## ARCHITECTURAL REVIEW BOARD

# RALPH LAUREN

## RALPH LAUREN

STANFORD SHOPPING CENTER
180 EL CAMINO REAL, SPACE #383A - BLDG. M
PALO ALTO, CA 94304

## PROJECT CONTACTS


TENANT:
RALPH LAUREN
601 W. 26TH STREET, 5TH FLOOR
NEW YORK, NY 10001

CONTACT: DANTE TAURO
DIRECT: (917) 748-8169
E-MAIL: DANTE.TAURO@RALPHLAUREN.COM

TENANT REPRESENTATIVE:
CHARRETTE
20 CLINTON AVE,
MAPLEWOOD, NJ 07040

CONTACT: LANDIS KAUFFMAN
DIRECT: (917) 294-9061
E-MAIL: LANDIS@CHARRETTE-MG.COM

OWNER REPRESENTATIVE:
SIMON PROPERTY GROUP
225 WEST WASHINGTON STREET
INDIANAPOLIS, IN 46204-3438 USA

CONTACT: RICHARD E. WESSELLS
MANAGER OF TENANT COORD.
TEL: (317) 464-8985
EMAIL: RWESSELLS@SIMON.COM

EXPEDITOR:
LANDSHARK DEVELOPMENT SERVICE GROUP
122 N HARBOR BLVD - #205
FULLERTON, CA 92832

CONTACT: JASON M. SMITH
TEL: (714) 235-8235
EMAIL: JSMITH@LANDSHARKDEVELOPMENT.COM

ARCHITECT OF RECORD:
TPG ARCHITECTURE LLP
31 PENN PLAZA
132 W 31ST STREET, 5TH FLOOR

AOR: THOMAS HUGHES, AIA
DIRECT: (212) 536-5089
E-MAIL: THUGHES@TPGARCHITECTURE.COM

PM: KATIE KANAKOS, RA
DIRECT: (212) 536.5048
E-MAIL: KKANAKOS@TPGARCHITECTURE.COM

MEP ENGINEER OF RECORD:
LAM+TEA ENGINEERING
901 CORPORATE CENTER DRIVE. #404
MONTEREY PARK, CA 91754

CONTACT: MALORY FAUST
DIRECT: (323) 673-8331
E-MAIL: MFAUST@LAMTEAENG.COM

STRUCTURAL ENGINEER:
KPFF
299 BROADWAY, SUITE 700
NEW YORK, NY 10007

CONTACT: LANDEN THOMAS
DIRECT: (212) 365-6691
E-MAIL: LANDEN.THOMAS@KPFF.COM

SYSTEMS CONTROL AND MONITORING
ENTOUCH CONTROLS
1755 N COLLINS BLVD # 350, RICHARDSON
TEXAS 75080

CONTACT: KARA FLOERSCH
DIRECT: (469) 744-8625
E-MAIL: KARAFLOERSCH@ENTOUCH.COM

FOH MILLWORK VENDOR
TBD
CONTACT: -
DIRECT: -

GREEN BUILDING 3RD PARTY INSPECTOR:
TBD
CONTACT: -
DIRECT: -
E-MAIL: -

FOOD SERVICE CONSULTANT
TRIMARK USA
3011 INDUSTRIAL PARKWAY EAST
KNOXVILLE, TN 37921

CONTACT: JEREMY GARCIA
DIRECT: (865) 405-3106
E-MAIL: JEREMY.GARCIA@TRIMARKUSA.COM


## LANDLORD REQUIRED VENDORS

FIRE ALARM
JOHNSON CONTROLS, INC.
6952 PRESTON AVE, SUITE A
LIVERMORE, CA 94551

DIRECT: (800) 200-4377 PROMPT# 4

BARRICADE
BOSTON RETAIL SOLUTIONS

DIRECT: (772) 569-7202

SIGNAGE
SIGNWORKS - FOR BRASS ADA BRAILLE PLAQUE
1200 INDUSTRIAL ROAD, UNIT 14
SAN CARLOS, CA 94070

DIRECT: (650) 508-7446

CONCRETE
BAY AREA CONCRETE - FOR MATCHING LL
FINISHED CONCRETE

DIRECT: (650) 508-7446

ROOFING
ALLIANCE ROOFING
630 MARTIN AVENUE
SANTA CLARA, CA 95050

DIRECT: (408) 261-2595

KODIAK ROOFING
8825 WASHINGTON BLVD, SUITE 100
ROSEVILLE, CA 95678

DIRECT: (916) 253-1935

STATE ROOFING
15444 HESPERIAN BLVD.
SAN LEANDRO CA 94578

DIRECT: (510) 317-1477

ELECTRICIANS
SHRADER ELECTRIC

DIRECT: (408) 371-1526

TELEPHONE/DATA
GRANITE TELECOM

DIRECT: (617) 837-4718

AT&T

DIRECT: (877) 691-9465

TRASH HAULING
GREEN WASTE OF PALO ALTO

DIRECT: (650) 493-4894

## TENANT VENDORS

LIGHTING DESIGNER
GEORGE SEXTON ASSOCIATES
2121 WISCONSIN AVENUE, NW, SUITE 220
WASHINGTON, DC 20007 - 2270

CONTACT: KARIN SALCH
DIRECT: 202.337.1903
E-MAIL: KSALCH@GSADC.COM

SECURITY/PEOPLE-COUNTER/ALARMS
COORDINATE WITH RL CONSTRUCTION

AUDIO
COORDINATE WITH RL CONSTRUCTION


TPG Architecture

TPG ARCHITECTURE, LLP
31 PENN PLAZA
132 WEST 31ST STREET, 5TH FLOOR, NEW YORK, NY 10001
212.768.0800 | TPGARCHITECTURE.COM


## DRAWING LIST

- ● NEW / REVISED ISSUE
- ○ ISSUED NO CHANGE, FOR INFORMATION ONLY

| | | 01.10.2025 - ARCHITECTURAL REVIEW BOARD SET | 05.30.2025 - ARCHITECTURAL REVIEW CORR. 1 | 07.22.2025 - ARCHITECTURAL REVIEW CORR. 2 |
|---|---|---|---|---|
| **ARCHITECTURAL** | | | | |
| T-001 | TITLE SHEET | ● | ● | ● |
| G-001 | CODE DATA & & RESPONSIBILITY SCHEDULE | ● | ● | ● |
| G-002 | MATERIALS BOARD | ● | ● | ● |
| G-003 | EXISTING EXTERIOR VIEWS | ● | ● | ● |
| G-004 | PROPOSED RENDERED EXTERIOR VIEWS | ● | ● | ● |
| G-005 | EXTERIOR SITE PLAN | ● | ● | ● |
| G-006 | SITE PLAN AND PARKING ANALYSIS | ● | ● | ● |
| G-007 | ZERO WASTE SHEET | ● | ● | ● |
| G-008 | SITE PLAN - REFUSE BIN TRANSPORT PLAN | | ● | ● |
| T-1 | TREE PROTECTION PLAN | ● | ● | ● |
| D-101 | DEMOLITION PLAN | ● | ● | ● |
| A-001 | LEASE OUTLINE PLAN | ● | ● | ● |
| A-002 | EGRESS PLAN | ● | ● | ● |
| A-100 | LAYOUT PLAN | ● | ● | ● |
| A-101 | CONSTRUCTION PLAN | ● | ● | ● |
| A-201 | REFLECTED CEILING PLAN | ● | ● | ● |
| A-401 | FINISH PLAN | ● | ● | ● |
| A-402 | FINISH SCHEDULE - RETAIL | ● | ● | ● |
| A-403 | FINISH SCHEDULE - CAFE | ● | ● | ● |
| A-410 | FLOOR DETAILS | ● | ● | ● |
| A-501 | FIXTURE PLAN | ● | ● | ● |
| A-502 | EXTERIOR FIXTURE DETAILS | | ● | ● |
| A-600 | DOOR TYPES AND SCHEDULES | ● | ● | ● |
| A-601 | DOOR DETAILS | ● | ● | ● |
| A-700 | PLAN & ELEVATIONS - STOREFRONT | ● | ● | ● |
| A-701 | ENLARGED PARTIAL PLAN & ELEVATIONS - STOREFRONT | ● | ● | ● |
| A-702 | ENLARGED PARTIAL PLAN & ELEVATIONS - STOREFRONT | ● | ● | ● |
| A-703 | ENLARGED PARTIAL PLAN & ELEVATIONS - STOREFRONT | ● | ● | ● |
| A-710 | STOREFRONT SECTIONS | ● | ● | ● |
| A-711 | STOREFRONT SECTIONS | ● | ● | ● |
| A-712 | STOREFRONT SECTIONS | ● | ● | ● |
| A-713 | STOREFRONT SECTIONS | | ● | ● |
| A-720 | STOREFRONT PLAN DETAILS | ● | ● | ● |
| A-721 | STOREFRONT PLAN DETAILS | ● | ● | ● |
| A-722 | STOREFRONT SECTION DETAILS | ● | ● | ● |
| A-723 | STOREFRONT SECTION DETAILS | ● | ● | ● |
| A-724 | STOREFRONT SECTION DETAILS | ● | ● | ● |
| A-725 | STOREFRONT SECTION DETAILS | ● | ● | ● |
| A-900 | SIGNAGE DETAILS | ● | ● | ● |
| A-901 | SIGNAGE DETAILS | ● | ● | ● |

RALPH LAUREN

SPACE PLAN

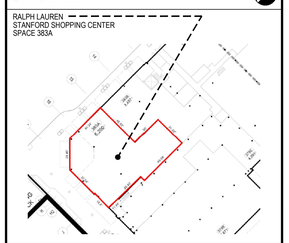


Lam+Tea Engineering

kpff

### SUBMISSION FOR ARCHITECTURAL REVIEW BOARD

| NO. | REVISION | | DATE | BY |
|---|---|---|---|---|
| 9 | A.R.B. CORRECTIONS 2 | 7 | 07.22.2025 | TPG |
| 8 | PERMIT CORRECTIONS 2 | 6 | 07.02.2025 | TPG |
| 7 | A.R.B. CORRECTIONS 1 | 5 | 05.30.2025 | TPG |
| 6 | BOARD OF HEALTH CORRECTIONS | 4 | 04.18.2025 | TPG |
| 5 | LATEST FULL SET UPDATES | 3 | 04.14.2025 | TPG |
| 4 | PERMIT CORRECTIONS 1 | 2 | 05.23.2025 | TPG |
| 3 | BID ADDENDUM 1 | 1 | 03.11.2025 | TPG |
| 2 | ISSUED FOR BID & PERMIT | | 01.10.2025 | TPG |
| 1 | PROGRESS SET FOR CLIENT REVIEW | | 12.13.2024 | TPG |

TPG Architecture


TPG ARCHITECTURE, LLP
31 PENN PLAZA
132 WEST 31ST STREET, 5TH FLOOR, NEW YORK, NY 10001
212.768.0800 | TPGARCHITECTURE.COM



IN CONSIDERATION OF RECEIVING DRAWINGS FROM TPG ARCHITECTURE LLP IN AN ELECTRONIC FORM, THE RECIPIENT AGREES, TO THE FULLEST EXTENT PERMITTED BY LAW, TO HOLD HARMLESS AND INDEMNIFY TPG ARCHITECTURE LLP FROM AND AGAINST ALL CLAIMS, LIABILITIES, LOSSES, DAMAGES, AND COSTS, INCLUDING BUT NOT LIMITED TO ATTORNEY'S FEES, ARISING OUT OF, OR IN ANY WAY CONNECTED WITH THE USE, RE-USE, MIS-USE, MODIFICATION, OR MISINTERPRETATION OF THE MACHINE-READABLE INFORMATION PROVIDED BY TPG ARCHITECTURE LLP UNDER THIS AGREEMENT.


PROJECT
**RALPH LAUREN**
**STANFORD SHOPPING CENTER**
180 EL CAMINO REAL #383A, BLDG. M
PALO ALTO, CA 94304

DRAWING
COVER SHEET

FOR ARB EXHIBIT

SEAL

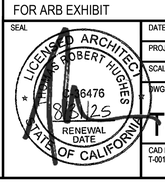


| | |
|---|---|
| DATE | 04/18/2025 |
| PROJECT NO. | 1524879-00 |
| SCALE | |
| DWG NO. | T-001.00 |
| CAD FILE NO. | T-001.00_COVER ARB.DWG |
| PAGE | 01 of 55 |

K:\241524879.0008_DRAWINGS_OUTPUTS\SHEETS\2025\0530 ARB CORRECTIONS 1_REV 5\ARCH\T-001.00_COVER ARB.DWG / Plot Date: Jul. 24, 2025 - 9:33 AM
Last Saved By: MHAMANI / Save Date: 7/24/2025 8:56:15 AM

## SPACE PLAN

RALPH LAUREN
STANFORD SHOPPING CENTER,
PALO ALTO, CA 94304

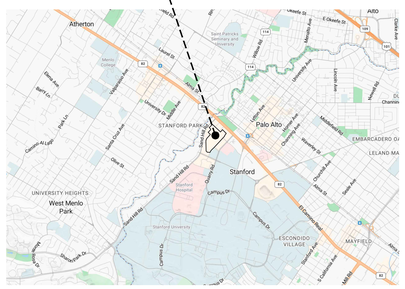


## LOCATION MAP

RALPH LAUREN
STANFORD SHOPPING CENTER,
SPACE # 383A

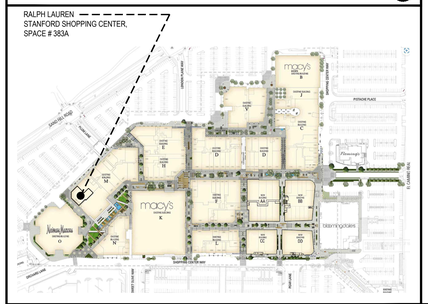


## HARMONY CLAUSE (AS APPLICABLE)

THERE SHALL BE NO MANIFESTATIONS ON THE PROJECT OF ANY DISPUTE BETWEEN ANY LABOR ORGANIZATION AND ANY TENANT CONTRACTOR OR SUBCONTRACTOR, INCLUDING BUT NOT LIMITED TO, ANY AREA STANDARDS PICKETING AGAINST SAID CONTRACTOR OR SUBCONTRACTOR.

SHOULD THERE BE ANY MANIFESTATION OF A LABOR DISPUTE BETWEEN ANY TENANT CONTRACTOR OR SUBCONTRACTOR AND ANY UNION WHICH RESULTS IN A STOPPAGE OF WORK ON THE PART OF SAID CONTRACTOR OR CONTRACTOR'S EMPLOYEES OR THE EMPLOYEES OF ANY EMPLOYER OR SUPPLIER ON THE PROJECT, WHICH IN THE SOLE JUDGEMENT OF THE LANDLORD/BUILDING MANAGEMENT, WILL CAUSE, OR IS LIKELY TO CAUSE, UNREASONABLE DELAY IN THE PROGRESS OF CONSTRUCTION, THEN UPON WRITTEN NOTICE FROM THE LANDLORD/BUILDING MANAGEMENT, THE TENANT SHALL HAVE THE OBLIGATION AND RIGHT TO DECLARE THE CONTRACTOR OR SUBCONTRACTOR IN DEFAULT OF HIS CONTRACT, UPON SUCH NOTICE, THE TENANT SHALL HAVE THE RIGHT TO TAKE SUCH STEPS AS NECESSARY TO FINISH THE UNCOMPLETED PORTION OF THE WORK TO BE PERFORMED BY THE CONTRACTOR OR SUBCONTRACTOR.

## SCOPE OF WORK STATEMENT

TENANT FIT OUT OF EXISTING MERCANTILE SPACE. NO CHANGE IN USE, OCCUPANCY, OR ZONING FILED UNDER THIS APPLICATION. INTERIOR SCOPE FILED UNDER SEPARATE APPLICATION.

EXTERIOR IMPROVEMENTS INCLUDE NEW STOREFRONT SYSTEM AND ENTRY TO BUSINESS. EXISTING FACADE COMPONENTS TO BE REFINISHED. NEW EXTERIOR LIGHTING. NEW EXTERIOR FURNITURE.R

*SHELL SPACE WAS REDEMISE UNDER PROJECT # 24BLD-03495.*

**ALL EXTERIOR SIGNAGE TO BE FILED UNDER SEPARATE APPLICATION.**

## BUILDING CODE DATA

| | |
|---|---|
| TYPE OF STORE: | INTERIOR TENANT FIT-OUT |
| EXISTING OR NEW: | EXISTING |
| SQUARE FOOTAGE: | 5,200 SF (GROSS) |
| PROJECT ADDRESS: | **RALPH LAUREN**<br>180 EL CAMINO REAL, SPACE #383A<br>PALO ALTO, CA 94304 |

**APPLICABLE CODES**

| | | |
|---|---|---|
| BUILDING: | 2022 CALIFORNIA BUILDING CODE | - CCR TITLE 24 PART 2 |
| MECHANICAL: | 2022 CALIFORNIA MECHANICAL CODE | - CCR TITLE 24 PART 4 |
| PLUMBING: | 2022 CALIFORNIA PLUMBING CODE | - CCR TITLE 24 PART 5 |
| ELECTRICAL: | 2022 CALIFORNIA ELECTRICAL CODE | - CCR TITLE 24 PART 3 |
| FIRE SAFETY: | 2022 CALIFORNIA FIRE CODE | |
| ACCESSIBILITY: | 2022 CALIFORNIA BUILDING CODE<br>2010 ADA STANDARDS | - CCR TITLE 24 PART 2 |
| ENERGY: | 2022 CALIFORNIA ENERGY CODE<br>2022 PALO ALTO GREEN BUILDING AND LOCAL ENERGY REACH CODE | |

| | |
|---|---|
| EXIST. CONSTRUCTION TYPE: | TYPE III-B - FULLY SPRINKLED |
| OCCUPANCY GROUP: | M (MERCANTILE)<br>B* (BUSINESS) |

**FIRE**

| | |
|---|---|
| AUTOMATIC SPRINKLERS: | YES |
| SMOKE CONTROL: | YES |
| STOCKROOM WALL RATING: | 0 HR. |
| NUMBER OF EXITS: | REQUIRED: 2 / PROVIDED: 2 |
| TRAVEL DISTANCE TO EXIT: | 250'-0" MAX. |
| COMMON PATH OF TRAVEL: | 75'-0" MAX. |

**PLUMBING FACILITIES REQUIRED IN LEASED PREMISES** — ***CPC: TABLE 422.1***

| | | | |
|---|---|---|---|
| WATER CLOSETS | SEE CHART BELOW | REQ: 2 | PROVIDED: 2 |
| LAVATORIES | SEE CHART BELOW | REQ: 2 | PROVIDED: 2 |
| DRINKING FOUNTAIN | 1:1-250 | REQ: 1 | PROVIDED: 1 |
| SERVICE SINK | | REQ: 1 | PROVIDED: 1 |

**OCCUPANT LOAD*** — ***CBC: TABLE 1004.5***

*SEE SQUARE FOOTAGE & OCCUPANT LOAD BREAKDOWN ON TABLE BELOW

**EGRESS**

SEE LIFE SAFETY PLAN FOR MORE INFORMATION

| | |
|---|---|
| AISLE WIDTH: | 44" MIN. |
| AISLE ACCESS: | 36" MIN. |
| AISLE ACCESS DISTANCE: | 250'-0" MAX. |
| EXIT CAPACITY: | REQUIRED: 36"<br>PROVIDED: 72" + 72" = 144" |

## GENERAL RESPONSIBILITY NOTES

1. GC SHALL FIELD VERIFY ALL FIELD CONDITIONS PRIOR TO THE START OF ANY CONSTRUCTION. BE ADVISED THAT A CHANGES AND MODIFICATION TO THE LANDLORD'S APPROVED DRAWINGS SHALL BE RESUBMITTED TO LANDLORD FOR LL RE-APPROVAL. ANY CONSTRUCTION COMPLETED WITH OUT LANDLORD APPROVAL SHALL BE CORRECTED AS APPROVED BY LANDLORD AT GC'S EXPENSE.
2. ANY ITEMS SHOWN ELSEWHERE IN DRAWING SET BUT NOT LISTED ABOVE SHALL BE INCLUDED IN G.C. BID.

## BUILDING CODE NOTES

1. THE WORK FILED HEREIN FOR INTERIOR TENANT LAYOUT ONLY. NO CHANGE IN USE, OR OCCUPANCY OR EGRESS.
2. SEPARATE PLAN CHECK, PLANS, & PERMIT(S) MAY BE REQUIRED FOR SIGNS, FIRE SPRINKLER SYSTEMS & EACH SEPARATE STRUCTURE.
3. ALL WORK HEREIN SHALL BE DONE IN ACCORDANCE WITH THE REQUIREMENTS OF THE 2022 CALIFORNIA BUILDING CODE
4. ALL DEMISING WALLS AND RATED PARTITIONS SHALL BE CONSTRUCTED TO THE UNDERSIDE OF THE STRUCTURAL FLOOR OR ROOF ABOVE WITH FIRE-STOPPING PER CODE REQUIREMENTS.
5. ALL RATED ASSEMBLIES MUST COMPLY WITH U.L. SPECIFICATIONS FOR CONSTRUCTION.
6. DOORS
   - 6.1. ALL NEW DOORS AND TRIM OPENINGS SHALL BE INCOMBUSTIBLE AND A MINIMUM OF 3'-0" WIDE UNLESS OTHERWISE NOTED
   - 6.2. ALL NEW DOOR HARDWARE TO COMPLY WITH ACCESSIBILITY DESIGN REQUIREMENTS.
7. ILLUMINATED EXIT SIGNS AND DIRECTIONAL SIGNS SHALL COMPLY WITH ALL GOVERNING CODE REQUIREMENTS.
8. GENERAL CONTRACTOR TO VERIFY ALL CONDITIONS AND DIMENSIONS SHOWN ON THE PLANS AT THE JOB SITE BEFORE COMMENCING ANY WORK.
9. GENERAL CONTRACTOR SHALL VERIFY THAT DEMISING WALLS EXTEND TO STRUCTURE ABOVE AND ALL PENETRATIONS ARE SEALED TIGHT, AND SHALL PROVIDE ALL WORK REQUIRED TO CORRECT DEFICIENT CONDITIONS. VERIFY WITH LANDLORD.
10. NO WORK SHALL COMMENCE UNTIL PLANS HAVE BEEN APPROVED AND PERMITS ISSUED BY THE LOCAL BUILDING DEPARTMENT.
11. THE CONTRACTOR SHALL MAINTAIN, FOR THE ENTIRE DURATION OF THE WORK, ALL EXITS, EXIT LIGHTING, FIRE PROTECTION DEVICES AND ALARMS IN CONFORMANCE WITH ALL APPLICABLE CODES AND ORDINANCES.
12. THE TENANT MAY BE REQUIRED TO MAKE A SEPARATE SUBMITTAL FOR FIRE PROTECTION AND SECURE A SEPARATE PERMIT PRIOR TO INSTALLATION.
13. IF APPLICABLE, COORDINATE ALL FIRE SPRINKLER WORK WITH LL APPROVED FIRE SPRINKLER CONTRACTOR.
14. ONLY FIRE RETARDANT WOOD & PLYWOOD ARE PERMITTED INCLUDING BLOCKING, BACKINGS, ETC.
15. ALL MATERIALS INSTALLED SHALL BE A MINIMUM OF CLASS "C".
16. INTERIOR FINISH MATERIALS APPLIED TO WALLS AND CEILINGS SHALL BE TESTED AS SPECIFIED.
17. ONLY NON-COMBUSTIBLE METAL STUDS ARE ALLOWED ON THIS PROJECT AS A TYPE III NON-RATED CONSTRUCTION.
18. INSULATION SHALL HAVE A MINIMUM FLAME SPREAD PER CODE REQUIREMENTS.

## FIRE DEPARTMENT NOTES

1. EXIT SIGNS =, EMERGENCY LIGHTING, FIRE EXTINGUISHERS, FIRE DEPARTMENT LOCK AND ADDRESS POSTING TO BE FIELD VERIFIED BY FIRE INSPECTOR.
2. SEPARATE PERMIT REQUIRED FOR MODIFICATION TO THE FIRE SPRINKLER /FIRE ALARM SYSTEMS.
3. IF ANY CONSTRUCTION / TENANT IMPROVEMENT WORK IS DONE THAT MAY IMPACT THE BUILDING FIRE ALARM SYSTEM THEN THE FIRE MONITORING MUST BE NOTIFIED. IF THE FIRE ALARM SYSTEM IS ACCIDENTALLY ACTIVATED IMMEDIATLY CALL THE CITY OF PALO ALTO COMMUNICATION CENTER AT 650-329-2613 TO REPORT THE INCIDENT. MULITPLE FALSE ALARMS WILL RESULT IN FINES.
4. ANY ONSITE CONSTRUCTION ACTIVITY THAT EMITS/PRODUCES HEAT OR FLAME INCLUDING WELDING, BRAZING, HEATING OR USE OF LARGE M/V SMALL GENERATORS REQUIRES A HOT WORK PERMIT FROM THE PALO ALTO FD. EMAIL FIRE@CITYOFPALOALTO.ORG TO OBTAIN A HOT WORK PERMIT PRIOR TO HOT WORK ACTIVITY.

## FIRE RESISTIVE REQUIREMENTS

| | | |
|---|---|---|
| 1. SALES / NON-SALES WALL: | = | 0 HR |
| 2. CEILING: | = | 0 HR |
| 3. COLUMNS: | = | 0 HR |
| 4. EXIT HALLWAY: | = | 1 HR IF OVER 75' LINEAR FEET |
| 5. CORRIDOR: | = | 1 HR |

SEE A-001.00 FOR NEIGHBORING SPACES AND DEMISING WALL CONSTRUCTION

## DELIVERY NOTES

1. GC TO COORDINATE ALL DELIVERIES WITH LANDLORD'S FIELD TENANT COORDINATION TEAM.

## RESPONSIBILITY SCHEDULE

REFER TO DRAWINGS FOR FULL RESPONSIBILITY REQUIREMENTS

| GENERAL REQUIREMENTS | E | LL F | LL I | GC F | GC I | TENANT F | TENANT I | N/A | REMARKS |
|---|---|---|---|---|---|---|---|---|---|
| REQUIRED REIMBURSABLE LL FEES | | | | ● | ● | ● | ● | | |
| PERMITS / FEES (APPLICATIONS FILED BY TENANT) | | | | | | ● | ● | | |
| CERTIFICATE OF INSURANCE | ● | | | ● | ● | | | | |
| HAZ-MAT ABATEMENT | | | | ● | ● | | | | |
| TEMPORARY UTILITIES | | | | ● | ● | | | | |
| BARRICADE AND PAINT (WHITE) | | | | ● | ● | | | | REFER TO D-101.00 AND D-102.00 FOR SCOPE. |
| BARRICADE RELOCATION | | | | | | | | ● | |
| TEMP WINDOW/BARRICADE GRAPHICS | | | | ● | ● | | | | |
| BARRICADE REMOVAL/DISPOSAL | | | | ● | ● | | | | COORDINATE WITH LANDLORD |
| PROTECTION OF LANDLORD TILE | | | | ● | ● | | | | PROTECT PRIOR TO BARRICADE INSTALLATION |

| DEMOLITION | E | LL F | LL I | GC F | GC I | TENANT F | TENANT I | N/A | REMARKS |
|---|---|---|---|---|---|---|---|---|---|
| STOREFRONT | | | | ● | ● | | | | REFER TO D-101.00 FOR SCOPE. |
| CEILING / LIGHT FIXTURES | | | | ● | ● | | | | |
| FIXTURES / FINISHES | | | | ● | ● | | | | |
| PARTITIONS / DOORS | | | | ● | ● | | | | |
| REAR DOOR | | | | | | | | ● | |
| TOILET ROOM | | | | ● | ● | | | | GC TO ENSURE ALL ROUGHS REMOVED TO SOURCE. REFER TO D-101.00 FOR SCOPE. |
| SIGNAGE | | | | ● | ● | | | | REFER TO D-101.00 FOR SCOPE. |
| TEMP LIGHTING & SAFETY REQ'TS | | | | ● | ● | | | | G.C. RESP. FOR ALL SITE SAFETY |

| FLOOR CONSTRUCTION | E | LL F | LL I | GC F | GC I | TENANT F | TENANT I | N/A | REMARKS |
|---|---|---|---|---|---|---|---|---|---|
| EXISTING SLAB VERIFICATION | | | | ● | ● | | | | |
| FLOOR PENETRATION | | | | ● | ● | | | | AS REQUIRED |
| FLOOR PROTECTION | | | | ● | ● | | | | |
| SLAB PREPARATION | | | | ● | ● | | | | FLASH & PATCH AS REQ'D. INFILL TO BE LEVEL WITHIN TOLERANCES AS INDICATED. COORDINATE WITH FLOORING THICKNESS. LEVEL FOR BOH ROLLING SHELVES |
| CORING, TRENCHING & SLAB INFILL | | | | ● | ● | | | | GC TO SCAN PRIOR TO ANY CORING / TRENCH. |

| WALLS | E | LL F | LL I | GC F | GC I | TENANT F | TENANT I | N/A | REMARKS |
|---|---|---|---|---|---|---|---|---|---|
| DEMISING PARTITION STUDS | | ● | ● | | | | | | BY MALL TEAM |
| DEMISING PARTITION DRYWALL | | | | ● | ● | | | | GC TO PATCH AND REPAIR (E) DEMISING |
| TOILET ROOM FRAMING, BLOCKING, GYP BD. | | | | ● | ● | | | | WALLS AS REQUIRED TO MAINTAIN FIRE RATING. V.I.F. TENANT SIDE ONLY |
| SALES WALLS FRAMING, BLOCKING, GYP BD | | | | ● | ● | | | | SEE CON. PLAN; COORD. w/ MW VENDOR |
| FURRING AROUND COLUMNS | | | | ● | ● | | | | SEE CON. PLAN; COORD. w/ MW VENDOR |
| TAPING & SPACKLING | | | | ● | ● | | | | |
| CARPENTRY, ROUGH AND FINISH | | | | | | | | | FINISH MILLWORK, TRIM & CASING PROVIDED BY MILLWORKER & INSTALLED BY GC |

| CEILINGS | E | LL F | LL I | GC F | GC I | TENANT F | TENANT I | N/A | REMARKS |
|---|---|---|---|---|---|---|---|---|---|
| GYP. BD. CEILINGS, SOFFITS & COVES | | | | ● | ● | | | | SALES |
| INSULATION | | | | ● | ● | | | | AS REQUIRED |
| ACCESS PANELS | | | | ● | ● | | | | AS REQUIRED |
| BLOCKING AND FRAMING ABOVE GYP. BD. CLGS | | | | ● | ● | | | | G.C. TO COORD. W/ MILLWORK VENDOR |
| SEISMIC CEILING RUNNER AND GRID | | | | ● | ● | | | | F.O.H. AND B.O.H. |
| ACOUSTIC CEILING TILE | | | | ● | ● | | | | |

| DOORS | E | LL F | LL I | GC F | GC I | TENANT F | TENANT I | N/A | REMARKS |
|---|---|---|---|---|---|---|---|---|---|
| STOREFRONT DOORS | | | | ● | ● | | | | BY SF VENDOR. G.C. TO COORD. |
| INTERIOR DOORS & FRAMES | | | | ● | ● | | | | F.O.H. AND B.O.H. |
| MILLWORK DOORS & FRAMES | | | | | | ● | ● | | F.O.H. BY MW VENDOR; G.C. TO COORD. |
| DOOR HARDWARE | | | | ● | ● | ● | ● | | SEE HARDWARE SCHEDULE |
| CUSTOM DOOR CASING | | | | | ● | ● | | | GC. TO COORDINATE WITH M.C. AS REQUIRED IN ORDER TO COMPLETE INSTALLATION. GC TO PAINT ON-SITE. SUPPLIED BY MW, INSTALLED BY GC. |

| FINISHES | E | LL F | LL I | GC F | GC I | TENANT F | TENANT I | N/A | REMARKS |
|---|---|---|---|---|---|---|---|---|---|
| WOOD FLOORING | | | | ● | ● | | | | GC TO PROVIDE SAMPLES FOR REVIEW. SEE FINISH SCHEDULE FOR ADDITIONAL INFO. |
| CARPETS | | | | ● | ● | ● | | | DOUBLE STICK TAPE AT EDGES OF AREA RUGS. AREA RUGS BY DECO TEAM; CARPET TO BE PURCHASED & SUPPLIED BY RL AND INSTALLED BY G.C. |
| V.C.T. FLOORING | | | | ● | ● | | | | |
| REDUCER / TRANSITION STRIPS | | | | ● | ● | | | | |
| ENTRY TILE / MALL FLOORING | | | | ● | ● | | | | INSTALL PER DWGS. REPAIR/INFILL AS REQ'D; COORD. W/ LL. SEE FINISH SCHEDULE FOR MORE INFO PROTECT ALL THROUGHOUT CONS. |
| FRP PANELS (MOP SINK) | | | | ● | ● | | | | |
| RUBBER/VINYL BASE | | | | ● | ● | | | | |
| WATERPROOF MEMBRANE (TOILET ROOM, MOP SINK, SALES SINK) | | | | ● | ● | | | | 6" UP ALL ADJACENT WALLS |
| PAINT (WALLS & CEILINGS) | | | | ● | ● | | | | |
| WALL COVERINGS | | | | | ● | ● | | | |
| WOOD BASE AND CROWN MOLDING | | | | | ● | ● | | | BY MW VENDOR; G.C. TO COORD. INSTALL |
| PUBLIC RESTROOM WALL AND FLOOR FINISHES | | | | ● | ● | | | | SEE FINISH SCHEDULE |
| DRAPERY | | | | | ● | ● | | | DRAPES INSTALLED BY GC UNDER SUPERVISION OF RL DECO DURING SET-UP |

| STOREFRONT / SIGNAGE | E | LL F | LL I | GC F | GC I | TENANT F | TENANT I | N/A | REMARKS |
|---|---|---|---|---|---|---|---|---|---|
| ILLUMINATED SIGNAGE | | | | | ● | ● | | | PROVIDED BY RL VENDOR. COORD. BY GC. GC TO PROVIDE ALL ELEC CONNECTIONS |
| STOREFRONT GLAZING | | | | ● | ● | | | | SEE NEW WERE INDICATED. GC TO PROVIDE ALL FRAMING STRUCTURE AND SUPPORT. SEE DWGS FOR MORE INFO. |
| STOREFRONT SYSTEM AND FRAMING | | | | ● | ● | | | | |
| NEUTRAL PIERS/ LANDLORD BULKHEAD | ● | ● | ● | | | | | | |
| STOREFRONT LIGHTING | | | | ● | ● | | | | GC, AND ELECTRICIAN TO COORD. WITH LL |

| FIXTURES | E | LL F | LL I | GC F | GC I | TENANT F | TENANT I | N/A | REMARKS |
|---|---|---|---|---|---|---|---|---|---|
| WALL FIXTURES | | | | | | ● | ● | | BY MW VENDOR; G.C. TO COORD. |
| VISUALS | | | | | | ● | ● | | BY MW VENDOR; G.C. TO COORD. |
| FREESTANDING FIXTURES | | | | | | ● | ● | | BY MW VENDOR; ELEC. CONNECTION BY G.C. |
| FREESTANDING FURNITURE | | | | ● | ● | ● | | | PROVIDED BY LV, INVOICE, ELEC, INSTALL & CONNECTION BY G.C. |

| STOCKROOM | E | LL F | LL I | GC F | GC I | TENANT F | TENANT I | N/A | REMARKS |
|---|---|---|---|---|---|---|---|---|---|
| BUILT-IN MILLWORK SHELVING | | | | ● | ● | | | | SEE A-140 FOR FULL EQUIPMENT LIST AND RESPONSIBILITIES. GC RESPONSIBLE FOR ALL BOH MILLWORK, EQUIPMENT, AND SHELVING EXCEPT AS NOTED. |
| DESK CHAIR | | | | ● | ● | | | | |
| PANTRY APPLIANCES | | | | ● | ● | | | | |
| BOH STOCK SHELVING | | | | ● | ● | | | | |

| MECHANICAL | E | LL F | LL I | GC F | GC I | TENANT F | TENANT I | N/A | REMARKS |
|---|---|---|---|---|---|---|---|---|---|
| HVAC UNITS | | | | ● | ● | | | | |
| SUPPLY & RETURN DUCTWORK | | | | ● | ● | | | | |
| DIFFUSERS / GRILLES | | | | ● | ● | | | | |
| THERMOSTATS & SENSORS | | | | ● | ● | | | | |
| TOILET ROOM EXHAUST FAN | | | | ● | ● | | | | |
| FIRE DAMPERS / SMOKE DETECTORS | | | | ● | ● | | | | |
| SMOKE EVAC SYSTEM | | | | | | | | ● | |
| CERTIFIED AIR BALANCE REPORT | | | | ● | ● | | | | |
| CONTROLS AND CONNECTORS | | | | ● | ● | | | | |
| GAS SERVICE | | | | ● | ● | | | | |
| TESTING AND BALANCING | | | | ● | ● | | | | |
| ROOF PENETRATIONS / PATCHING | | | | | | | | ● | |
| ROOF CURB | | | | | | | | ● | |
| HVAC SHOP DRAWINGS | | | | ● | ● | | | | INCLUDE ALL COMPONENTS |
| INDOOR AIR QUALITY | | | | ● | ● | | | | SEE ENGINEER IAQ LETTER FOR REQS |

| TOILET / PLUMBING | E | LL F | LL I | GC F | GC I | TENANT F | TENANT I | N/A | REMARKS |
|---|---|---|---|---|---|---|---|---|---|
| WATER METER | ● | | | | | | | | |
| PLUMBING FIXTURES | | | | ● | ● | | | | |
| FLOOR DRAIN / TRAP PRIMER | | | | ● | ● | | | | |
| WATER HEATER/ INSTA HOT | | | | ● | ● | | | | |
| MOP SINK | | | | ● | ● | | | | |
| DRINKING FOUNTAIN | | | | ● | ● | | | | |
| WATER COOLER | | | | | | | | ● | |
| ACCESSORIES | | | | ● | ● | | | | |
| SANITARY WASTE TO PREMISES | ● | | | | | | | | |
| DOMESTIC SUPPLY TO PREMISES | ● | | | | | | | | |
| VENT PIPES TO PREMISES | ● | | | | | | | | |
| SUPPLY, VENT, WASTE PIPING | | | | ● | ● | | | | AS NEEDED FOR NEW PLUMBING FIXTURES |

| ELECTRICAL | E | LL F | LL I | GC F | GC I | TENANT F | TENANT I | N/A | REMARKS |
|---|---|---|---|---|---|---|---|---|---|
| CONDUIT TO SPACE | ● | | | ● | ● | | | | G.C. TO EXTEND AS REQ'D; SEE ELEC. DWGS |
| METER AND METER PAN | | | | ● | ● | | | | SEE ELECTRICAL DRAWINGS |
| ELECTRICAL FEED TO SPACE | | | | ● | ● | | | | SEE ELECTRICAL DRAWINGS |
| ELECTRICAL PANELS | | | | ● | ● | | | | SEE ELECTRICAL DRAWINGS |
| ELECTRICAL DISTRIBUTION | | | | ● | ● | | | | SEE ELECTRICAL DRAWINGS |
| TRANSFORMER | | | | ● | ● | | | | SEE ELECTRICAL DRAWINGS |
| LIGHTING CONTROLS | | | | ● | ● | | | | SEE ELECTRICAL DRAWINGS. G.C. RESPONSIBLE TO SUPPLY AND INSTALL ALL LIGHTING CONTROLLS AND INVERTER |
| INVERTER | | | | ● | ● | | | | |
| RECEPTACLES | | | | ● | ● | | | | SEE ELECTRICAL DRAWINGS |
| SALES AREA LIGHT FIXT. & LAMPS U.O.N. | | | | ● | ● | | ● | | FOH FIXTURES PROVIDED BY TENANT AND INSTALLED BY GC. |
| NICHE MILLWORK LIGHTING | | | | ● | | | ● | | WALLCASES LIGHTS PRE-ASSEMBLED BY MILLWORKER. GC TO PROVIDE CEILING/FLOOR WHIPS FOR ELEC. HOOKUP. |
| TIME CLOCK | | | | | ● | ● | | | GC TO COORDINATE WITH RL TEAM |
| BOH LIGHT FIXTURES & LAMPS | | | | ● | ● | | | | |
| BOH MILLWORK TASK LIGHTING | | | | ● | ● | | | | |
| EXIT SIGNS | | | | ● | ● | | | | |
| TEL./DATA CONDUIT TO SPACE W/PULL STRINGS | | | | ● | ● | | | | SEE PROGRAM LOW VOLTAGE RESPONSIBILITY MATRIX ON ELECTRICAL DRAWINGS FOR MORE INFORMATION. |
| 6 CAT6 CABLE FROM MALL CLOSET | | | | ● | ● | | ● | | |
| TELECOM BOARD (PLYWOOD) | | | | ● | ● | | | | |
| PHONE & DATA CABLE (INCL. POS & WAP) | | | | ● | ● | | | | |
| PHONE & DATA TERM. AT PATCH PANEL | | | | ● | ● | | | | |
| PHONE & DATA PORTS/RECEPTACLES | | | | ● | ● | | | | |
| SECURITY SYSTEMS (BURGLAR ALARM & CCTV) | | | | | | | ● | ● | GC TO COORDINATE WITH RL TEAM |
| SECURITY SYSTEMS (KAY PAD) | | | | | | | ● | ● | |
| SECURITY SYSTEMS - CABLE | | | | | | ● | ● | | |
| SOUND SYSTEM & EQUIPMENT | | | | | | | ● | ● | GC TO COORDINATE WITH RL TEAM |
| SOUND SYSTEM - CABLING | | | | | | ● | ● | | |
| TRAFFIC COUNTER & EQUIPMENT | | | | | | | ● | ● | GC TO COORDINATE WITH RL TEAM |
| TRAFFIC COUNTER - CABLING | | | | | | ● | ● | | |
| LOW VOLTAGE CONDUIT | | | | | | ● | ● | | IF REQUIRED BY LOCAL JURISDICTION; TYP. |

| FIRE PROTECTION | E | LL F | LL I | GC F | GC I | TENANT F | TENANT I | N/A | REMARKS |
|---|---|---|---|---|---|---|---|---|---|
| SPRINKLER MAIN TO PREMISES (SPACE) | ● | | | | | | | | |
| SPRINKLER BRANCH LINES / DROPS / HEADS | | | | ● | ● | | | | |
| FIRE ALARM SYSTEM (CONDUIT) | | | | ● | ● | | | | |
| FIRE ALARM SYSTEM (DEVICES / WIRING) | | | | ● | ● | | | | INCLUDE ALL COMPONENTS |
| FIRE EXTINGUISHERS & CABINETS | | | | ● | ● | | | | NEW, FULLY CHARGED, PER CODE WITH CERTIFICATION TAG & READY TO OPERATE |
| SPRINKLER SHUT-OFF VALVE & ASSOCIATED PIPES RELOCATION | ● | | | ● | ● | | | | AS REQUIRED |

| POST CONSTRUCTION | E | LL F | LL I | GC F | GC I | TENANT F | TENANT I | N/A | REMARKS |
|---|---|---|---|---|---|---|---|---|---|
| FINAL CLEANUP FOR OCCUPANCY | | | | ● | ● | | | | |
| CHANGE FILTERS | | | | ● | ● | | | | CHANGE FILTERS AT TURNOVER TO OPS/RETAIL |
| CLEAN PLUMBING LINES | | | | ● | ● | | | | PROVIDE VIDEO OF PLUMBING LINES CLEAN OF DEBRIS AT TURNOVER |
| CERTIFICATE OF OCCUPANCY | | | | ● | ● | | | | |
| PUNCHLIST COMPLETION | | | | ● | ● | | | | |
| DUMPSTER FOR STORE USE AT TURNOVER | | | | ● | ● | | | | EMPTY AT TURNOVER |
| CHANGE CORES | | | | | | ● | ● | | FINAL CORES BY TENANT |

**KEY**

GC - TENANT GENERAL CONTRACTOR
F - FURNISH
I - INSTALL
E - EXISTING
LL - LANDLORD
N/A- NOT APPLICABLE

**NOTES**

THIS 'RESPONSIBILITY SCHEDULE' IS INTENDED FOR USE AS A GUIDE ONLY & IS NOT ALL-INCLUSIVE. ALL PERSONS BIDDING WORK OR CONTRACTED FOR WORK ARE TO REVIEW THESE DOCUMENTS, LANDLORD CRITERIA & EXECUTED LEASE AGREEMENT IN THEIR ENTIRETY.

## SQUARE FOOTAGE & OCCUPANT LOAD

| | SPACE | OCCUPANCY | OCC AREA | CBC FUNCTION | LOAD FACTOR | # OF OCCUPANTS | TOTAL | PLUMBING FIXTURE COUNT - TABLE 4-1 | | | TOTAL |
|---|---|---|---|---|---|---|---|---|---|---|---|
| MERCANTILE | SALES AREA | M | 3171.8 GSF | RETAIL | 1:60 | 52.86 | 55.5 | | | | |
| | BOH | M | 791.8 GFF | STORAGE | 1:300 | 2.64 | | FEMALE | 27.75 | 27.75/100 | 0.28 |
| | DATA/ELEC ROOM | M | 86.6 GSF | ACCESSORY, CIRCULATION | 0 | 0 | | MALE | 27.75 | 27.75/100 | 0.28 |
| | RESTROOMS | M | 134 GSF | ACCESSORY, CIRCULATION | 0 | 0 | | | | | |
| CAFE | BAR AREA | B* | 182 NSF | BUSINESS | 1:150 | 1.21 | 34.53 | | | | |
| | MERCANTILE | B* | 34 NSF | RETAIL | 1:60 | .57 | | | | | |
| | CIRCULATION | B* | 177 NSF | CIRCULATION | 1:15 | 11.85 | | FEMALE | 17.26 | 17.26/25 | 0.69 |
| | SEATING AREA | B* | 49 NSF | UNCONNECTED TABLES & CHAIRS | 1:15 | 3.27 | | MALE | 17.26 | 17.26/50 | 0.35 |
| | FIXED SEATING | B* | 17.6 NSF | BENCH SEATING | 24" PER OCC. | 8.8 | | | | | |
| | CAFE BOH | B* | 193 NSF | KITCHEN | 1:200 | 0.97 | | | | | |
| EXTERIOR | SEATING AREA | B* | 118 NSF | UNCONNECTED TABLES & CHAIRS | 1:15 | 7.87 | | | | | |
| B* = A BUILDING OR TENANT SPACE USED FOR ASSEMBLY PURPOSES WITH AN OCCUPANT LOAD OF LESS THAN 50 PERSONS SHALL BE CLASSIFIED AS A GROUP B OCCUPANCY | | | | | | | | | | | |
| | | | | | | TOTAL OCCUPANTS: | 91 | | | FIXTURE COUNT REQ'D: MALE | 0.62 |
| | | | | | | | | | | FIXTURE COUNT REQ'D: FEMALE | 0.97 |

## LANDLORD NOTES

1. TENANT DRAWINGS ARE TO CLEARLY SHOW ALL MODIFICATIONS TO EXISTING INSTALLATION THAT ARE REQUIRED TO ACCOMMODATE TENANT IMPROVEMENTS.
2. TENANTS MEP DRAWINGS SHALL BE PREPARED AND STAMPED BY A PROFESSIONAL ENGINEER. INDICATE COLUMN LINR DESIGNATIONS ON ALL PLANS.
3. UNLESS ALREADY EXISTING AND IN COMPLIANCE WITH LANDLORDS REQUIREMENTS, TENANT IS REQUIRED TO INSTALL, UPGRADE AND/OR FURNISH ANY AND ALL EQUIPMENT, DUCTWORK, PIPING, ETC. FOR TENANTS MEP SERVICE MEP SERVICE INSTALLATION.
4. THE DESIGN, MATERIALS AND INSTALLATION SHALL CONFORM TO THE BEST CURRENT PRACTICE IN THE RESPECTIVE TRADES AND SHALL BE CONSISTENT WITH GOOD ENGINEERING PRACTICE, MANUFACTURE'S RECOMMENDATIONS, INDUSTRY TECHINCAL REFERENCES AND STANDARDS.
5. ANY MODIFICATIONS OR UPGRADE OF EXISTING BASE BUILDING SERVICES OR CONSTRUCTION MUST RECEIVE THE PRIOR WRITTEN APPROVED FROM THE LANDLORD, PRIOR TO DRAWING SUBMISSION. UPGRADES SHALL BE SUBJECT TO BUILDING CAPACITY AND ACCESS AVAILABILITY.

## TYPICAL OUTLET / DEVICE MOUNTING HEIGHTS

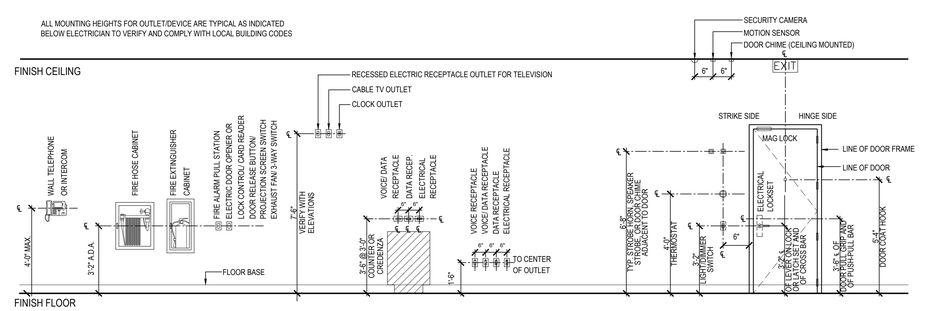
ALL MOUNTING HEIGHTS FOR OUTLET/DEVICE ARE TYPICAL AS INDICATED BELOW ELECTRICIAN TO VERIFY AND COMPLY WITH LOCAL BUILDING CODES
FINISH CEILING
FINISH FLOOR
SECURITY CAMERA
MOTION SENSOR
DOOR CHIME (CEILING MOUNTED)
EXIT
6"
6"
RECESSED ELECTRIC RECEPTACLE OUTLET FOR TELEVISION
CABLE TV OUTLET
CLOCK OUTLET
STRIKE SIDE
HINGE SIDE
MAG LOCK
LINE OF DOOR FRAME
LINE OF DOOR
WALL TELEPHONE OR INTERCOM
4'-0" MAX.
FIRE HOSE CABINET
3'-2" A.D.A.
FIRE EXTINGUISHER CABINET
FIRE ALARM PULL STATION
ELECTRIC DOOR OPENER OR LOCK CONTROL CARD READER
VOICE / DATA OUTLET
PROJECTION SCREEN SWITCH
EXHAUST FAN 3-WAY SWITCH
7'-6" VERIFY WITH ELEVATIONS
FLOOR BASE
VOICE/ DATA RECEPTACLE
DATA RECEP.
ELECTRICAL RECEPTACLE
5'-6" @ 3'-0" COUNTER OR CREDENZA
VO

**P4 - ELASOMERIC PAINT**
BM ESSEX GREEN W/ 10% BLACK

**P5 - ELECTROSTATIC PAINT**
BM ESSEX GREEN W/ 10% BLACK

**EX1 - EXISTING STUCCO**
TERRACOTTA

**RL-L4 - SCONCE**
CHAPMAN & MEYERS - LINEAR LARGE WALL LANTERN (29"H X 9"W X 5"D) - BRONZE METAL 7

**M5 - POWDER COATED METAL**
MATCH BM ESSEX GREEN W/ 10% BLACK

**EX3 - EXISTING PRECAST**
NEUTRAL PIER BASE

**EX2 - EXISTING STUCCO**
GRAY

**M1 - SIGNAGE**
BRONZE

**T1 - HOMOGENOUS EXTERIOR SLATE TILE**
BLACK - 12"X24" 1

**EX4 - EXISTING PAVERS**
-

**M6 - METAL**
BLACKENED. MATTE.

**G1 - STOREFRONT GLAZING**

RALPH LAUREN

**SPACE PLAN**

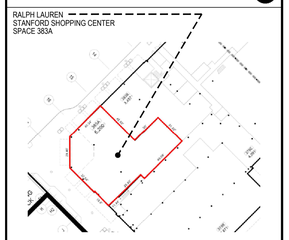


Lam+Tea Engineering

**SUBMISSION FOR ARCHITECTURAL REVIEW BOARD**

| NO. | REVISION | DATE | BY |
|---|---|---|---|
| 9 | A.R.B. CORRECTIONS 2 (7) | 07.22.2025 | TPG |
| 8 | PERMIT CORRECTIONS 2 (6) | 07.02.2025 | TPG |
| 7 | A.R.B. CORRECTIONS 1 (5) | 05.30.2025 | TPG |
| 6 | BOARD OF HEALTH CORRECTIONS (4) | 04.18.2025 | TPG |
| 5 | LATEST FULL SET UPDATES (3) | 04.14.2025 | TPG |
| 4 | PERMIT CORRECTIONS 1 (2) | 05.23.2025 | TPG |
| 3 | BID ADDENDUM 1 (1) | 03.11.2025 | TPG |
| 2 | ISSUED FOR BID & PERMIT | 01.10.2025 | TPG |
| 1 | PROGRESS SET FOR CLIENT REVIEW | 12.13.2024 | TPG |

TPG Architecture

**TPG ARCHITECTURE, LLP**
**31 PENN PLAZA**
**132 WEST 31ST STREET, 5TH FLOOR, NEW YORK, NY 10001**
**212.768.0800 | TPGARCHITECTURE.COM**

IN CONSIDERATION OF RECEIVING DRAWINGS FROM TPG ARCHITECTURE LLP IN AN ELECTRONIC FORM, THE RECIPIENT AGREES, TO THE FULLEST EXTENT PERMITTED BY LAW, TO HOLD HARMLESS AND INDEMNIFY TPG ARCHITECTURE LLP FROM AND AGAINST ALL CLAIMS, LIABILITIES, LOSSES, DAMAGES, AND COSTS, INCLUDING BUT NOT LIMITED TO ATTORNEYS FEES, ARISING OUT OF, OR IN ANY WAY CONNECTED WITH THE USE, RE-USE, MIS-USE, MODIFICATION, OR MISINTERPRETATION OF THE MACHINE-READABLE INFORMATION PROVIDED BY TPG ARCHITECTURE LLP UNDER THIS AGREEMENT.

PROJECT
**RALPH LAUREN**
**STANFORD SHOPPING CENTER**
180 EL CAMINO REAL #383A, BLDG. M
PALO ALTO, CA 94304

DRAWING
MATERIALS BOARD

FOR ARB EXHIBIT

SEAL

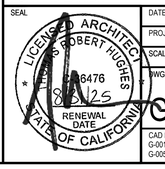


| | |
|---|---|
| DATE | XX/XX/2024 |
| PROJECT NO. | 1524879-00 |
| SCALE | SEE DWG |
| DWG NO. | G-002.00 |
| CAD FILE NO. | G-001.00 - G-005.00_GENERAL.DWG |
| PAGE | 5 of 75 |

K:\24\1524879.0008_DRAWINGS\D_CAD\2_SHEETS\G-001.00 - G-005.00_GENERAL.DWG | Plot Date: Jan 8, 2025 - 9:49 PM
Last Saved By: HISAM | Save Date: 1/6/2025 5:22:53 PM

EXISTING FACADE (WEST ELEVATION)

EXISTING FACADE (SOUTHWEST ELEVATION)

EXISTING FACADE (SOUTH ELEVATION)

SHOWN FOR REFERENCE ONLY

RALPH LAUREN

SPACE PLAN

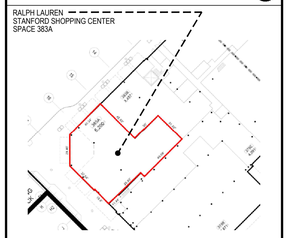


Lam+Tea Engineering

kpff

**SUBMISSION FOR ARCHITECTURAL REVIEW BOARD**

| NO. | REVISION | | DATE | BY |
|---|---|---|---|---|
| 9 | A.R.B. CORRECTIONS 2 | 7 | 07.22.2025 | TPG |
| 8 | PERMIT CORRECTIONS 2 | 6 | 07.02.2025 | TPG |
| 7 | A.R.B. CORRECTIONS 1 | 5 | 05.30.2025 | TPG |
| 6 | BOARD OF HEALTH CORRECTIONS | 4 | 04.18.2025 | TPG |
| 5 | LATEST FULL SET UPDATES | 3 | 04.14.2025 | TPG |
| 4 | PERMIT CORRECTIONS 1 | 2 | 05.23.2025 | TPG |
| 3 | BID ADDENDUM 1 | 1 | 03.11.2025 | TPG |
| 2 | ISSUED FOR BID & PERMIT | | 01.10.2025 | TPG |
| 1 | PROGRESS SET FOR CLIENT REVIEW | | 12.13.2024 | TPG |

TPG Architecture

**TPG ARCHITECTURE, LLP**
**31 PENN PLAZA**
**132 WEST 31ST STREET, 5TH FLOOR, NEW YORK, NY 10001**
**212.768.0800 | TPGARCHITECTURE.COM**

IN CONSIDERATION OF RECEIVING DRAWINGS FROM TPG ARCHITECTURE LLP IN AN ELECTRONIC FORM, THE RECIPIENT AGREES, TO THE FULLEST EXTENT PERMITTED BY LAW, TO HOLD HARMLESS AND INDEMNIFY TPG ARCHITECTURE LLP FROM AND AGAINST ALL CLAIMS, LIABILITIES, LOSSES, DAMAGES, AND COSTS, INCLUDING BUT NOT LIMITED TO ATTORNEY'S FEES, ARISING OUT OF, OR IN ANY WAY CONNECTED WITH THE USE, RE-USE, MIS-USE, MODIFICATION, OR MISINTERPRETATION OF THE MACHINE-READABLE INFORMATION PROVIDED BY TPG ARCHITECTURE LLP UNDER THIS AGREEMENT.

PROJECT

**RALPH LAUREN**
**STANFORD SHOPPING CENTER**
180 EL CAMINO REAL #383A, BLDG. M
PALO ALTO, CA 94304

DRAWING

EXISTING EXTERIOR VIEWS

FOR ARB EXHIBIT

SEAL

LICENSED ARCHITECT
THOMAS ROBERT HUGHES
6476
08/31/25
RENEWAL DATE
STATE OF CALIFORNIA

| | |
|---|---|
| DATE | XX/XX/2024 |
| PROJECT NO. | 1524879-00 |
| SCALE | |
| DWG NO. | G-003.00 |
| CAD FILE NO. | G-006.00 G-010.00_GENERAL CA SHEETS.DWG |
| PAGE | 3 of 75 |

K:\01\1524879.0008_DRAWINGS_CAD\2_SHEETS\G-006.00 - G-010.00_GENERAL CA SHEETS.DWG | Plot Date: Jan. 15, 2025 - 11:08 AM
Last Saved By: MHAMANN | Save Date: 1/13/2025 7:02:32 PM

RENDERED FACADE (WEST ELEVATION)

RENDERED FACADE (SOUTHWEST ELEVATION)

RENDERED FACADE (SOUTHWEST ELEVATION)

RENDERED FACADE (SOUTH ELEVATION)

SHOWN FOR REFERENCE ONLY

RALPH LAUREN

SPACE PLAN

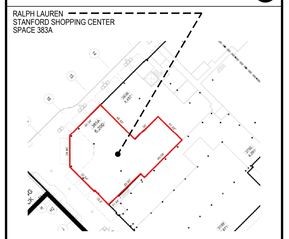


Lam+Tea Engineering

kpff

**SUBMISSION FOR ARCHITECTURAL REVIEW BOARD**

| NO. | REVISION | DATE | BY |
|---|---|---|---|
| 9 | A.R.B. CORRECTIONS 2 (1) | 07.22.2025 | TPG |
| 8 | PERMIT CORRECTIONS 2 (6) | 07.02.2025 | TPG |
| 7 | A.R.B. CORRECTIONS 1 (5) | 05.30.2025 | TPG |
| 6 | BOARD OF HEALTH CORRECTIONS (4) | 04.18.2025 | TPG |
| 5 | LATEST FULL SET UPDATES (3) | 04.14.2025 | TPG |
| 4 | PERMIT CORRECTIONS 1 (2) | 05.23.2025 | TPG |
| 3 | BID ADDENDUM 1 (1) | 03.11.2025 | TPG |
| 2 | ISSUED FOR BID & PERMIT | 01.10.2025 | TPG |
| 1 | PROGRESS SET FOR CLIENT REVIEW | 12.13.2024 | TPG |

TPG Architecture

**TPG ARCHITECTURE, LLP**
**31 PENN PLAZA**
**132 WEST 31ST STREET, 5TH FLOOR, NEW YORK, NY 10001**
**212.768.0800 | TPGARCHITECTURE.COM**

IN CONSIDERATION OF RECEIVING DRAWINGS FROM TPG ARCHITECTURE LLP IN AN ELECTRONIC FORM, THE RECIPIENT AGREES, TO THE FULLEST EXTENT PERMITTED BY LAW, TO HOLD HARMLESS AND INDEMNIFY TPG ARCHITECTURE LLP FROM AND AGAINST ALL CLAIMS, LIABILITIES, LOSSES, DAMAGES, AND COSTS, INCLUDING BUT NOT LIMITED TO ATTORNEY'S FEES, ARISING OUT OF, OR IN ANY WAY CONNECTED WITH THE USE, RE-USE, MIS-USE, MODIFICATION, OR MISINTERPRETATION OF THE MACHINE-READABLE INFORMATION PROVIDED BY TPG ARCHITECTURE LLP UNDER THIS AGREEMENT.

PROJECT
**RALPH LAUREN**
**STANFORD SHOPPING CENTER**
180 EL CAMINO REAL #383A, BLDG. M
PALO ALTO, CA 94304

DRAWING
PROPOSED RENDERED EXTERIOR VIEWS

FOR ARB EXHIBIT

SEAL

LICENSED ARCHITECT
ROBERT HUGHES
6476
8/31/25
RENEWAL DATE
STATE OF CALIFORNIA

| | |
|---|---|
| DATE | XX/XX/2024 |
| PROJECT NO. | 1524879-00 |
| SCALE | |
| DWG NO. | G-004.00 |
| CAD FILE NO. | G-006.00 - G-010.00_GENERAL CA SHEETS.DWG |
| PAGE | 3 of 75 |

K:\24\1524879.0006_DRAWINGS\3_CAD\2_SHEETS\G-006.00 - G-010.00_GENERAL CA SHEETS.DWG | Print Date: Jan. 15, 2025 - 11:08 AM
Last Saved By: MHAMANN | Save Date: 1/13/2025 7:02:22 PM

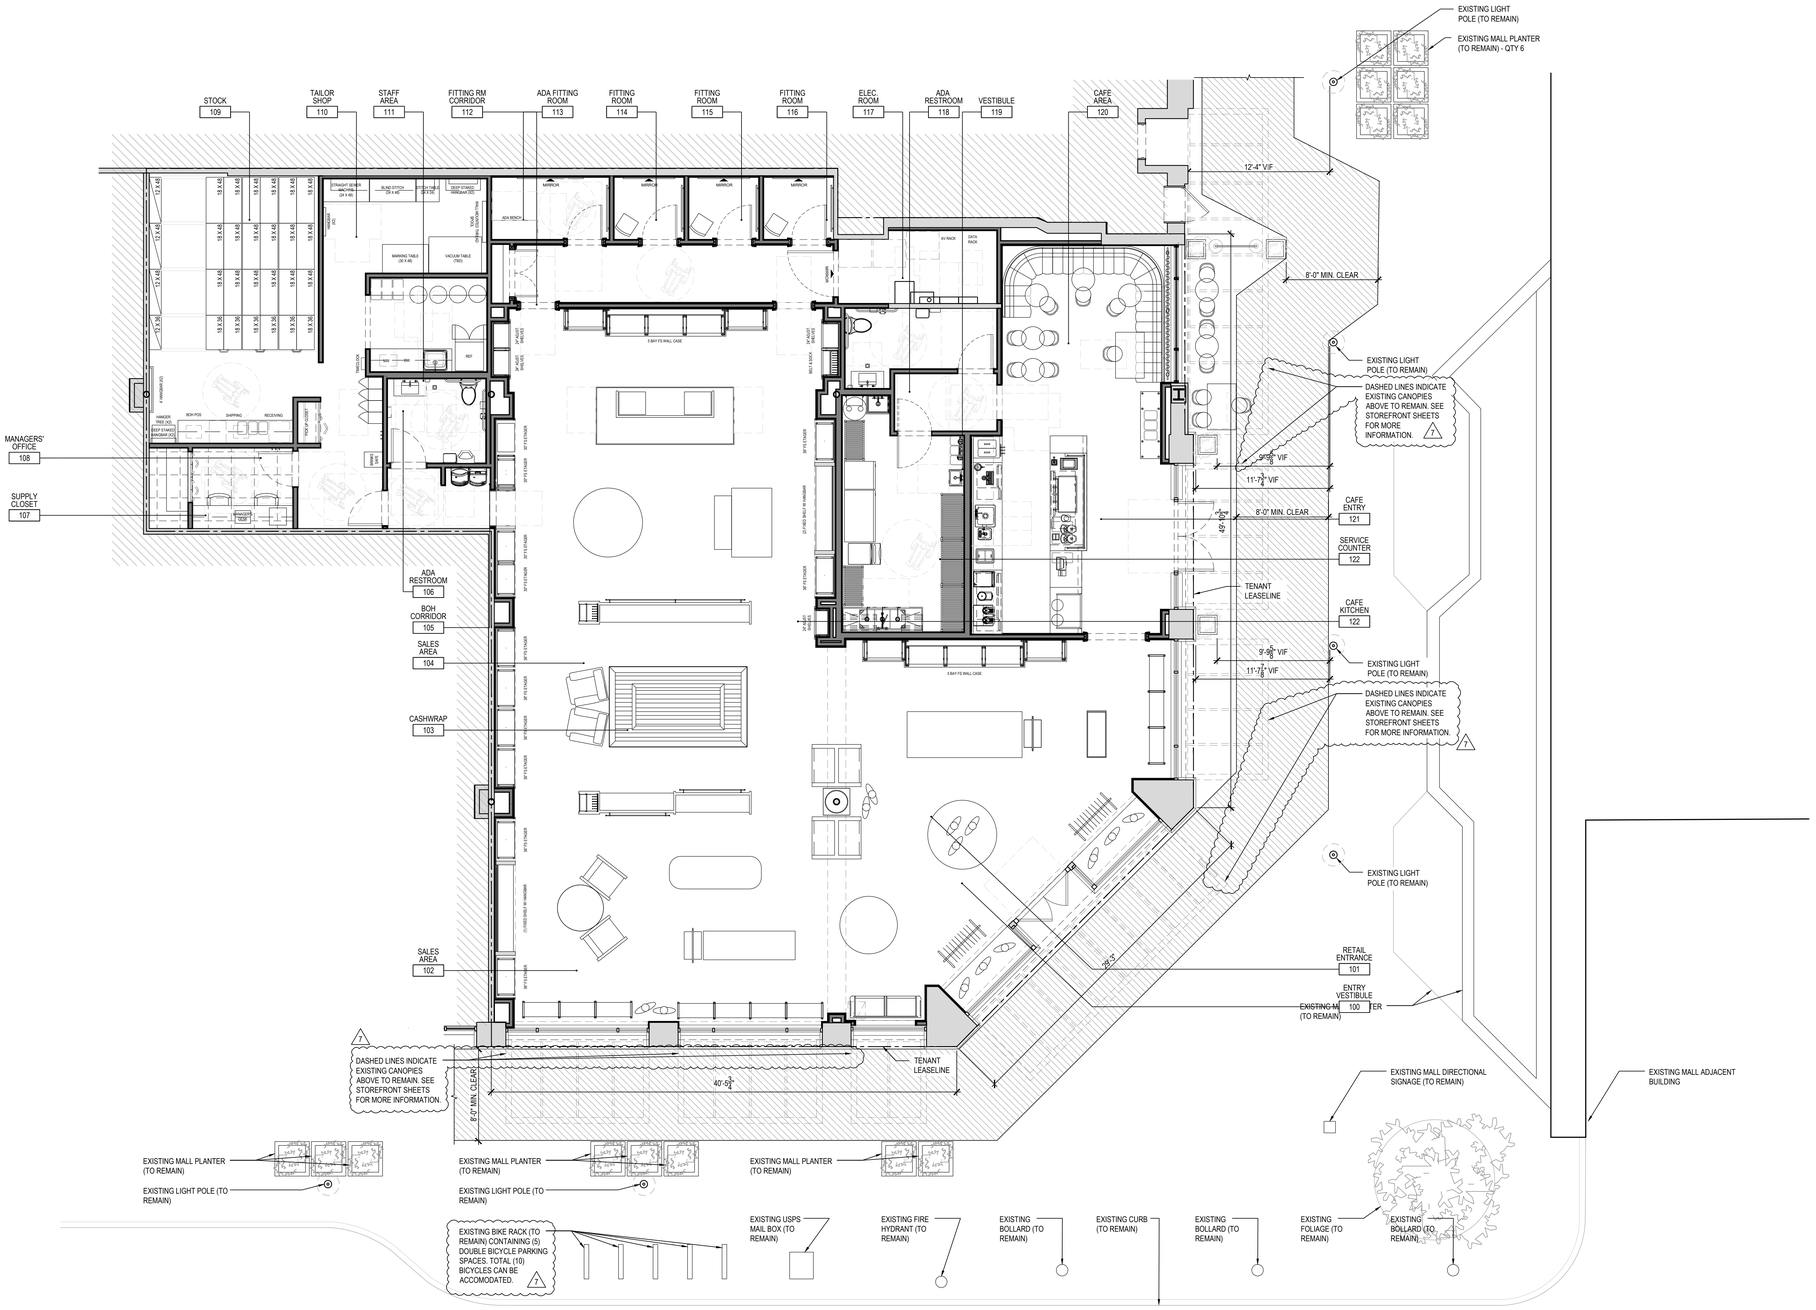


EXISTING TO REMAIN EXTERIOR FEATURES INDICATED. SEE A-501 FOR PROPOSED EXTERIOR FURNITURE AND FEATURES.

1 **EGRESS & LIFE SCALE: 3/16"=1'-0"**

RALPH LAUREN

## SPACE PLAN

RALPH LAUREN
STANFORD SHOPPING CENTER
SPACE 383A

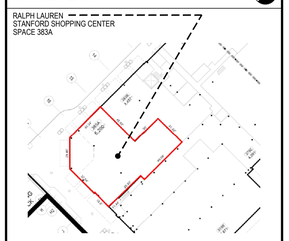

Lam+Tea Engineering

kpff

## SUBMISSION FOR ARCHITECTURAL REVIEW BOARD

| NO. | REVISION | | DATE | BY |
|---|---|---|---|---|
| 9 | A.R.B. CORRECTIONS 2 | 7 | 07.22.2025 | TPG |
| 8 | PERMIT CORRECTIONS 2 | 6 | 07.02.2025 | TPG |
| 7 | A.R.B. CORRECTIONS 1 | 5 | 05.30.2025 | TPG |
| 6 | BOARD OF HEALTH CORRECTIONS | 4 | 04.18.2025 | TPG |
| 5 | LATEST FULL SET UPDATES | 3 | 04.14.2025 | TPG |
| 4 | PERMIT CORRECTIONS 1 | 2 | 05.23.2025 | TPG |
| 3 | BID ADDENDUM 1 | 1 | 03.11.2025 | TPG |
| 2 | ISSUED FOR BID & PERMIT | | 01.10.2025 | TPG |
| 1 | PROGRESS SET FOR CLIENT REVIEW | | 12.13.2024 | TPG |

TPG Architecture


**TPG ARCHITECTURE, LLP**
**31 PENN PLAZA**
**132 WEST 31ST STREET, 5TH FLOOR, NEW YORK, NY 10001**
**212.768.0800 | TPGARCHITECTURE.COM**



IN CONSIDERATION OF RECEIVING DRAWINGS FROM TPG ARCHITECTURE LLP IN AN ELECTRONIC FORM, THE RECIPIENT AGREES, TO THE FULLEST EXTENT PERMITTED BY LAW, TO HOLD HARMLESS AND INDEMNIFY TPG ARCHITECTURE LLP FROM AND AGAINST ALL CLAIMS, LIABILITIES, LOSSES, DAMAGES, AND COSTS, INCLUDING BUT NOT LIMITED TO ATTORNEY'S FEES, ARISING OUT OF, OR IN ANY WAY CONNECTED WITH THE USE, RE-USE, MIS-USE, MODIFICATION, OR MISINTERPRETATION OF THE MACHINE-READABLE INFORMATION PROVIDED BY TPG ARCHITECTURE LLP UNDER THIS AGREEMENT.


PROJECT
**RALPH LAUREN**
**STANFORD SHOPPING CENTER**
180 EL CAMINO REAL #383A, BLDG. M
PALO ALTO, CA 94304

DRAWING
EXTERIOR SITE PLAN

FOR ARB EXHIBIT

SEAL

LICENSED ARCHITECT — THOMAS ROBERT HUGHES — 26476 — RENEWAL DATE 08.31.25 — STATE OF CALIFORNIA

| | |
|---|---|
| DATE | 04/18/2025 |
| PROJECT NO. | 1524879-00 |
| SCALE | 3/16"=1'-0" |
| DWG NO. | G-005.00 |
| CAD FILE NO. | G-005.00_SITE PLAN.DWG |
| PAGE | 16 of 55 |


K:\241524879.0008_DRAWINGS\4_OUTPUT\BLUSH\20250530 ARB CORRECTIONS 1_REVT 6\ARCHIVED\G-005.00_SITE PLAN.DWG | Plot Date: Jul. 23, 2025 - 7:01 AM
Last Saved By: MHAMANI | Save Date: —

# Stanford Shopping Center Parking and Loading Tabulation

**6/30/25 Revision 10**

## GROSS FLOOR AREA (GFA) for Parking

| BUILDING | BASEMENT | GROUND | 2ND | 3RD | OUTDOOR | TOTAL |
|---|---|---|---|---|---|---|
| C-North | | 26,213 | 11,988 | | 0 | 38,201 |
| C-South | | 30,754 | 7,546 | | 0 | 38,300 |
| D | | 62,860 | 16,834 | | 186 | 79,880 |
| E | | 27,452 | 12,678 | | 2,386 | 42,516 |
| F | 15,459 | 44,527 | 6,565 | | 0 | 66,551 |
| H | | 21,584 | 0 | | 0 | 21,584 |
| L | | 23,610 | 2,467 | | 784 | 26,861 |
| M | | 55,048 | 13,596 | | 0 | 68,644 |
| N | | 20,403 | 2,710 | | 0 | 23,113 |
| P | | 9,955 | | | 0 | 9,955 |
| V | | 30,859 | 32,637 | | 1,674 | 65,170 |
| W | | 10,630 | 0 | | 1,148 | 11,778 |
| AA | | 29,306 | 607 | | 0 | 29,913 |
| BB | | 25,979 | 25,995 | | 174 | 52,148 |
| CC | | 16,493 | 0 | | 0 | 16,493 |
| DD | | 16,823 | 16,825 | | 546 | 34,194 |
| EE (Future) | | 11,799 | 0 | | 1,246 | 13,045 |
| FF (Future) | | 22,268 | 6,473 | | | 28,741 |
| Bloomingdale's* | | 120,000 | | | | 120,000 |
| Macy's* | | 225,830 | | | | 225,830 |
| Neiman Marcus* | | 120,000 | | | | 120,000 |
| Flemings | | 7,088 | | | 1,176 | 8,264 |
| Nordstrom* | | 180,000 | | | | 180,000 |
| Container Store | | 24,116 | | | | 24,116 |
| Crate&Barrel | | 14,530 | 24,643 | | | 39,173 |
| Bank of America | | 4,185 | | | | 4,185 |
| Restoration Hardware | | 17,713 | 15,524 | 8,613 | | 41,850 |
| **TOTAL** | **15,459** | **1,200,025** | **197,088** | **8,613** | **9,320** | **1,430,505** |

GBA = Anchors, Small shops, office, storage, utility rooms, trash rooms, back of house, service corridors
GFA = GBA + outdoor space under permanent canopies

## NET FLOOR AREA (NFA) for Entitlements*

| BUILDING | BASEMENT | GROUND | 2ND | 3RD | OUTDOOR | TOTAL |
|---|---|---|---|---|---|---|
| C-North | | 22,136 | 3,694 | | | 25,830 |
| C-South | | 29,277 | 4,418 | | | 33,695 |
| D | | 57,726 | 16,834 | | 186 | 74,746 |
| E | | 24,167 | 0 | | 2,386 | 26,553 |
| F | 8,461 | 40,995 | 4,386 | | | 53,842 |
| H | | 18,979 | 0 | | | 18,979 |
| L | | 21,531 | 0 | | 784 | 22,315 |
| M | | 52,075 | 11,142 | | | 63,217 |
| N | | 20,135 | 2,710 | | | 22,845 |
| P | | 9,955 | 0 | | | 9,955 |
| V | | 28,279 | 31,126 | | | 59,405 |
| W | | 10,008 | 0 | | 1,148 | 11,156 |
| AA | | 28,491 | 607 | | | 29,098 |
| BB | | 20,167 | 22,829 | | 174 | 43,170 |
| CC | | 16,130 | 0 | | | 16,130 |
| DD | | 16,202 | 16,513 | | | 32,715 |
| EE (Future) | | 11,554 | 0 | | 1246 | 12,800 |
| FF (Future) | | 22,268 | 6,473 | | | 28,741 |
| Bloomingdale's* | | 114,000 | | | | 114,000 |
| Macy's* | | 214,539 | | | | 214,539 |
| Neiman Marcus* | | 114,000 | | | | 114,000 |
| Flemings | | 7,220 | | | 1,176 | 8,396 |
| Nordstrom* | | 171,000 | | | | 171,000 |
| Container Store | | 24,116 | | | | 24,116 |
| Crate&Barrel | | 39,173 | | | | 39,173 |
| Bank of America | | 4,185 | | | | 4,185 |
| Restoration Hardware | | 17,711 | 15,524 | 8,613 | | 41,868 |
| **TOTAL** | **8,461** | **1,156,839** | **136,256** | **8,613** | **7,100** | **1,316,869** |
| | | | | | Allowable NFA | 1,412,362 |
| | | | | | Available NFA | **95,893** |

NFA = GFA - mall office space, sealed off space and common area

NOTES:
* Includes 5% reduction in Anchor Store GFA for space classified as 'non-occupied' to calculate NFA per COPA Planning Dept. letter dated Apr. 23, 2014. Note that the Redevelopment Phase I table ('Existing as of 5/23/12') pre-dated this agreement, thus did not take into account the 5% reduction for NFA, therefore some figures will differ.
** per PAMC Ch. 18.16.060(c) and COPA Planning Dept. letter dated Feb. 27, 2014.
395 Quarry Road (Bank of America) has been deleted from this table. The site has an existing 4,185 sf building, 21 parking spaces and is zoned CN. The property is managed by Simon, but is not counted towards Stanford Shopping Center FAR (Gross & Net) as it is not within the PAMC 18.16.030(d) definition of "Stanford Shopping Center" properties which are defined as all properties zoned CC and bounded by El Camino Real, Sand Hill Road, Quarry Road, and Vineyard Lane.

| Loading Space | Required 3/First 120k sf | Required 1/50k sf over 120k sf | Required | Existing | Proposed | Deficient |
|---|---|---|---|---|---|---|
| 3/70,000 -120,000 sf with 1 additional space per 50,000 sf over 120,000 sf | 3 | 26 | 29 | 24 | 25 | 4 |

| Vehicular Parking Provided by Space Type | Notes | Regular | ADA | ADA Van Accessible | Standard EVSE | ADA EVSE*** | Standard EV (Ready) | ADA EV (Ready) | Physical Stall Subtotal | Dedicated Parking** | s2PK EVSE*** | TOTAL |
|---|---|---|---|---|---|---|---|---|---|---|---|---|
| Required Parking Spaces 1/275 GFA | | | | | | | | | | | | 5,202 |
| Total Parking Spaces | | 5,035 | 90 | 23 | 45 | 1 | 61 | 1 | 5,256 | -11 | 1 | 5,246 |
| **Excess number of spaces (Proposed - Required and Dedicated Spaces)** | | | | | | | | | | | | 44 |

*Per AB1100: EVSE & EV Ready Van accessible & accessible spaces adjacent to an accessible path of travel are counted as 2 spaces towards the parking total
**Dedicated parking spaces are not included in the parking total. The dedicated spaces are for the following Tesla EV = 5, Rivian EV = 4, Rivian Regular = 2

1 PARKING AND LOAD TABULATION — SCALE: NTS

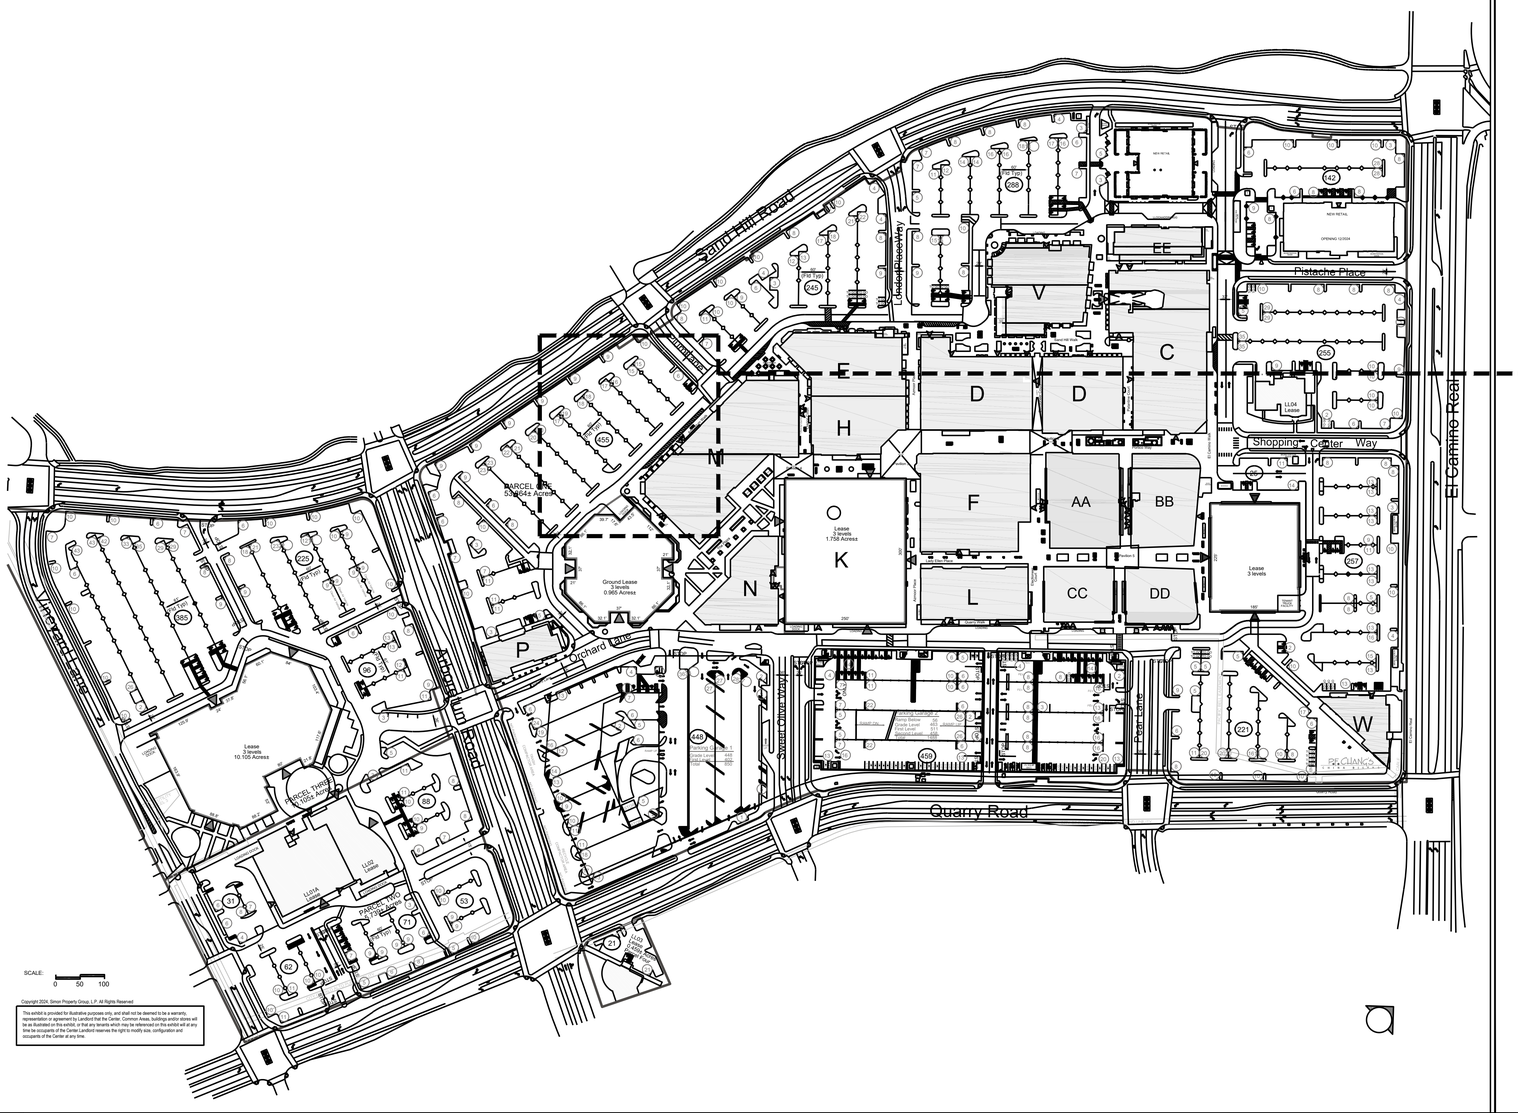

1 SIGNAGE - OPTION A SCALE: NTS

## Rubbermaid® Office Recycling Container - 7 Gallon, Blue

Sturdy containers hold paper, cans and bottles for recycling.

- Tough plastic won't crack, chip or dent.
- For offices and cubicles.

H1384 - BLUE
RECYCLING
(1) IN OFFICE
(1) IN BOH WORK STATION

## Rubbermaid® Office Recycling Container - 7 Gallon, Green

Sturdy containers hold paper, cans and bottles for recycling.

- Tough plastic won't crack, chip or dent.
- For offices and cubicles.

H1384 - GREEN
COMPOST
(1) IN OFFICE
(1) IN EA. RESTROOM W/ PAPER TOWEL SIGNAGE

## OFFICE TRASH CANS

**RUBBERMAID®**

Space-efficient trash cans fit under desks.

- Lightweight plastic won't dent, rust or chip.
- Seamless design is easy to clean.
- Rolled rim adds strength, holds up liners.
- **10 Gallon** - Classic kitchen size uses 13-gallon liners.

S9970 - BLACK
LANDFILL
(1) IN OFFICE
(1) IN BOH WORK STATION

PROVIDE SIGNAGE FOR COMPOSTING/RECYCLING/LANDFILL BIN AS INDICATED ON THIS SHEET. SIGNAGE MUST BE ON EACH RECEPTACLE AND VISIBLE.

NOTE: SEE FIXTURE PLAN OF A-120 FOR LOCATION OF ALL RECEPTACLES

2 OFFICE RECYCLING RECEPTACLES SCALE: NTS

3 SIGNAGE - OPTION B SCALE: NTS




4 PAPER TOWEL SIGNAGE SCALE: NTS

SPECIFICATION IS TBD. CLIENT DECO TEAM TO PROVIDE SANITARY NAPKIN DISPOSAL FIXTURE.

NOTE: SEE FIXTURE PLAN OF A-130 FOR LOCATION OF ALL RECEPTACLES

5 RESTROOM SANITARY NAPKIN DISPOSAL SCALE: NTS

## ULINE TRASH CANS WITH WHEELS

TRANSPORT BIN - RECYCLING
ULINE - 95 GAL
H7938 - BLUE

TRANSPORT BIN - COMPOST
ULINE - 95 GAL
H7938 - GREEN

TRANSPORT BIN - LANDFILL
ULINE - 95 GAL
H7938 - BLACK

PROVIDE SIGNAGE FOR COMPOSTING/RECYCLING/LANDFILL BIN AS INDICATED ON THIS SHEET. SIGNAGE MUST BE ON EACH RECEPTACLE AND VISIBLE.

NOTE: SEE FIXTURE PLAN OF A-120 FOR LOCATION OF ALL RECEPTACLES

6 ENLARGED SITE PLAN SCALE: NTS

## SLIM JIM® RECYCLING CONTAINER

**RUBBERMAID®**

Sturdy containers hold paper, cans and bottles for recycling.

- Tough plastic won't crack, chip or dent.
- Fits where space is limited.
- Vented side channels for easy liner removal.
- Dollies and Trolley sold separately.

ULINE - H-2894 - 23 GAL - GREEN
COMPOST

ULINE - H-2894 - 23 GAL - BLUE
RECYCLING

## SLIM JIM® TRASH CANS

**RUBBERMAID®**

Slim and trim to save space.

- Handle design holds liners securely.
- Vented side channels for easy liner removal.
- **Trolley** – Link together and move multiple Slim Jim® trash cans in one trip.
- Lids, Dollies and Trolley sold separately.

S9970 - BLACK
LANDFILL

PROVIDE SIGNAGE FOR COMPOSTING/RECYCLING/LANDFILL BIN AS INDICATED ON THIS SHEET. SIGNAGE MUST BE ON EACH RECEPTACLE AND VISIBLE.

NOTE: SEE FIXTURE PLAN OF A-120 FOR LOCATION OF ALL RECEPTACLES

7 ENLARGED SITE PLAN SCALE: NTS

RALPH LAUREN

## SPACE PLAN

RALPH LAUREN
STANFORD SHOPPING CENTER
SPACE 383A

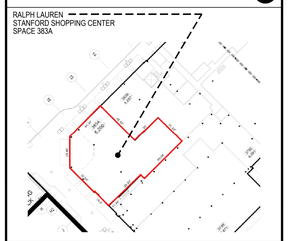

Lam+Tea Engineering

kpff

## SUBMISSION FOR ARCHITECTURAL REVIEW BOARD

| NO. | REVISION | DATE | BY |
|---|---|---|---|
| 9 | A.R.B. CORRECTIONS 2 | 07.22.2025 | TPG |
| 8 | PERMIT CORRECTIONS 2 | 07.02.2025 | TPG |
| 7 | A.R.B. CORRECTIONS 1 | 05.30.2025 | TPG |
| 6 | BOARD OF HEALTH CORRECTIONS | 04.18.2025 | TPG |
| 5 | LATEST FULL SET UPDATES | 04.14.2025 | TPG |
| 4 | PERMIT CORRECTIONS 1 | 05.23.2025 | TPG |
| 3 | BID ADDENDUM 1 | 03.11.2025 | TPG |
| 2 | ISSUED FOR BID & PERMIT | 01.10.2025 | TPG |
| 1 | PROGRESS SET FOR CLIENT REVIEW | 12.13.2024 | TPG |

TPG Architecture

TPG ARCHITECTURE, LLP
31 PENN PLAZA
132 WEST 31ST STREET, 5TH FLOOR, NEW YORK, NY 10001
212.768.0800 | TPGARCHITECTURE.COM

IN CONSIDERATION OF RECEIVING DRAWINGS FROM TPG ARCHITECTURE LLP IN AN ELECTRONIC FORM, THE RECIPIENT AGREES, TO THE FULLEST EXTENT PERMITTED BY LAW, TO HOLD HARMLESS AND INDEMNIFY TPG ARCHITECTURE LLP FROM AND AGAINST ALL CLAIMS, LIABILITIES, LOSSES, DAMAGES, AND COSTS, INCLUDING BUT NOT LIMITED TO ATTORNEY'S FEES, ARISING OUT OF, OR IN ANY WAY CONNECTED WITH THE USE, RE-USE, MIS-USE, MODIFICATION, OR MISINTERPRETATION OF THE MACHINE-READABLE INFORMATION PROVIDED BY TPG ARCHITECTURE LLP UNDER THIS AGREEMENT.

PROJECT
**RALPH LAUREN**
**STANFORD SHOPPING CENTER**
180 EL CAMINO REAL #383A, BLDG. M
PALO ALTO, CA 94304

DRAWING
ZERO WASTE SHEET

FOR ARB EXHIBIT

SEAL

LICENSED ARCHITECT ROBERT HUGHES 26476 STATE OF CALIFORNIA RENEWAL DATE 8/31/25

| | |
|---|---|
| DATE | 01/10/2025 |
| PROJECT NO. | 1524879-00 |
| SCALE | |
| DWG NO. | G-007.00 |
| CAD FILE NO. | G-006.00 - G-010.00_CA SHEETS.DWG |
| PAGE | 10 of 55 |

K:\24\1524879.0098_DRAWINGS\1_CAD\3_SHEETS\G-006.00 - G-010.00_CA SHEETS.DWG | Plot Date: Mar. 20, 2025 - 8:16 AM
Last Saved By: MHAMANN | Save Date: 3/20/2025 8:15:29 AM

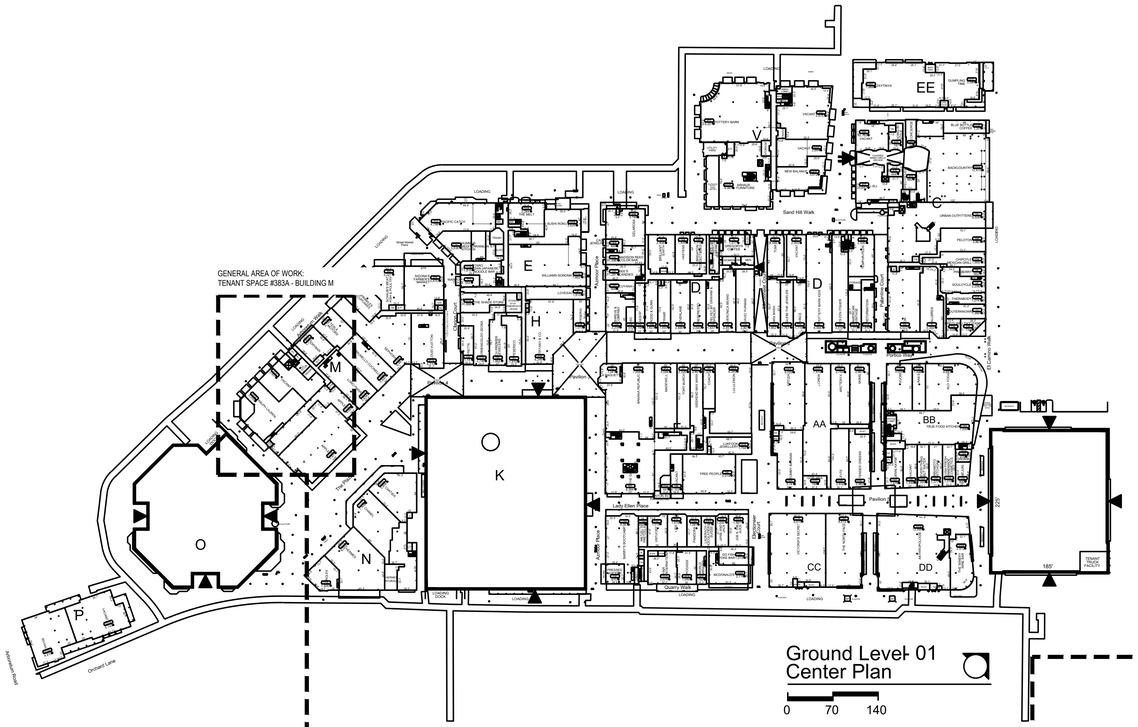


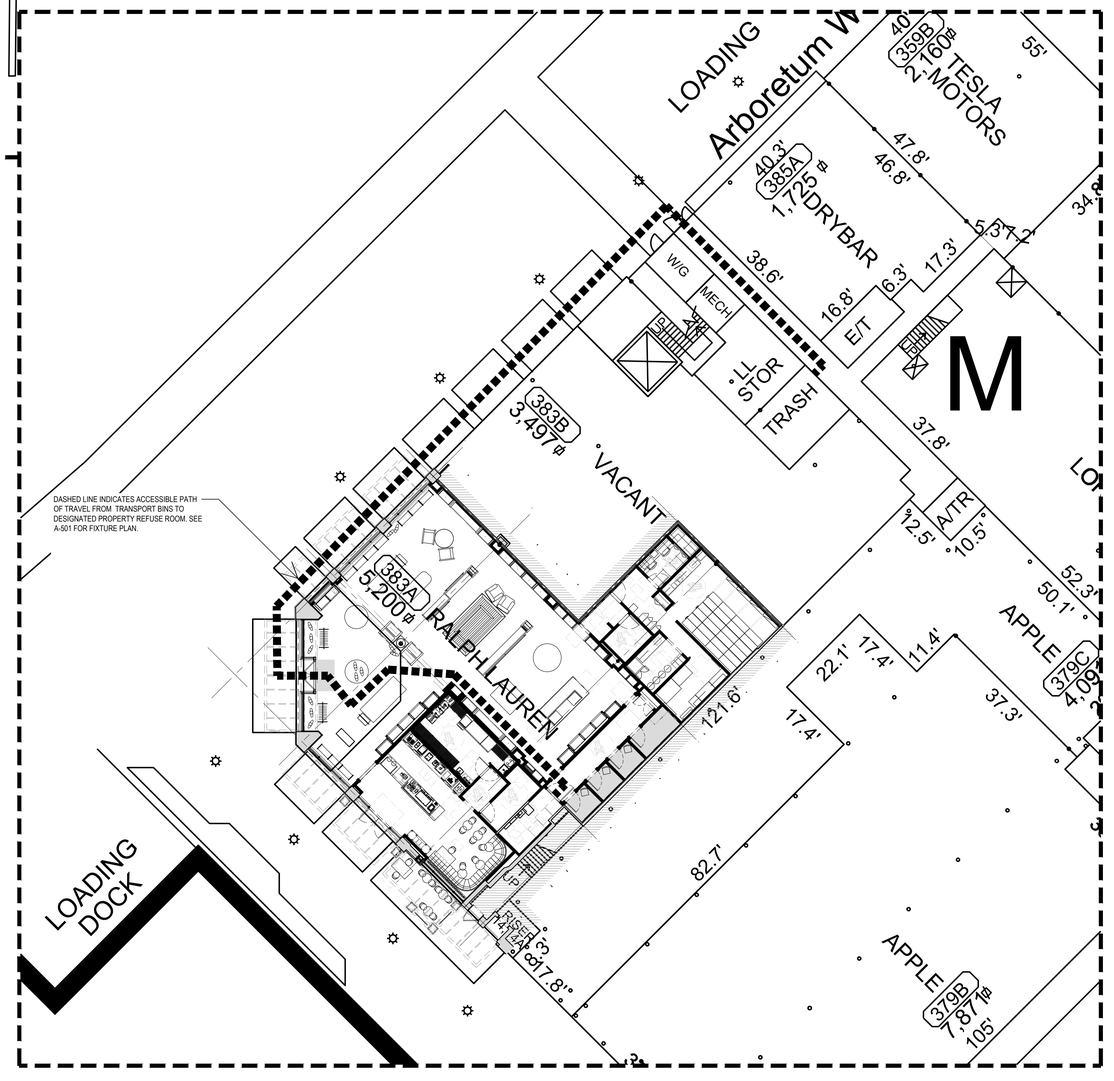


SCALE: 3/16"=1'-0"

RALPH LAUREN

SPACE PLAN

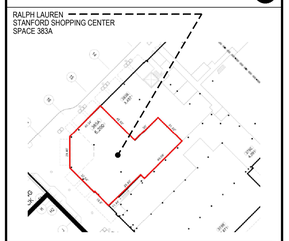


Lam+Tea Engineering

kpff

**SUBMISSION FOR ARCHITECTURAL REVIEW BOARD**

| NO. | REVISION | | DATE | BY |
|---|---|---|---|---|
| 9 | A.R.B. CORRECTIONS 2 | 7 | 07.22.2025 | TPG |
| 8 | PERMIT CORRECTIONS 2 | 6 | 07.02.2025 | TPG |
| 7 | A.R.B. CORRECTIONS 1 | 5 | 05.30.2025 | TPG |
| 6 | BOARD OF HEALTH CORRECTIONS | 4 | 04.18.2025 | TPG |
| 5 | LATEST FULL SET UPDATES | 3 | 04.14.2025 | TPG |
| 4 | PERMIT CORRECTIONS 1 | 2 | 05.23.2025 | TPG |
| 3 | BID ADDENDUM 1 | 1 | 03.11.2025 | TPG |
| 2 | ISSUED FOR BID & PERMIT | | 01.10.2025 | TPG |
| 1 | PROGRESS SET FOR CLIENT REVIEW | | 12.13.2024 | TPG |

TPG Architecture

**TPG ARCHITECTURE, LLP**
**31 PENN PLAZA**
**132 WEST 31ST STREET, 5TH FLOOR, NEW YORK, NY 10001**
**212.768.0800 | TPGARCHITECTURE.COM**

IN CONSIDERATION OF RECEIVING DRAWINGS FROM TPG ARCHITECTURE LLP IN AN ELECTRONIC FORM, THE RECIPIENT AGREES, TO THE FULLEST EXTENT PERMITTED BY LAW, TO HOLD HARMLESS AND INDEMNIFY TPG ARCHITECTURE LLP FROM AND AGAINST ALL CLAIMS, LIABILITIES, LOSSES, DAMAGES, AND COSTS, INCLUDING BUT NOT LIMITED TO ATTORNEY'S FEES, ARISING OUT OF, OR IN ANY WAY CONNECTED WITH THE USE, RE-USE, MIS-USE, MODIFICATION, OR MISINTERPRETATION OF THE MACHINE-READABLE INFORMATION PROVIDED BY TPG ARCHITECTURE LLP UNDER THIS AGREEMENT.

PROJECT

**RALPH LAUREN**
**STANFORD SHOPPING CENTER**
180 EL CAMINO REAL #383A, BLDG. M
PALO ALTO, CA 94304

DRAWING

SITE PLAN - REFUSE BIN TRANSPORT PLAN

FOR ARB EXHIBIT

SEAL

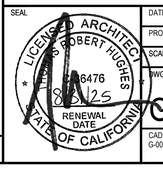


| | |
|---|---|
| DATE | 01/10/2025 |
| PROJECT NO. | 1524879-00 |
| SCALE | |
| DWG NO. | G-008.00 |
| CAD FILE NO. | G-005.00_SITE PLAN.DWG |
| PAGE | 16 of 55 |

K:\241524\BP\00\00_DRAWINGS\4_OUTPUS\ARCH\20250101 ISSUED FOR PERMIT SET\ARB FACADE SET\ARB REVISION 02\20250210-G-005.00_SITE PLAN.DWG | Plot Date: Mar 20, 2025 - 4:01 PM
Last Saved By: MHAMANN | Save Date: 3/20/2025 4:00:17 PM

City of Palo Alto

# Tree Protection - It's Part of the Plan!

Make sure your crews and subs do the job right!

Fenced enclosures around trees are essential to protect them by keeping the foliage canopy and branching structure clear from contact by equipment, materials and activities, preserving roots and soil conditions in an intact and non-compacted state, and identifying the Tree Protection Zone (TPZ) in which no soil disturbance is permitted and activities are restricted, unless otherwise approved. **An approved tree protection report must be added to this sheet when project activity occurs within the TPZ of a regulated tree.**
For detailed information on Palo Alto's regulated trees and protection during development, review the **City Tree Technical Manual** (TTM) found at www.cityofpaloalto.org/trees/.

## TREE DISCLOSURE STATEMENT

CITY OF PALO ALTO
Planning Division, 250 Hamilton Avenue
Palo Alto, CA 94301
(650) 329-2441
http://www.cityofpaloalto.org

Palo Alto Municipal Code, Chapter 8.10.040, requires disclosure and protection of certain trees located on private and public property, and that they be shown on approved site plans. A completed disclosure statement must accompany all building permit applications that include exterior work, all demolition or grading permit applications, or other development activity.

**PROPERTY ADDRESS:** 180 El Camino Real - #383A Bldg M - Palo Alto, CA 94304

**Are there Regulated trees on or adjacent to the property?** ☐ YES ☑ NO (If no, proceed to Section 4)

***[Sections 1- 4 MUST be completed by the applicant. Please circle and/or check where applicable.]***

1. Where are the trees? Check those that apply. **(Plans must be submitted showing over 4" diameter trees)**
   - ☐ On the property
   - ☐ On adjacent property overhanging the project site
   - ☐ In the City planter strip or right-of-way easement within 30' of property line (Street Trees)*

*Street trees **require special protection by a fenced enclosure**, per the attached instructions. Prior to receiving any permit, you must provide an authorized Street Tree Protection Verification form by calling Public Works Operations at 493-5953 for inspection of required type I, II or III fencing (see attached Detail #605).

2. Are there any Protected or Designated Trees? ☐ YES (Check where applicable) ☐ NO
   - ☐ Protected Tree (s)
   - ☐ Designated Tree (s)
   - ☐ On or overhanging the property

3. Is there activity or grading within the dripline? (radius 10 times the trunk diameter) of these trees? ☐ YES ☐ NO
*If Yes, a **Tree Preservation Report** must be prepared by an ISA certified arborist and submitted for staff review (see TTM , Section 6.25). Attach this report to Sheet T-1, 'Tree Protection, its Part of the Plan!", per Site Plan Requirements.*

4. Are the Site Plan Requirements** completed? ☐ YES ☑ NO

**Protection of Regulated trees during development require the following: (1) Plans must show the measured trunk diameter and canopy dripline; (2) Plans must denote, as a bold dashed line, a fenced enclosure area out to the dripline, per Sheet T-1 and Detail #605 - http://www.cityofpaloalto.org/trees/forms.htm (See also TTM , Section 2.15 for area to be fenced)

**I, the undersigned, agree to the conditions of this disclosure.** I understand that knowingly or negligently providing false or misleading information in response to this disclosure requirement constitutes a violation of the Palo Alto Municipal Code Section 8.10.040, which can lead to criminal and/or civil legal action.

Signature: Margaret Hamann (Prop. Owner or Agent) Print: Margaret Hamann Date: 3/20/25

**FOR STAFF USE:**

**Protective Fencing**
Sections 5-6 must be **completed by staff** for the issuance of any development permit (demolition, grading or building permit).

5. Protected Trees. The specified tree fencing is in place. A written statement is attached verifying that protective fencing is correctly in place around protected and/or designated trees. (N/A if there are no protected trees, check here ☐) ☐ YES ☐ NO

6. Street Trees. A signed Public Works Street Tree Protection Verification form is attached. (N/A if there are no street trees, check here ☐) ☐ YES ☐ NO

Regulated Trees – a) Street trees – trees on public property; b) Protected trees – Coast Live Oaks or Valley Oaks which are 11.5" in diameter or larger, Coast Redwoods which are 18" in diameter or larger, when measured 54" above natural grade; and Heritage trees are trees designated by City Council; and c) Designated Trees – commercial or non-residential property trees, which are part of an approved landscape plan.

Palo Alto Tree Technical Manual (TTM) contains instructions for all requirements on this form, available at http://www.cityofpaloalto.org/planning-community/tree_technical-manual.html

S:Plan/Pladiv/Arborist/Tree Protection Info/Tree Disclosure Statement — Revised 08/06

## City of Palo Alto
250 Hamilton Avenue, Palo Alto, CA 94301

Search: Advanced Browse By Topic
Home > Planning & Community Environment

Home
City-owned Trees
Privately-owned Trees
About the Tree Ordinance
Title 8.10
Heritage Trees
Forms
Tree Technical Manual
FAQs
Contact Us
Resources

### Tree Technical Manual

**To purchase the Tree Technical Manual**

**June, 2001 First Edition**

View by section:

- Table of Contents (PDF, 87KB)
- Intent and Purpose (PDF, 1.05MB)
- Introduction - Use of Manual (PDF, 1.05MB)
- Section 1.0 - Definitions (PDF, 96KB)
- Section 2.0 - Protection of Trees During Construction (PDF, 259KB)
- Section 3.0 - Removal, Replacement & Planting of Trees (PDF, 117KB)
- Section 4.0 - Hazardous Trees (PDF, 105KB)
- Section 5.0 - Tree Maintenance Guidelines (PDF, 110KB)
- Section 6.0 - Tree Reports (PDF, 84KB)

**View ALL sections:**

- Tree Technical Manual - Full (PDF, 1.84MB)

**APPENDICES**
A: Palo Alto Municipal Code Chapter 8.10, Tree Preservation & Management Regulations
B: Tree City - USA
C: ISA Hazard Evaluation Form
D: List of Inherent Failure Patterns for Selected Species (Reference source)
E: ISA Tree Pruning Guidelines (PDF, 1.85MB)
F: Tree Care Safety Standards, ANSI Z133.1-1994 (Reference source)
G: Pruning Performance Standards, ANSI A300-1995 (Reference source) H: Tree Planting Details, Diagram 504 & 505
I: Tree Disclosure Statement
J: Palo Alto Standard Tree Protection Instructions

**For written specifications associated with illustrations below, see Public Works Specifications Section 31**
**Detailed specifications are found in the Palo Alto Tree Technical Manual (TTM) (www.cityofpaloalto.org/trees/)**

**Tree Protection Zone (TPZ)** shown in gray (radius of TPZ equals 10-times the diameter of the tree at 10-feet, whichever is greater).
★ Restricted activity area -- see Tree Technical Manual Sec 2.15(E).
★ Restricted trenching area -- see Tree Technical Manual Sec 2.20(C-D), any proposed trench or form work within TPZ of a protected tree requires approval from Public Works Operations. Call 650-496-5953.

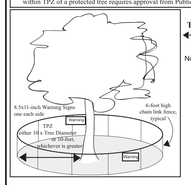


**Type I Tree Protection**

For all Ordinance Protected and Designated trees, as detailed in the site specific tree preservation report (TPR) prepared by the applicant's project arborist as diagramed on the plans.

Note: Ordinance Protected & Designated Trees. Issuance of a permit requires applicant's project arborist written verification Type I is installed correctly according to the plans and Tree Preservation Report

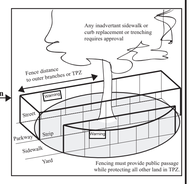


**Type II Tree Protection**

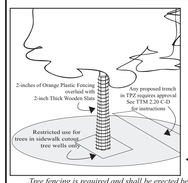


Note: Street Trees. Issuance of a permit requires Public Works Operations inspection and signed approval on the Street Tree Verification (STV) form provided.

**Type III Tree Protection**
(to be used only with approval of Public Works Operations)

*Tree fencing is required and shall be erected before demolition, grading or construction begins.*

| Rev | By | Date |
|---|---|---|
| 0 | DWH | 12/14/92 |
| 01 | D.D. | 08/04/04 |
| #2 | D.D. | 08/10/06 |

Tree Protection During Construction

Scale: NTS — City of Palo Alto Standard

Approved by: Dave Dockter
PE No. ____
Date 2006
Dwg No. 605

**APPENDIX J**

**PALO ALTO**
**STREET TREE PROTECTION INSTRUCTIONS**
**--SECTION 31--**

**31-1 General**

**a. Tree protection has three primary functions**, 1) to keep the foliage canopy and branching structure clear from contact by equipment, materials and activities; 2) to preserve roots and soil conditions in an intact and non-compacted state and 3) to identify the Tree Protection Zone (TPZ) in which no soil disturbance is permitted and activities are restricted, unless otherwise approved.

**b. The Tree Protection Zone (TPZ)** is a restricted area around the base of the tree with a radius of ten-times the diameter of the tree's trunk or ten feet; whichever is greater, enclosed by fencing.

**31-2 Reference Documents**

**a. Detail 605** – Illustration of situations described below.

**b. Tree Technical Manual (TTM) Forms** (http://www.cityofpaloalto.org/trees)
1. Trenching Restriction Zones (TTM, Section 2.20(C))
2. Arborist Reporting Protocol (TTM, Section 6.30)
3. Site Plan Requirements (TTM, Section 6.33)
4. Tree Disclosure Statement (TTM, Appendix D)

**c. Street Tree Verification (STV) Form** (http://www.cityofpaloalto.org/trees/forms)

**31-3 Execution**

**a. Type I Tree Protection:** The fence shall enclose the entire TPZ of the tree(s) to be protected throughout the life of the construction project. In some parking areas, if fencing is located on paving or concrete that will not be demolished, then the posts may be supported by an appropriate grade level concrete base, if approved by Public Works Operations.

**b. Type II Tree Protection:** For trees situated within a planting strip, only the planting strip and yard side of the TPZ shall be enclosed with the required chain link protective fencing in order to keep the sidewalk and street open for public use.

**c. Type III Tree Protection:** To be used only with approval of Public Works Operations. Trees situated in a tree well or sidewalk planter pit, shall be wrapped with 2-inches of orange plastic fencing from the ground to the first branch and overlaid with 2-inch thick wooden slats bound securely (slats shall not be allowed to dig into the bark). During installation of the plastic fencing, caution shall be used to avoid damaging any branches. Major limbs may also require plastic fencing as directed by the City Arborist.

**d. Size, type and area to be fenced.** All trees to be preserved shall be protected with six (6') foot high chain link fences. Fences are to be mounted on two-inch diameter galvanized iron posts, driven into the ground to a depth of at least 2-feet at no more than 10-foot spacing. Fencing shall extend to the outer branching, unless specifically approved on the STV Form.

**e. 'Warning' signs**. A warning sign shall be weather proof and prominently displayed on each fence at 20-foot intervals. The sign shall be minimum 8.5-inches x 11-inches and clearly state in half inch tall letters:
"WARNING - Tree Protection Zone - This fence shall not be removed and is subject to a fine according to PAMC Section 8.10.110."

**f. Duration**. Tree fencing shall be erected before demolition; grading or construction begins and remain in place until final inspection of the project, except for work specifically allowed in the TPZ. Work or soil disturbance in the TPZ requires approval by the project arborist or City Arborist (in the case of work around Street Trees). Excavations within the public right of way require a Street Work Permit from Public Works.

**g. During construction**

1. All neighbors' trees that overhang the project site shall be protected from impact of any kind.
2. The applicant shall be responsible for the repair or replacement plus penalty of any publicly owned trees that are damaged during the course of construction, pursuant to Section 8.04.070 of the Palo Alto Municipal Code.
3. The following tree preservation measures apply to all trees to be retained:
   - **a.** No storage of material, topsoil, vehicles or equipment shall be permitted within the TPZ.
   - **b.** The ground under and around the tree canopy area shall not be altered.
   - **c.** Trees to be retained shall be irrigated, aerated and maintained as necessary to ensure survival.

END OF SECTION

City of Palo Alto 2004 Standard Drawings and Specifications
Street Tree Verification of Protection, PWE, Section 31 — Revised 08/06

**Table 2-2 Palo Alto Tree Technical Manual**

**CONTRACTOR & ARBORIST INSPECTION SCHEDULE**

Reference: the Palo Alto Tree Technical Manual is available at www.cityofpaloalto.org/environment/

**ALL CHECKED ITEMS APPLY TO THIS PROJECT:**

1. ☑ **Inspection of Protective Tree Fencing**. For Public Trees, the Street Tree Verification Form shall be signed by the City Arborist. For Protected Trees, the project site arborist shall provide an initial Monthly Tree Activity Report form with a photograph verifying that he has conducted a field inspection of the trees and that the correct type of protective fencing is in place around the designated tree protection zone (TPZ) prior to issuance of a demolition, grading, or building permit. (See TTM, Verification of Tree Protection, Section 1.39).
2. ☑ **Pre-Construction Meeting**. Prior to commencement of construction, the applicant or contractor shall conduct a pre-construction meeting to discuss tree protection with the job site superintendent, grading operators, project site arborist, City Arborist, and, if a city maintained irrigation system is involved, the Parks Manager (Contact 650-496-6962).
3. ☑ **Inspection of Rough Grading or Trenching**. Contractor shall ensure the project site arborist performs an inspection during the course of rough grading or trenching adjacent to or within the TPZ to ensure trees will not be injured by compaction, cut or fill, drainage and trenching, and if required, inspect aeration systems, tree wells, drains and special paving. The contractor shall provide the project arborist at least 24 hours advance notice of such activity.
4. ☑ **Monthly Tree Activity Report Inspections**. The project site arborist shall perform a minimum monthly activity inspection to monitor and advise on conditions, tree health and retention or, immediately if there are *any revisions* to the approved plans or protection measures. The Tree Technical Manual Monthly Tree Activity Report format shall be used and sent to the Planning Dept. landscape review staff no later than 14 days after issuance of building permit date. Fax to (650) 329-2154. (See TTM, Monthly Tree Activity Inspection Report, Addendum 11 & section 1.17).
5. ☑ **Special activity within the Tree Protection Zone**. Work in the TPZ area (see also #7 below) requires the direct onsite supervision of the project arborist (see TTM, Trenching, Excavation & Equipment, Section 2.20 C).
6. ☐ **Landscape Architect Inspection**. For discretionary development projects, prior to temporary or final occupancy the applicant or contractor shall arrange for the Landscape Architect to perform an on site inspection of all plant stock, quality of the materials and planting (see TTM, Planting Quality, Section 5.20.1 A) and that the irrigation is functioning consistent with the approved construction plans. The Planning Dept. landscape review staff shall be in receipt of written verification of Landscape Architect approval prior to scheduling the final inspection, unless otherwise approved.
7. ☐ **List Other** (please describe as called out in the site Tree Preservation Report, Sheet T-1, T-2, etc.)
   - * _____
   - * _____

**City of Palo Alto**
**Tree Department**
Public Works Operations
PO Box 10250 Palo Alto, CA 94303
**650/496-5953** FAX: 650/852-9289
treeprotection@CityofPaloAlto.org

**Verification of Street Tree Protection**

*Applicant Instructions: Complete upper portion of this form. Mail or FAX this form along with signed Tree Disclosure Statement to Public Works Dept. Public Works Tree Staff will inspect and notify applicant.*

| | |
|---|---|
| **APPLICATION DATE:** | |
| **ADDRESS/LOCATION OF STREET TREES TO BE PROTECTED:** | |
| **APPLICANT'S NAME:** | |
| **APPLICANT'S ADDRESS:** | |
| **APPLICANT'S TELEPHONE & FAX NUMBERS:** | |

*This section to be filled out by City Tree Staff*

1. The Street Trees at the above address(es) are adequately protected. The type of protection used is: YES ☐ NO* ☐ * If NO, go to #2 below

| | |
|---|---|
| **Inspected by:** | |
| **Date of Inspection:** | |

2. The Street Trees at the above address are **NOT** adequately protected. The following modifications are required: _____
   Indicate how the required modifications were communicated to the applicant. _____

*Subsequent Inspection*

Street trees at above address were found to be adequately protected: YES ☐ NO* ☐ * If NO, indicate in "Notes" below the disposition of case.

| | |
|---|---|
| **Inspected by:** | |
| **Date of Inspection:** | |

**Notes:** List City street trees by species, site, condition and type of tree protection installed. Also note if pictures were taken. Use back of sheet if necessary.

**Return approved sheet to Applicant for demolition or building permit issuance.**

S:PWD/OPS/Tree/DS/St.TreeProtect — 5/1706

City of Palo Alto Tree Technical Manual — ADDENDUM 11

**Arborist Firm Data Here** — email, RCA/ISA Certified Arborist #WE-000, Contract Cell #

**Monthly Tree Activity Report- *Construction Site***

| | | | |
|---|---|---|---|
| **Inspection Date:** _____ **Inspection #**_____ | **Site address:** _____ Palo Alto, CA | **Contractor-Main Site Contact Information** | #1: Job site superintendent Company: Email: Job site Office: Cell: Mail: |
| | | **Also present:** | • _____ • _____ |
| **Distribution:** | 1. City of Palo Alto 2. Others | **Attn: Dave Dockter** | Dave.dockter@cityofpaloalto.org 650-329-2440 |

Provide the neglected minimum information with each report, customize as necessary. To be completed by project site arborist. Send monthly to city arborist at above address until project completion. Use additional sheets as needed.

1. Assignment Activity (Demolition/grading/sewer/trenching/foundation/list relevant visits)
   a. Pre-construction meetag requirement with sub-contractors
   b. Inspect to verify that tree protection measures are in place
   c. Determine if field adjustments, watering or plan revisions may be needed
2. Field Observations (general site-wide and list by individual tree number)
   a. Tree Protection Fences (TPF) are …
   b. Trenching has/will occur …
3. Action Items (list site-wide, by tree number and date to be satisfied) and Date Due
   a. Tree Protection Fence (TPF) needs adjusting (tree # x, x, x)
   b. Root zone buffer material (wood chips) can be installed next
   c. Schedule sewer trench, foundation dig with …
4. Photographs (use often)
5. Tree Location Map (mandatory 8.5 x 11 sheet)
6. Recommendations, notes or monitor items for project/staff/schedule
   •
7. Past visits (list carry-over items satisfied/still outstanding)
   •

Respectfully submitted,

Project site arborist
Consultant contact information (Include email, cell#, and mailing)
Cc:

Enter Date — CPA Monthly Tree Activity Report: Type site address here — Page #1 of 1

## ---WARNING---
## Tree Protection Zone

**This fencing shall not be removed without City Arborist approval (650-496-5953)**

**Removal without permission is subject to a $500 fine per day***

***Palo Alto Municipal Code Section 8.10.110***

City of Palo Alto Tree Protection Instructions are located at http://www.city.palo-alto.ca.us/trees/technical-manual.html

**SPECIAL INSPECTIONS** — **PLANNING DEPARTMENT**

**TREE PROTECTION INSPECTIONS MANDATORY**

PAMC 8.10 PROTECTED TREES. CONTRACTOR SHALL ENSURE PROJECT SITE ARBORIST IS PERFORMING REQUIRED TREE INSPECTION AND SITE MONITORING. PROVIDE WRITTEN MONTHLY TREE ACTIVITY REPORTS TO THE PLANNING DEPARTMENT LANDSCAPE REVIEW STAFF BEGINNING 14 DAYS AFTER BUILDING PERMIT ISSUANCE.

BUILDING PERMIT DATE: _____

DATE OF 1ST TREE ACTIVITY REPORT: _____

CITY STAFF: _____

REPORTING DETAILS OF THE MONTHLY TREE ACTIVITY REPORT SHALL CONFORM TO SHEET T-1 FORMAT, VERIFY THAT ALL TREE PROTECTION MEASURES ARE IMPLIMENTED AND WILL INCLUDE ALL CONTRACTOR ACTIVITY, SCHEDULED OR UNSCHEDULED, WITHIN A TREE PROTECTION ROOT ZONE. NON-COMPLIANCE IS SUBJECT TO VIOLATION OF PAMC 8.10.080. REFERENCE: PALO ALTO TREE TECHNICAL MANUAL, SECTION 2.00 AND ADDENDUM 11.

Apply Tree Protection Report on sheet(s) T-2

Use addtional "T" sheets as needed

Project Data

T-1

All other tree-related reports shall be added to the space provided on this sheet (adding as needed)
Include this sheet(s) on Project Sheet Index or Legend Page.
A copy of T-1 can be downloaded at
http://www.cityofpaloalto.org/civica/filebank/blobdload.asp?BlobID=6460

# Special Tree Protection Instruction Sheet
City of Palo Alto

T-1

K:\0415879.0098_DRAWINGS\2_CAD\3_SHEETS\G-001.00 - G-005.00_GENERAL.DWG | Plot Date: Jan. 14, 2025 - 6:52 AM
Last Saved By: MHAMANN | Save Date: 1/13/2025 1:04:15 PM

RALPH LAUREN

**SPACE PLAN**

RALPH LAUREN
STANFORD SHOPPING CENTER
SPACE 383A

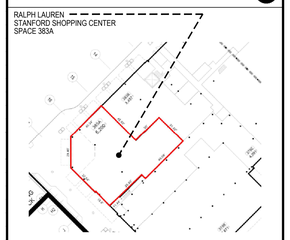

Lam+Tea Engineering

kpff

**SUBMISSION FOR ARCHITECTURAL REVIEW BOARD**

| NO. | REVISION | | DATE | BY |
|---|---|---|---|---|
| 9 | A.R.B. CORRECTIONS 2 | 7 | 07.22.2025 | TPG |
| 8 | PERMIT CORRECTIONS 2 | 6 | 07.02.2025 | TPG |
| 7 | A.R.B. CORRECTIONS 1 | 5 | 05.30.2025 | TPG |
| 6 | BOARD OF HEALTH CORRECTIONS | 4 | 04.18.2025 | TPG |
| 5 | LATEST FULL SET UPDATES | 3 | 04.14.2025 | TPG |
| 4 | PERMIT CORRECTIONS 1 | 2 | 05.23.2025 | TPG |
| 3 | BID ADDENDUM 1 | 1 | 03.11.2025 | TPG |
| 2 | ISSUED FOR BID & PERMIT | | 01.10.2025 | TPG |
| 1 | PROGRESS SET FOR CLIENT REVIEW | | 12.13.2024 | TPG |

TPG Architecture


**TPG ARCHITECTURE, LLP**
**31 PENN PLAZA**
**132 WEST 31ST STREET, 5TH FLOOR, NEW YORK, NY 10001**
**212.768.0800 | TPGARCHITECTURE.COM**



IN CONSIDERATION OF RECEIVING DRAWINGS FROM TPG ARCHITECTURE LLP IN AN ELECTRONIC FORM, THE RECIPIENT AGREES, TO THE FULLEST EXTENT PERMITTED BY LAW, TO HOLD HARMLESS AND INDEMNIFY TPG ARCHITECTURE LLP FROM AND AGAINST ALL CLAIMS, LIABILITIES, LOSSES, DAMAGES, AND COSTS, INCLUDING BUT NOT LIMITED TO ATTORNEY'S FEES, ARISING OUT OF, OR IN ANY WAY CONNECTED WITH THE USE, RE-USE, MIS-USE, MODIFICATION, OR MISINTERPRETATION OF THE MACHINE-READABLE INFORMATION PROVIDED BY TPG ARCHITECTURE LLP UNDER THIS AGREEMENT.


PROJECT
**RALPH LAUREN**
**STANFORD SHOPPING CENTER**
180 EL CAMINO REAL #383A, BLDG. M
PALO ALTO, CA 94304

DRAWING
TREE PROTECTION PLAN

FOR ARB EXHIBIT

SEAL — LICENSED ARCHITECT ROBERT HUGHES 26476 STATE OF CALIFORNIA RENEWAL DATE 08/31/25

DATE XX/XX/2024
PROJECT NO. 1524879-00
SCALE
DWG NO. T-1
CAD FILE NO. G-001.00 - G-005.00_GENERAL.DWG
PAGE 2 of 75

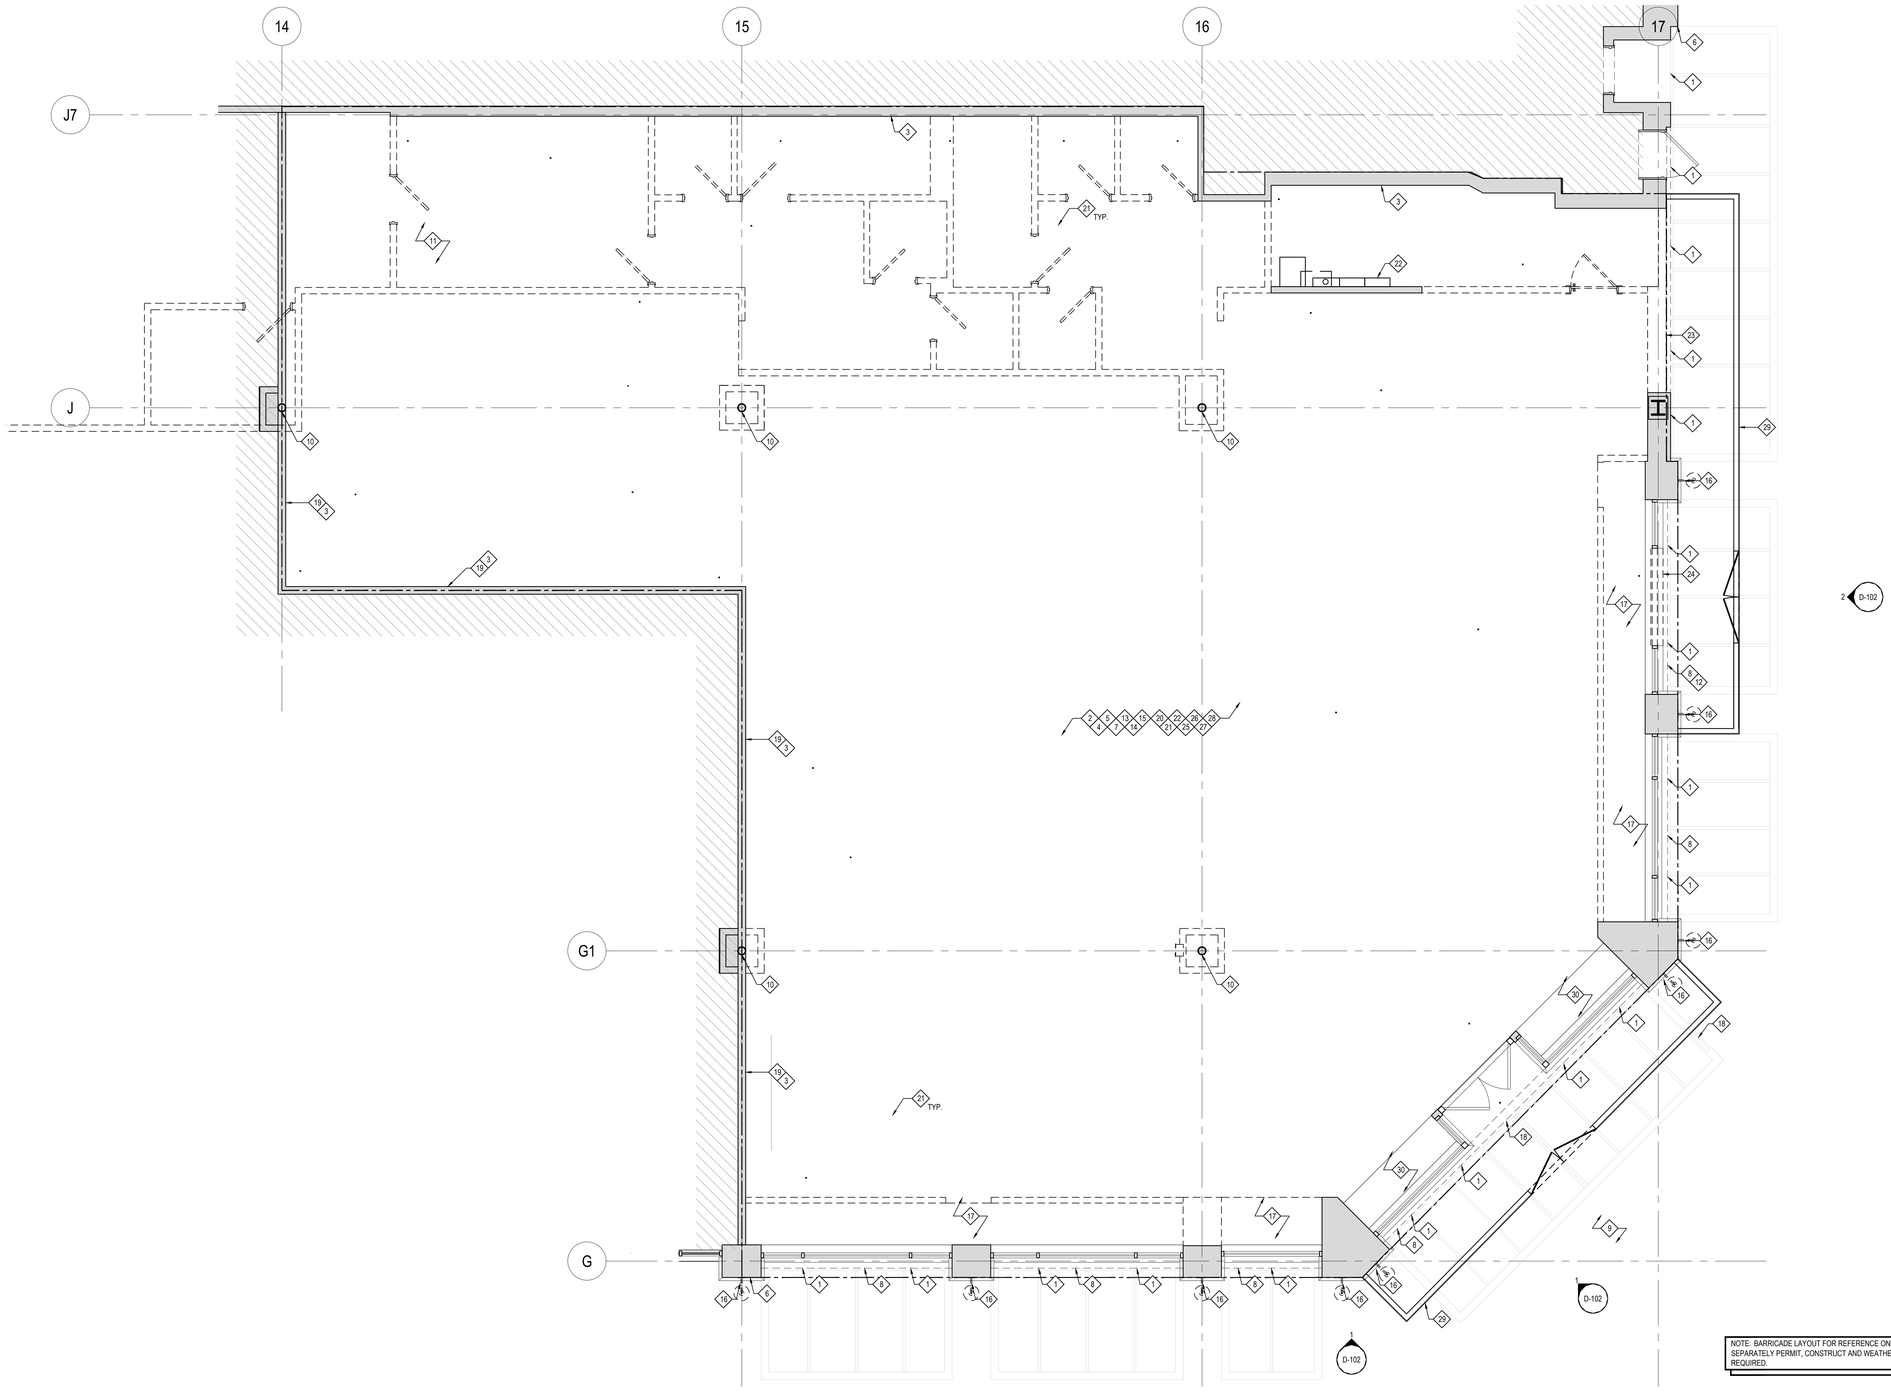


## 1 DEMOLITION PLAN

SCALE: 1/4"=1'-0"

## GENERAL NOTES

1. CONTRACTOR IS RESPONSIBLE TO VISIT SITE & CAREFULLY EXAMINE WORK OF THIS SECTION TO FAMILIARIZE THEMSELVES w/ EXIST. CONDITIONS, SCOPE OF WORK & DIFFICULTIES THAT MAY ATTEND EXECUTION OF WORK. CONTRACTOR MUST CONTACT LL IN ADVANCE FOR ACCESS TO SPACE.
2. DRAWINGS MAY NOT SHOW ALL REMOVALS REQUIRED. CONTRACT INCLUDES ALL WORK NECESSARY TO PRODUCE FINAL DESIGN AS SHOWN LEAVING NO EXIST. WORK THAT IS NO LONGER NEEDED. GC TO IDENTIFY AND CONFIRM ALL EXISTING CEILING MOUNTED ELEMENTS TO REMAIN AND TO BE REMOVED.
3. CONTRACTOR IS RESPONSIBLE FOR ENTIRE DEMOLITION OF SPACE FOLLOWING TENANT POSSESSION OF SPACE. THIS INCLUDES, BUT IS NOT LIMITED TO: WALLS, CEILINGS, FINISHES, EQUIPMENT, ELECTRICAL, HVAC & PLUMBING LINES AS REQUIRED.
4. CONTRACTOR IS RESPONSIBLE FOR PROVIDING NECESSARY PROTECTION AGAINST DIRT & DAMAGE & KEEPING PUBLIC SPACE CLEAN & FREE OF MATERIALS AT ALL TIMES.
5. CONTRACTOR IS RESPONSIBLE FOR ANY DAMAGES INCURRED BY PUBLIC AREAS DURING ALL PHASES OF WORK.
6. GC TO STUDY LL CONSTRUCTION GUIDE PRIOR TO ANY DEMO.
7. CONTRACTOR TO KEEP JOB SITE FREE OF ALL MATERIALS & BROOM-CLEAN & CONTROL CONSTRUCTION AREA TO JOB SITE & INFILTRATING AREAS OUTSIDE PROJECT AT ALL TIMES.
8. CONTRACTOR IS RESPONSIBLE FOR CLEAN-UP & CARTING FOR ALL TRADES, WHETHER OR NOT UNDER THEIR JURISDICTION.
9. ALL LIFE-SAFETY SYSTEMS & DEVICES TO REMAIN THROUGHOUT ALL PHASES OF CONSTRUCTION UNTIL REPLACEMENT.
10. GC TO PROVIDE ALL TEMP ACCOMMODATIONS FOR CONSTRUCTION. SITE MUST BE CODE & LL COMPLIANT THROUGHOUT DURATION OF PROJECT.
11. GC TO NOTIFY ARCHITECT OF ANY DISCREPANCIES FROM EXISTING SITE CONDITIONS TO DWG'S PRIOR TO DEMO.
12. NOTIFY ARCHITECT OF ANY EXIST. CONTROL/EXPANSION JOINTS.
13. GC TO PROTECT ALL EXISTING FIRE PROOFING AND MAINTAIN RATINGS. PREP TO PATCH ANY DAMAGED FIRE PROOFING.
14. GC TO OVERLAY NEW CONSTRUCTION PLAN TO EXIST FLOOR PLAN AND NEW RCP TO EXISTING CEILING PLAN TO CONFIRM NO OBSTRUCTIONS
15. G.C. TO IDENTIFY LL CONNECTIONS AND COORDINATE ALL IN-SLAB PLUMBING CONNECTIONS WITH MEP DRAWINGS.
16. GC TO FULLY COORDINATE w/ ENTIRE DRAWING SET FOR ANY SCHEDULED SLAB MODIFICATION; INCLUDING, BUT NOT LIMITED TO, POWER / DATA, FINISH, CONSTRUCTION, PLUMBING.
17. GC TO PROVIDE PRICE FOR SLAB SCANNING TO CONFIRM ANY OBSTRUCTIONS.
18. GC TO PROTECT ALL EXISTING COLUMNS. EXISTING FIRE RATING(S) TO REMAIN & BE MAINTAINED.
19. DURING CONSTRUCTION, AT LEAST ONE EXTINGUISHER SHALL BE PROVIDED ON EACH FLOOR LEVEL AT EACH STAIRWAY, IN ALL STORAGE AND CONSTRUCTION SHEDS, IN LOCATIONS WHERE FLAMMABLE OR COMBUSTIBLE LIQUIDS ARE STORED OR USED ABD WHERE OTHER SPECIAL HAZARDS ARE PRESENT PER CFC SECTION 3315.1
20. BUILDING UNDERGOING CONSTRUCTION, ALTERATION, OR DEMOLITION SHALL CONFORM TO CFC CHAPTER 33. WELDING, CUTTING, AND OTHER HOT WORK SHALL BE IN CONFORMANCE WITH CFC CHAPTER 35
21. OPEN FLAMES, FIRE, AND BURNING ON ALL PREMISES IS PROHIBITED EXCEPT AS SPECIFICALLY PERMITTED BY THE CITY OF SAN DIEGO AND CFC 308
22. GC TO ADHERE TO INDOOR AIR QUALITY REQUIREMENTS AS OUTLINED IN LETTERS PROVIDED.

## DEMO LEGEND

| SYMBOL | DESCRIPTION |
|---|---|
| | EXISTING CONSTRUCION TO REMAIN |
| | NOT IN CONTRACT (N.I.C.) |
| | DEMO |
| 88 | COLUMN TAG |
| (DX) | KEY NOTE |
| | DIMENSION LINE |
| | EXISTING DOOR & FRAME TO REMAIN |
| | LEASELINE |

## KEY NOTES

| TAG | DESCRIPTION |
|---|---|
| 1 | GC TO REMOVE EXISTING EXTERIOR LIGHT FIXTURE ABOVE GLAZED STOREFRONT SYSTEM - TYPICAL. PATCH AND REPAIR TO MATCH ADJACENT SURFACE. COORDINATE SCOPE OUTSIDE OF LEASELINE WITH LL. |
| 2 | GC TO REMOVE EXISTING FLOOR AND PREP SLAB FOR NEW FLOOR FINISH. REMOVE ANY EXISTING FINISHES, ADHESIVES, RESIDUE, ETC. AS REQUIRED FOR INSTALLATION OF NEW FINISH. FINISH FLOOR MUST BE FLUSH ACROSS ALL SPACES; FLOAT FLOOR AS REQUIRED FOR FLUSH, LEVEL FINISH (3/16" MAX TOLERANCE ACROSS ENTIRE SPACE). GC TO INCLUDE MINIMUM OF 1" FLOAT ACROSS SPACE. GC TO VIF LEASE LINE WITH LANDLORD PRIOR TO DEMOLITION. GC TO PROVIDE SCAN FOR LEVELNESS FOR REVIEW BY CLIENT, ARCHITECT AND MILLWORKER, BOTH BEFORE AND AFTER LEVELING |
| 3 | GC TO CONFIRM IF EXISTING DEMISING WALL IS FULL HEIGHT WITH GYP. BOARD TO UNDERSIDE OF DECK & FULLY RATED. G.C. TO FIRESTOP ANY NEW OR EXISTING PENETRATIONS AS REQUIRED. |
| 4 | GC TO REMOVE EXISTING PARTITIONS, MILLWORK & DOORS/FRAMES (SHOWN DASHED); DISCARD AS REQUIRED, UNLESS OTHERWISE NOTED. PATCH & FINISH AND EXPOSED EDGES OR DAMAGED SURFACES. |
| 5 | EXISTING CEILING TO REMAIN; GC TO REMOVE EXISTING LIGHTING AND CEILING EQUIPMENT UNLESS OTHERWISE NOTED. G.C. TO CUT POWER BACK TO ELECTRICAL PANEL. SEE MEP FOR DEMOLITION/REUSE SCOPE. |
| 6 | EXISTING LANDLORD NEUTRAL PIER. PROTECT THROUGHOUT CONSTRUCTION, PATCH AND REPAIR AS REQUIRED TO MAINTAIN APPEARANCE. COORDINATE FINISHES WITH LANDLORD. |
| 7 | NOTIFY ARCHITECT/ TENANT PROJECT MANAGER OF ANY FLOOR EXPANSION/ CONTROL JOINTS OR OF ANY CHANGES OF LEVEL OF FLOOR SLAB. |
| 8 | LANDLORD BULKHEAD ABOVE. PROTECT BULKHEAD, CEILING, DEVICES, AND ALL MECHANICAL CONNECTIONS. GC TO NOTIFY CLIENT, ARCHITECT AND ENGINEER IF ANY EQUIPMENT INTERFERES WITH PROPOSED CONSTRUCTION. |
| 9 | GC TO PROTECT EXTERIOR LL PAVERS THROUGHOUT DEMOLITION AND CONSTRUCTION. GC TO COORDINATE WITH STOREFRONT VENDOR FOR ANY MODIFICATIONS REQUIRED TO MALL TILE. |
| 10 | EXISTING COLUMN TO REMAIN; GC TO EXPOSE COLUMN AND VERIFY IF ANY FIREPROOFING IS PRESENT. GC TO FIELD VERIFY EXACT LOCATION OF STRUCTURE AND NOTIFY ARCHITECT AND MILLWORKER OF ANY DISCREPANCIES. PROTECT COLUMN AND ANY FIREPROOFING THROUGHOUT DEMOLITION AND CONSTRUCTION. MAINTAIN EXISTING FIRE RATING. PATCH/REPAIR IF REQUIRED. COORDINATE INSTALLATION OF NEW COLUMN ENCLOSURE OR MILLWORK (WHERE OCCURS). |
| 11 | GC TO ENSURE FLOOR IS LEVELED TO RECEIVE MOBILE SHELVING, PATCH/LEVEL AS REQUIRED. 1/8" MAX TOLERANCE ACROSS ROLLING SHELF RUN; PATCH TO THIS TOLERANCE IN AREA OF ROLLING SHELVES ONLY. CONFIRM WITH VENDOR. |
| 12 | GC TO VERIFY THE EXTENT OF DEMOLITION AT THE STOREFRONT AND VERIFY ALL EXISTING CONDITIONS. GC TO NOTIFY CLIENT, ARCHITECT AND ENGINEER IF ANY DISCREPANCIES EXIST THAT WOULD IMPEDE THE PROPOSED CONSTRUCTION. |
| 13 | REMOVE ANY FLOOR RECESS DEVICES AND PATCH TO ORIGINAL LEVEL IF NOT BEING REUSED IN NEW CONSTRUCTION. TERMINATE ALL POWER NOT USED BACK TO SOURCE. ALL FLOOR PENETRATIONS TO BE FIRE STOPPED TO MAINTAIN EXISTING FIRE RATING. |
| 14 | GC TO TRENCH AS REQUIRED FOR ANY FLOOR BOXES OR WHIPS AS REQUIRED FOR MILLWORK AND/OR FURNITURE CONNECTIONS. ALL FLOOR BOX AND WHIP LOCATIONS TO BE CONFIRMED WITH MILLWORKER PRIOR TO ANY SLAB CUTTING. GC TO SCAN SLAB PRIOR TO DEMO TO LOCATE ALL REBAR; NOTIFY ARCHITECT IF LOCATION SHOWN IS UNACHIEVABLE. |
| 15 | GC TO PROTECT LANDLORD EQUIPMENT, DUCTWORK AND PIPES THROUGHOUT DEMOLITION AND CONSTRUCTION. |
| 16 | REMOVE EXISTING SCONCE AT FACADE. POWER TO REMAIN. PREP FOR NEW SCONCE AS SCHEDULED. SEE RCP. |
| 17 | REMOVE EXISTING PLATFORM. PREP SLAB FOR NEW FINISH AS SCHEDULED. |
| 18 | REMOVE EXISTING SIGNANGE AND ASSOCIATED EQUIPMENT. PREP TO RECEIVE NEW FACADE TREATMENT AS SCHEDULED. |
| 19 | EXISTING DEMISING WALL BY LL. GC TO CONFIRM LOCATION. ADVISE OF ANY DISCREPANCIES. |
| 20 | REMOVE ANY FLOOR RECESS DEVICES AND PATCH TO ORIGINAL LEVEL IF NOT BEING REUSED IN NEW CONSTRUCTION. TERMINATE ALL POWER NOT USED BACK TO SOURCE. ALL FLOOR PENETRATIONS TO BE FIRE STOPPED TO MAINTAIN EXISTING FIRE RATING. |
| 21 | EXISTING DIFFUSERS TO BE REMOVED U.O.N. REFER TO MECHANICAL DEMOLITION PLAN FOR LOCATION OF EXISTING DUCTWORK TO BE DEMOLISHED. COORDINATE WITH MEP DEMOLITION PLANS FOR MODIFICATION SCOPE AND EXTENT OF DEMOLITION. PROTECT EXISTING DUCTS AND EQUIPMENT, INCLUDING MALL DUCTS AND EQUIPMENT, THROUGHOUT DEMO & CONSTRUCTION AS REQ'D. |
| 22 | EXISTING ELECTRICAL EQUIPMENT LOCATION, SEE ELEC. DWGS. REFER TO MEP DRAWINGS FOR FULL DEMOLITION SCOPE. G.C. TO PROTECT ANY EQUIPMENT TO REMAIN. |
| 23 | DEMO/CUT EXISTING FACADE AND WALL TO ACHIEVE LAYOUT PER DRAWINGS. SEE STOREFRONT SHEETS FOR MORE INFORMATION. PATCH AND REPAIR ADJACENT NEUTRAL PIERS AS REQUIRED. |
| 24 | REMOVE EXISTING STOREFRONT WINDOW GLAZING AND CUT FACADE BASE. TO ACHIEVE LAYOUT PER DRAWINGS. STOREFRONT SYSTEM FRAME TO REMAIN. SEE STOREFRONT DRAWINGS FOR MORE INFORMATION |
| 25 | G.C. TO PATCH EXISTING FLOOR SLAB AT ALL PLUMBING REMOVALS. MATCH EXISTING CONSTRUCTION AND FIRE RATING; FIRESTOP AS REQUIRED. |
| 26 | POST DEMOLITION, G.C. TO LOCATE ALL LANDLORD EQUIPMENT, DUCTWORK, PIPING, ETC. TO REMAIN. NOTIFY ARCHITECT, LL AND CLIENT IF ANY EQUIPMENT REQUIRES ACCESS OR IMPEDES PROPOSED CON. |
| 27 | G.C. TO REMOVE AND DISPOSE OF ANY CASEWORK, FURNITURE, EQUIPMENT, ETC. REMAINING IN THE SPACE UNLESS OTHERWISE NOTED. |
| 28 | GC TO PREP FLOOR TO RECEIVE NEW FLOOR FINISH. |
| 29 | BARRICADE BY GC - PERMITTED UNDER SEPARATE APPLICATION. GC TO COORDINATE LOCATION, REQUIREMENTS, AND GUIDELINES WITH LANDLORD. PREP FOR GRAPHICS. COORDINATE FINAL DIRECTION WITH RL. BARRICADE TO RECEIVES A CONTINUOUS WEATHERPROOFING HARDTOP BARRICADE LID, SECURED TO BARRICADE AND EXISTING EXTERIOR WALL. PATCH AND REPAIR AS REQUIRED AFTER REMOVAL OF SUPPORT TO RESTORE SURFACE CONDITION. |
| 30 | GC TO PROBE EXISTING SHOW WINDOW PLATFORMS. CONFIRM NO EXISTING OBSTRUCTIONS INHIBIT DESIGN INTENT. |

RALPH LAUREN

SPACE PLAN

RALPH LAUREN
STANFORD SHOPPING CENTER
SPACE 383A

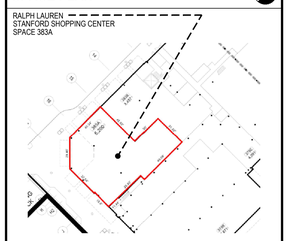

Lam+Tea Engineering

kpff

**SUBMISSION FOR ARCHITECTURAL REVIEW BOARD**

| NO. | REVISION | | DATE | BY |
|---|---|---|---|---|
| 9 | A.R.B. CORRECTIONS 2 | 7 | 07.22.2025 | TPG |
| 8 | PERMIT CORRECTIONS 2 | 6 | 07.02.2025 | TPG |
| 7 | A.R.B. CORRECTIONS 1 | 5 | 05.30.2025 | TPG |
| 6 | BOARD OF HEALTH CORRECTIONS | 4 | 04.18.2025 | TPG |
| 5 | LATEST FULL SET UPDATES | 3 | 04.14.2025 | TPG |
| 4 | PERMIT CORRECTIONS 1 | 2 | 05.23.2025 | TPG |
| 3 | BID ADDENDUM 1 | 1 | 03.11.2025 | TPG |
| 2 | ISSUED FOR BID & PERMIT | | 01.10.2025 | TPG |
| 1 | PROGRESS SET FOR CLIENT REVIEW | | 12.13.2024 | TPG |

TPG Architecture

TPG ARCHITECTURE, LLP
31 PENN PLAZA
132 WEST 31ST STREET, 5TH FLOOR, NEW YORK, NY 10001
212.768.0800 | TPGARCHITECTURE.COM

IN CONSIDERATION OF RECEIVING DRAWINGS FROM TPG ARCHITECTURE LLP IN AN ELECTRONIC FORM, THE RECIPIENT AGREES, TO THE FULLEST EXTENT PERMITTED BY LAW, TO HOLD HARMLESS AND INDEMNIFY TPG ARCHITECTURE LLP FROM AND AGAINST ALL CLAIMS, LIABILITIES, LOSSES, DAMAGES, AND COSTS, INCLUDING BUT NOT LIMITED TO ATTORNEY'S FEES, ARISING OUT OF, OR IN ANY WAY CONNECTED WITH THE USE, RE-USE, MIS-USE, MODIFICATION, OR MISINTERPRETATION OF THE MACHINE-READABLE INFORMATION PROVIDED BY TPG ARCHITECTURE LLP UNDER THIS AGREEMENT.

PROJECT
**RALPH LAUREN**
**STANFORD SHOPPING CENTER**
180 EL CAMINO REAL #383A, BLDG. M
PALO ALTO, CA 94304

DRAWING
DEMOLITION PLAN

FOR ARB EXHIBIT

SEAL

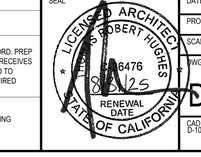


| | |
|---|---|
| DATE | XX/XX/2024 |
| PROJECT NO. | 1524879-00 |
| SCALE | 1/4"=1'-0" |
| DWG NO. | D-101.00 |
| CAD FILE NO. | D-101.00_DEMO.DWG |
| PAGE | 11 of 75 |

K:\241524879.0000_DRAWINGS\3_CAD\2_SHEETS\D-101.00_DEMO.DWG | Plot Date: Jan. 14, 2025 - 6:51 AM
Last Saved By: MAHAMAN | Save Date: 1/14/2025 6:31:41 AM

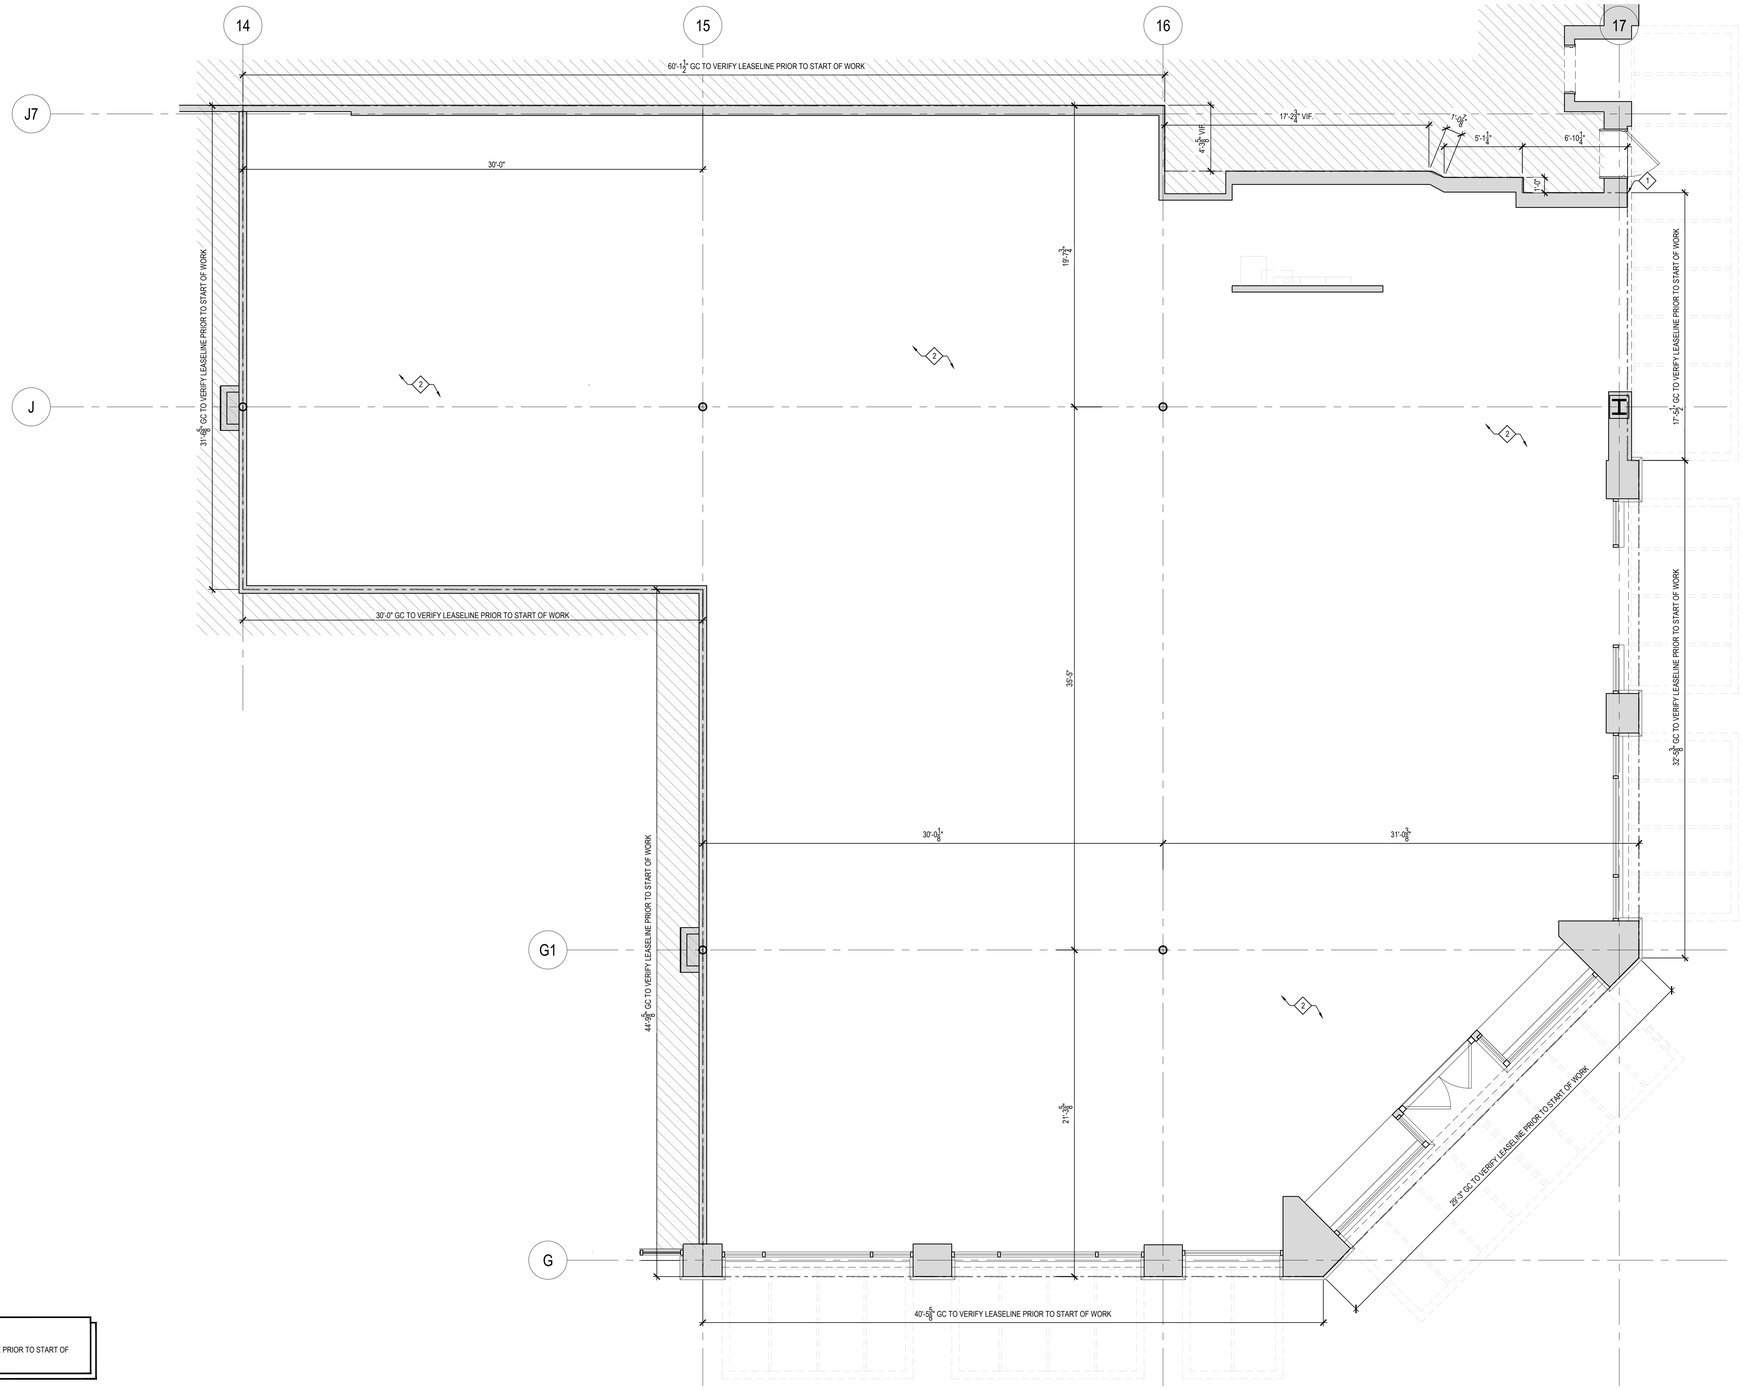


LANDLORD LOD NOTE:

SEE TENANT'S LOD PLAN TO VERIFY TENANT LEASELINE PRIOR TO START OF PROJECTS CONSTRUCTION.

1

## 1 GROUND FLOOR LEASE OUTLINE VERIFICATION PLAN

SCALE: 1/4"=1'-0"

### GENERAL NOTES

1. REFER TO MASTER LEGEND, MASTER RESPONSIBILITY MATRIX, AND MASTER SCHEDULES ON G-SHEETS FOR ALL INFORMATION PERTAINING TO THESE ITEMS.
2. ARCHITECT UNABLE TO PERFORM FULL SURVEY DUE TO PREVIOUS TENANT RESTRICTIONS.
3. GC TO SUBMIT L.O.D. VERIFICATION DRAWING PRIOR TO FRAMING NEW LAYOUT. GC TO NOTIFY OWNER AND ARCHITECT IMMEDIATELY AND DOCUMENT ANY CONDITIONS THAT DIFFER FROM THE PLANS HEREIN.
4. GC TO NOTIFY ARCHITECT OF ANY CONDITIONS THAT WOULD PREVENT COMPLETION OF PROPOSED DESIGN.
5. GC TO NOTIFY ARCHITECT OF ANY EXISTING EXPANSION AND/OR CONTROL JOINTS TO BE ADDRESSED.
6. GC TO CONFIRM ANY DISCREPANCIES AT EXISTING STOREFRONT.
7. GC TO NOTIFY ARCHITECT OF ANY DAMAGES TO BE RECTIFIED AS REQUIRED PRIOR TO CONSTRUCTION.
8. GC TO CONFIRM CONDITION OF ALL EXISTING ITEMS TO REMAIN. GC TO ENSURE THE GOOD CONDITION FOR ALL EXISTING ITEMS TO REMAIN. NOTIFY ARCHITECT OF ANY EXISTING ITEMS TO REMAIN THAT REQUIRE REPLACEMENT OR REPAIR.
9. GC TO NOTIFY ARCHITECT OF ANY CONDITIONS OR CONFLICTS THAT WILL PREVENT COMPLETION OF DUCTWORK LAYOUT AND HVAC DESIGN PRIOR TO FABRICATION.
10. GC TO CONFIRM EXISTING STRUCTURAL CONDITIONS.
11. GC TO VERIFY FLOOR TO CEILING HEIGHT AT NOTED LOCATIONS, NOTE ANY VARIATION IN FLOOR SLAB HEIGHT.
12. GC TO VERIFY & NOTIFY ARCHITECT OF ANY EXISTING BASE BUILDING BEAMS, MEP, HVAC, OR STRUCTURAL ELEMENTS NOT INCLUDED ON THE PLAN THAT WOULD PREVENT OR OTHERWISE INTERFERE WITH THE PROPOSED DESIGN INTENT.

### LEGEND

| SYMBOL | DESCRIPTION |
|---|---|
| | EXISTING CONSTRUCION TO REMAIN |
| | NOT IN CONTRACT (N.I.C.) |
| | CENTERLINE |
| 88 | COLUMN TAG |
| DX | KEY NOTE |
| | DIMENSION LINE |
| | EXISTING DOOR & FRAME TO REMAIN |

### KEY NOTES

| TAG | DESCRIPTION |
|---|---|
| 1 | REFER TO START POINT FOR DIMENSIONING AND LAYOUT OF PLANS. |
| 2 | G.C. TO VERIFY AND DOCUMENT EXISTING SLAB, SOFFIT, STRUCTURE, AND BASE BUILDING INFRASTRUCTURE CONDITIONS AND NOTIFY ARCHITECT. VERIFY ALL DIMENSIONS SHOWN |

RALPH LAUREN

SPACE PLAN

RALPH LAUREN
STANFORD SHOPPING CENTER
SPACE 383A

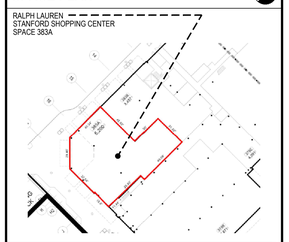

Lam+Tea Engineering

kpff

**SUBMISSION FOR ARCHITECTURAL REVIEW BOARD**

| NO. | REVISION | | DATE | BY |
|---|---|---|---|---|
| 9 | A.R.B. CORRECTIONS 2 | 7 | 07.22.2025 | TPG |
| 8 | PERMIT CORRECTIONS 2 | 6 | 07.02.2025 | TPG |
| 7 | A.R.B. CORRECTIONS 1 | 5 | 05.30.2025 | TPG |
| 6 | BOARD OF HEALTH CORRECTIONS | 4 | 04.18.2025 | TPG |
| 5 | LATEST FULL SET UPDATES | 3 | 04.14.2025 | TPG |
| 4 | PERMIT CORRECTIONS 1 | 2 | 05.23.2025 | TPG |
| 3 | BID ADDENDUM 1 | 1 | 03.11.2025 | TPG |
| 2 | ISSUED FOR BID & PERMIT | | 01.10.2025 | TPG |
| 1 | PROGRESS SET FOR CLIENT REVIEW | | 12.13.2024 | TPG |


TPG Architecture

**TPG ARCHITECTURE, LLP**
**31 PENN PLAZA**
**132 WEST 31ST STREET, 5TH FLOOR, NEW YORK, NY 10001**
**212.768.0800 | TPGARCHITECTURE.COM**



IN CONSIDERATION OF RECEIVING DRAWINGS FROM TPG ARCHITECTURE LLP IN AN ELECTRONIC FORM, THE RECIPIENT AGREES, TO THE FULLEST EXTENT PERMITTED BY LAW, TO HOLD HARMLESS AND INDEMNIFY TPG ARCHITECTURE LLP FROM AND AGAINST ALL CLAIMS, LIABILITIES, LOSSES, DAMAGES, AND COSTS, INCLUDING BUT NOT LIMITED TO ATTORNEY'S FEES, ARISING OUT OF, OR IN ANY WAY CONNECTED WITH THE USE, RE-USE, MIS-USE, MODIFICATION, OR MISINTERPRETATION OF THE MACHINE-READABLE INFORMATION PROVIDED BY TPG ARCHITECTURE LLP UNDER THIS AGREEMENT.


PROJECT

**RALPH LAUREN**
**STANFORD SHOPPING CENTER**
180 EL CAMINO REAL #383A, BLDG. M
PALO ALTO, CA 94304

DRAWING

LEASE OUTLINE VERIFICATION PLAN

SEAL

LICENSED ARCHITECT ROBERT HUGHES 26476 STATE OF CALIFORNIA RENEWAL DATE 8/31/25

| | |
|---|---|
| DATE | 04/18/2025 |
| PROJECT NO. | 1524879-00 |
| SCALE | 1/4"=1'-0" |
| DWG NO. | A-001.00 |
| CAD FILE NO. | A-001.00_LEASE OUTLINE.DWG |
| PAGE | 15 of 55 |

K:\24\1524879.0008_DRAWINGS\2_CAD\3_SHEETS\A-001.00_LEASE OUTLINE.DWG | Plot Date: Jul. 23, 2025 - 7:01 AM
Last Saved By: MHAMANN | Save Date: 7/22/2025 1:32:23 PM

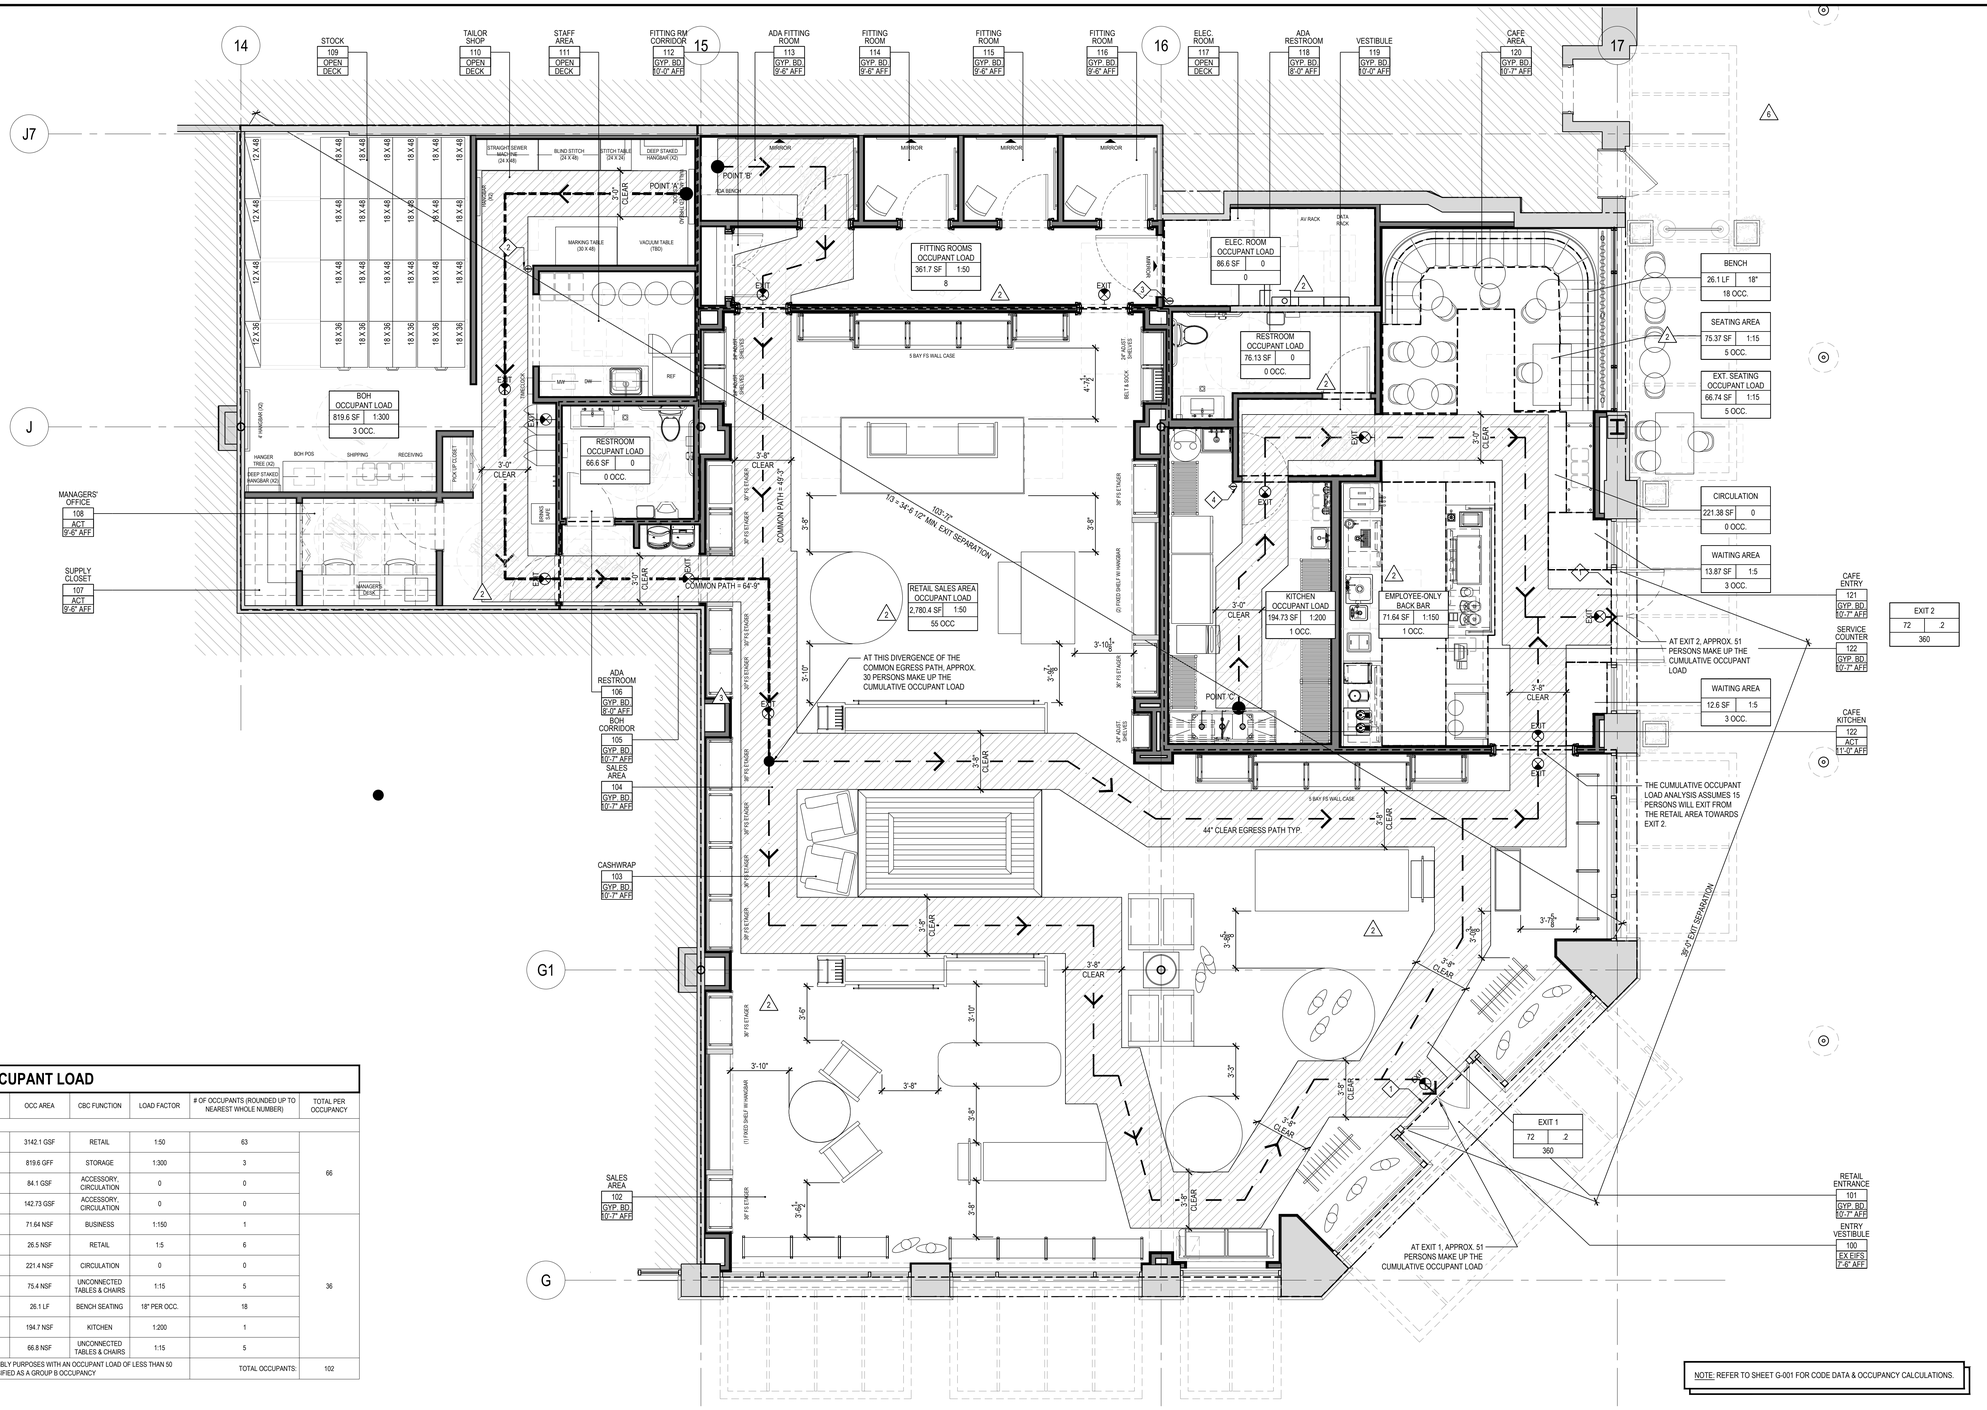


NOTE: REFER TO SHEET G-001 FOR CODE DATA & OCCUPANCY CALCULATIONS.

## SQUARE FOOTAGE & OCCUPANT LOAD

| | SPACE | OCCUPANCY | OCC AREA | CBC FUNCTION | LOAD FACTOR | # OF OCCUPANTS (ROUNDED UP TO NEAREST WHOLE NUMBER) | TOTAL PER OCCUPANCY |
|---|---|---|---|---|---|---|---|
| MERCANTILE | SALES AREA | M | 3142.1 GSF | RETAIL | 1:50 | 63 | 66 |
| | BOH | M | 819.6 GFF | STORAGE | 1:300 | 3 | |
| | DATA/ELEC ROOM | M | 84.1 GSF | ACCESSORY, CIRCULATION | 0 | 0 | |
| | RESTROOMS | M | 142.73 GSF | ACCESSORY, CIRCULATION | 0 | 0 | |
| CAFE | EMPLOYEE-ONLY BACK BAR | B* | 71.64 NSF | BUSINESS | 1:150 | 1 | 36 |
| | WAITING AREA | B* | 26.5 NSF | RETAIL | 1:5 | 6 | |
| | CIRCULATION | B* | 221.4 NSF | CIRCULATION | 0 | 0 | |
| | SEATING AREA | B* | 75.4 NSF | UNCONNECTED TABLES & CHAIRS | 1:15 | 5 | |
| | FIXED SEATING | B* | 26.1 LF | BENCH SEATING | 18" PER OCC. | 18 | |
| | CAFE BOH | B* | 194.7 NSF | KITCHEN | 1:200 | 1 | |
| EXTERIOR | SEATING AREA | B* | 66.8 NSF | UNCONNECTED TABLES & CHAIRS | 1:15 | 5 | |
| B* = A BUILDING OR TENANT SPACE USED FOR ASSEMBLY PURPOSES WITH AN OCCUPANT LOAD OF LESS THAN 50 PERSONS SHALL BE CLASSIFIED AS A GROUP B OCCUPANCY | | | | | TOTAL OCCUPANTS: | | 102 |

## 1 EGRESS & LIFE SAFETY PLAN

SCALE: 1/4"=1'-0"

## GENERAL NOTES

1. MAINTAIN 3'-8" CLEAR ALONG EGRESS PATH & 3'-0" BETWEEN FLOOR FIXTURES AT ALL TIMES.
2. COORDINATE EGRESS PATH & SIGNAGE LOCATIONS WITH EC. ANY DISCREPANCIES TO BE REPORTED TO ARCHITECT PRIOR TO ROUGH-IN.
3. ALL CEILING-MOUNTED EQUIPMENT TO BE COORDINATED w/ LIGHTING & SPRINKLER PLANS.
4. SEE RCP FOR ADDITIONAL CEILING-MOUNTED EQUIPMENT INFORMATION.
5. ALL CEILING-MOUNTED EQUIPMENT TO BE WHITE (U.O.N.).
6. THE EGRESS PATH SHALL REMAIN FREE AND CLEAR OF ALL OBSTRUCTIONS AT ALL TIMES. NO STORAGE IS PERMITTED IN ANY EGRESS PATHS.

MEANS OF EGRESS ILLUMINATION
EMERGENCY POWER SOURCE AND INITIAL ILLUMINATION LEVELS SHALL CONFORM WITH CBC 1008

EXIT SIGN PLACEMENT
EXIT SIGN PLACEMENT SHALL BE SUCH THAT NO POINT IN AN EXIT ACCESS CORRIDOR OR EXIT PASSAGEWAY IS MORE THAN 100 FEET OR THE LISTED VIEWING DISTANCE FOR THE SIGN, WHICHEVER IS LESS, FROM THE NEAREST VISIBLE EXIT SIGN. EXIT SIGNS ARE NOT REQUIRED IN ROOMS OR AREAS THAT REQUIRE ONLY ONE EXIT OR EXIT ACCESS (IBC 1013.1).

## FIRE & LIFE SAFETY LEGEND

| SYMBOL | TYPE | DESCRIPTION | DESCRIPTION |
|---|---|---|---|
| | EXIT | CEILING MOUNTED EXIT SIGN WALL MOUNTED EXIT SIGN | SEE LIGHT FIXTURE SCHEDULE |
| FE | FE | WALL MOUNTED FIRE EXTINGUISHER | SEE FIRE EXTINGUISHER NOTES |
| FEC | FEC | WALL RECESSED FIRE EXTINGUISHER AND CABINET | SEE FIRE EXTINGUISHER NOTES |
| SD | SD | SMOKE DETECTOR | SEE POWER / DATA & ENGINEER'S DRAWINGS |
| HS | HS | HORN STROBE - CEILING MTD. | SEE POWER / DATA & ENGINEER'S DRAWINGS |
| HS | HS | HORN STROBE - WALL MTD. | SEE POWER / DATA & ENGINEER'S DRAWINGS |
| SP | SP | SPRINKLER HEAD | SEE ENGINEER'S DRAWINGS |
| PS | PS | FIRE PULL STATION | SEE ENGINEER'S DRAWINGS |
| | PATH | EGRESS PATH OF TRAVEL | |

## FIRE EXTINGUISHER NOTES

SEMI-RECESSED-MOUNTED (FEC) AT BACK OF HOUSE / NON-PUBLIC AREAS. ALL FIRE EXTINGUISHERS TO BE ADA-COMPLIANT TYPE "ABC" ALL PURPOSE CHEMICAL EXTINGUISHERS. GC TO FURNISH & INSTALL ALL FIRE EXTINGUISHERS. SEE SHEET G-002 FOR MOUNTING HEIGHT(S).

**SPECIFICATIONS:**
FIRE EXTINGUISHER
ANSUL "SENTRY 10"

MODEL #: A10H
PART #: 429003
BRACKET #: 30855
AGENT CAPACITY: 10 LB. FORAY
U.L. RATING: 10-A:60-B:C

FIRE EXTINGUISHER CABINET
POTTER ROEMER, 7100 SERIES, U.L. CLASSIFIED 7N43

MODEL #: 7122-A-18-VAB
MOUNTING: SEMI-RECESSED
DOOR STYLE: FULL ACRYLIC DOOR w/ MAGNETIC LATCH
DOOR COLOR: MATCH ADJACENT WALL FINISH / COVERING
OPTIONAL LETTERING: VERTICAL ASCENDING, BLACK

## BUILDING CODE ANALYSIS

**OCCUPANT LOAD**

SEE SQUARE FOOTAGE & OCCUPANT LOAD BREAKDOWN ON TABLE SHEET G-001

**EGRESS REQUIREMENTS**

**SPRINKLER SYSTEM:** YES
**EMERGENCY VOICE/ALARM COMMUNICATION SYSTEM:** YES

**MINIMUM NUMBER OF EXITS PER FLOOR**
(PER ***CBC 1006.2.1*** EGRESS BASED ON OCCUPANT LOAD AND COMMON PATH OF EGRESS TRAVEL DISTANCE):

TOTAL OCCUPANTS: 102 OCCUPANTS > 49 OCCUPANTS, **(2)** EXITS MINIMUM REQUIRED

**MAXIMUM TRAVEL DISTANCE**
(PER ***CBC TABLE 1017.2***, EXIT ACCESS TRAVEL DISTANCE): 250'-0"

**MINIMUM AISLE WIDTH**
(PER ***CBC 1018.3*** AISLES IN GROUP B AND M & ***CBC TABLE 1020.2*** MINIMUM CORRIDOR WIDTH): 44"

**MINIMUM AISLE ACCESSWAY WIDTH**
(PER ***CBC 1018.4*** AISLE ACCESSWAYS IN GROUP M): 30" REQ'D ON NOT LESS THAN 1 SIDE OF EACH ELEMENT WITHIN THE MERCANDISE PAD WTIH A MAXIMUM COMMON PATH OF TRAVEL NOT EXCEEDING 30'-0"

MINIMUM EXIT SEPARATION
(PER ***CBC 1007.1.1*** TWO EXITS OR EXIT ACCESS DOORWAYS):

MAX. OVERALL DIAGONAL DIMENSION : 103'-8 1/8" GROUND FLOOR

REQUIRED MIN. SEPARATION: GROUND FLOOR:
REQUIRED: 103'-8 1/8" / 3 = 34'-6"
PROVIDED: 39'-0" (COMPLIES)

MEANS OF EGRESS SIZING
(PER ***CBC 1005.3.2*** THE CAPACITY, IN INCHES, OF MEANS OF EGRESS COMPONENTS OTHER THAN STAIRWAYS SHALL BE CALCULATED BY MULTIPLYING THE OCCUPANT LOAD SERVED BY SUCH COMPONENT BY A MEANS OF EGRESS CAPACITY FACTOR OF 0.2 INCH (5.1 MM) PER OCCUPANT.

TOTAL OCCUPANTS: 102 OCCUPANTS / 2 = REQUIRED: 20.4"
PROVIDED: 144"

| EXIT 2 | |
|---|---|

EXIT NUMBER
FACTOR
OCCUPANCY LOAD
EXIT WIDTH

## EGRESS PATH CALCULATIONS:

| EGRESS PATH | TOTAL LENGTH TO NEAREST EXIT | |
|---|---|---|
| | EXIT 1 | EXIT 2 |
| PATH A | 140'-0" | 134'-3" |
| PATH B | 118'-0" | 146'-10" |
| PATH C | 85'-3" | 52'-8" |
| | | |

## FLOOR KEY NOTES

| TAG | DESCRIPTION |
|---|---|
| 1 | EGRESS DOORS LOCKABLE FROM THE EGRESS SIDE. THE LOCKING DEVICE IS TO BE READILY DISTINGUISHABLE AS LOCKED. DOORS TO REMAIN UNLOCKED WHEN SPACE IS OCCUPIED. |
| 2 | NEW FIRE EXTINGUISHER IN BOH |
| 3 | NEW FIRE EXTINGUISHER IN SALES |
| 4 | NEW FIRE EXTINGUISHER IN CAFE |

RALPH LAUREN

SPACE PLAN

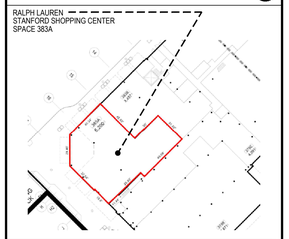


Lam+Tea Engineering

kpff

## SUBMISSION FOR ARCHITECTURAL REVIEW BOARD

| NO. | REVISION | | DATE | BY |
|---|---|---|---|---|
| 9 | A.R.B. CORRECTIONS 2 | 7 | 07.22.2025 | TPG |
| 8 | PERMIT CORRECTIONS 2 | 6 | 07.02.2025 | TPG |
| 7 | A.R.B. CORRECTIONS 1 | 5 | 05.30.2025 | TPG |
| 6 | BOARD OF HEALTH CORRECTIONS | 4 | 04.18.2025 | TPG |
| 5 | LATEST FULL SET UPDATES | 3 | 04.14.2025 | TPG |
| 4 | PERMIT CORRECTIONS 1 | 2 | 05.23.2025 | TPG |
| 3 | BID ADDENDUM 1 | 1 | 03.11.2025 | TPG |
| 2 | ISSUED FOR BID & PERMIT | | 01.10.2025 | TPG |
| 1 | PROGRESS SET FOR CLIENT REVIEW | | 12.13.2024 | TPG |


TPG Architecture

TPG ARCHITECTURE, LLP
31 PENN PLAZA
132 WEST 31ST STREET, 5TH FLOOR, NEW YORK, NY 10001
212.768.0800 | TPGARCHITECTURE.COM



IN CONSIDERATION OF RECEIVING DRAWINGS FROM TPG ARCHITECTURE LLP IN AN ELECTRONIC FORM, THE RECIPIENT AGREES, TO THE FULLEST EXTENT PERMITTED BY LAW, TO HOLD HARMLESS AND INDEMNIFY TPG ARCHITECTURE LLP FROM AND AGAINST ALL CLAIMS, LIABILITIES, LOSSES, DAMAGES, AND COSTS, INCLUDING BUT NOT LIMITED TO ATTORNEY'S FEES, ARISING OUT OF, OR IN ANY WAY CONNECTED WITH THE USE, RE-USE, MIS-USE, MODIFICATION, OR MISINTERPRETATION OF THE MACHINE-READABLE INFORMATION PROVIDED BY TPG ARCHITECTURE LLP UNDER THIS AGREEMENT.


PROJECT
**RALPH LAUREN**
**STANFORD SHOPPING CENTER**
180 EL CAMINO REAL #383A, BLDG. M
PALO ALTO, CA 94304

DRAWING
EGRESS PLAN

SEAL

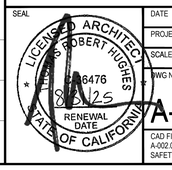


| | |
|---|---|
| DATE | 04/18/2025 |
| PROJECT NO. | 1524879-00 |
| SCALE | 1/4"=1'-0" |
| DWG NO. | A-002.00 |
| CAD FILE NO. | A-002.00_EGRESS & LFE SAFETY PLAN.DWG |
| PAGE | 16 of 55 |

K:\01\1524879-0000_DRAWINGS\3_CAD\2_SHEETS\A-000.00_EGRESS & LIFE SAFETY PLAN.DWG | Print Date: Jul. 23, 2025 - 7:02 AM
Last Saved By: MHAHAN | Save Date: 7/23/2025 6:27:40 AM

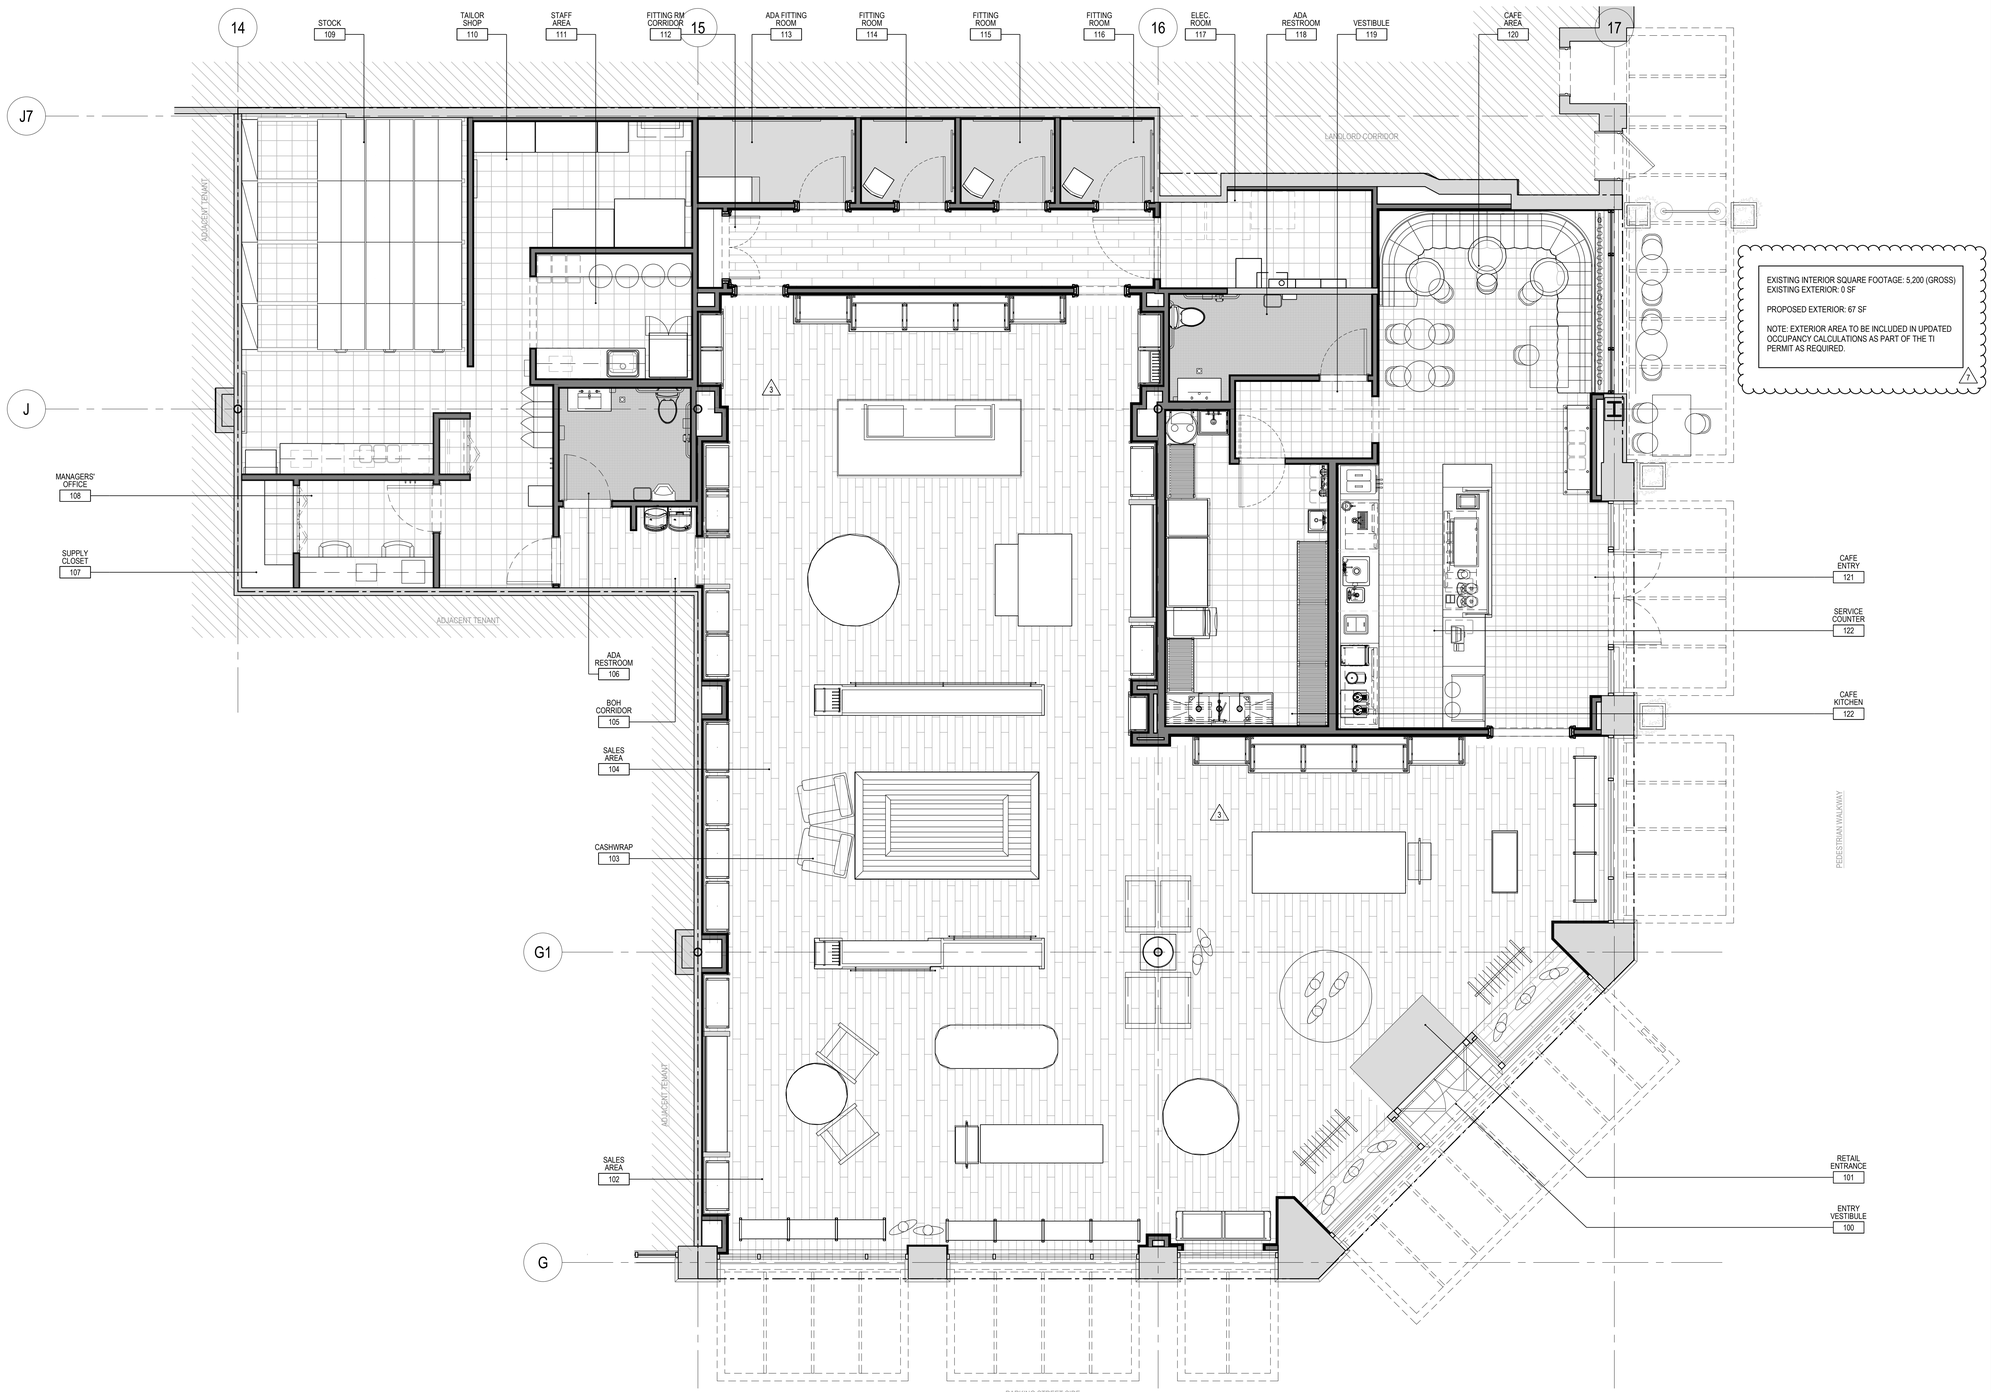


RALPH LAUREN

## SPACE PLAN

RALPH LAUREN
STANFORD SHOPPING CENTER
SPACE 383A

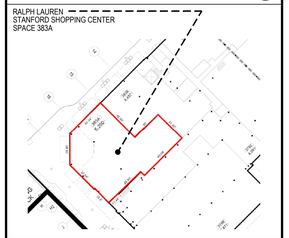

Lam+Tea Engineering

kpff

**SUBMISSION FOR ARCHITECTURAL REVIEW BOARD**

| NO. | REVISION | | DATE | BY |
|---|---|---|---|---|
| 9 | A.R.B. CORRECTIONS 2 | 7 | 07.22.2025 | TPG |
| 8 | PERMIT CORRECTIONS 2 | 6 | 07.02.2025 | TPG |
| 7 | A.R.B. CORRECTIONS 1 | 5 | 05.30.2025 | TPG |
| 6 | BOARD OF HEALTH CORRECTIONS | 4 | 04.18.2025 | TPG |
| 5 | LATEST FULL SET UPDATES | 3 | 04.14.2025 | TPG |
| 4 | PERMIT CORRECTIONS 1 | 2 | 05.23.2025 | TPG |
| 3 | BID ADDENDUM 1 | 1 | 03.11.2025 | TPG |
| 2 | ISSUED FOR BID & PERMIT | | 01.10.2025 | TPG |
| 1 | PROGRESS SET FOR CLIENT REVIEW | | 12.13.2024 | TPG |

TPG Architecture

**TPG ARCHITECTURE, LLP**
**31 PENN PLAZA**
**132 WEST 31ST STREET, 5TH FLOOR, NEW YORK, NY 10001**
**212.768.0800 | TPGARCHITECTURE.COM**

IN CONSIDERATION OF RECEIVING DRAWINGS FROM TPG ARCHITECTURE LLP IN AN ELECTRONIC FORM, THE RECIPIENT AGREES, TO THE FULLEST EXTENT PERMITTED BY LAW, TO HOLD HARMLESS AND INDEMNIFY TPG ARCHITECTURE LLP FROM AND AGAINST ALL CLAIMS, LIABILITIES, LOSSES, DAMAGES, AND COSTS, INCLUDING BUT NOT LIMITED TO ATTORNEYS FEES, ARISING OUT OF, OR IN ANY WAY CONNECTED WITH THE USE, RE-USE, MIS-USE, MODIFICATION, OR MISINTERPRETATION OF THE MACHINE-READABLE INFORMATION PROVIDED BY TPG ARCHITECTURE LLP UNDER THIS AGREEMENT.

PROJECT
**RALPH LAUREN**
**STANFORD SHOPPING CENTER**
180 EL CAMINO REAL #383A, BLDG. M
PALO ALTO, CA 94304

DRAWING
LAYOUT PLAN

SEAL

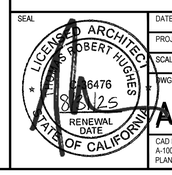


| | |
|---|---|
| DATE | 04/18/2025 |
| PROJECT NO. | 1524879-00 |
| SCALE | 1/4"=1'-0" |
| DWG NO. | A-100.00 |
| CAD FILE NO. | A-100.00_LAYOUT PLAN.DWG |
| PAGE | 17 of 55 |

K:\01\1524879.0008_DRAWINGS\3_CAD\2_SHEETS\A-100.00_LAYOUT PLAN.DWG | Plot Date: Jul 23, 2025 - 7:02 AM
Last Saved By: MHAMANN | Save Date: 7/22/2025 6:44:44 AM

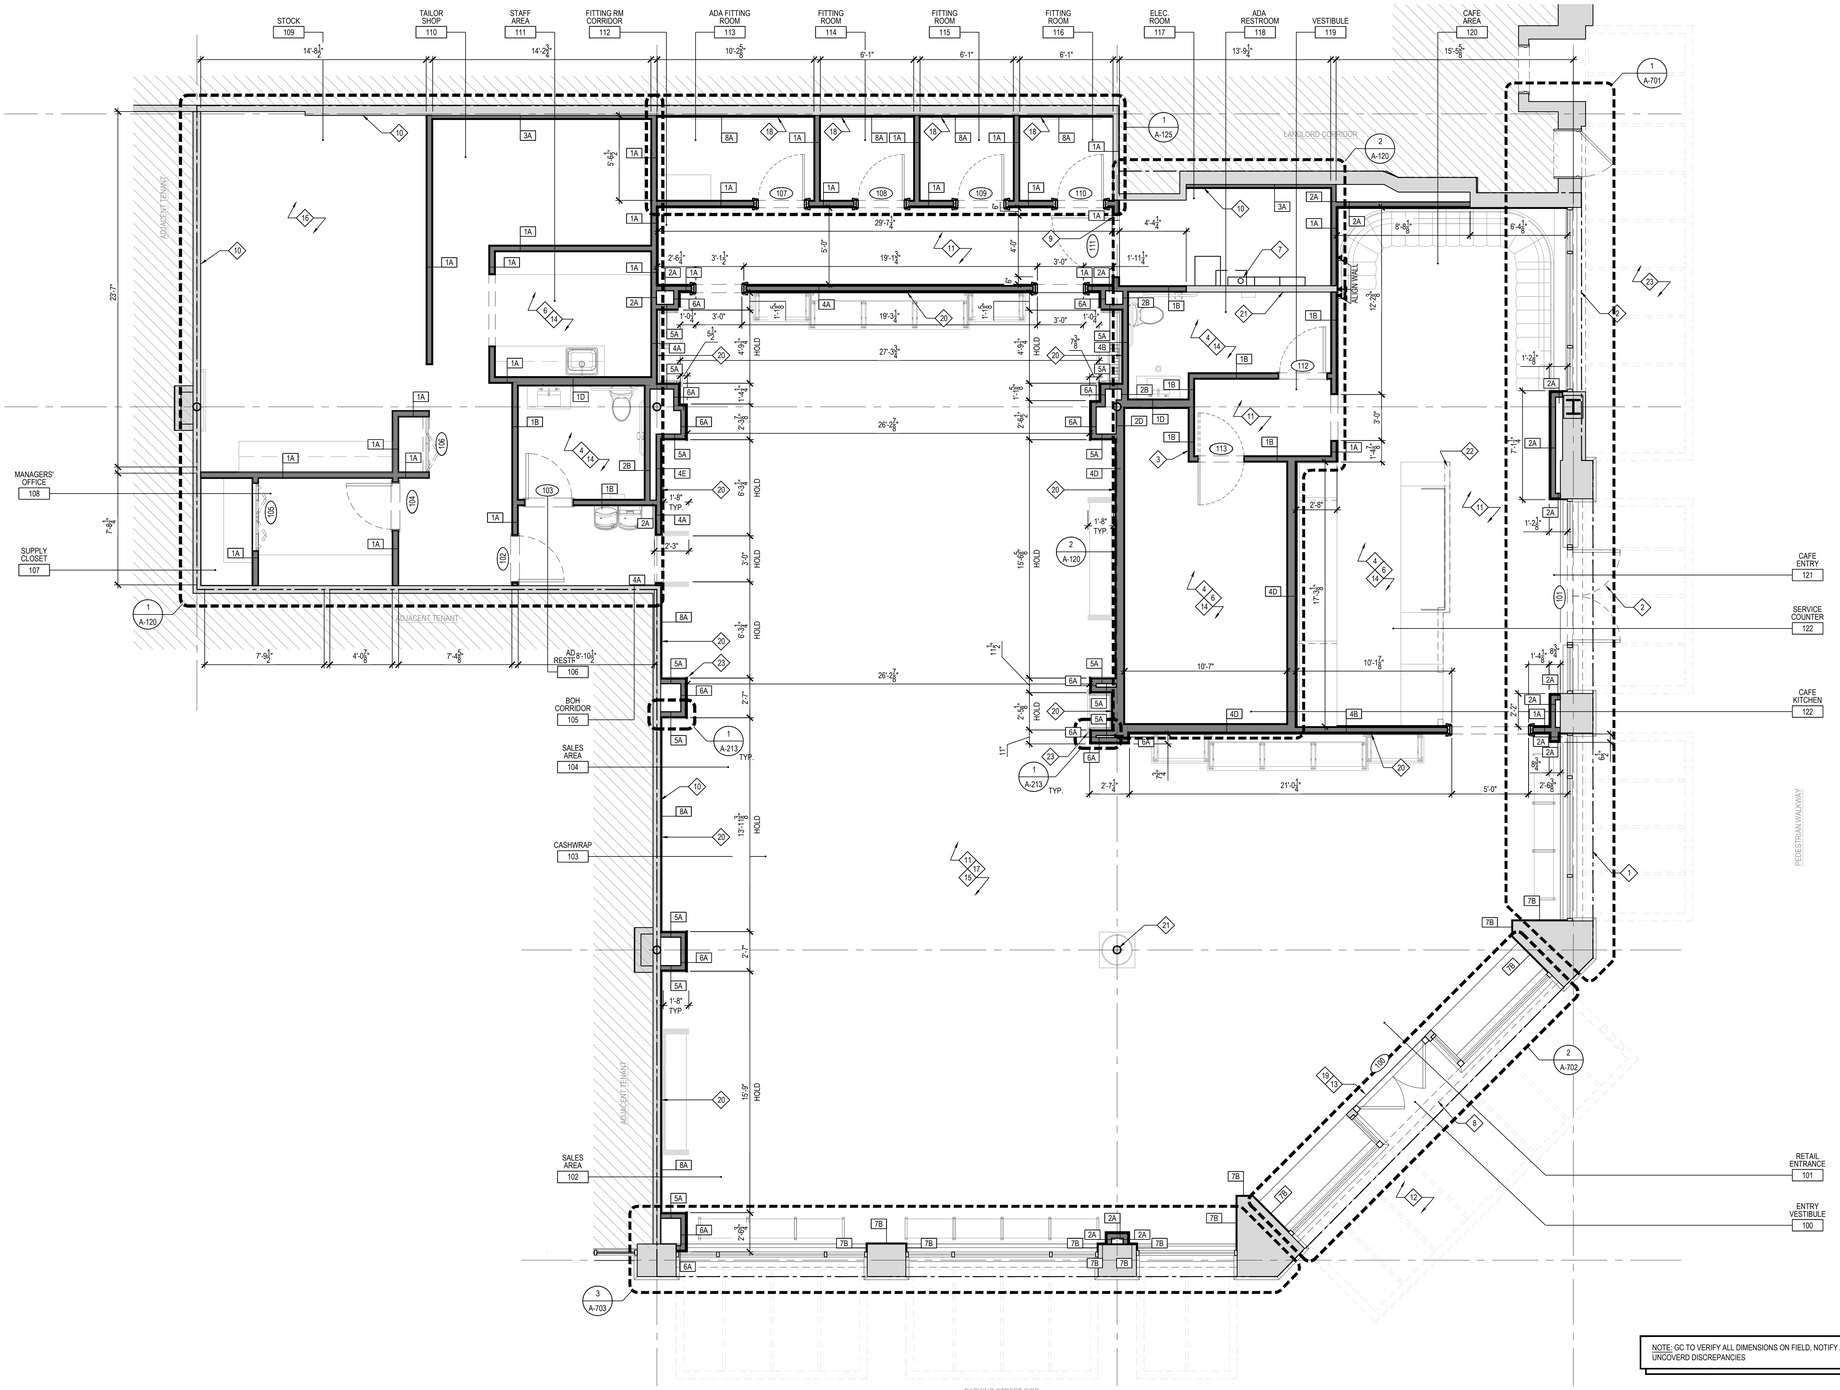


NOTE: GC TO VERIFY ALL DIMENSIONS ON FIELD, NOTIFY ARCHITECT OF ANY UNCOVERD DISCREPANCIES

## 1 CONSTRUCTION PLAN

SCALE: 1/4"=1'-0"

## CONSTRUCTION LEGEND

| SYMBOL | DESCRIPTION |
|---|---|
| XXX / ### | ROOM NAME / ROOM NUMBER |
| | EXISTING CONSTRUCTION TO REMAIN |
| | NOT IN CONTRACT (N.I.C) |
| | NEW PARTITION |
| | CENTER LINE |
| # | DOOR TAG |
| X.### / # | ELEVATION TAG |
| #X | PARTITION TYPE |
| # | KEY NOTE |
| XXX (S.T.S) | DIMENSION LINE |
| # / X.### | SECTION CALL-OUT |

## GENERAL NOTES

1. ALL CONSTRUCTION TO COMPLY WITH APPLICABLE CITY & STATE CODES & STANDARDS.
2. PROVIDE PROTECTION OF ALL EXG. ITEMS TO REMAIN THROUGHOUT DURATION OF CONSTRUCTION. PATCH & / OR REPAIR ANY DEMISING WALL, CORRIDOR OR OTHER PROPERTY DAMAGED DURING DEMOLITION OR CONSTRUCTION AS REQUIRED TO BRING TO LIKE-NEW CONDITION; MATCH ALL STANDARD FINISHES.
3. PATCH & / OR REPAIR ALL DEMISING WALLS, FIRE-CAULK & TAPE PENETRATIONS TO MAINTAIN EXISTING FIRE RATING.
4. COORDINATE ALL WORK w/ ENGINEER'S DRAWINGS.
5. PREPARE COORDINATION DRAWING(S) OF ALL TRADES PRIOR TO ORDERING MATERIALS, INCLUDING LONG-LEAD ITEMS.
6. DO NOT SCALE DRAWINGS. WRITTEN DIMENSIONS GOVERN ALL PARTITION LOCATIONS. NOTIFY ARCHITECT OF ANY DISCREPANCIES.
7. ALL DIMENSIONS TO FACE OF FINISHED WALL (U.O.N.). MAINTAIN ALL DIMENSIONS MARKED "CLEAR" OR "HOLD" & ALLOW FOR THICKNESS OF FINISH(ES).
8. CHALK ALL PARTITION LINES ON SITE FOR APPROVAL PRIOR TO COMMENCEMENT OF CONSTRUCTION. FULLY COORDINATE WITH MILLWORK SHOP DRAWINGS.
9. PROVIDE DIAGONAL BRACING TO STRUCTURE ABOVE AT ALL DOORS, HEADERS & JAMBS AS REQUIRED TO PROVIDE RIGID ASSEMBLY.
10. V.I.F. CONDITION OF ALL DEMISING PARTITIONS & PROVIDE FULL-HT. FINISHED GYP. BD. TO UNDERSIDE OF DECK AS REQUIRED TO ACHIEVE & / OR MAINTAIN REQUIRED & / OR EXISTING FIRE RATING; PATCH / REPAIR TO PREPARE FOR FINISHES. PATCH & FIRE-STOP ALL PARTITIONS AS REQ'D.
11. ALL SLAB PENETRATIONS MUST BE APPROVED IN WRITING BY TENANT COORDINATOR PRIOR TO COMMENCEMENT OF WORK. ENSURE ALL SLAB PENETRATIONS WITHIN TENANT'S PREMISES ARE PROPERLY SEALED, WATERTIGHT & FULLY FIRE STOPPED.
12. ALL PENETRATIONS AT FIRE-RESISTANT FLOORS OR SHAFT WALLS TO BE PROTECTED BY MATERIALS & INSTALLATION DETAILS IN CONFORMANCE WITH UL STANDARDS FOR THROUGH-PENETRATIONS FIRE-STOP SYSTEMS. SUBMIT SHOP DRAWINGS TO SHOW COMPLETE CONFORMANCE TO ARCHITECT & MAKE AVAILABLE TO ANY INSPECTORS AS REQ'D. DRAWINGS TO BE SPECIFIC PER PENETRATION WITH ALL VARIABLES DEFINED.
13. COORDINATE WITH TENANT MILLWORKER & ALL FINISH TRADES TO ENSURE PROPER PROVISIONS ARE MADE FOR INSTALLATION OF FIXTURES. ENSURE CONCEALED BLOCKING / GROUNDS ARE INSTALLED AS REQUIRED BY MILLWORKER PRIOR TO CLOSING-UP WORK BY OTHER TRADES; PROVIDE DRAWING INDICATING SIZE & LOCATIONS OF ALL BLOCKING.
14. ALL CONCEALED WOOD, BLOCKING, FRAMING & PLYWOOD TO BE FIRE-RETARDANT AS REQUIRED BY STATE CODES.
15. PROVIDE APPROVED FIRE EXTINGUISHERS AS INDICATED ON EGRESS & LIFE SAFETY DRAWINGS & INSTALL AS REQUIRED BY LOCAL A.H.J.
16. COORDINATE ALL LAYOUT ISSUES WITH MILLWORKER TO ESTABLISH MILLWORK LAYOUTS & BOX LOCATIONS. OBTAIN MILLWORK SHOP DRAWINGS PRIOR TO COMMENCEMENT OF FRAMING.
17. PROVIDE FIELD-INFORMATION & DIMENSIONS TO MILLWORKER & ANY OF OWNER'S OTHER CONTRACTORS UPON REQUEST.
18. MAINTAIN ACCESS TO & PROTECT ALL EXISTING ELECTRICAL, FIRE ALARM, SPRINKLER, ETC. & LANDLORD EQUIPMENT THROUGHOUT CONSTRUCTION; COORDINATE WITH LANDLORD AS REQUIRED.
19. FOR ALL AREAS WITH WATERPROOFING:
    - INSTALL DAL-SEAL TS SINGLE SHEET WATERPROOFING MEMBRANE BELOW FINISH FLOOR & ABOVE CONCRETE SLAB. EXTEND MEMBRANE 6" UP ALL ADJACENT WALLS. PROVIDE MEMBRANE AT ALL 'WET' AREAS & FLOOR PENETRATIONS. ALL DRAINS MUST BE ACCESSIBLE & HAVE CLEANOUTS.
    - USE NOBLEFLEX DRAIN FLASHING WHEN DRAIN RING IS BELOW FINISH FLOOR.
    - PREP FLOOR TO RECEIVE FLOOR DRAIN WITH PITCH. REFER TO DETAILS FOR MORE INFO.
21. METAL STUDS TO BE 3-5/8" WHEREVER POSSIBLE.; EXTEND TO U.O. DECK.
22. GC TO COORDINATE ALL IN-SLAB PLUMBING CONNECTIONS w/ MEP DRAWINGS.
23. GC TO SCAN SLAB PRIOR TO ANY SLAB MODIFICATIONS IMMEDIATELY FOLLOWING CHALK LAYOUT. NOTIFY ARCHITECT IMMEDIATELY IF OBSTRUCTIONS ARE LOCATED.
24. GC TO REVIEW MALL CONSTRUCTION GUIDE FOR ALL MANDATORY VENDORS & REGULATIONS.
25. GC TO CONFIRM THERE ARE NO WATER DAMAGE WITHIN PREMISES.
26. ALL GLASS TO BE CERTIFIED AND LABELED FOR INSPECTION. SHOP DRAWINGS TO INDICATE LOCATION OF LABELS FOR APPROVAL.
27. ALL DOOR LOCKS TO HAVE CONSTRUCTION CORES. REFER TO A-600 FOR FINAL CORE-SPEC.
28. MILLWORKER TO CONFIRM ANY MALL FIRE RATING REQUIREMENTS FOR MILLWORK FIXTURES.
29. ALL WALL MOUNTED DEVICE LOCATIONS TO BE APPROVED BY ARCHITECT PRIOR TO INSTALLATION.

## FLOOR PLAN KEY NOTES

| TAG | DESCRIPTION |
|---|---|
| 1 | LEASELINE (V.I.F.). VERIFY WITH LANDLORD AT START OF CONSTRUCTION. |
| 2 | NEW STOREFRONT WINDOW AND ENTRY. GC TO PREP EXISTING STRUCTURE FOR NEW DOUBLE DOOR BY VENDOR. INSTALL BY GC. SEE A-700 FOR MORE INFORMATION. |
| 3 | FRP WALL PANELS AROUND MOP SINK; SEE INTERIOR ELEVATIONS |
| 4 | WET AREA(S) TO BE EQUIPPED WITH WATERPROOF MEMBRANE TURNED UP MINIMUM 6"; SEE 'GENERAL NOTES' |
| 5 | G.C. TO PROVIDE ½" FRT PLYWOOD OVER GYP. BD. FOR DEVICE MOUNTING; UTILIZE FULL SHEETS WHERE FEASIBLE; COORD. w/ POWER & DATA CUT-OUTS; PAINT 'P-1' EXCEPT AT FRT STAMP |
| 6 | PROVIDE WATER LINES FOR APPLIANCES AND EQUIPMENT, AS REQ'D; SEE ENGINEER DRAWINGS |
| 7 | ELECTRICAL EQUIPMENT; SEE POWER PLAN & ENGINEER'S DWGS FOR FINAL LOCATIONS & REQUIREMENTS |
| 8 | INTERNALLY-ILLUMINATED STOREFRONT SIGNAGE ABOVE BY STOREFRONT VENDOR; G.C. TO PROVIDE & COORD. POWER REQS. SEE DETAILS & STOREFRONT ELEVS |
| 9 | GC WALL TO EXTEND ABOVE MILLWORK DOOR; COORDINATE ROUGH OPENING SIZE; HEADER REQS. & BLOCKING REQUIREMENTS WITH MILLWORKER. COORDINATE CONNECTION BETWEEN MILLWORK AND GYP. BD. FINISH |
| 10 | GC TO CONFIRM IF EXISTING DEMISING WALL IS FULL HEIGHT WITH GYP. BOARD TO UNDERSIDE OF DECK & FULL RATED. G.C. TO FIRESTOP ANY NEW OR EXISTING PENETRATIONS AS REQUIRED. G.C. TO PROVIDE UNIT PRICING FOR NEW GYP. BOARD AS REQUIRED BY CURRENT CONDITIONS; INCLUDE GYP. BOARD FULL HEIGHT AT TENANT SEPARATION WALL. |
| 11 | GC TO PREP SLAB FOR NEW FLOOR FINISH. REMOVE ANY RESIDUE, ADHESIVES OR CONSTRUCTION DEBRIS, ETC. AS REQUIRED. FLOOR TO BE INFILLED FOR RL FINISH TO BE FLUSH WITH EXTERIOR DATUM IN REQUIRED. FLOOR INFILL TO BE INSTALLED LEVEL THROUGHOUT - ½" MAX. TOLERANCE ACROSS ENTIRE SALES AND CAFE FLOOR. |
| 12 | EXISTING LANDLORD PAVERS TO BE PROTECTED THROUGHOUT DEMOLITION AND CONSTRUCTION; PATCH AND FINISH PER LANDLORD STANDARDS AS REQUIRED. |
| 13 | GC TO GRIND CONCRETE SLAB OR PROVIDE INFILL AS REQUIRED TO ENSURE SMOOTH AND LEVEL TRANSITION BETWEEN THE MALL FINISH AND INTERIOR OF THE STORE. |
| 14 | GC TO TRENCH OR CORE DRILL AS REQUIRED FOR PLUMBING. GC TO SCAN SLAB PRIOR TO TRENCHING OR CORE DRILL TO LOCATE ALL REBAR; NOTIFY ARCHITECT IF LOCATION SHOWN IS UNACHEIVABLE. |
| 15 | FINISH TRANSITION TO MILLWORK AFTER MILLWORK INSTALL. COORDINATE WITH MILLWORKER |
| 16 | GC TO ENSURE FLOOR IS LEVELED TO RECEIVE MOBILE SHELVING, PATCH/LEVEL AS REQUIRED. 1/8" MAX TOLERANCE ACROSS ROLLING SHELF RUN; PATCH TO THE THIS TOLERANCE IN AREA OF ROLLING SHELVES ONLY. CONFIRM WITH VENDOR. |
| 17 | GC TO TRENCH OR CORE DRILL AS REQUIRED ANY FLOOR BOXES OR WHIPS AS REQ. FOR MILLWORK AND/OR FURNITURE CONNECTIONS. ALL FLOOR BOX AND WHIP LOCATIONS TO BE CONFIRMED WITH MILLWORKER PRIOR TO ANY SLAB CUTTING. GC TO SCAN SLAB PRIOR TO CORE DRILLING TO LOCATE ALL REBAR; NOTIFY ARCHITECT IF LOCATION SHOWN IS UNACHIEVABLE. SEE DEMO PLAN NOTES. |
| 18 | BLOCKING FOR MIRRORS. SEE FITTING ROOM INTERIOR ELEVATION |
| 19 | EXISTING DOOR AND HARDWARE TO REMAIN |
| 20 | GC TO PROVIDE & INSTALL FRT BLOCKING/ PLYWOOD & MTL. STUDS., IF REQ'D. AT PLANNED MILLWORK LOCATIONS. COORDINATE W/ M.W.C. |
| 21 | EXISTING STRUCTURE: COLUMNS / STRUCTURAL BEAMS / PARTITIONS, WHERE NOTED. TO REMAIN. GC TO PROTECT & NOT DISTURB ANY EXISTING FIREPROOFING THROUGHOUT SPACE. PATCH/ REPAIR AREAS TO MAINTAIN REQUIRED FIRE-RESISTANT RATING THROUGHOUT. |
| 22 | KNEE WALL FOR CAFE SERVICE COUNTER. GC TO COORDINATE DIMENSIONS WITH VENDOR SHOP DRAWINGS AND INSTALL |
| 23 | SEE MILLWORK DETAIL SHEET FOR PLACEMENT OF PLYWOOD BACKING AT IN-SET FIXTURE LOCATION. SEE HOLD DIMENSION FOR OVERALL LENGTH OF PLYWOOD |

RALPH LAUREN

## SPACE PLAN

RALPH LAUREN
STANFORD SHOPPING CENTER
SPACE 383A

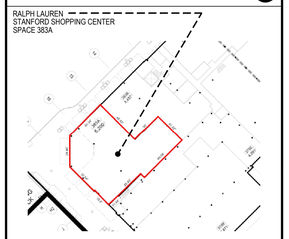

Lam+Tea Engineering

kpff

## SUBMISSION FOR ARCHITECTURAL REVIEW BOARD

| NO. | REVISION | | DATE | BY |
|---|---|---|---|---|
| 9 | A.R.B. CORRECTIONS 2 | 7 | 07.22.2025 | TPG |
| 8 | PERMIT CORRECTIONS 2 | 6 | 07.02.2025 | TPG |
| 7 | A.R.B. CORRECTIONS 1 | 5 | 05.30.2025 | TPG |
| 6 | BOARD OF HEALTH CORRECTIONS | 4 | 04.18.2025 | TPG |
| 5 | LATEST FULL SET UPDATES | 3 | 04.14.2025 | TPG |
| 4 | PERMIT CORRECTIONS 1 | 2 | 05.23.2025 | TPG |
| 3 | BID ADDENDUM 1 | 1 | 03.11.2025 | TPG |
| 2 | ISSUED FOR BID & PERMIT | | 01.10.2025 | TPG |
| 1 | PROGRESS SET FOR CLIENT REVIEW | | 12.13.2024 | TPG |


TPG Architecture

**TPG ARCHITECTURE, LLP**
**31 PENN PLAZA**
**132 WEST 31ST STREET, 5TH FLOOR, NEW YORK, NY 10001**
**212.768.0800 | TPGARCHITECTURE.COM**



IN CONSIDERATION OF RECEIVING DRAWINGS FROM TPG ARCHITECTURE LLP IN AN ELECTRONIC FORM, THE RECIPIENT AGREES, TO THE FULLEST EXTENT PERMITTED BY LAW, TO HOLD HARMLESS AND INDEMNIFY TPG ARCHITECTURE LLP FROM AND AGAINST ALL CLAIMS, LIABILITIES, LOSSES, DAMAGES, AND COSTS, INCLUDING BUT NOT LIMITED TO ATTORNEY'S FEES, ARISING OUT OF, OR IN ANY WAY CONNECTED WITH THE USE, RE-USE, MIS-USE, MODIFICATION, OR MISINTERPRETATION OF THE MACHINE-READABLE INFORMATION PROVIDED BY TPG ARCHITECTURE LLP UNDER THIS AGREEMENT.


PROJECT
**RALPH LAUREN**
**STANFORD SHOPPING CENTER**
180 EL CAMINO REAL #383A, BLDG. M
PALO ALTO, CA 94304

DRAWING






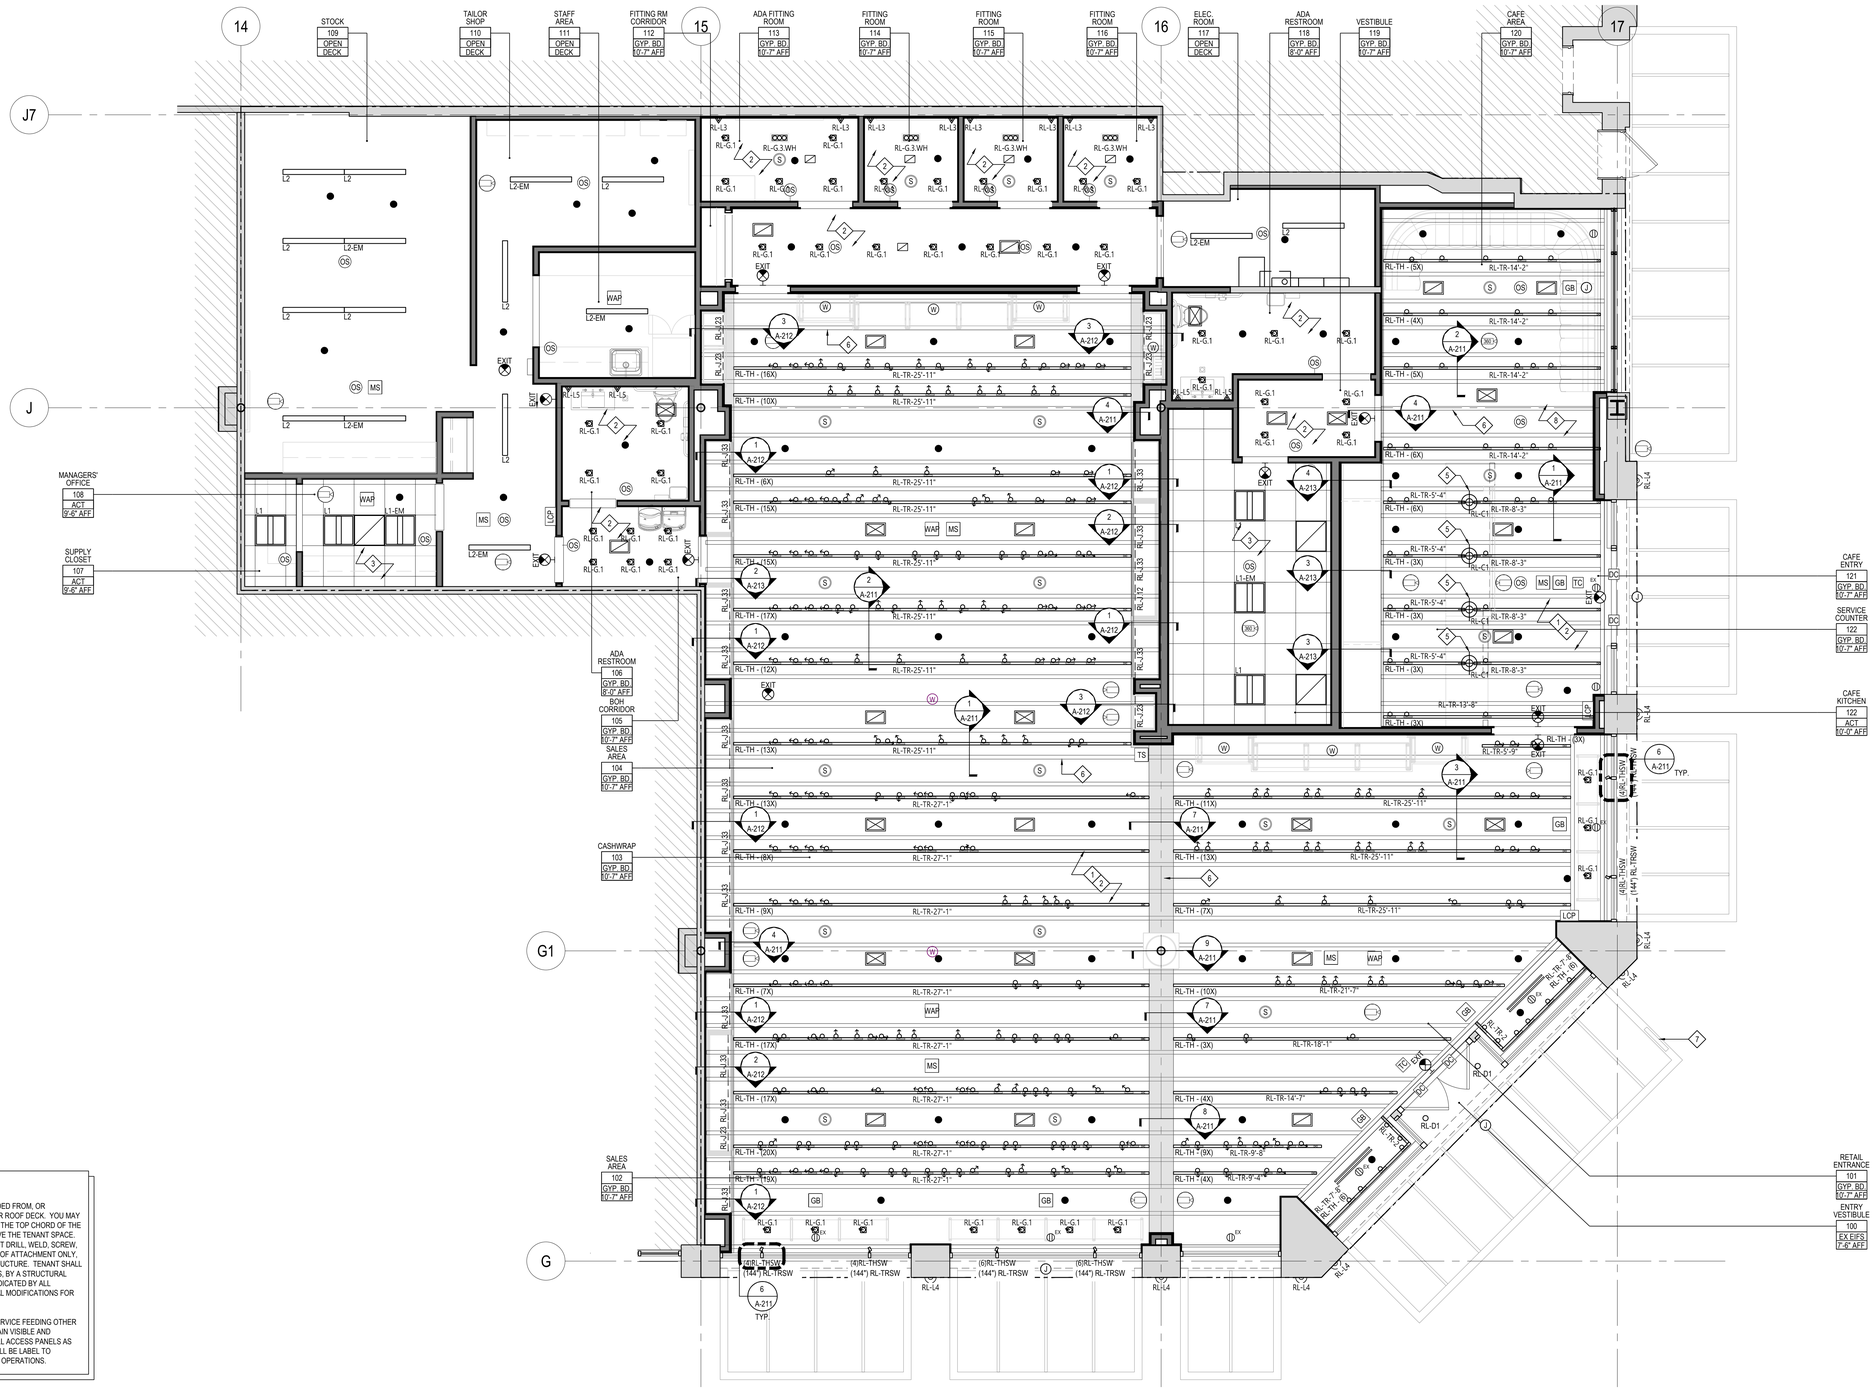


LANDLORD REQUIREMENTS:

NOTHING IS PERMITTED TO BE ATTACHED TO, SUSPENDED FROM, OR PENETRATE LANDLORD'S STRUCTURE, FLOOR DECK, OR ROOF DECK. YOU MAY ATTACH, NON-DESTRUCTIVELY, TO OR SUSPEND FROM THE TOP CHORD OF THE JOIST OR THE STRUCTURAL STEEL WHICH EXISTS ABOVE THE TENANT SPACE. WHEN ATTACHING TO LANDLORD'S STRUCTURE, DO NOT DRILL, WELD, SCREW, OR SHOOT INTO STRUCTURE. ALTERNATIVE METHODS OF ATTACHMENT ONLY. NOTHING TO DAMAGE LANDLORD'S BASE BUILDING STRUCTURE. TENANT SHALL PROVIDE SIGNED AND SEALED STRUCTURAL DRAWINGS, BY A STRUCTURAL ENGINEER WITH LEGALLY ACTIVE REGISTRATION AS INDICATED BY ALL JURISDICTIONAL REQUIREMENTS, FOR ALL STRUCTURAL MODIFICATIONS FOR LANDLORD RECORDS.

ANY LANDLORD EQUIPMENT, COMPONENT, AND / OR SERVICE FEEDING OTHER TENANT(S) THAT IS EXISTING IN THE SPACE MUST REMAIN VISIBLE AND ACCESSIBLE TO THE LANDLORD. TENANT SHALL INSTALL ACCESS PANELS AS REQUIRED TO MAINTAIN ACCESS. ACCESS PANELS SHALL BE LABEL TO PROPERLY IDENTIFY SYSTEM, COORDINATE WITH MALL OPERATIONS.

## 1 REFLECTED CEILING PLAN

SCALE: 1/4"=1'-0"

## REFLECTED CEILING PLAN LEGEND

| TAG | DESCRIPTION |
|---|---|
| LP / EX | EXISTING PENDANT SPRINKLER TO REMAIN<br>EXISTING CONCEALED SPRINKLER TO REMAIN |
| S | SPEAKER |
| OS | OCCUPANCY SENSOR |
| R | CONCEALED, FLUSH MOUNTED SPRINKER HEAD, FINISH TO MATCH ADJACENT CLG. COLOR |
| XXXX<br>X'-X" AFF | CEILING TAG |
| | SUPPLY AIR GRILLE, SEE MECHANICAL DRAWINGS |
| | RETURN AIR GRILLE, SEE MECHANICAL DRAWINGS |
| MS | MOTION SENSOR BY SECURITY VENDOR |
| | EXIT SIGN |
| WAP | WIRELESS ACCESS POINT |

## GENERAL NOTES

1. SEE ENGINEER'S DRAWINGS FOR CIRCUITING, SWITCHING, SPECIFICATIONS, FIXTURE SCHEDULE, QUANTITIES, ADDITIONAL FIXTURES, ETC. NOT SHOWN ON THIS SHEET.
2. INCLUDE IN PRICE ANY CEILING TAKE-DOWN & / OR REINSTALLATION REQUIRING ACCESS IN AREAS NOT INDICATED ON DWGS AS REQ'D.
3. ALL CEILING HEIGHTS TO U.O. FINISHED CEILING FROM T.O. FINISHED FLOOR, U.N.O.
4. ALL CEILING-MOUNTED DEVICES TO BE INSTALLED AT CENTERLINE OF LIGHT FIXTURES. ALL LIGHT FIXTURE & DEVICE LOCATIONS TO BE CHALKED ON CEILING / WALLS FOR OWNER'S APPROVAL PRIOR TO INSTALLATION.
5. COORDINATE ALL CEILING HEIGHTS w/ ENGINEER'S DRAWINGS / EQUIPMENT LOCATIONS; NOTIFY ARCHITECT IMMEDIATELY OF ANY DISCREPANCIES.
6. COORDINATE EMERGENCY LIGHT FIXTURE QUANTITY / LOCATIONS WITH ENGINEER'S DRAWINGS.
7. SUBMIT COORDINATED SHOP DRAWINGS FOR ALL ABOVE-CLG TRADES.
8. CONFIRM & COORDINATE CEILING HEIGHTS WITH ANY NEW OR EXISTING FIELD CONDITIONS; IMMEDIATELY NOTIFY ARCHITECT & OWNER IF CEILING HEIGHTS ARE NOT POSSIBLE.
9. HVAC UNIT(S) TO BE PROTECTED PRIOR TO START OF CONSTRUCTION (CONSTRUCTION FILTER). UNIT(S) MUST BE CLEANED AT COMPLETION OF CONSTRUCTION.
10. A / V SYSTEM BY OWNER; VENDOR TO SUPPLY, INSTALL & TERMINATE. CABLING PROVIDED BY OWNER; GC TO PULL. DEVICE CUT-OUTS & PREP BY GC. GC TO FULLY-COORDINATE w/ ALL TRADES.
11. ADEQUATE CLEARANCE TO BE PROVIDED AT ALL MEP ELEMENTS / DEVICES AS REQ'D PER ALL APPLICABLE CODE & STANDARDS.
12. ALL EXPOSED STRUCTURE TO BE PAINED & EXISTING FIRE-RATING MAINTAINED.
13. ALL LIGHTING AROUND CAFE FOOD PREP AND SERVICE AREA TO HAVE SHATTERPROOF BULBS*
14. ADDITIONAL HANGERS OR SAFETY WIRES FOR CEILING FIXTURES / DEVICES TO BE PROVIDED AS REQUIRED BY CODE(S).
15. ALL CEILINGS & ASSOCIATED FRAMING, FURRING & BLOCKING TO BE CONSTRUCTED FROM NON-COMBUSTIBLE, UL-APPROVED MATERIALS.
16. MILLWORKER TO ESTABLISH FINAL QUANTITIES OF LED DRIVERS PER FIXTURE w/ LIGHT FIXTURE MANUFACTURER.
17. MILLWORKER TO LOCATE DRIVERS & BALLASTS AS SHOWN IN DETAILS.
18. ALL LIGHT FIXTURE TRIMS, HVAC GRILLES / DIFFUSERS / RETURNS, & SPRINKLER HEAD CAPS TO MATCH ADJACENT CEILING COLOR U.N.O.
19. GC TO INCLUDE ALL TESTING, PROGRAMMING, FINAL CONNECTION AS REQ'D. TO TIE ALL DEVICES INTO BUILDING FIRE SPRINKLER / ALARM SYSTEM. ALL REQ'D. CERTIFICATES OF INSPECTION TO BE PROVIDED AT CONSTRUCTION COMPLETION.
20. GC IS RESPONSIBLE FOR ALL LIGHT FIXTURE LAMPING UNTIL COMPLETION OF PUNCH LIST. LIGHT FIXTURES TO BE THOROUGHLY-CLEANED PRIOR TO PROJECT COMPLETION.
21. SPRINKLER HEADS AT A.C.T. CEILINGS MUST BE FULLY-RECESSED. CENTER HEADS IN CEILLING TILES WHEREVER POSSIBLE U.N.O.
22. SPRINKLER HEADS AT GYP. BD. CEILINGS MUST BE FULLY-RECESSED. CENTER HEADS w/ ADJACENT LIGHT FIXTURES / DEVICES WHEREVER POSSIBLE U.N.O.
23. REFER TO MECHANICAL PLAN FOR NEW ROOF OPENING FOR NEW RTU. GC TO COORDINATE w/ MEP & STRUCTURAL DRAWINGS FOR DETAILS.
24. GC TO FULLY-COORDINATE FRAMING & BLOCKING TO RECEIVE ALL LIGHT FIXTURES & CEILLING-MOUNTED DEVICES.
25. "EM" LIGHT FIXTURE DESIGNATION INDICATES EMERGENCY FIXTURE.

## LIGHTING SCHEDULE

| SYMBOL | TAG | DESCRIPTION | WATTS | NOTES |
|---|---|---|---|---|
| RL-G.1 | RL-G.1 | GIMBAL MINI SINGLE TR DOWNLIGHT W/ HOUSING. 4" SQUARE APERTURE OPENING W/ 6"X6" HOUSING. PROVIDE STANDARD LUMINARIES WITH SORAA LED REPLACEMENT LAMP. MATTE BALCK HOUSING INTERIOR FINISH. FIXTURE TO BE MATTE WHITE. | 7.5 | PROVIDED BY RL. GC TO INSTALL. CONTRACTOR TO CONFIRM AND PROVIDE ALL MOUNTING HARDWARE AS REQUIRED. |
| RL-TH | RL-TH | TRACK HEAD AT RL-TR. LF ILLUMINATION. TRA19B-G-01GU10X-NA1-WW. | 7.5 | PROVIDED BY RL. GC TO INSTALL. WHITE. |
| RL-TR-LENGTH | RL-TR | TRACK FOR RL-TH . TO BE CUT ON SITE TO CORRECT SIZE. LF ILLUMINATION GES212-3 | | PROVIDED BY RL. GC TO INSTALL. SURFACE MOUNTED ON DRYWALL CEILING. WHITE. |
| RL-G.3.WH | RL-G.3 | GIMBAL MINI TRIPLE TR DOWNLIGHT W/ HOUSING. RECESSED WITH TRIM IN DRYWALL CEILING. 13.94" L X 5.12" W. PROVIDE STANDARD LUMINARIES WITH SORAA LED REPLACEMENT LAMP. WHITE TRIM/ WHITE GIMBAL/ BLACK INTERIOR. | 7.5 | PROVIDED BY RL. GC TO INSTALL. CONTRACTOR TO CONFIRM AND PROVIDE ALL MOUNTING HARDWARE AS REQD. |
| RL-THSW | RL-THSW | LUMENTURE TRACK HEAD. T40-30H-600-22-B-J-SNC. BLACK. | 7 | PROVIDED BY RL. GC TO INSTALL AT STOREFRONT WINDOW MULLIONS |
| L2 | L2 | LITHONIA LIGHTING - CHAIN MOUNTED - 4' LINEAR. CLX L48 300LM SEF RDL MVOLT GZ10 30K80CRI WH - WHITE LED | 20.3 | PROVIDED AND INSTALLED BY GC. EM - WITH EMERGENCY BATTERY PACK PER CODE WHERE INDICATED |
| L1 | L1 | LEDALITE BY SIGNIFY. RECESSED VERSAFORM 2X2. 41-22-D1-ST-L-8B-E-S - WHITE LED | 27 | |

| SYMBOL | TAG | DESCRIPTION | WATTS | NOTES |
|---|---|---|---|---|
| RL-L3 | RL-L3 | VISUAL COMFORT GENEVA MEDIUM SCONCE 2026BZ-WG - BRONZE / WHITE GLASS | 3 - 40 B11 | BY RL DECO TEAM |
| RL-L4 | RL-L4 | VISUAL COMFORT. CHAPMAN & MEYERS. LINEAR LARGE WALL LANTERN - SIGNATURE COLLECTION. | | EXTERIOR. INSTALLED AT EXISTING LOCATION. PROVIDED BY RL DECO TEAM, INSTALLED BY GC. |
| RL-L5 | RL-L5 | VISUAL COMFORT GENEVA MEDIUM SCONCE 2025NB-WG - BRONZE / WHITE GLASS | 2 - 40 B11 | BY RL DECO TEAM |
| RL-C1 | RL-C1 | VISUAL COMFORT McCARREN LARGE GLOBE PENDANT 5461NB-WG - NATURAL BRASS / WHITE GLASS | 75 | BY RL DECO TEAM |
| RL-D1 | RL-D1 | LUCENT SQUARE EDGE 4.25" FIXED. A31433-F-LED-BK-DP-PB-SCI-C-LED51/2-30-38. LH-6.75-NIC. 120-A-E-LL45. PROVIDE STANDARD LUMINARIES WITH SORAA LED REPLACEMENT LAMP. | 7.5 | REPLACE AT EXISTING FIXTURE LOCATION |
| RL-J.(LENGTH) | RL-J.(X) | NICHE LINEAR LED FIXTURE | 17 | FURN./INSTALL. BY GC |
| | RL-TRSW | LUMENTURE JT-4/8-B. TRACK FOR RL-THSW. BLACK LENGTH AS SPECIFIED ON PLANS. VIF. BLACK. LUMENTURE SURFACE MOUNTED LOW VOLATGE TRACK. | | PROVIDED BY RL. GC TO INSTALL AT STOREFRONT WINDOW MULLIONS |

## FLOOR PLAN KEY NOTES

| TAG | DESCRIPTION |
|---|---|
| 1 | G.C. TO ENSURE ALL EXISTING STRUCTURE TO REMAIN IS UNDISTURBED THROUGHOUT CONSTRUCTION. MAINTAIN ANY EXISTING FIRE RATING REQUIREMENTS. G.C. TO VERIFY CONDITIONS IN FIELD AND REPORT ANY DISCREPANCIES IN WRITING TO THE ARCHITECT IMMEDIATELY. (TYP. THROUGHOUT) |
| 2 | EXISTING GYP CEILING TO REMAIN WHERE FEASIBLE. GC TO COORDINATE ANY ABOVE CEILING ACCESS FOR SCOPE AS SCHEDULED. PATCH/REPAIR AND REPLACE AS REQUIRED. |
| 3 | NEW ACT CEILING AT BOH AS REQUIRED REFER TO SHEET DETAILS FOR ADDITIONAL INFO |
| 4 | AREA FOR DIFFUSER FOR AIR SUPPLY, RETURN, OR EXHAUST |
| 5 | CEILING HUNG PENDANTS AS SCHEDULED. GC TO PROVIDE BLOCKING FOR ATTACHMENT AS REQUIRED. CENTER ON MILLWORK COUNTER BELOW. |
| 6 | NEW FAUX BEAM / JOISTS AT CEILING. |
| 7 | BLADE SIGN, COORDINATE FINAL LOCATION WITH RALPH LAUREN & LANDLORD. |
| 8 | ALL LIGHTING AROUND CAFE FOOD PREP AND SERVICE AREA TO HAVE SHATTERPROOF BULBS |

RALPH LAUREN

## SPACE PLAN

RALPH LAUREN
STANFORD SHOPPING CENTER
SPACE 383A

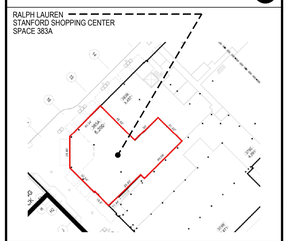

Lam+Tea Engineering

kpff

## SUBMISSION FOR ARCHITECTURAL REVIEW BOARD

| NO. | REVISION | DATE | BY |
|---|---|---|---|
| 9 | A.R.B. CORRECTIONS 2 | 07.22.2025 | TPG |
| 8 | PERMIT CORRECTIONS 2 | 07.02.2025 | TPG |
| 7 | A.R.B. CORRECTIONS 1 | 05.30.2025 | TPG |
| 6 | BOARD OF HEALTH CORRECTIONS | 04.18.2025 | TPG |
| 5 | LATEST FULL SET UPDATES | 04.14.2025 | TPG |
| 4 | PERMIT CORRECTIONS 1 | 05.23.2025 | TPG |
| 3 | BID ADDENDUM 1 | 03.11.2025 | TPG |
| 2 | ISSUED FOR BID & PERMIT | 01.10.2025 | TPG |
| 1 | PROGRESS SET FOR CLIENT REVIEW | 12.13.2024 | TPG |


TPG Architecture

TPG ARCHITECTURE, LLP
31 PENN PLAZA
132 WEST 31ST STREET, 5TH FLOOR, NEW YORK, NY 10001
212.768.0800 | TPGARCHITECTURE.COM



IN CONSIDERATION OF RECEIVING DRAWINGS FROM TPG ARCHITECTURE LLP IN AN ELECTRONIC FORM, THE RECIPIENT AGREES, TO THE FULLEST EXTENT PERMITTED BY LAW, TO HOLD HARMLESS AND INDEMNIFY TPG ARCHITECTURE LLP FROM AND AGAINST ALL CLAIMS, LIABILITIES, LOSSES, DAMAGES, AND COSTS, INCLUDING BUT NOT LIMITED TO ATTORNEY'S FEES, ARISING OUT OF, OR IN ANY WAY CONNECTED WITH THE USE, RE-USE, MIS-USE, MODIFICATION, OR MISINTERPRETATION OF THE MACHINE-READABLE INFORMATION PROVIDED BY TPG ARCHITECTURE LLP UNDER THIS AGREEMENT.


PROJECT
**RALPH LAUREN**
**STANFORD SHOPPING CENTER**
180 EL CAMINO REAL #383A, BLDG. M
PALO ALTO, CA 94304

DRAWING
REFLECTED CEILING PLAN

FOR ARB EXHIBIT

SEAL

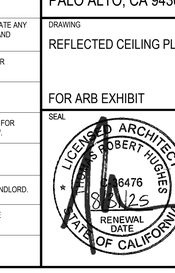


| | |
|---|---|
| DATE | 01/10/2025 |
| PROJECT NO. | 1524879-00 |
| SCALE | 1/4"=1'-0" |
| DWG NO. | A-201.00 |
| CAD FILE NO. | A-201.00_RCP.DWG |
| PAGE | 27 of 55 |


K:\01\1524879.0008_DRAWINGS\3_CAD\2_SHEETS\A-201.00_RCP.DWG | Plot Date: Mar. 20, 2025 - 6:24 AM
Last Saved By: MHAMANI | Save Date: 3/1/2025 7:15:38 AM

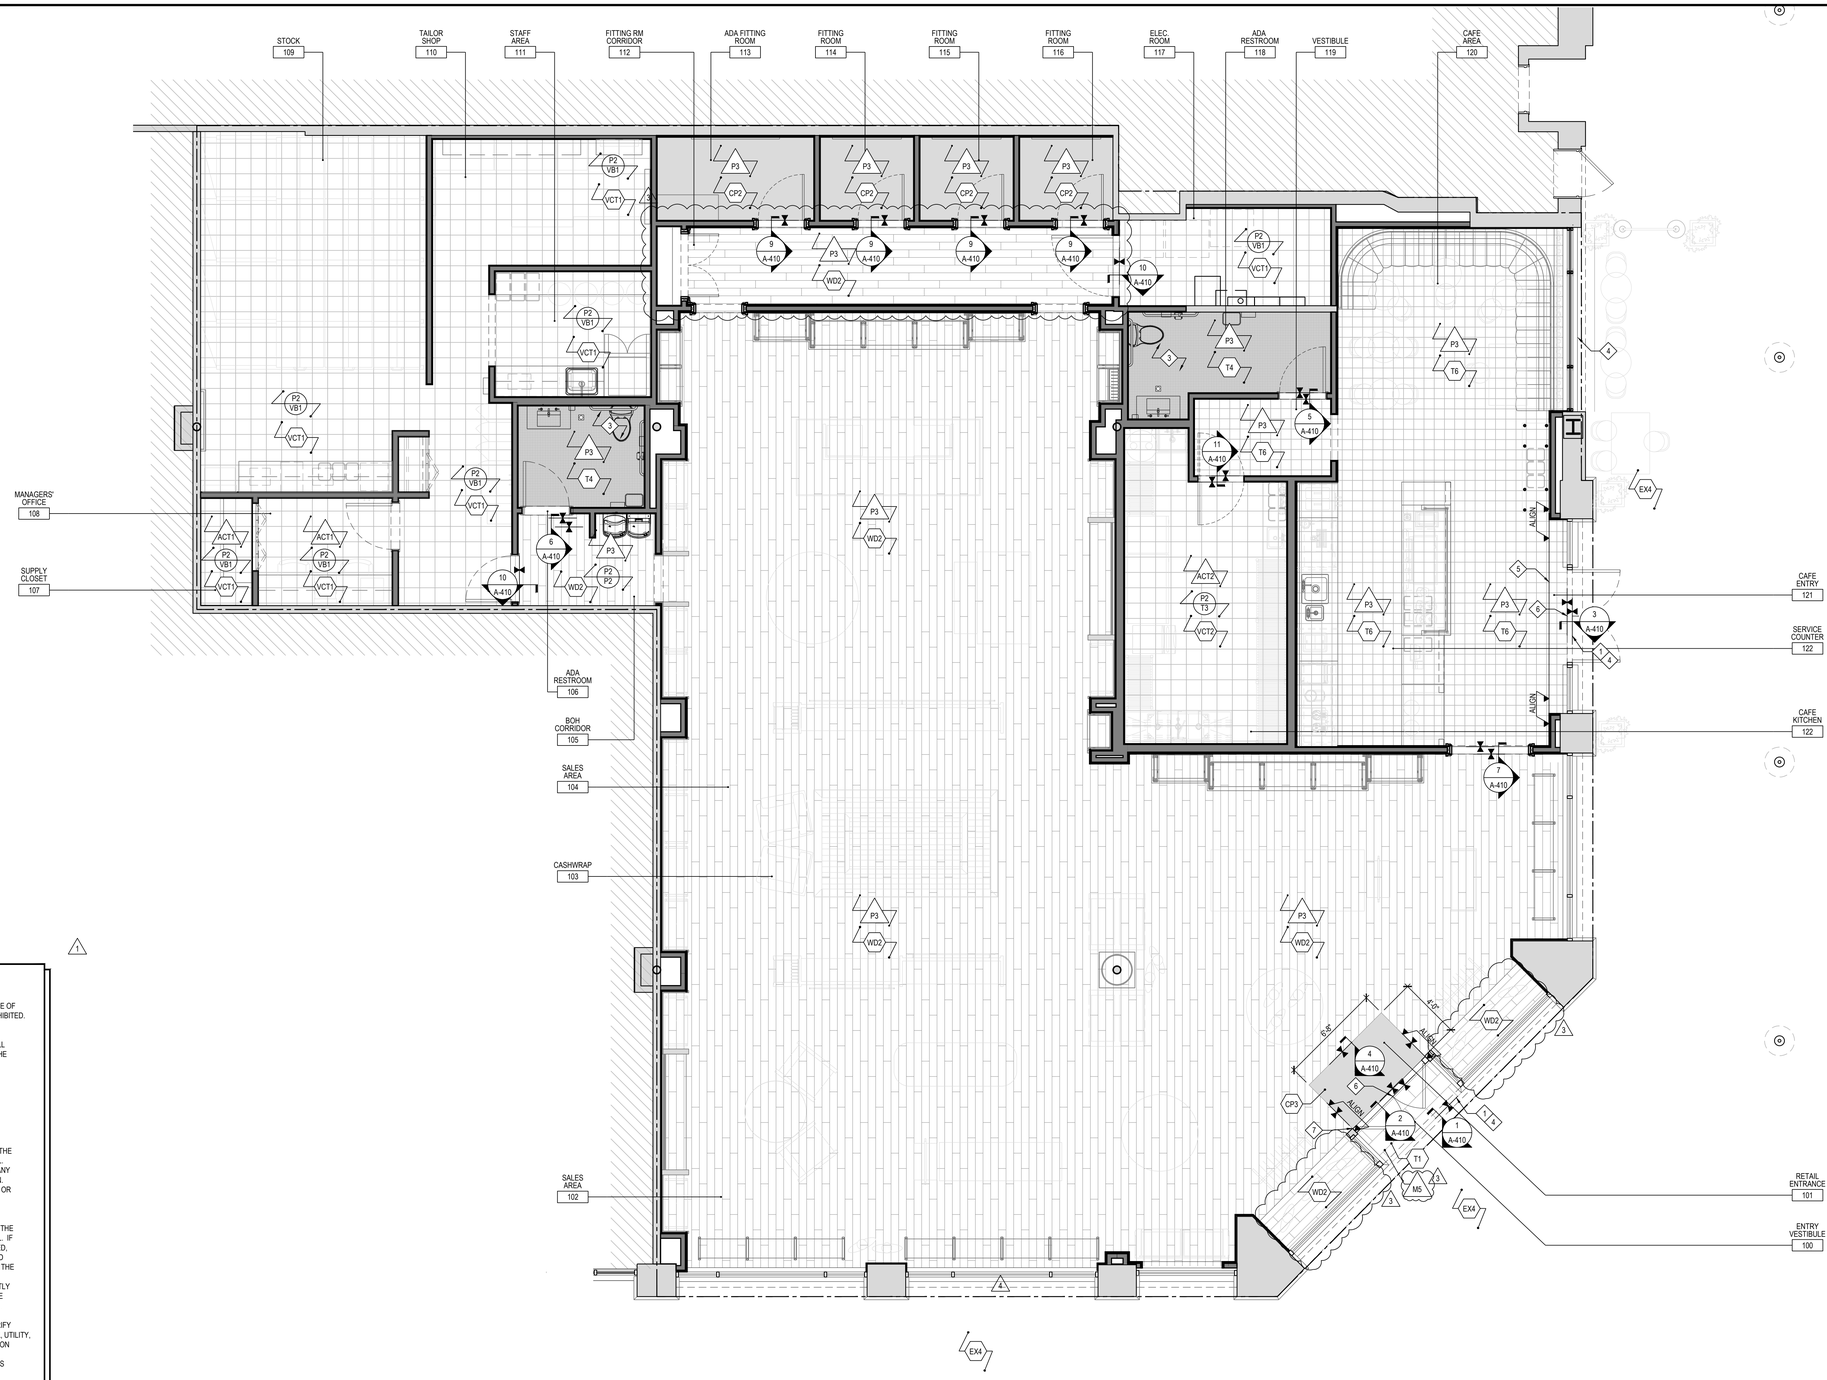


LANDLORD FINISH PLAN NOTE:

•ALL FLOORING TRANSITIONS MUST BE SMOOTH AND FLUSH. THE USE OF PLASTIC, VINYL, OR RUBBER TRANSITIONS STRIPS IS STRICTLY PROHIBITED. TENANTS MUST UTILIZE A HARD SURFACE TRANSITION.

•TENANT IS REQUIRED TO INSTALL A WATERPROOF MEMBRANE IN ALL WET AREAS (RESTROOMS, KITCHENS, FOOD SERVICES, ETC…) OF THE SPACE TENANT SHALL USE A 30 MIL POLYETHYLENE CLEAVAGE MEMBRANE (EQUAL TO NOBLESEAL TS) INSTALLED PER MANUFACTURERS RECOMMENDATIONS AND ANSI A108. MEMBRANE MUST BE EXTENDED UP THE WALL A MINIMUM OF 6" OR EQUAL TO THE HEIGHT OF THE FLOOR BASE.

•SLAB REQUIREMENTS:

SLAB ON GRADE: TENANT'S GENERAL CONTRACTOR SHALL ADVISE THE OPERATION TEAM PRIOR TO ANY SLAB MODIFICATIONS OR REMOVAL. TENANT GC SHALL VERIFY THAT WORK SHALL NOT CONFLICT WITH ANY EXISTING STRUCTURAL, UTILITY, OR OTHER UNDER-SLAB CONDITION. (NONDESTRUCTIVE VERIFICATION MAYBE REQUIRED ) ANY DAMAGE OR DOWNTIME CAUSED BY TENANT'S WORK SHALL BE REPAIRED AND REIMBURSED AT TENANT'S EXPENSE.

ELEVATED SLABS: TENANT'S GENERAL CONTRACTOR SHALL ADVISE THE OPERATIONS TEAM PRIOR TO ANY SLAB MODIFICATION OR REMOVAL. IF ANY ELEVATED SLAB IS TO BE MODIFIED IN ANYWAY (DRILLED, CORED, OR PENETRATED), TENANT SHALL PROVIDE STAMPED AND CERTIFIED DRAWINGS BY A LICENSED STRUCTURAL ENGINEERED CERTIFIED IN THE LOCAL JURISDICTION. ALL PENETRATIONS SHALL BE CORE BORED ONLY. SAW CUTTING, JACK HAMMERING, AND TRENCHING IS STRICTLY PROHIBITED. ALL PENETRATIONS SHALL BE SLEEVED, SEALED, FIRE STOPPED, AND WATERPROOFED. THE PENETRATION SLEEVE SHALL EXTEND A MINIMUM OF 4" ON EITHER SIDE OF THE SLAB AND BE LABELED WITH THE REQUIRED NFPA RATING. TENANT GC SHALL VERIFY THAT WORK SHALL NOT CONFLICT WITH ANY EXISTING STRUCTURAL, UTILITY, OR OTHER UNDER-SLAB CONDITION. (NONDESTRUCTIVE VERIFICATION MAYBE REQUIRED ) ANY DAMAGE OR DOWNTIME CAUSED BY TENANT'S WORK SHALL BE REPAIRED AND REIMBURSED AT TENANT'S EXPENSE.

## 1 FINISH PLAN

SCALE: 1/4"=1'-0"

## GENERAL NOTES

1. DOORS & FRAMES TO BE PAINTED TO MATCH ADJACENT WALLS w/ SEMI-GLOSS FINISH (U.N.O.). EXCLUDES STOREFRONT.
2. FLOORING TRANSITIONS TO BE SMOOTH & FLUSH.
3. RECEPTACLE COVERS TO BE FINISHED TO MATCH ADJACENT WALL (U.N.O.).
4. SEE FINISH SCHEDULE FOR SPECIFICATIONS.
5. WOOD FLOOR TO BE GLUED DOWN ON CONCRETE (PREFERRED). INSTALL MOISTURE BARRIER FIRST (ADHESIVE BY CBOSTIK MVP4 OR FRANKLIN 531) PRIOR TO GLUING WOOD FLOORING TO PROVIDE PERMANENT MOISTURE BARRIER.
6. ONCE FLOOR IS INSTALLED, USE ROSIN PAPER TO COVER & USE ONLY 3M BLUE TAPE. FOOT TRAFFIC OR HEAVY FURNITURE NOT PERMITTED ON FLOOR FOR 24 HOURS FOLLOWING INSTALLATION.
7. SUB-FLOOR TO BE:
   - STRUCTURALLY SOUND - PERFORM MOISTURE TEXT PRIOR TO WOOD FLOOR INSTALLATION ON SLAB.
   - CLEAN - THOROUGHLY SWEEP & ENSURE FREE OF DEBRIS. IF GLUED, SUBFLOOR MUST BE FREE FROM WAX, GREASE, PAINT, SEALERS, OLD ADHESIVE, ETC.
   - LEVEL - FLAT TO ⅛" PER 10'-0" RADIUS.
   - MOISTURE CONTENT - NOT TO EXCEED LEVELS REQUIRED BY WOOD FLOORING MANUACTURER.
   - DRY & WELL-SECURED - NAIL OR SCREW EVERY 6" ALONG JOISTS TO AVOID SQUEAKING.
8. CONCRETE SUBFLOOR MUST BE FULLY-CURED MIN. 60 DAYS PRIOR TO WOOD FLOOR INSTALLATION.
   - GC RESPONSIBLE TO RECEIVE & HANDLE FLOORING PRIOR TO INSTALLATION.
9. PROVIDE SAMPLES OF ALL FINISHES, EXCEPT OWNER- PROVIDED, TO ARCHITECT/TENANT FOR APPROVAL PRIOR TO ORDERING / FABRICATION.
10. ALL GLASS (MIRRORED, FROSTED & CLEAR) TO BE EXTRA LOW-IRON.
11. CARPETING PROVIDED BY OWNER. CARPETS IN SALES AREA TO BE AREA RUGS INSTALLED OVER WOOD FLOOR. PROVIDE COMMERCIAL-GRADE DOUBLE-SIDED TAPE AROUND ENTIRE PERIMETER OF ALL RUGS; DO NOT GLUE DOWN.
12. WOOD FLOORING & PATTERN TO CONTINUE BELOW ALL RUGS / CARPETS & EXTEND TO BACK EDGE OF WALL UNITS.
13. FLOOR SURFACES TO BE SLIP-RESISTANT w/ INDIVIDUAL STATIC COEFFICIENT OF FRICTION OF > 0.6 FOR FLAT SURFACES & > 0.8 FOR SLOPED SURFACES PER ASTM C1028.
14. FLR. LEVEL AT DOORS TO BE 1/2" MAX. LOWER THAN THRESHOLD, PROVIDED THRESHOLD HAS 1:2 MAX. BEVELED SLOPE.
15. PROVIDE WOOD FLOORING ADHESIVE GLUE (MAPEI ULTRABOND ECO 995 PREMIUM MOISTURE CONTROL, SOUND REDUCTION & WOOD-FLOORING ADHESIVE OR EQ.) & INSTALL PER MANUFACTURER'S REQUIREMENTS.
16. WOOD FLOORING CONTRACTOR RESPONSIBLE FOR INSTALL OF WOOD ACCESS PANEL OVER FLOOR BOXES. SEE FLR. BOX DETAILS.
17. ENSURE FLOOR IS LEVELED AS REQUIRED w/ ARDEX K-15 SYSTEM.
18. PREPARE FLOOR FOR PIVOT DOORS. SEE DOOR SCHEDULE.
19. ALL B.O.H. WALLS TO BE PAINTED "P1" w/ "VB1" WALL BASE U.N.O.
20. PROVIDE WATERPROOFING AT FLOORS/WALLS AND WATER RESISTANCE AT WALL UP TO 6" MIN. AS REQUIRED BY APPLICABLE CODES AND LL.

## FINISH LEGEND

| SYMBOL | DESCRIPTION | SYMBOL | DESCRIPTION |
|---|---|---|---|
| X | CEILING FINISH | | MOSAIC TILE |
| X | FLOOR FINISH | | SLATE FLOOR |
| X | FLOOR TRANSITION | | LANDLORD PAVER FLOOR |
| | WOOD FLOOR | | |
| | CARPET | | |
| | V.C.T. FLOOR | | |

## FINISH LEGEND

| TAG | DESCRIPTION |
|---|---|
| 1 | EXTERIOR VESTIBULE FLOORING TO SLOPE FROM INTERIOR LEVEL TO MALL FLOORING AT 1:48 MAX. SEE STOREFRONT DRAWINGS. |
| 2 | LOOSE CARPET OVER WOOD FLOOR. CARPETS TO BE TAPED DOWN ON ALL FOUR SIDES USING POLYKEN CARPET TAPE. |
| 3 | COORDINATE LOCATION OF TILE-IN FLOOR DRAIN WITH FLOOR PATTERN. |
| 4 | CONFIRM EXTEND OF LANDLORD PAVERS. REPLACE LAST ROW OF LANDLORD TILE AS NEEDED TO EXTEND INTO REVEAL AT STOREFRONT BASE. G.C. TO PURCHASE PAVERS FROM LANDLORD |
| 5 | GC TO SLOPE TILE FLOORING FROM INTERIOR LEVEL TO DOOR THRESHOLD AT 1:48 MAX. SEE STOREFRONT DRAWINGS FOR MORE INFORMATION. |
| 6 | CENTER FULL TILE AT ENTRY DOOR THRESHOLD FOR START POINT FINISH. |
| 7 | START POINT OF WOOD FLOORING. RL TO CONFIRM FINAL START POINT AND PLANK DIRECTION. |

## MANDATORY CALGREEN REQUIREMENTS

SECTION 5.504 FINISH MATERIAL POLLUTANT CONTROL REQUIREMENT:

ALL FINISH MATERIALS SHALL MEET THE REQUIREMENTS OF SECTIONS 5.504.1 THROUGH 5.504.4.6

TGC TO SUBMIT TABLE 5.504.4.1 FOR VERIFICATION OF ADHESIVE VOC LIMITS ON MATERIALS IDENTIFIED IN PROJECT FINISH SCHEDULE ON SHEET A1.1.

TGC TO SUBMIT TABLE 5.504.4.3 FOR VERIFICATION OF VOC LIMITS ON ARCHITECTURAL COATINGS IDENTIFIED IN PROJECT FINISH SCHEDULE ON SHEET A1.1.

TGC TO SUBMIT TABLE 5.504.4.5 FOR VERIFICATION OF FORMALDEHYDE LIMITS ON MATERIALS IDENTIFIED IN PROJECT DRAWINGS.

TGC TO SUBMIT TABLE 5.504.4.6 FOR VERIFICATION OF RESILIENT FLOORING SYSTEMS ON MATERIALS IDENTIFIED IN PROJECT FINISH SCHEDULE ON SHEET A1.1.

TGC TO SUBMIT TABLE 5.504.4.2 FOR VERIFICATION OF SEALANT VOC LIMITS ON MATERIALS IDENTIFIED IN PROJECT FINISH SCHEDULE ON SHEET A1.1

RALPH LAUREN

SPACE PLAN

RALPH LAUREN
STANFORD SHOPPING CENTER
SPACE 383A

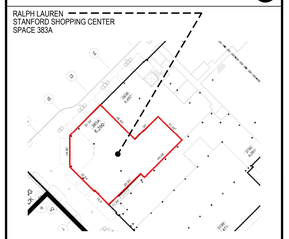

Lam+Tea Engineering

kpff

**SUBMISSION FOR ARCHITECTURAL REVIEW BOARD**

| NO. | REVISION | DATE | BY |
|---|---|---|---|
| 9 | A.R.B. CORRECTIONS 2 (7) | 07.22.2025 | TPG |
| 8 | PERMIT CORRECTIONS 2 (6) | 07.02.2025 | TPG |
| 7 | A.R.B. CORRECTIONS 1 (5) | 05.30.2025 | TPG |
| 6 | BOARD OF HEALTH CORRECTIONS (4) | 04.18.2025 | TPG |
| 5 | LATEST FULL SET UPDATES (3) | 04.14.2025 | TPG |
| 4 | PERMIT CORRECTIONS 1 (2) | 05.23.2025 | TPG |
| 3 | BID ADDENDUM 1 (1) | 03.11.2025 | TPG |
| 2 | ISSUED FOR BID & PERMIT | 01.10.2025 | TPG |
| 1 | PROGRESS SET FOR CLIENT REVIEW | 12.13.2024 | TPG |


TPG Architecture

**TPG ARCHITECTURE, LLP**
**31 PENN PLAZA**
**132 WEST 31ST STREET, 5TH FLOOR, NEW YORK, NY 10001**
**212.768.0800 | TPGARCHITECTURE.COM**



IN CONSIDERATION OF RECEIVING DRAWINGS FROM TPG ARCHITECTURE LLP IN AN ELECTRONIC FORM, THE RECIPIENT AGREES, TO THE FULLEST EXTENT PERMITTED BY LAW, TO HOLD HARMLESS AND INDEMNIFY TPG ARCHITECTURE LLP FROM AND AGAINST ALL CLAIMS, LIABILITIES, LOSSES, DAMAGES, AND COSTS, INCLUDING BUT NOT LIMITED TO ATTORNEY'S FEES, ARISING OUT OF, OR IN ANY WAY CONNECTED WITH THE USE, RE-USE, MIS-USE, MODIFICATION, OR MISINTERPRETATION OF THE MACHINE-READABLE INFORMATION PROVIDED BY TPG ARCHITECTURE LLP UNDER THIS AGREEMENT.


PROJECT
**RALPH LAUREN**
**STANFORD SHOPPING CENTER**
180 EL CAMINO REAL #383A, BLDG. M
PALO ALTO, CA 94304

DRAWING
FINISH PLAN

SEAL

LICENSED ARCHITECT
ROBERT HUGHES
26476
RENEWAL DATE 08.31.25
STATE OF CALIFORNIA

| | |
|---|---|
| DATE | 04/18/2025 |
| PROJECT NO. | 1524879-00 |
| SCALE | 1/4"=1'-0" |
| DWG NO. | A-401.00 |
| CAD FILE NO. | A-401.00_FINISH.DWG |
| PAGE | 36 of 55 |


K:\2415\2487900\8_DRAWINGS\0_CAD\2_SHEETS\A-401.00_FINISH.DWG | Plot Date: Jun. 2, 2025 - 11:52 AM
Last Saved By: MHAMANI | Save Date: 6/2/2025 11:44:43 AM

# FINISH SCHEDULE - RETAIL

## CEILING FINISH

| TAG | MATERIAL | MANUFACTURER/ SUPPLIER | PRODUCT # / COLOR | SIZE | TYPE / FINISH | RESPONSIBILITY PROVIDE | RESPONSIBILITY INSTALL | REMARKS |
|---|---|---|---|---|---|---|---|---|
| ACT1 | ACOUSTIC CEILING TILE | ARMSTRONG | SUPRAFINE XL 9/16", EXPOSED TEE W/ ULTIMA LAY-IN TEGULAR TILE #1912 | 24" x 24", 7/8" REVEAL | ULTIMA TEGULAR w/ AIRGUARD COATING | GC | GC | STANDARD B.O.H. CEILING (U.N.O.). |
| P3 | PAINT | BENJAMIN MOORE | 50% ATRIUM, 50% DECORATOR | 1 OR 2 MM | WHITE, FLAT | GC | GC | ALL GYPSUM CEILINGS |
| M5 | METAL | LOCALLY SOURCED | POWDER COATED GREEN TO MATCH P5 | - | GREEN, FINISH TBD | GC | GC | STOREFRONT ENTRY VESTIBULE |

## WALL FINISH

| TAG | MATERIAL | MANUFACTURER/ SUPPLIER | PRODUCT # / COLOR | SIZE | TYPE / FINISH | RESPONSIBILITY PROVIDE | RESPONSIBILITY INSTALL | REMARKS |
|---|---|---|---|---|---|---|---|---|
| BR1 | BRICK VENEER | TBD | TBD, WHITE | 3" THK. | - | GC | GC | FOH AND CAFE. SEE ELEVATIONS FOR LAYOUT. |
| G1 | STOREFRONT GLASS (EXTERIOR) | - | - | AS SHOWN | TEMPERED | GC | GC | 1" INSULATED. TO BE FULLY ENGINEERED PER LOCAL CODE. SEE STRUCTURAL DETAILS AND CALCULATIONS. SEE STOREFRONT DRAWINGS FOR MORE INFORMATION. |
| G2 | MIRROR GLASS | - | MIRROR | SITE-SPECIFIC | TEMPERED. LOW IRON | MW / GC | MW / GC | FITTING ROOMS & CAFE MENU BOARD. EDGES & CORNERS w/ PRECISION MICRO-BEVEL (NOT SHARP). |
| P2 | PAINT | BENJAMIN MOORE | 50% ATRIUM, 50% DECORATOR WHITE | - | MATTE (CLEANABLE) | GC | GC | FOH, BOH, CAFE, HALLS/VESTIBULES, TOILET ROOMS. WHERE OTHER WALL FINISH NOT SPECIFIED. |
| P5 | ELASOMERIC COATING PAINT | SHERWIN WILLIAMS | MATCH BM ESSEX GREEN W/ 10% BLACK | - | CONFLEX SHERLASTIC. FLAT | GC | GC | STOREFRONT FACADE. SEE STOREFRONT DRAWINGS. GC TO PROVIDE SAMPLES TO RL AND ARCHITECT FOR FINISH AND COLOR APPROVAL. |
| T2 | SUBWAY TILE | NEMO TILE | METRO30625, WHITE | 3" X 6" | GLOSSY | GC | GC | ADA RESTROOMS TO BE INSTALLED W/ TRIM S1/212J 1/2" X 12" TO MATCH AT TOP TRANSITION TO GYPSUM BOARD. |
| V1 | V-GROOVE PANELS | - | SHOP PAINTED. COLOR TBD | 5/8" THK. 8" WIDE PREFABRICATED | TBD | GC | GC | FOH AND CAFE. SEE ELEVATIONS FOR LAYOUT. |
| WC1 | RL WALL COVERING | TBD | TBD | AS SHOWN | TBD | RL | GC | FITTING ROOMS. GC TO PROVIDE LEVEL 5 FINISH OR PER MANUFACTURER'S RECOMMENDATION. WALLCOVERING TO MEET ALL LOCAL CODE REQUIREMENTS INCLUDING CLASS A FIRE RATING AND FLAME/SMOKE SPREAD INDICES. |
| EX1 | EXISTING STUCCO | - | - | EXISTING | TERRACOTTA | - | - | EXISTING TO REMAIN. EXTERIOR FACADE. SEE STOREFRONT ELEVATIONS. GC TO PATCH AND REPAIR AS REQUIRED FOR LIGHTING FIXTURE REPLACEMENT/REMOVAL SCOPE |
| EX2 | EXISTING STUCCO | - | - | EXISTING | GRAY | - | - | EXISTING TO REMAIN. EXTERIOR FACADE. SEE STOREFRONT ELEVATIONS. GC TO PATCH AND REPAIR AS REQUIRED FOR LIGHTING FIXTURE REPLACEMENT/REMOVAL SCOPE |
| EX3 | EXISTING PRECAST | - | - | EXISTING | GRAY | - | - | EXISTING TO REMAIN. EXTERIOR FACADE - NEUTRAL PIER BASE. SEE STOREFRONT ELEVATIONS. GC TO PATCH AND REPAIR AS REQUIRED. |

## CROWN MOULDING FINISH

| TAG | MATERIAL | MANUFACTURER/ SUPPLIER | PRODUCT # / COLOR | SIZE | TYPE / FINISH | RESPONSIBILITY PROVIDE | RESPONSIBILITY INSTALL | REMARKS |
|---|---|---|---|---|---|---|---|---|
| CM1 | PRIMED MDF | DYKE'S LUMBER MOULDINGS | 343 CROWN MOLDING | 6 3/8" H. X 1" D. | PRE-PRIMED AND PAINTED.SEMI-GLOSS | GC | GC | CROWN MOLDING, GC TO PAINT MOLDING P2, GC TO SUPPLY AS SCHEDULED OR EQUAL APPROVED BY RL TEAM |
| CM2 | PRIMED MDF | DYKE'S LUMBER MOULDINGS | 185 CROWN MOLDING | 4 5/8" H. X 1" D. | PRE-PRIMED AND PAINTED.SEMI-GLOSS | GC | GC | CROWN MOLDING, GC TO PAINT MOLDING P2, GC TO SUPPLY AS SCHEDULED OR EQUAL APPROVED BY RL TEAM |

## BASE FINISH

| TAG | MATERIAL | MANUFACTURER/ SUPPLIER | PRODUCT # / COLOR | SIZE | TYPE / FINISH | RESPONSIBILITY PROVIDE | RESPONSIBILITY INSTALL | REMARKS |
|---|---|---|---|---|---|---|---|---|
| P2 | PAINTED WOOD | BENJAMIN MOORE | 50% ATRIUM, 50% DECORATOR WHITE | - | PRE-PRIMED AND PAINTED.SEMI-GLOSS | GC | GC | CROWN, WALL BASE, APPLIED MOLDING, TRIM |
| T3 | TILE | DALTILE | S34197, ARCTIC WHITE | 4.25" X 6" | WHITE GLOSSY | GC | GC | ADA RESTROOMS |
| T5 | TILE | - | LIMESTONE | MATCH EXISTING | MATCH EXISTING | GC | GC | MATCH EXISTING AT INFILL OF NEW STOREFRONT SYSTEM OR REPLACEMENT OF BROKEN/MISSING TILES. STOREFRONT BASE. |
| VB1 | VINYL | TARKETT | JOHNSONITE TRADITIONAL VINYL 1/8" (TYPE TV) 22 PEARL | 4" H. | TOELESS | GC | GC | B.O.H. |
| WB1 | PAINTED MDF | DYKE'S LUMBER MOLDINGS | 355 BASE MOLDING | 5 1/4" H. X 11/16" D. | PRE-PRIMED AND PAINTED.SEMI-GLOSS | GC | GC | FITTING ROOM AND HALLWAY WALL BASE MOLDING, GC TO PAINT MOLDING P2, GC TO SUPPLY AS SCHEDULED OR EQUAL APPROVED BY RL TEAM |
| WB2 | PAINTED MDF | DYKE'S LUMBER MOLDINGS | 222 PANEL MOLDING | 7/8" H. X 3/8" D. | PRE-PRIMED AND PAINTED.SEMI-GLOSS | GC | GC | DISPLAY PLATFORMS WALL PANEL MOLDING, GC TO PAINT MOLDING P1, GC TO SUPPLY AS SCHEDULED OR EQUAL APPROVED BY RL TEAM |
| WB3 | PAINTED MDF | DYKE'S LUMBER MOLDINGS | 255 BASE MOLDING | 3 1/2" H. X 11/16" D. | PRE-PRIMED AND PAINTED.SEMI-GLOSS | GC | GC | DISPLAY PLATFORM WALL BASE MOLDING, GC TO PAINT MOLDING P1, GC TO SUPPLY AS SCHEDULED OR EQUAL APPROVED BY RL TEAM |
| WB4 | PAINTED MDF | DYKE'S LUMBER MOLDINGS | 263 BASE MOLDING | 7" H. X 3/4" D. | PRE-PRIMED AND PAINTED.SEMI-GLOSS | GC | GC | SALES AREA WALL BASE MOLDING, GC TO PAINT MOLDING P2, GC TO SUPPLY AS SCHEDULED OR EQUAL APPROVED BY RL TEAM |

## FLOOR FINISH

| TAG | MATERIAL | MANUFACTURER/ SUPPLIER | PRODUCT # / COLOR | SIZE | TYPE / FINISH | RESPONSIBILITY PROVIDE | RESPONSIBILITY INSTALL | REMARKS |
|---|---|---|---|---|---|---|---|---|
| CP1 | CARPET | RL DECO TEAM | TBD | SEE PLAN | - | RL | GC | SALES FLOOR. RECESSED. TO BE INSTALLED W/ 1/8" BRASS TRANSITION STRIP, STYLE - P-228, CARPET PADDING IS FURNISHED AND INSTALLED BY GC |
| CP2 | CARPET | RL DECO TEAM | TBD | SEE PLAN | - | RL | GC | FITTING ROOMS. TO BE INSTALLED W/ 1/8" BRASS TRANSITION STRIP, STYLE - P-228, CARPET PADDING IS FURNISHED AND INSTALLED BY GC |
| CP3 | COCO MAT | TBD | TBD | SEE PLAN | - | GC | GC | RETAIL ENTRY, CARPET PADDING IS FURNISHED AND INSTALLED BY GC |
| CP4 | AREA RUG | RL DECO TEAM | TBD | SEE PLAN | - | RL | GC | SALES FLOOR SECURE TO FLOOR WITH DOUBLE SIDED TAPE; COORDINATE WITH ANY POWER LOCATIONS. V.I.F. FINAL CARPET DIMENSIONS AFTER SITE LAYOUT IS COMPLETE. CARPET PADDING IS FURNISHED AND INSTALLED BY GC |
| CP5 | CARPET | RL DECO TEAM | TBD | SEE PLAN | - | RL | GC | WINDOW DISPLAY PLATFORM INSERTS SECURE TO FLOOR WITH DOUBLE SIDED TAPE; COORDINATE WITH ANY POWER LOCATIONS. V.I.F. FINAL CARPET DIMENSIONS TO FIT PLATFORM FRAME. CARPET PADDING IS FURNISHED AND INSTALLED BY GC |
| EX4 | LL PAVERS | - | VARIES - EXISTING | - | - | - | - | EXISTING TO REMAIN. EXTERIOR. PROTECT THROUGHOUT CONSTRUCTION. |
| T1 | TILE | TBD | BLACK SLATE | 12" X 24" | HONED | GC | GC | EXTERIOR ENTRY VESTIBULE [100] TO BE INSTALLED IN RUNNING BOND OFFSET PATTERN |
| T4 | MARBLE MOSAIC TILE | STONE SOURCE | SQUARE, WHITE MARBLE | 1" X 1" | NON SLIP | GC | GC | ADA RESTROOMS [106] & [118] |
| VCT1 | VINYL COMPOSITE TILE | ARMSTRONG | STANDARD EXCELON IMPERIAL TEXTURE #51861 SOFT WARM GRAY | 12" x 12" | NON SLIP | GC | GC | BOH |
| WD2 | WOOD | - | WHITE OAK - TONGUE & GROOVE, HONEY STAIN | 5" W, 3/4" THICK | RIFT & QUARTER SAWN | RL | GC | SALES FLOOR, B.O.H. CORRIDOR [105], FITTING ROOM CORRIDOR [112] |

## MATERIAL FINISH

| TAG | MATERIAL | MANUFACTURER/ SUPPLIER | PRODUCT # / COLOR | SIZE | TYPE / FINISH | RESPONSIBILITY PROVIDE | RESPONSIBILITY INSTALL | REMARKS |
|---|---|---|---|---|---|---|---|---|
| M1 | BRONZE METAL | LOCALLY SOURCED | BRONZE | - | TBD | MW | MW | MILLWORK |
| M2 | METAL | LOCALLY SOURCED | POWDER COATED WHITE | - | TBD | MW | MW | MILLWORK |
| M3 | METAL | LOCALLY SOURCED | POWDER COATED GREEN TO MATCH P5 | - | TBD | GC | GC | CAFE AREA / SERVICE COUNTER METAL BASE SUPPLIED & INSTALLED BY GC PROVIDE SAMPLES FOR APPROVAL AS REQUIRED. |
| M4 | METAL (GREEN) | LOCALLY SOURCED | POWDER COATED TO MATCH P4 | - | TBD | GC | GC | STOREFRONT GC TO MATCH CONTROL SAMPLE. PROVIDE SAMPLES FOR APPROVAL AS REQUIRED. |
| M5 | METAL (GREEN BLACK) | LOCALLY SOURCED | POWDER COATED GREEN TO MATCH P5 | - | TBD | GC | GC | STOREFRONT SUPPLIED & INSTALLED BY GC PROVIDE SAMPLES FOR APPROVAL AS REQUIRED. |
| M6 | METAL | LOCALLY SOURCED | BLACKENED METAL | - | MATTE | GC | GC | SALES AREA TRANSITION TO FAUX BEAM. EXTERIOR DOOR HANDLES. SUPPLIED & INSTALLED BY GC MATCH RL CONTROL SAMPLES. GC TO PROVIDE SAMPLES OF METAL FINISH FOR RL APPROVAL PRIOR TO FABRICATION |
| P1 | PAINT | BENJAMIN MOORE | 50% ATRIUM, 50% DECORATOR WHITE | - | SPRAYED SEMI-GLOSS | GC/MW | GC/MW | BY MW AT ALL FIXTURES WHERE SCHEDULED. A-501 FOR RESPONSIBILITY. AT FOH WALLS BY GC, U.O.N. |
| P4 | ELECTROSTATIC PAINT | BENJAMIN MOORE | ESSEX GREEN | - | SPRAYED SEMI-GLOSS | GC | GC | EXISTING STOREFRONT METAL. ELECTROSTATIC OR APPROVED ALTERNATE. SEE STOREFRONT DRAWINGS. |
| P5 | ELECTROSTATIC PAINT | BENJAMIN MOORE | ESSEX GREEN W/ 10% BLACK | - | SPRAYED SEMI-GLOSS | GC | GC | EXISTING STOREFRONT METAL. ELECTROSTATIC OR APPROVED ALTERNATE. SEE STOREFRONT DRAWINGS. |
| PL1 | PLASTIC LAMINATE | FORMICA | COMMERCIAL - 949 WHITE | - | - | GC | GC | B.O.H. MILLWORK |
| WD3 | WOOD | - | - | - | TBD | MW | GC | FOH AND CAFE AREA AT FAUX BEAMS. PROVIDE SAMPLES FOR APPROVAL AS REQUIRED. |

RALPH LAUREN

## SPACE PLAN

RALPH LAUREN
STANFORD SHOPPING CENTER
SPACE 383A

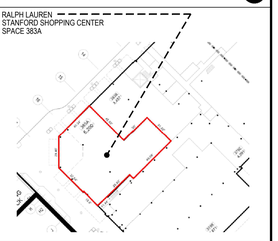

Lam+Tea Engineering

kpff

## SUBMISSION FOR ARCHITECTURAL REVIEW BOARD

| NO. | REVISION | DATE | BY |
|---|---|---|---|
| 9 | A.R.B. CORRECTIONS 2 (7) | 07.22.2025 | TPG |
| 8 | PERMIT CORRECTIONS 2 (6) | 07.02.2025 | TPG |
| 7 | A.R.B. CORRECTIONS 1 (5) | 05.30.2025 | TPG |
| 6 | BOARD OF HEALTH CORRECTIONS (4) | 04.18.2025 | TPG |
| 5 | LATEST FULL SET UPDATES (3) | 04.14.2025 | TPG |
| 4 | PERMIT CORRECTIONS 1 (2) | 05.23.2025 | TPG |
| 3 | BID ADDENDUM 1 (1) | 03.11.2025 | TPG |
| 2 | ISSUED FOR BID & PERMIT | 01.10.2025 | TPG |
| 1 | PROGRESS SET FOR CLIENT REVIEW | 12.13.2024 | TPG |


TPG Architecture

**TPG ARCHITECTURE, LLP**
**31 PENN PLAZA**
**132 WEST 31ST STREET, 5TH FLOOR, NEW YORK, NY 10001**
**212.768.0800 | TPGARCHITECTURE.COM**



IN CONSIDERATION OF RECEIVING DRAWINGS FROM TPG ARCHITECTURE LLP IN AN ELECTRONIC FORM, THE RECIPIENT AGREES, TO THE FULLEST EXTENT PERMITTED BY LAW, TO HOLD HARMLESS AND INDEMNIFY TPG ARCHITECTURE LLP FROM AND AGAINST ALL CLAIMS, LIABILITIES, LOSSES, DAMAGES, AND COSTS, INCLUDING BUT NOT LIMITED TO ATTORNEY'S FEES, ARISING OUT OF, OR IN ANY WAY CONNECTED WITH THE USE, RE-USE, MIS-USE, MODIFICATION, OR MISINTERPRETATION OF THE MACHINE-READABLE INFORMATION PROVIDED BY TPG ARCHITECTURE LLP UNDER THIS AGREEMENT.


PROJECT
**RALPH LAUREN**
**STANFORD SHOPPING CENTER**
180 EL CAMINO REAL #383A, BLDG. M
PALO ALTO, CA 94304

DRAWING
FINISH SCHEDULE
RETAIL

SEAL

LICENSED ARCHITECT — ROBERT HUGHES — 26476 — STATE OF CALIFORNIA — RENEWAL DATE 8/31/25

| | |
|---|---|
| DATE | 04/18/2025 |
| PROJECT NO. | 1524879-00 |
| SCALE | 1/4"=1'-0" |
| DWG NO. | A-402.00 |
| CAD FILE NO. | A-401.00_FINISH.DWG |
| PAGE | 37 of 55 |


K:\2415\24879.0000_DRAWINGS_CAD_SHEETS\A-401.00_FINISH.DWG / Plot Date: Jun. 2, 2025 - 11:52 AM
Last Saved By: MHAMANN / Save Date: 6/2/2025 11:44:43 AM

# FINISH SCHEDULE - CAFE

## CEILING FINISH

| TAG | MATERIAL | MANUFACTURER/ SUPPLIER | PRODUCT # / COLOR | SIZE | TYPE / FINISH | RESPONSIBILITY PROVIDE | RESPONSIBILITY INSTALL | REMARKS |
|---|---|---|---|---|---|---|---|---|
| ACT2 | ACOUSTIC CEILING TILE | ARMSTRONG | 24" X 24" KITCHEN ZONE - #673 | 24" x 24", ½" REVEAL | ULTIMA TEGULAR w/ AIRGUARD COATING | GC | GC | RALPH'S COFFEE B.O.H. |
| P3 | PAINT | BENJAMIN MOORE | 50% ATRIUM, 50% DECORATOR | 1 OR 2 MM | WHITE, FLAT | GC | GC | ALL GYPSUM CEILINGS |
| 3 M5 | METAL | LOCALLY SOURCED | POWDER COATED GREEN TO MATCH P5 | - | GREEN, FINISH TBD | GC | GC | STOREFRONT ENTRY VESTIBULE |

## WALL FINISH

| TAG | MATERIAL | MANUFACTURER/ SUPPLIER | PRODUCT # / COLOR | SIZE | TYPE / FINISH | RESPONSIBILITY PROVIDE | RESPONSIBILITY INSTALL | REMARKS |
|---|---|---|---|---|---|---|---|---|
| BR1 - | BRICK VENEER | TBD | TBD, WHITE | ¾" THK. | - | GC | GC | FOH AND CAFE (NOT IN FOOD PREP AREAS). SEE ELEVATIONS FOR LAYOUT. |
| FRP1 - | WHITE FRP | PANOLAM SURFACE SYSTEMS | WHITE | FRP CLASS A (0.075) | SMOOTH | GC | GC | 4 CAFE BOH - TYPICAL. SEE ELEVATIONS. SMOOTH, NO TEXTURE |
| FRP2 - | BLACK FRP | PANOLAM SURFACE SYSTEMS | BLACK | FRP CLASS A (0.075) | SMOOTH | GC | GC | CAFE - BEHIND EQUIPMENT UNDER COUNTERTOP. SEE ELEVATIONS. SMOOTH, NO TEXTURE |
| G1 - | STOREFRONT GLASS (EXTERIOR) | - | - | AS SHOWN | TEMPERED | GC | GC | 1" INSULATED. TO BE FULLY ENGINEERED PER LOCAL CODE. SEE STRUCTURAL DETAILS AND CALCULATIONS. SEE STOREFRONT DRAWINGS FOR MORE INFORMATION. |
| G2 - | MIRROR GLASS | - | MIRROR | SITE-SPECIFIC | 3 TEMPERED. LOW IRON. | MW / GC | MW / GC | FITTING ROOMS & CAFE MENU BOARD. EDGES & CORNERS w/ PRECISION MICRO-BEVEL (NOT SHARP). |
| G3 - | STOREFRONT GLASS (DOORS) | - | - | MATCH EXISTING | TEMPERED AND LAMINATED | GC | GC | GLASS AT NEW CAFE DOORS. TINT, SECURITY, AND ENERGY PERFORMANCE TO MATCH EXISTING ADJACENT. SEE STOREFRONT DRAWINGS FOR MORE INFORMATION. |
| P2 - | PAINT | BENJAMIN MOORE | 50% ATRIUM, 50% DECORATOR WHITE | - | MATTE (CLEANABLE) | GC | GC | 4 FOH, BOH, CAFE, HALLS/VESTIBULES, TOILET ROOMS. WHERE OTHER WALL FINISH NOT SPECIFIED. PER BOARD OF HEALTH REQUIREMENTS PAINTED SURFACES ADJACENT TO FOOD STORAGE, FOOD PREPARATION, UTENSIL WASHING, REFUSE STORAGE, JANITORIAL AREA, AND TOILET ROOMS SHALL BE SMOOTH WITHOUT TEXTURE. PAINTED SURFACES SHALL BE GLOSS OR SEMI-GLOSS ENAMEL PAINT, OR EPOXY PAINT. |
| 3 P5 - | ELASOMERIC COATING PAINT | SHERWIN WILLIAMS | MATCH BM ESSEX GREEN W/ 10% BLACK | - | CONFLEX SHERLASTIC. FLAT | GC | GC | STOREFRONT FACADE. SEE STOREFRONT DRAWINGS. GC TO PROVIDE SAMPLES TO RL AND ARCHITECT FOR FINISH AND COLOR APPROVAL. |
| T2 - | SUBWAY TILE | NEMO TILE | METRO30625, WHITE | 3" X 6" | GLOSSY | GC | 4 GC | ADA RESTROOMS TO BE INSTALLED W/ TRIM S1/212J 1/2" X 12" TO MATCH AT TOP TRANSITION TO GYPSUM BOARD. SMOOTH, NO TEXTURE |
| V1 - | V-GROOVE PANELS | - | PAINTED. COLOR TBD | 5/8" THK. 8" WIDE PREFABRICATED | TBD | 1 GC | GC | FOH AND CAFE. SEE ELEVATIONS FOR LAYOUT. PER BOARD OF HEALTH REQUIREMENTS PAINTED SURFACES ADJACENT TO FOOD STORAGE, FOOD PREPARATION, UTENSIL WASHING, REFUSE STORAGE, JANITORIAL AREA, AND TOILET ROOMS SHALL BE SMOOTH WITHOUT TEXTURE. PAINTED SURFACES SHALL BE GLOSS OR SEMI-GLOSS ENAMEL PAINT, OR EPOXY PAINT. |
| EX1 - | EXISTING STUCCO | - | - | EXISTING | TERRACOTTA | - | - | EXISTING TO REMAIN. EXTERIOR FACADE. SEE STOREFRONT ELEVATIONS. GC TO PATCH AND REPAIR AS REQUIRED FOR LIGHTING FIXTURE REPLACEMENT/REMOVAL SCOPE |
| EX2 - | EXISTING STUCCO | - | - | EXISTING | GRAY | - | - | EXISTING TO REMAIN. EXTERIOR FACADE. SEE STOREFRONT ELEVATIONS. GC TO PATCH AND REPAIR AS REQUIRED FOR LIGHTING FIXTURE REPLACEMENT/REMOVAL SCOPE |
| EX3 - | EXISTING PRECAST | - | - | EXISTING | GRAY | - | - | EXISTING TO REMAIN. EXTERIOR FACADE - NEUTRAL PIER BASE. SEE STOREFRONT ELEVATIONS. GC TO PATCH AND REPAIR AS REQUIRED. |

## CROWN MOULDING FINISH

| TAG | MATERIAL | MANUFACTURER/ SUPPLIER | PRODUCT # / COLOR | SIZE | TYPE / FINISH | RESPONSIBILITY PROVIDE | RESPONSIBILITY INSTALL | REMARKS |
|---|---|---|---|---|---|---|---|---|
| 3 CM1 - | PRIMED MDF | DYKE'S LUMBER MOULDINGS | 343 CROWN MOLDING | 6 3/8" H. X 1" D. | PRE-PRIMED AND PAINTED.SEMI-GLOSS | GC | GC | CROWN MOLDING, GC TO PAINT MOLDING P2, GC TO SUPPLY AS SCHEDULED OR EQUAL APPROVED BY RL TEAM |

## BASE FINISH

| TAG | MATERIAL | MANUFACTURER/ SUPPLIER | PRODUCT # / COLOR | SIZE | TYPE / FINISH | RESPONSIBILITY PROVIDE | RESPONSIBILITY INSTALL | REMARKS |
|---|---|---|---|---|---|---|---|---|
| - P2 | PAINTED WOOD | BENJAMIN MOORE | 50% ATRIUM, 50% DECORATOR WHITE | - | PRE-PRIMED AND PAINTED. SEMI-GLOSS | GC | GC | 4 CROWN, WALL BASE, APPLIED MOLDING, TRIM |
| - T5 | TILE | DALTILE | S3419T, ARCTIC WHITE | 4.25" X 6" | WHITE GLOSSY | GC | GC | 4 ADA RESTROOMS, CAFE KITCHEN, AND BETWEEN SERVICE COUNTERS. MEETS REQUIREMENTS FOR MINIMUM OF 4" HIGH ¾" RADIUS COVE BASE |
| - T5 | TILE | - | LIMESTONE | MATCH EXISTING | MATCH EXISTING | GC | GC | MATCH EXISTING AT INFILL OF NEW STOREFRONT SYSTEM OR REPLACEMENT OF BROKEN/MISSING TILES. STOREFRONT BASE. |
| - VB1 | VINYL | TARKETT | JOHNSONITE TRADITIONAL VINYL 1/8" (TYPE TV) 22 PEARL | 4" H. | 4 WITH TOE | GC | GC | RALPH'S CAFE SERVICE COUNTER MEETS REQUIREMENTS FOR MINIMUM OF 4" HIGH ¾" RADIUS COVE BASE |
| 3 - WB1 | PRIMED MDF | DYKE'S LUMBER MOLDINGS | 355 BASE MOLDING | 5 1/4" H. X 11/16" D. | PRE-PRIMED AND PAINTED.SEMI-GLOSS | GC | GC | CAFE VESTIBULE, WALL BASE MOLDING, GC TO PAINT MOLDING P2, GC TO SUPPLY AS SCHEDULED OR EQUAL APPROVED BY RL TEAM |
| 4 - WB4 | PAINTED MDF | DYKE'S LUMBER MOLDINGS | 263 BASE MOLDING | 7" H. X 3/4" D. | PRE-PRIMED AND PAINTED.SEMI-GLOSS | GC | GC | CAFE BELOW BASE MOLDING, GC TO PAINT MOLDING P2, GC TO SUPPLY AS SCHEDULED OR EQUAL APPROVED BY RL TEAM |

## FLOOR FINISH

| TAG | MATERIAL | MANUFACTURER/ SUPPLIER | PRODUCT # / COLOR | SIZE | TYPE / FINISH | RESPONSIBILITY PROVIDE | RESPONSIBILITY INSTALL | REMARKS |
|---|---|---|---|---|---|---|---|---|
| EX4 | LL PAVERS | - | VARIES - EXISTING | - | - | - | - | EXISTING TO REMAIN. EXTERIOR. PROTECT THROUGHOUT CONSTRUCTION. |
| T1 | TILE | TBD | BLACK SLATE | 12" X 24" | HONED | GC | GC | EXTERIOR ENTRY VESTIBULE [100] TO BE INSTALLED IN RUNNING ½ OFFSET PATTERN |
| T4 | MARBLE MOSAIC TILE | STONE SOURCE | SQUARE, WHITE MARBLE | 1" X 1" | NON SLIP | GC | GC | ADA RESTROOMS [106] & [118] |
| T6 | ENCAUSTIC CEMENT TILE | VILLA LAGOON | CUBES A (PONDEROSA, RAINFOREST, WHITE) | 8" X 8" | TBD LAYOUT/DIRECTION BY RL | RL | GC | CAFE AREA [120]. VESTIBULE [119] |
| VCT2 | VINYL COMPOSITE TILE | ARMSTRONG | STANDARD EXCELON IMPERIAL TEXTURE COLOR TBD | 12" x 12" | NON SLIP | GC | GC | CAFE BOH [122] |

## MATERIAL FINISH

| TAG | MATERIAL | MANUFACTURER/ SUPPLIER | PRODUCT # / COLOR | SIZE | TYPE / FINISH | RESPONSIBILITY PROVIDE | RESPONSIBILITY INSTALL | REMARKS |
|---|---|---|---|---|---|---|---|---|
| G4 | GLASS | LOCALLY SOURCED | EXTRA LOW IRON | - | TBD | MW | MW | SNEEZE GUARD AT MILLWORK. TEMPERED AND LAMINATED. 4 |
| G5 | BACK-PAINTED GLASS | LOCALLY SOURCED | WHITE. TO MATCH RL CONTROL SAMPLE | - | TBD | MW | MW | AT CAFE MILLWORK |
| M3 | METAL | LOCALLY SOURCED | POWDER COATED GREEN TO MATCH P5 | - | TBD | GC | GC | CAFE AREA / SERVICE COUNTER METAL BASE SUPPLIED & INSTALLED BY GC PROVIDE SAMPLES FOR APPROVAL AS REQUIRED. |
| M4 | METAL (GREEN) | LOCALLY SOURCED | POWDER COATED TO MATCH P4 | - | TBD | GC | GC | STOREFRONT GC TO MATCH CONTROL SAMPLE. PROVIDE SAMPLES FOR APPROVAL AS REQUIRED. |
| M5 | METAL (GREEN BLACK) | LOCALLY SOURCED | POWDER COATED GREEN TO MATCH P5 | - | TBD | GC | GC | STOREFRONT SUPPLIED & INSTALLED BY GC PROVIDE SAMPLES FOR APPROVAL AS REQUIRED. |
| 3 M6 | METAL | LOCALLY SOURCED | BLACKENED METAL | - | MATTE | GC | GC | SALES AREA TRANSITION TO FAUX BEAM. EXTERIOR DOOR HANDLES. SUPPLIED & INSTALLED BY GC MATCH RL CONTROL SAMPLES. GC TO PROVIDE SAMPLES OF METAL FINISH FOR RL APPROVAL PRIOR TO FABRICATION |
| P4 | ELECTROSTATIC PAINT | BENJAMIN MOORE | ESSEX GREEN | - | SPRAYED SEMI-GLOSS | GC | GC | EXISTING STOREFRONT METAL. ELECTROSTATIC OR APPROVED ALTERNATE. SEE STOREFRONT DRAWINGS. |
| P5 | ELECTROSTATIC PAINT | BENJAMIN MOORE | ESSEX GREEN W/ 10% BLACK | - | SPRAYED SEMI-GLOSS | GC | GC | EXISTING STOREFRONT METAL. ELECTROSTATIC OR APPROVED ALTERNATE. SEE STOREFRONT DRAWINGS. |
| ST1 | CORIAN QUARTZ | CORIAN DESIGN | ETHEREAL WHITE, SLAB | - | - | MW | MW | CAFE - SERVICE COUNTER / BACKSPLASH COUNTERTOPS & TABLES PROVIDE SAMPLES FOR APPROVAL AS REQUIRED. |
| WD1 | WOOD | - | TBD | - | RIFT | MW | MW | CAFE - CUSTOM BENCH PROVIDE SAMPLES FOR APPROVAL AS REQUIRED. |
| WD3 | WOOD | - | - | - | TBD | 3 MW | GC | FOH AND CAFE AREA AT FAUX BEAMS. PROVIDE SAMPLES FOR APPROVAL AS REQUIRED. |
| WD4 | WOOD | - | - | - | - | MW | MW | CAFE - CUSTOM MIRROR FRAME PROVIDE SAMPLES FOR APPROVAL AS REQUIRED. |

RALPH LAUREN

## SPACE PLAN

RALPH LAUREN
STANFORD SHOPPING CENTER
SPACE 383A

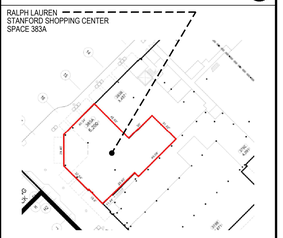

Lam+Tea Engineering

kpff

## SUBMISSION FOR ARCHITECTURAL REVIEW BOARD

| NO. | REVISION | DATE | BY |
|---|---|---|---|
| 9 | A.R.B. CORRECTIONS 2 (7) | 07.22.2025 | TPG |
| 8 | PERMIT CORRECTIONS 2 (6) | 07.02.2025 | TPG |
| 7 | A.R.B. CORRECTIONS 1 (5) | 05.30.2025 | TPG |
| 6 | BOARD OF HEALTH CORRECTIONS (4) | 04.18.2025 | TPG |
| 5 | LATEST FULL SET UPDATES (3) | 04.14.2025 | TPG |
| 4 | PERMIT CORRECTIONS 1 (2) | 05.23.2025 | TPG |
| 3 | BID ADDENDUM 1 (1) | 03.11.2025 | TPG |
| 2 | ISSUED FOR BID & PERMIT | 01.10.2025 | TPG |
| 1 | PROGRESS SET FOR CLIENT REVIEW | 12.13.2024 | TPG |


TPG Architecture

**TPG ARCHITECTURE, LLP**
**31 PENN PLAZA**
**132 WEST 31ST STREET, 5TH FLOOR, NEW YORK, NY 10001**
**212.768.0800 | TPGARCHITECTURE.COM**



IN CONSIDERATION OF RECEIVING DRAWINGS FROM TPG ARCHITECTURE LLP IN AN ELECTRONIC FORM, THE RECIPIENT AGREES, TO THE FULLEST EXTENT PERMITTED BY LAW, TO HOLD HARMLESS AND INDEMNIFY TPG ARCHITECTURE LLP FROM AND AGAINST ALL CLAIMS, LIABILITIES, LOSSES, DAMAGES, AND COSTS, INCLUDING BUT NOT LIMITED TO ATTORNEY'S FEES, ARISING OUT OF, OR IN ANY WAY CONNECTED WITH THE USE, RE-USE, MIS-USE, MODIFICATION, OR MISINTERPRETATION OF THE MACHINE-READABLE INFORMATION PROVIDED BY TPG ARCHITECTURE LLP UNDER THIS AGREEMENT.


PROJECT
**RALPH LAUREN**
**STANFORD SHOPPING CENTER**
180 EL CAMINO REAL #383A, BLDG. M
PALO ALTO, CA 94304

DRAWING
FINISH SCHEDULE
CAFE

SEAL

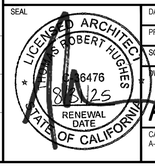


| | |
|---|---|
| DATE | 04/18/2025 |
| PROJECT NO. | 1524879-00 |
| SCALE | 1/4"=1'-0" |
| DWG NO. | A-403.00 |
| CAD FILE NO. | A-401.00_FINISH.DWG |
| PAGE | 38 of 55 |


K:\01\1524879.0000_DRAWINGS\3_CAD\2_SHEETS\A-401.00_FINISH.DWG | Plot Date: Jun. 2, 2025 - 11:52 AM
Last Saved By: MHAMANN | Save Date: 6/2/2025 11:44:43 AM

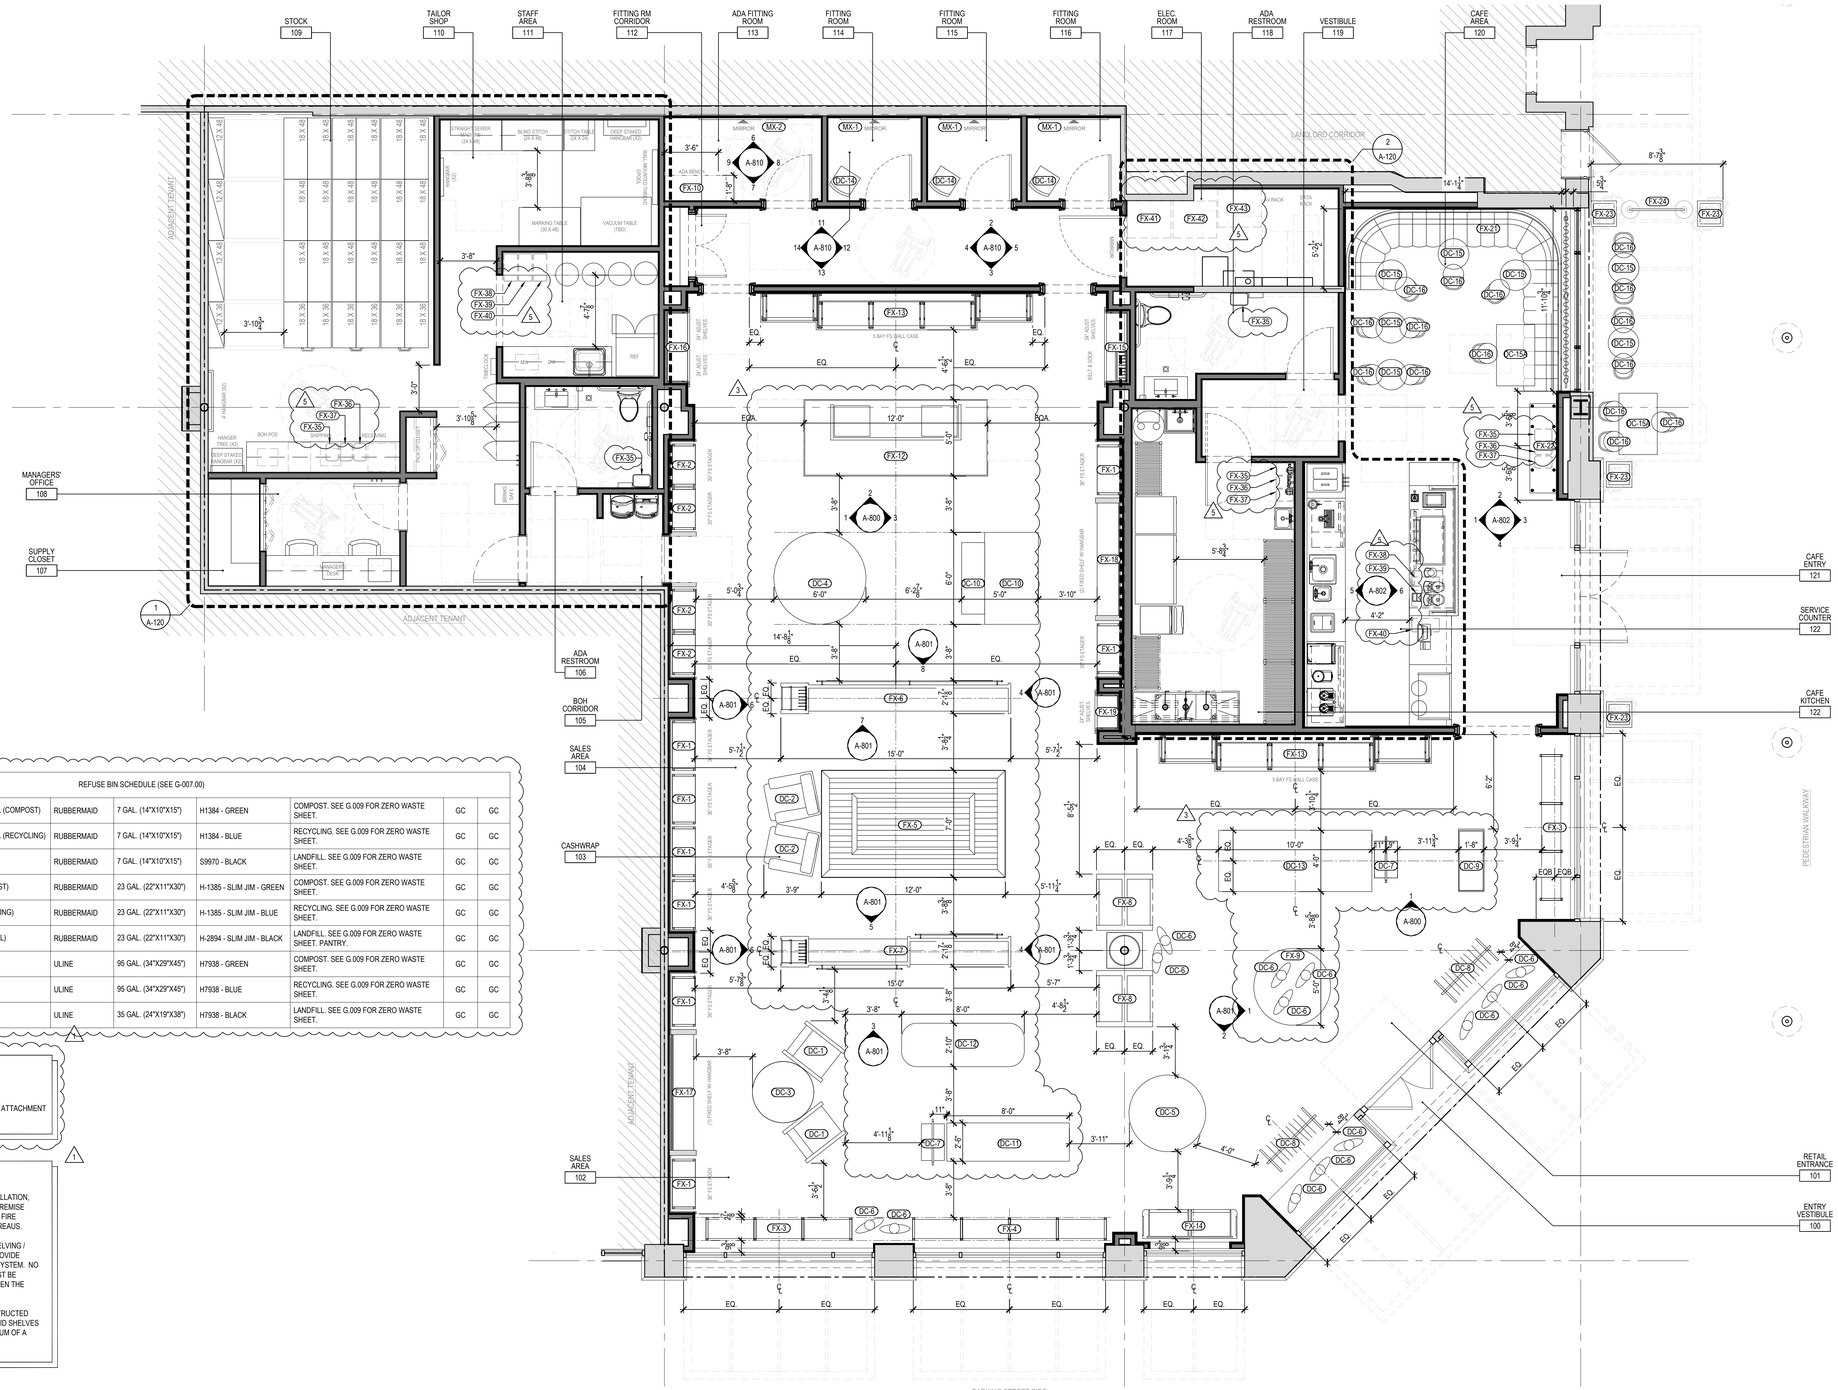


| REFUSE BIN SCHEDULE (SEE G-007.00) | | | | | | | |
|---|---|---|---|---|---|---|---|
| FX-35 | OFFICE RECYCLING CONTAINER - SMALL (COMPOST) | RUBBERMAID | 7 GAL. (14"X10"X15") | H1384 - GREEN | COMPOST. SEE G.009 FOR ZERO WASTE SHEET. | GC | GC |
| FX-36 | OFFICE RECYCLING CONTAINER - SMALL (RECYCLING) | RUBBERMAID | 7 GAL. (14"X10"X15") | H1384 - BLUE | RECYCLING. SEE G.009 FOR ZERO WASTE SHEET. | GC | GC |
| FX-37 | OFFICE TRASH CAN - SMALL (LANDFILL) | RUBBERMAID | 7 GAL. (14"X10"X15") | S9970 - BLACK | LANDFILL. SEE G.009 FOR ZERO WASTE SHEET. | GC | GC |
| FX-38 | RECYCLING CONTAINER - TALL (COMPOST) | RUBBERMAID | 23 GAL. (22"X11"X30") | H-1385 - SLIM JIM - GREEN | COMPOST. SEE G.009 FOR ZERO WASTE SHEET. | GC | GC |
| FX-39 | RECYCLING CONTAINER - TALL (RECYCLING) | RUBBERMAID | 23 GAL. (22"X11"X30") | H-1385 - SLIM JIM - BLUE | RECYCLING. SEE G.009 FOR ZERO WASTE SHEET. | GC | GC |
| FX-40 | RECYCLING CONTAINER - TALL (LANDFILL) | RUBBERMAID | 23 GAL. (22"X11"X30") | H-2894 - SLIM JIM - BLACK | LANDFILL. SEE G.009 FOR ZERO WASTE SHEET. PANTRY. | GC | GC |
| FX-41 | TRANSPORT BIN - COMPOST | ULINE | 95 GAL. (34"X29"X45") | H7938 - GREEN | COMPOST. SEE G.009 FOR ZERO WASTE SHEET. | GC | GC |
| FX-42 | TRANSPORT BIN - RECYCLING | ULINE | 95 GAL. (34"X29"X45") | H7938 - BLUE | RECYCLING. SEE G.009 FOR ZERO WASTE SHEET. | GC | GC |
| FX-43 | TRANSPORT BIN - LANDFILL | ULINE | 35 GAL. (24"X19"X38") | H7938 - BLACK | LANDFILL. SEE G.009 FOR ZERO WASTE SHEET. | GC | GC |

NOTE:

BOH STOCK SHELVING SUBMITTAL DEFERRED.

SEE S-500 STRUCTURAL DRAWINGS FOR FOH MILLWORK ANCHOR ATTACHMENT DETAILS.

LANDLORD FIXTURE PLAN NOTE:

TENANT SHALL BE SOLELY RESPONSIBLE FOR THE DESIGN, INSTALLATION, AND USE OF ANY DISPLAY OR STORAGE SYSTEM(S) WITHIN THE PREMISE INCLUDING ALL COMPLIANCE WITH APPLICABLE BUILDING CODES, FIRE CODES AND THE REQUIREMENTS OF ANY INSURANCE RATING BUREAUS.

TENANT DISPLAY FIXTURES IN THE RETAIL SPACE AND RACK / SHELVING / STORAGE UNITS IN THE STOCKROOM SHALL BE DESIGNED TO PROVIDE ADEQUATE CLEARANCE FOR THE AUTOMATIC (FIRE) SPRINKLER SYSTEM. NO DISPLAYS OR STORAGE SHOULD EXCEED 12FT AND CEILINGS MUST BE INSTALLED TO PROVIDE A MINIMUM OF 18" OF CLEARANCE BETWEEN THE TOP OF THE STORAGE SYSTEM AND SPRINKLER DEFLECTORS.

TENANT MOBILE / COMPACT STORAGE SYSTEMS SHALL BE CONSTRUCTED OF WIRE MESH SHELVES. HOWEVER, IF CONSTRUCTED WITH SOLID SHELVES (WOOD OR STEEL), THE UNITS SHALL BE INSTALLED WITH A MINIMUM OF A 3" SPACER TO PROVIDE SPACE BETWEEN UNITS AT MAXIMUM 5'-0" INTERVALS.

## 1 FIXTURE PLAN

SCALE: 1/4"=1'-0"

## GENERAL NOTES

1. THESE PLANS MEET ALL ADA REQUIREMENTS.
2. SEE CONSTRUCTION PLAN FOR PERIMETER FIXTURE LOCATIONS.
3. ALL DIMENSIONS TO CENTERLINE OF FIXTURE, U.N.O.
4. FLOOR FIXTURES TO BE INSTALLED SUCH THAT MIN. EGRESS PATH WIDTH IS NOT COMPROMISED. SEE EGRESS & LIFE SAFETY PLAN.
5. MILLWORK ANCHORING METHODS & SEAMING TO BE COORDINATED WITH MILLWORKER. PREP WALLS AS REQUIRED TO RECEIVE MILLWORK.
6. MILLWORK TO BE SHIMMED OR LEVELED TO MAINTAIN ALIGNMENT WITH FLOOR FINISH.
7. MILLWORK POWER / DATA CONNECTIONS TO BE COORDINATED WITH ELECTRICAL CONTRACTOR PRIOR TO INSTALLATION.
8. ALL DIMENSIONS TO / FROM FACE OF FINISHES.
9. ALL FURNITURE IS PROVIDED BY OWNER'S VENDOR & INSTALLED BY GC. OWNER TO COORDINATE EXACT LOCATION. PRICES TO INCLUDE SHIPPING & FREIGHT CHARGES / FEES, LICENSE & PERMITS. INSTALLATION TO BE PERFORMED BY QUALIFIED LABOR DURING NORMAL BUSINESS HOURS. PRIOR-AUTHORIZATION FOR OVERTIME DELIVERIES, IF REQUIRED BY BUILDING MANAGEMENT, TO BE OBTAINED FROM & COORDINATED w/ OWNER.
10. COORDINATE ALL BLOCKING w/ MILLWORK VENDOR PRIOR TO CLOSING UP NEW WALL CONSTRUCTION.
11. VERIFY FREIGHT CAPACITIES, DIMENSIONS OF OPENINGS & DELIVERY PATH TO ENSURE SUFFICIENT SPACE IS PRESENT / PROVIDED FOR PASSAGE OF FIXTURES INTO SPACE.
12. PROTECTION TO BE PROVIDED BY VENDOR FOR ALL SURFACES SUSCEPTIBLE TO DAMAGE DURING FIXTURE DELIVERY. VENDOR RESPONSIBLE TO CORRECT ANY DAMAGES CAUSED BY DELIVERY & COORDINATION w/ BUILDING MANAGEMENT.
13. COORDINATE PATH OF TRAVEL, ANY BUILDING FEES & DELIVERY SCHEDULES w/ BUILDING MANAGEMENT & OWNER.
14. COORDINATE MILLWORK w/ EXISTING & NEW CONSTRUCTION, MECHANICAL, FURNITURE & OTHER RELATED ELEMENTS.
15. MATERIALS TO BE AS SPECIFIED & OF HIGHEST-QUALITY BY ACCEPTED COMMERCIAL STANDARDS.
16. OWNER TO CONFIRM CONCEPTS.

## FIXTURE SCHEDULE 1 3

| TAG | DESCRIPTION | F | I |
|---|---|---|---|
| FX-1 | FREE STANDING - ETAGERE 3'-0" | MW | MW |
| FX-2 | FREE STANDING - ETAGERE 2'-6" | MW | MW |
| FX-3 | CEILING MTD. - 3 BAY STRAP FIXTURE 3'-0" PER BAY | MW | MW |
| FX-4 | CEILING MTD. - 4 BAY STRAP FIXTURE 3'-0" PER BAY | MW | MW |
| FX-5 | FREE STANDING - TIERED TABLE 12'-0" X 7'-0" | RL | GC |
| FX-6 | FREE STANDING - FIXED SINGLE SHELF SINGLE BAY FIXTURE WITH LOOK BAR | MW | MW |
| FX-7 | FREE STANDING - FIXED SINGLE SHELF DOUBLE BAY WITH LOOK BARS | MW | MW |
| FX-8 | FREE STANDING - DOUBLE SIDED FIXTURE 3'-0" | RL | GC |
| FX-9 | FREE STANDING - ROUND TABLE 5'-0" DIA. | RL | GC |
| FX-10 | FREE STANDING - ADA BENCH 3'-6" X 1'-8" | RL | GC |
| FX-11 | FREE STANDING - HANGER 3'-0" | MW | MW |
| FX-12 | FREE STANDING - POS STATION - TIERED TABLE 5'-0" X 12'-0" | MW | MW |
| FX-12 | FREE STANDING - POS STATION - TIERED TABLE 5'-0" X 12'-0" | MW | MW |
| FX-13 | FREE STANDING - 5 BAY WALL CASE 3'-0" PER BAY | MW | MW |
| FX-14 | FREE STANDING - WOOD CASE 5'-8" X 1'-8" | MW | MW |
| FX-15 | IN-SET WALL - ONE BAY ADJUSTABLE SHELF AND HOOKS, SEE PLAN FOR WIDTH | MW | MW |
| FX-16 | IN-SET WALL - 2 BAY ADJUSTABLE SHELF, SEE PLAN FOR WIDTH | MW | MW |
| FX-17 | IN-SET WALL - CENTER BAY FIXED SINGLE SHELF WITH HANG-BAR | MW | MW |
| FX-18 | IN-SET WALL - CENTER BAY FIXED DOUBLE SHELF WITH HANG-BAR | MW | MW |
| FX-19 | IN-SET WALL - ADJUSTABLE SHELVES - ACCESSORIES 2'-0" | MW | MW |
| FX-21 | FLOOR MTD. - CAFE SEATING BANQUETTE | MW | MW |
| FX-22 | FREE STANDING - ETAGERE 5'-6" X 1'-6" | MW | MW |
| FX-23 | PLANTER - 20" X 20" | MW | MW |
| FX-24 | STANCHION BARRIER - 44"L W/ SUNBRELLA (OE EQUIVALENT) FABRIC. WHITE. LOGO TO MATCH ESSEX GREEN W/ 10% BLACK. (NON-ANCHORED. NO ATTACHMENT TO LL PAVERS) | MW | MW |

| TAG | DESCRIPTION | F | I |
|---|---|---|---|
| MX-1 | WALL MOUNTED MIRROR - TYPICAL, SEE ELEVATIONS | MW | MW |
| MX-2 | 3 WAY WALL MOUNTED MIRROR - LARGE, SEE ELEVATIONS | MW | MW |
| DC-1 | DECO CHAIR 1 | RL | GC |
| DC-2 | DECO CHAIR 2 | RL | GC |
| DC-3 | ROUND TABLE 4'-0" | RL | GC |
| DC-4 | ROUND TABLE 5'-0" | RL | GC |
| DC-5 | ROUND TABLE 5'-0" | RL | GC |
| DC-6 | MANNEQUIN | RL | RL |
| DC-7 | FREE STANDING - HANGER 3'-0" | RL | GC |
| DC-8 | FREE STANDING - HANG-BAR BY DECO | RL | GC |
| DC-9 | FREE STANDING - FLOOR VITRINE BY DECO | RL | GC |
| DC-10 | FREE STANDING - TABLE 3'-6" X 6'-0" | RL | GC |

| TAG | DESCRIPTION | F | I |
|---|---|---|---|
| DC-10 | FREE STANDING - NESTER BENCH | RL | GC |
| DC-11 | FREE STANDING - TABLE 8'-0" X 2'-6" | RL | GC |
| DC-12 | FREE STANDING - TRACK TIERED TABLE 8'-0" X 2'-10" | RL | GC |
| DC-13 | FREE STANDING - TABLE 10'-0" X 4'-0" | RL | GC |
| DC-14 | FITTING ROOM CHAIR | RL | GC |
| DC-15 | CAFE ROUND TABLE 2'-6" DIA. | RL | GC |
| DC-15A | CAFE - RECTANGULAR ADA TABLE 48"X30" | RL | GC |
| DC-16 | CAFE CHAIR | RL | GC |

RALPH LAUREN

SPACE PLAN

RALPH LAUREN
STANFORD SHOPPING CENTER
SPACE 383A

Lam+Tea Engineering

kpff

## SUBMISSION FOR ARCHITECTURAL REVIEW BOARD

| NO. | REVISION | | DATE | BY |
|---|---|---|---|---|
| 9 | A.R.B. CORRECTIONS 2 | 7 | 07.22.2025 | TPG |
| 8 | PERMIT CORRECTIONS 2 | 6 | 07.02.2025 | TPG |
| 7 | A.R.B. CORRECTIONS 1 | 5 | 05.30.2025 | TPG |
| 6 | BOARD OF HEALTH CORRECTIONS | 4 | 04.18.2025 | TPG |
| 5 | LATEST FULL SET UPDATES | 3 | 04.14.2025 | TPG |
| 4 | PERMIT CORRECTIONS 1 | 2 | 05.23.2025 | TPG |
| 3 | BID ADDENDUM 1 | 1 | 03.11.2025 | TPG |
| 2 | ISSUED FOR BID & PERMIT | | 01.10.2025 | TPG |
| 1 | PROGRESS SET FOR CLIENT REVIEW | | 12.13.2024 | TPG |

TPG Architecture

TPG ARCHITECTURE, LLP
31 PENN PLAZA
132 WEST 31ST STREET, 5TH FLOOR, NEW YORK, NY 10001
212.768.0800 | TPGARCHITECTURE.COM

IN CONSIDERATION OF RECEIVING DRAWINGS FROM TPG ARCHITECTURE LLP IN AN ELECTRONIC FORM, THE RECIPIENT AGREES, TO THE FULLEST EXTENT PERMITTED BY LAW, TO HOLD HARMLESS AND INDEMNIFY TPG ARCHITECTURE LLP FROM AND AGAINST ALL CLAIMS, LIABILITIES, LOSSES, DAMAGES, AND COSTS, INCLUDING BUT NOT LIMITED TO ATTORNEY'S FEES, ARISING OUT OF, OR IN ANY WAY CONNECTED WITH THE USE, RE-USE, MIS-USE, MODIFICATION, OR MISINTERPRETATION OF THE MACHINE-READABLE INFORMATION PROVIDED BY TPG ARCHITECTURE LLP UNDER THIS AGREEMENT.

PROJECT
**RALPH LAUREN**
**STANFORD SHOPPING CENTER**
180 EL CAMINO REAL #383A, BLDG. M
PALO ALTO, CA 94304

DRAWING
FIXTURE PLAN

SEAL

LICENSED ARCHITECT * ROBERT HUGHES * 16476 * 12/25 * RENEWAL DATE * STATE OF CALIFORNIA

| | |
|---|---|
| DATE | 04/18/2025 |
| PROJECT NO. | 1524879-00 |
| SCALE | 1/4"=1'-0" |
| DWG NO. | A-501.00 |
| CAD FILE NO. | A-501.00_FIXTURE - ARB.DWG |
| PAGE | 39 of 55 |

K:\2415\24879.0006_DRAWINGS\1_CAD\2_SHEETS\A-501.00_FIXTURE - ARB.DWG | Plot Date: Jun. 2, 2025 - 12:30 PM
Last Saved By: MHAMANI | Save Date: 6/2/2025 11:45:59 AM

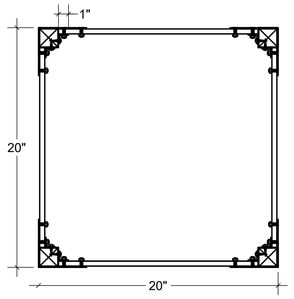


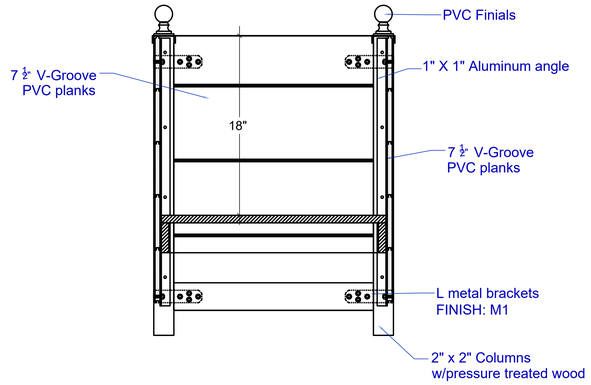


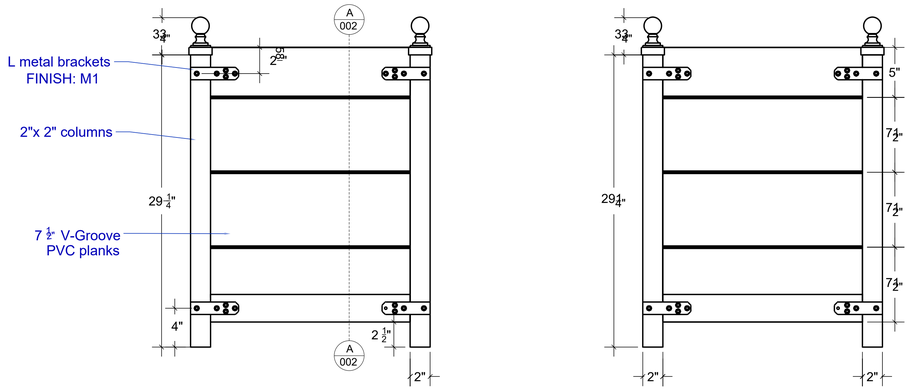


**FX-23 - EXTERIOR PLANTER**
SCALE: NTS

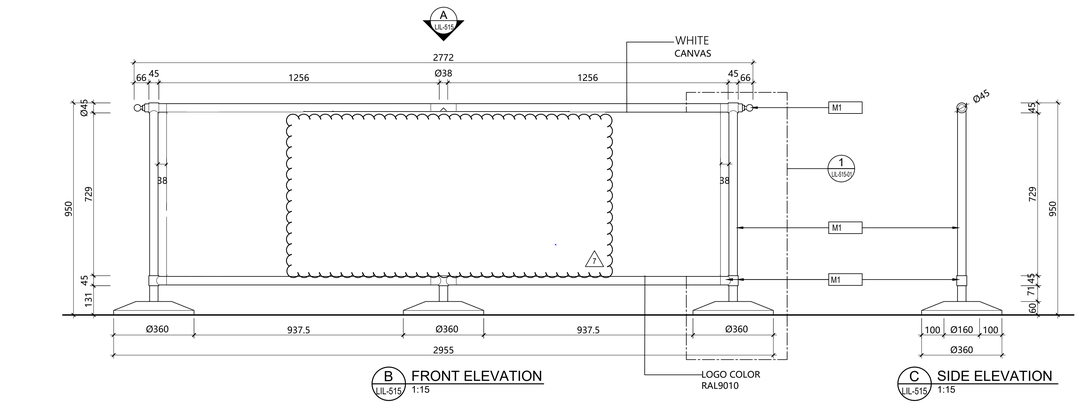


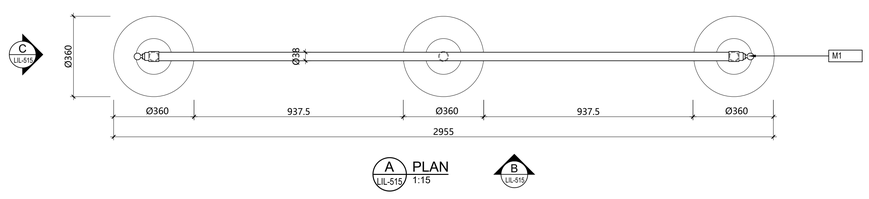


**FX-24 - EXTERIOR STANCHION**
SCALE: NTS

Wicker Chairs
Vendor: Inou info@inou.es

**Silla Tivoli**
Textilene **UNO** Verde y Blanco
*Aluminio Pintado Deco Bambú*

**DC-16 - CAFE CHAIR**
SCALE: NTS

28 1/2" High
24" X 24" Base Bottom Spread

**DC-15 - CAFE ROUND TABLE**
SCALE: NTS

17 1/2" D x 28 1/2" H

**2x per ada table*

**O/A TABLE HEIGHT** = 28.5" base + 1.8" table top = 30.3" H

SHEET PROVIDED FOR REFERENCE ONLY. FINAL DETAILS BY MILLWORK VENDOR.

**DC-15A - CAFE RECANGULAR ADA TABLE**
SCALE: NTS

RALPH LAUREN

**SPACE PLAN**

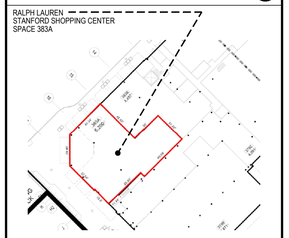


Lam+Tea Engineering

kpff

**SUBMISSION FOR ARCHITECTURAL REVIEW BOARD**

| NO. | REVISION | DATE | BY |
|---|---|---|---|
| 9 | A.R.B. CORRECTIONS 2 | 07.22.2025 | TPG |
| 8 | PERMIT CORRECTIONS 2 | 07.02.2025 | TPG |
| 7 | A.R.B. CORRECTIONS 1 | 05.30.2025 | TPG |
| 6 | BOARD OF HEALTH CORRECTIONS | 04.18.2025 | TPG |
| 5 | LATEST FULL SET UPDATES | 04.14.2025 | TPG |
| 4 | PERMIT CORRECTIONS 1 | 05.23.2025 | TPG |
| 3 | BID ADDENDUM 1 | 03.11.2025 | TPG |
| 2 | ISSUED FOR BID & PERMIT | 01.10.2025 | TPG |
| 1 | PROGRESS SET FOR CLIENT REVIEW | 12.13.2024 | TPG |


TPG Architecture

**TPG ARCHITECTURE, LLP**
**31 PENN PLAZA**
**132 WEST 31ST STREET, 5TH FLOOR, NEW YORK, NY 10001**
**212.768.0800 | TPGARCHITECTURE.COM**



IN CONSIDERATION OF RECEIVING DRAWINGS FROM TPG ARCHITECTURE LLP IN AN ELECTRONIC FORM, THE RECIPIENT AGREES, TO THE FULLEST EXTENT PERMITTED BY LAW, TO HOLD HARMLESS AND INDEMNIFY TPG ARCHITECTURE LLP FROM AND AGAINST ALL CLAIMS, LIABILITIES, LOSSES, DAMAGES, AND COSTS, INCLUDING BUT NOT LIMITED TO ATTORNEY'S FEES, ARISING OUT OF, OR IN ANY WAY CONNECTED WITH THE USE, RE-USE, MISUSE, MODIFICATION, OR MISINTERPRETATION OF THE MACHINE-READABLE INFORMATION PROVIDED BY TPG ARCHITECTURE LLP UNDER THIS AGREEMENT.


PROJECT
**RALPH LAUREN**
**STANFORD SHOPPING CENTER**
180 EL CAMINO REAL #383A, BLDG. M
PALO ALTO, CA 94304

DRAWING
EXTERIOR FIXTURE DETAILS

SEAL

LICENSED ARCHITECT ROBERT HUGHES 26476 RENEWAL DATE 08-31-25 STATE OF CALIFORNIA

| | |
|---|---|
| DATE | 04/18/2025 |
| PROJECT NO. | 1524879-00 |
| SCALE | NTS |
| DWG NO. | A-502.00 |
| CAD FILE NO. | A-501.00_FIXTURE - ARB.DWG |
| PAGE | 39 of 55 |


K:\241524879.0008_DRAWINGS_CAD\2_SHEETS\A-501.00_FIXTURE - ARB.DWG | Plot Date: Jun. 2, 2025 - 11:52 AM
Last Saved By: MHAMANI | Save Date: 6/2/2025 11:45:59 AM

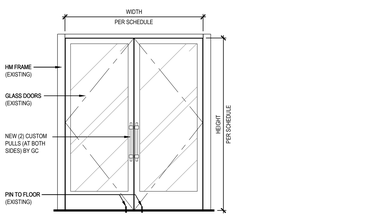


**A** DOOR TYPE - EXTERIOR — SCALE: 3/8"=1'-0"

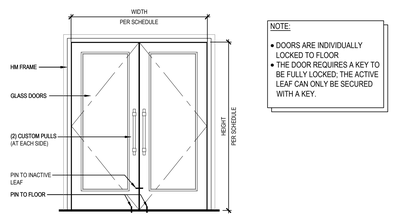


**B** DOOR TYPE - EXTERIOR — SCALE: 3/8"=1'-0"

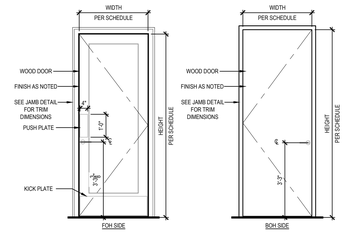


**C** DOOR TYPE — SCALE: 3/8"=1'-0"

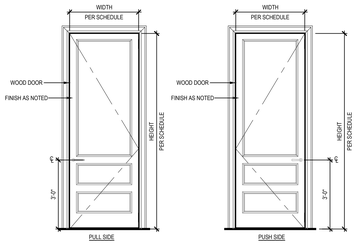


**D** DOOR TYPE — SCALE: 3/8"=1'-0"

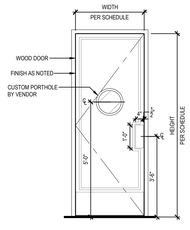


**E** DOOR TYPE — SCALE: 3/8"=1'-0"

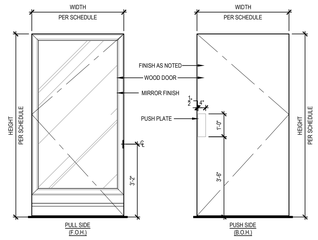


**F** DOOR TYPE — SCALE: 3/8"=1'-0"

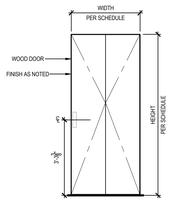


**G** DOOR TYPE — SCALE: 3/8"=1'-0"

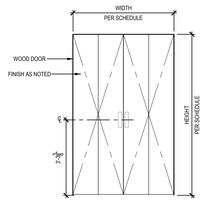


**H** DOOR TYPE — SCALE: 3/8"=1'-0"

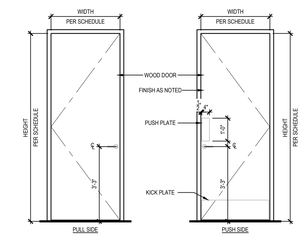


**J** DOOR TYPE — SCALE: 3/8"=1'-0"

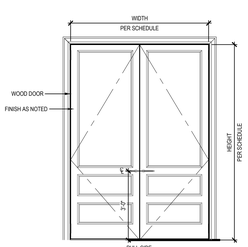


**K** DOOR TYPE — SCALE: 3/8"=1'-0"

NOTE: BACK OF HOUSE SIGNAGE TO BE SUPPLIED, INSTALLED AND COORD. BY GC. COORD.FINISH REQS WITH OWNER AND MILLWORK VENDOR

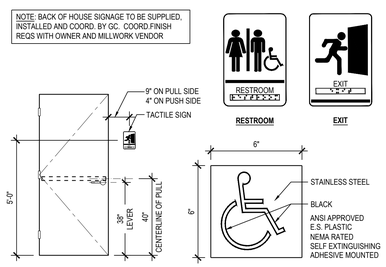


**RESTROOM** **EXIT**

**INTERNATIONAL ACCESSIBILITY SYMBOL**

SIGNAGE NOTES:

1. SIGN TO BE ADHESIVE ACRYLIC WITH RAISED CHARACTERS WITH A MINIMUM HEIGHT OF $\frac{5}{8}$" AND MAXIMUM HEIGHT OF 2" ACCOMPANIED BY GRADE 2 BRAILLE
2. PICTOGRAMS SHALL HAVE THE EQUIVALENT VERBAL DESCRIPTION LISTED DIRECTLY BELOW
3. CHARACTERS, SYMBOLS AND THEIR BACKGROUNDS SHALL HAVE A NON-GLARE FINISH WITH CHARACTERS AND SYMBOLS THAT CONTRAST WITH THE BACKGROUND.
4. SIGN TO BE MOUNTED AT LATCH-SIDE OF DOOR. WHEN SIGN OCCURS AT DOUBLE DOORS, MOUNT AT RIGHT SIDE OF RIGHT-HAND DOOR. WHEN WALL SPACE IS NOT AVAILABLE IN SUCH LOCATIONS, SIGN TO BE INSTALLED ON NEAREST ADJACENT WALL.
5. PROVIDE 18" x18" CLEAR FLOOR AREA CENTERED ON SIGN, BEYOND THE ARC OF ANY DOOR SWING
6. SIGNS TO BE BROWN WITH WHITE LETTERS, TYPICAL
7. TACTILE EXIT SIGNS SHALL COMPLY WITH SECTION 11B-703 AND 1011.4 OF THE BUILDING CODE.
8. GC TO PROVIDE "NO SMOKING" SIGN WITHIN 25 FEET OF BUILDING ENTRIES, OUTDOOR AIR INTAKES AND OPERABLE WINDOWS.
9. SIGNS TO BE INSTALLED IN COMPLIANCE WITH ALL APPLICABLE ACCESSIBILITY CODES & STANDARDS.

BRAILLE SIGNAGE NOTES:

1. PER THE LL REQUIREMENTS BRAILLE SIGNAGE TO BE INSTALLED AT TENANT STORE ENTRY POINTS IN COMPLIANCE WITH THE CITY OF PALO ALTO ADA/ BRAILLE CODES REQUIRED. G.C. TO PROVIDE AND INSTALL SIGNAGE BELOW AS SPECIFIED, COORDINATE FINAL LOCATION WITH TENANT AND LL.

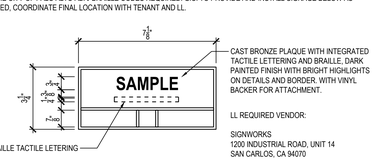


LL REQUIRED VENDOR:

SIGNWORKS
1200 INDUSTRIAL ROAD, UNIT 14
SAN CARLOS, CA 94070

DIRECT: (650) 508-7446

## DOOR SCHEDULE

| DOOR # | LOCATION | DOOR TYPE | DOOR SIZE (W x H) | DOOR HANDLING | DOOR MATERIAL | DOOR UNDERCUT | FRAME HEAD | FRAME JAMB | FRAME MATERIAL | FRAME THRESHOLD | FIRE RATING (HRS) | HARDWARE SET | RESPONSIBILITY | REMARKS |
|---|---|---|---|---|---|---|---|---|---|---|---|---|---|---|
| 100 | EXTERIOR - RETAIL ENTRY [121] - | A | EXISTING | L.H.R. / R.H.R. | EXST | - | EXST | EXST | EXST | MTL | - | 1 | GC | REFER TO STOREFRONT DRAWINGS FOR DETAILS. REFINISH DOORS AS REQUIRED. |
| 101 | EXTERIOR - CAFE ENTRY [121] | B | 6'-0" x 7'-6" | L.H.R. / R.H.R. | METAL / GLASS | - | - | - | MTL | MTL | - | 2 | GC | REFER TO STOREFRONT DRAWINGS FOR DETAILS |
| 102 | B.O.H. CORRIDOR [105] / B.O.H. | C | 3'-0" X 8'-6" | L.H.R | WOOD | - | H4 | J4 | WD | - | - | 3 | GC | SECURITY HARDWARE, PAINT BOTH SIDES OF DOOR "PT1" |
| 103 | ADA RESTROOM [106] | D | 3'-0" x 8'-6" | L.H. | WOOD | - | H1 | J1 | WD | ST | - | 5 | GC | REFER TO ELEVATION FOR FINISHES |
| 104 | MANAGER'S OFFICE [108] | J | 3'-0" x 7'-0" | R.H. | HM | - | H2 | J2 | HM | - | - | 4 | GC | PAINT DOOR AND FRAME ON BOTH SIDES TO MATCH ADJACENT WALL FINISH. |
| 105 | SUPPLY CLOSET [107] | H | 4'-4 3/4" x 7'-0" | - | WOOD | - | H5 | J5 | HM | - | - | 6 | GC | PAINT DOOR AND FRAME ON BOTH SIDES TO MATCH ADJACENT WALL FINISH. |
| 106 | B.O.H. / CLOSET | G | 3'-7 1/8" x 7'-0" | - | WOOD | - | H5 | J5 | HM | - | - | 6 | GC | PAINT DOOR AND FRAME ON BOTH SIDES TO MATCH ADJACENT WALL FINISH. |
| 107 | ADA FITTING ROOM [113] | D | 3'-0" x 8'-6" | R.H. | WOOD | - | H1 | J1 | WD | - | - | 8 | GC | REFER TO ELEVATION FOR FINISHES |
| 108 | FITTING ROOM [114] | D | 3'-0" x 8'-6" | R.H. | WOOD | - | H1 | J1 | WD | - | - | 7 | GC | REFER TO ELEVATION FOR FINISHES |
| 109 | FITTING ROOM [115] | D | 3'-0" x 8'-6" | R.H. | WOOD | - | H1 | J1 | WD | - | - | 7 | GC | REFER TO ELEVATION FOR FINISHES |
| 110 | FITTING ROOM [116] | D | 3'-0" x 8'-6" | R.H. | WOOD | - | H1 | J1 | WD | - | - | 7 | GC | REFER TO ELEVATION FOR FINISHES |
| 111 | ELEC. ROOM [117] | F | 4'-0" x 7'-11 1/2" | L.H.R | WOOD | - | H3 | J3 | WD | - | - | 9 | MW | REFER TO ELEVATION FOR FINISHES. PAINT DOOR AT BOH TO MATCH ADJACENT WALL FINISH. |
| 112 | ADA RESTROOM [118] | D | 3'-0" x 8'-6" | R.H. | WOOD | - | H1 | H1 | WD | ST | - | 5 | GC | REFER TO ELEVATION FOR FINISHES |
| 113 | CAFE KITCHEN [122] | E | 3'-0" x 8'-6" | R.H. / L.H.R. | WOOD | - | H6 | H6 | MTL | MTL | - | 8 | GC | REFER TO ELEVATION FOR FINISHES |
| 114 | FITTING ROOM CLOSET [112] | K | 4'-1" x 8'-6" | L.H.R. / R.H.R. | WOOD | - | H1 | J1 | WD | - | - | 7 | GC | REFER TO ELEVATION FOR FINISHES |

## HARDWARE SCHEDULE

| SET | HARDWARE DESCRIPTION | QTY. | DESCRIPTION | MANUFACTURER | ITEM NO. / FINISH | REMARKS | RESPONSIBILITY |
|---|---|---|---|---|---|---|---|
| 1 | RETAIL ENTRY | 4 | PULL | - | - | CUSTOM PULLS. MATCH BRONZE BAKED ENAMEL RL CONTROL SAMPLE. RL TO PROVIDE MORE INFORMATION. TO FIT INTO REMOVED PULL ATTACHMENT LOCATIONS AT EXISTING DOOR. | GC |
| 2 | CAFE ENTRY | 4 | PULL | - | - | CUSTOM PULLS. MATCH BRONZE BAKED ENAMEL RL CONTROL SAMPLE. RL TO PROVIDE MORE INFORMATION. TO MATCH RETAIL ENTRY PULLS. | GC |
| | | 4 | HINGE | SUN VALLEY | BH-4545 W/ BH-STPL FINIAL | PROVIDE WITH FINIAL (TOP AND BOTTOM). FINISH TO MATCH M1 BRONZE. | GC |
| | | 1 | DEADBOLT | ADAMS RITE | MS1861-01 | | GC |
| | | 1 | DEADBOLT | ADAMS RITE | MS1861-02 | 2-POINT AT ACTIVE LEAF. | GC |
| | | 1 | CYLINDER | - | - | MORTISE. | GC |
| | | 1 | STRIKE | IVES | DP2 | ROUND. DUST PROOF. | GC |
| | | 1 | STOP | SUN VALLEY | DS-2HE 3 1/2" | CONFIRM FINAL FINISH WITH RL. | GC |
| | | 1 | THUMBTURN | SCHLAGE | 80-113 | CONFIRM FINAL FINISH WITH RL. AT INTERIOR. | GC |
| | | 1 | SWEEP | | | BLACK. | GC |
| 3 | FOH - BOH | 1 | LEVER | BALDWIN | L029 LEVER, R017 ROSETTE | PASSAGE FUNCTION. FINISH TO MATCH M1 BRONZE. | GC |
| | | 4 | HINGE | SUN VALLEY | BH-4545 W/ BH-STPL FINIAL | PROVIDE WITH FINIAL (TOP AND BOTTOM). FINISH TO MATCH M1 BRONZE. | GC |
| | | 1 | STOP | BALDWIN | 4505 | 1 1/2"D. FLOOR MOUNTED. FINISH TO MATCH M1 BRONZE. CONFIRM HEIGHT WITH UNDER-CUT OF DOOR. | GC |
| | | 4 | CONCEALED CLOSER | LCN | 3133H | FINISH TO MATCH M1 BRONZE. | GC |
| | | 1 | PUSH PLATE | BALDWIN | 2121 | FINISH TO MATCH M1 BRONZE. | GC |
| | | 1 | KICK PLATE | IVES | 8400 (12" HEIGHT) | FINISH TO MATCH M1 BRONZE. | GC |
| 4 | MANAGER'S OFFICE | 1 | LEVER/LOCKSET | SCHLAGE | LATITUDE. PLYMOUTH TRIM. | KEYED ENTRY. SATIN CHROME | GC |
| | | 3 | HINGE | STANLEY | FBB179 | 4.5" x 4.5" | GC |
| | | 1 | STOP | BALDWIN | 4505.264 | SATIN CHROME. | GC |
| | | 1 | CLOSER | LCN | 4040 SERIES | OVERHEAD DOOR CLOSER w/ REGULAR ARM. INSTALL AT LEAST-OCCUPIED SIDE OF DOOR | GC |
| | | 1 | CYLINDER | - | - | REMOVABLE CORE (PROVIDE CONSTRUCTION CORE) | GC |
| | | 1 | PUSH PLATE | BALDWIN | 2121 | AT PUSH SIDE. SEE DOOR TYPE. SATIN CHROME. | GC |
| | | 1 | KICK PLATE | IVES | 8400 (12" HEIGHT) | AT PUSH SIDE. SEE DOOR TYPE. SATIN CHROME. | GC |
| 5 | RESTROOM | 1 | LOCKSET | BALDWIN | L029 LEVER, R017 ROSETTE | PRIVACY FUNCTION. FINISH TO MATCH M1 BRONZE. | GC |
| | | 1 | CORE | - | - | PER LEVER MFR. CONSTRUCTION CORE KEY ALIKE WHERE APPLICABLE. | GC |
| | | 1 | KEY | - | - | CONSTRUCTION KEYS WHERE APPLICABLE. | GC |
| | | 4 | HINGE | SUN VALLEY | BH-4545 W/ BH-STPL FINIAL | PROVIDE WITH FINIAL (TOP AND BOTTOM). FINISH TO MATCH M1 BRONZE. | GC |
| | | 1 | STOP | BALDWIN | 4505 | 1 1/2"D. FLOOR MOUNTED. FINISH TO MATCH M1 BRONZE. CONFIRM HEIGHT WITH UNDER-CUT OF DOOR. | GC |
| | | 4 | CONCEALED CLOSER | LCN | 3133H | FINISH TO MATCH M1 BRONZE. | GC |
| 6 | BI-FOLD CLOSET | 1 | PIVOT | STANLEY | BFN125N | TOP AND BOTTOM. PER SET OF LEAVES. OR APPROVED EQUAL. PROVIDE TRACK AS REQUIRED. | GC |
| | | 3 | HINGE | - | - | PER SET OF LEAVES. | GC |
| | | 1 | LOCK | - | - | PER SET OF LEAVES. RL TO CONFIRM. | GC |
| | | 1 | PULL | IVES | 960 | FINGER PULL. PER SET OF LEAVES. SATIN CHROME. | GC |
| 7 | FITTING ROOM | 1 | LOCKSET | BALDWIN | L029 LEVER, R017 ROSETTE | PRIVACY FUNCTION. FINISH TO MATCH M1 BRONZE. | GC |
| | | 1 | CORE | - | - | PER LEVER MFR. CONSTRUCTION CORE KEY ALIKE WHERE APPLICABLE. | GC |
| | | 1 | KEY | - | - | CONSTRUCTION KEYS WHERE APPLICABLE. | GC |
| | | 4 | HINGE | SUN VALLEY | BH-4545 W/ BH-STPL FINIAL | PROVIDE WITH FINIAL (TOP AND BOTTOM). FINISH TO MATCH M1 BRONZE. | GC |
| | | 1 | STOP | BALDWIN | 4505 | 1 1/2"D. FLOOR MOUNTED. FINISH TO MATCH M1 BRONZE. CONFIRM HEIGHT WITH UNDER-CUT OF DOOR. | GC |
| 8 | CAFE BOH | 2 | PUSH PLATE | BALDWIN | 2121 | DOUBLE ACTING DOOR. PROVIDE AT BOTH SIDES. FINISH TO MATCH M1 BRONZE. | GC |
| | | 3 | PIVOT HINGE | BOMMER | 7512 SERIES | FINISH TO MATCH M1 BRONZE. | GC |
| | | 1 | STOP | OMNIA | OMN-7000, US32D | COORD. HEIGHT w/ UNDERCUT OF DOOR; COORD. LOCATION PER ADJACENT WALLS / MILLWORK | GC |
| | | 1 | CLOSER | LCN | 603X - 695 BRONZE | CONCEALED DOUBLE ACTING DOOR CLOSER. OR APPROVED EQUAL. MATCH M1 BRONZE. | GC |
| | | 1 | CUSTOM PORTHOLE | - | - | TRIM TO MATCH M1 BRONZE. CONFIRM FINAL DIAMETER WITH RL. | GC |
| 9 | HIDDEN FOH DOOR | 2 | EDGE PULL | SA BAXTER | AEP-3000 | AT FOH SIDE. CONCEAL INTEGRATED INTO MIRROR FRAME. FINISH TO MATCH M1 BRONZE. | MILLWORKER |
| | | 2 | PUSH PLATE | BALDWIN | 2121 | PROVIDE AT PUSH SIDE. SATIN CHROME. | MILLWORKER |
| | | 4 | HINGE | SOSS | 218 | AT FOH SIDE. FINISH TO MATCH M1 BRONZE. TO BE CONCEALED BEYOND MIRROR FRAME. | MILLWORKER |
| | | 1 | STOP | OMNIA | OMN-7000, US32D | 1 1/2"D. FLOOR MOUNTED. FINISH TO MATCH M1 BRONZE. CONFIRM HEIGHT WITH UNDER-CUT OF DOOR. | GC |
| | | 1 | CLOSER | - | - | RL TO CONFIRM. | MILLWORKER |
| | | 1 | MAGNETIC CATCH | IVES | 327 | MOUNTED A TOP OF DOOR AND FINGER PULL SIDE. | MILLWORKER |

## GENERAL NOTES

DOOR & HARDWARE NOTES:

1. ALL EGRESS DOORS TO BE READILY OPERABLE FROM EGRESS SIDE w/OUT KEY OR REQUIRING SPECIAL KNOWLEDGE OR ABILITY TO GRASP OPENING HARDWARE.
2. ANY DOOR PART OF EGRESS SYSTEM MUST BE PROVIDED w/ PERMANENT, DURABLE TACTILE SIGN, VISIBLE FROM HEADER FRAME STATING "THIS DOOR TO REMAIN UNLOCKED WHEN SPACE IS OCCUPIED" IN ACCORDANCE w/ LOCAL JURISDICTIONAL REQUIREMENTS.
3. ALL ACCESSIBLE ENTRANCES TO BE IDENTIFIED w/ (1) INTERNATIONAL SYMBOL OF ACCESSIBILITY MIN., VISIBLE TO PERSONS ALONG APPROACHING CIRCULATION PATH.
4. NO DOOR, OTHER THAN FIRE DOORS, CAN EXCEED 5 LB. PUSH / PULL FORCE RESTRICTION; DOOR LATCHES MUST RELEASE WHEN SUBJECT TO 15 LB. FORCE.
9. ALL ACCESSIBLE DOOR HARDWARE TO BE LEVER-TYPE PER ADA REQUIREMENTS; DOOR LATCHES & LOCKSETS SHALL BE MOUNTED BELOW 48" A.F.F.
10. USE WELDED DOOR BUCKS ONLY; NOT KNOCKDOWN-TYPE.
11. COORDINATE ALL KEYING w/ OWNER & ASSET PROTECTION.
12. CONFIRM CARD ACCESS REQUIREMENTS & LOCK FUNCTIONS w/ ASSET PROTECTION.
13. ALL CORES TO BE INTERCHANGEABLE 6-PIN/SMALL FORMAT PROVIDED BY GC.
14. ALL DOOR LOCKS TO BE INTERCHANGEABLE INSTAKEY CORES (7-PIN) w/ MASTER KEY PROVIDED BY ASSET PROTECTION.
15. PROVIDE GLASS BREAKS ON ALL GLASS DOORS.

RALPH LAUREN

## SPACE PLAN

RALPH LAUREN
STANFORD SHOPPING CENTER
SPACE 383A

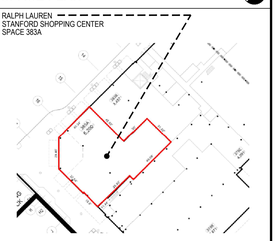

Lam+Tea Engineering

kpff

## SUBMISSION FOR ARCHITECTURAL REVIEW BOARD

| NO. | REVISION | | DATE | BY |
|---|---|---|---|---|
| 9 | A.R.B. CORRECTIONS 2 | 7 | 07.22.2025 | TPG |
| 8 | PERMIT CORRECTIONS 2 | 6 | 07.02.2025 | TPG |
| 7 | A.R.B. CORRECTIONS 1 | 5 | 05.30.2025 | TPG |
| 6 | BOARD OF HEALTH CORRECTIONS | 4 | 04.18.2025 | TPG |
| 5 | LATEST FULL SET UPDATES | 3 | 04.14.2025 | TPG |
| 4 | PERMIT CORRECTIONS 1 | 2 | 05.23.2025 | TPG |
| 3 | BID ADDENDUM 1 | 1 | 03.11.2025 | TPG |
| 2 | ISSUED FOR BID & PERMIT | | 01.10.2025 | TPG |
| 1 | PROGRESS SET FOR CLIENT REVIEW | | 12.13.2024 | TPG |

TPG Architecture

**TPG ARCHITECTURE, LLP**
**31 PENN PLAZA**
**132 WEST 31ST STREET, 5TH FLOOR, NEW YORK, NY 10001**
**212.768.0800 | TPGARCHITECTURE.COM**

IN CONSIDERATION OF RECEIVING DRAWINGS FROM TPG ARCHITECTURE LLP IN AN ELECTRONIC FORM, THE RECIPIENT AGREES, TO THE FULLEST EXTENT PERMITTED BY LAW, TO HOLD HARMLESS AND INDEMNIFY TPG ARCHITECTURE LLP FROM AND AGAINST ALL CLAIMS, LIABILITIES, LOSSES, DAMAGES, AND COSTS, INCLUDING BUT NOT LIMITED TO ATTORNEY'S FEES, ARISING OUT OF, OR IN ANY WAY CONNECTED WITH THE USE, RE-USE, MIS-USE, MODIFICATION, OR MISINTERPRETATION OF THE MACHINE-READABLE INFORMATION PROVIDED BY TPG ARCHITECTURE LLP UNDER THIS AGREEMENT.

PROJECT

**RALPH LAUREN**
**STANFORD SHOPPING CENTER**
180 EL CAMINO REAL #383A, BLDG. M
PALO ALTO, CA 94304

DRAWING

DOOR TYPES & SCHEDULES

FOR ARB EXHIBIT

SEAL

LICENSED ARCHITECT — ROBERT HUGHES — 26476 — 08/31/25 — RENEWAL DATE — STATE OF CALIFORNIA

| | |
|---|---|
| DATE | 01/10/2025 |
| PROJECT NO. | 1524879-00 |
| SCALE | 1/4"=1'-0" |
| DWG NO. | A-600.00 |
| CAD FILE NO. | A-600.00_DOOR SCHEDULE.DWG |
| PAGE | 40 of 55 |

K:\01\1524879.0008_DRAWINGS\3_CAD\2_SHEETS\A-600.00_DOOR SCHEDULE.DWG | Plot Date: Mar 20, 2025 - 6:22 AM
Last Saved By: MHAMANI ( Save Date: 3/1/2025 7:41:39 AM

1 **STOREFRONT ELEVATION - WEST** SCALE: 1/4"=1'-0"

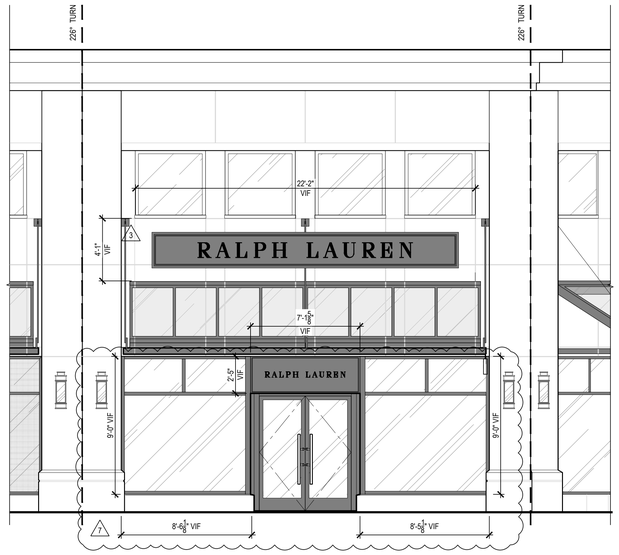


2 **STOREFRONT ELEVATION - SOUTHWEST** SCALE: 1/4"=1'-0"

DRAWINGS FOR DESIGN REFERENCE. GC TO PROVIDE FULLY ENGINEERED SHOP DRAWINGS FOR METAL FRAMING AND SUPPORTS AT STOREFRONT PREPARED BY AN ENGINEER LICENSED IN THE PROJECT JURISDICTION. COORDINATE ALL DETAILS AND SIZES WITH STRUCTURAL REQUIREMENTS TO MATCH THE EXISTING CONDITIONS

STOREFRONT VENDOR TO CONFIRM THICKNESS OF GLASS REQUIRED PRIOR TO COMMENCING ANY CONSTRUCTION / FABRICATION.

ENVELOPE COMPLIANCE WITH 2022 CALIFORNIA ENERGY CODE:

VERTICAL FENESTRATION:
-MAXIMUM U FACTOR: 0.47 (PER TABLE 141.0-A)
-RSHGC & VT REQUIREMENTS DO NOT APPLY PER EXCEPTION 1 TO SECTION 141.0(b)(2Ai. APPROXIMATE AREA OF REPLACEMENT GLASS IS 108 SF.

CONTRACTOR SHALL PROVIDE SUBMITTAL SHOWING U-FACTOR IS IN COMPLIANCE WITH THE ABOVE.

WALL INSULATION:
-MINIMUM R-13 INSULATION BETWEEN FRAMING MEMBERS OR OVERALL WALL ASSEMBLY U-VALUE SHALL BE NOT EXCEED U-0.217. ESTIMATED U-VALUE OF NEW PORTION OF EXTERIOR WALL ASSEMBLY IS BELOW:

R-0.2 (2 1/2" LIMESTONE) + R-0.26 (1" AIRSPACE) + R-1.25 (6" SOLID CMU) + R-6.5 (1" POLYISO RIGID FOAM) + R-0.56 (5/8" GYPSUM BOARD) = R-8.77

U = 1/R-8.77 = 0.114

U-0.114 < U-0.27 *COMPLIES*

**NOTES:**
- STOREFRONT SYSTEM SHALL BE KAWNEER TRIFAB 451UT.
- NEW ENTRY SHALL BE KAWNEER 190 ENTRANCE TO MATCH EXISTING STOREFRONT CONDITIONS. DOOR FRAME TO MATCH CUSTOM METAL FINISH AS SCHEDULED
- ENTRY DOOR GLASS TO BE LAMINATED.

SIGNAGE NOTE:
SIGNAGE UNDER SEPARATE APPLICATION.

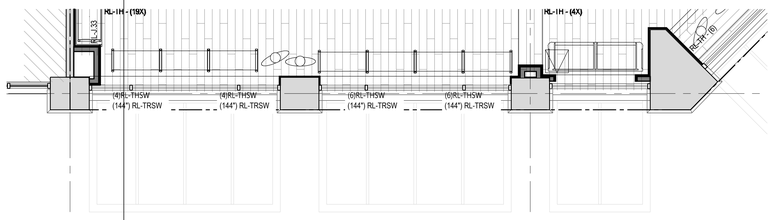


3 **STOREFRONT PLAN - WEST** SCALE: 1/4"=1'-0"

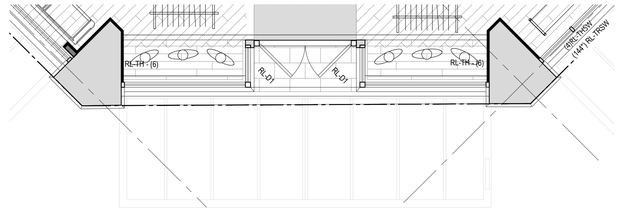


4 **STOREFRONT PLAN - SOUTHWEST** SCALE: 1/4"=1'-0"

5 **STOREFRONT ELEVATION - SOUTH** SCALE: 1/4"=1'-0"

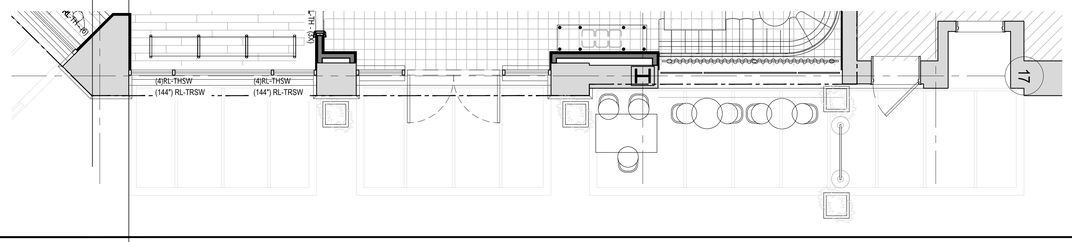


6 **STOREFRONT PLAN - SOUTH** SCALE: 1/4"=1'-0"

RALPH LAUREN

## SPACE PLAN

RALPH LAUREN
STANFORD SHOPPING CENTER
SPACE 383A

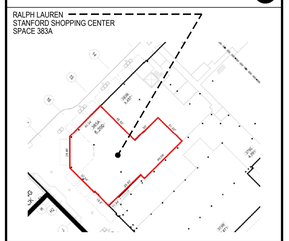

Lam+Tea Engineering

kpff

**SUBMISSION FOR ARCHITECTURAL REVIEW BOARD**

| NO. | REVISION | DATE | BY |
|---|---|---|---|
| 9 | A.R.B. CORRECTIONS 2 (7) | 07.22.2025 | TPG |
| 8 | PERMIT CORRECTIONS 2 (6) | 07.02.2025 | TPG |
| 7 | A.R.B. CORRECTIONS 1 (5) | 05.30.2025 | TPG |
| 6 | BOARD OF HEALTH CORRECTIONS (4) | 04.18.2025 | TPG |
| 5 | LATEST FULL SET UPDATES (3) | 04.14.2025 | TPG |
| 4 | PERMIT CORRECTIONS 1 (2) | 05.23.2025 | TPG |
| 3 | BID ADDENDUM 1 (1) | 03.11.2025 | TPG |
| 2 | ISSUED FOR BID & PERMIT | 01.10.2025 | TPG |
| 1 | PROGRESS SET FOR CLIENT REVIEW | 12.13.2024 | TPG |


TPG Architecture

**TPG ARCHITECTURE, LLP**
**31 PENN PLAZA**
**132 WEST 31ST STREET, 5TH FLOOR, NEW YORK, NY 10001**
**212.768.0800 | TPGARCHITECTURE.COM**



IN CONSIDERATION OF RECEIVING DRAWINGS FROM TPG ARCHITECTURE LLP IN AN ELECTRONIC FORM, THE RECIPIENT AGREES, TO THE FULLEST EXTENT PERMITTED BY LAW, TO HOLD HARMLESS AND INDEMNIFY TPG ARCHITECTURE LLP FROM AND AGAINST ALL CLAIMS, LIABILITIES, LOSSES, DAMAGES, AND COSTS, INCLUDING BUT NOT LIMITED TO ATTORNEY'S FEES, ARISING OUT OF, OR IN ANY WAY CONNECTED WITH THE USE, RE-USE, MIS-USE, MODIFICATION, OR MISINTERPRETATION OF THE MACHINE-READABLE INFORMATION PROVIDED BY TPG ARCHITECTURE LLP UNDER THIS AGREEMENT.


PROJECT
**RALPH LAUREN**
**STANFORD SHOPPING CENTER**
180 EL CAMINO REAL #383A, BLDG. M
PALO ALTO, CA 94304

DRAWING
ENLARGED PLAN & ELEVATIONS - STOREFRONT

SEAL

| | |
|---|---|
| DATE | 04/18/2025 |
| PROJECT NO. | 1524879-00 |
| SCALE | 1/4"=1'-0" |
| DWG NO. | A-700.00 |
| CAD FILE NO. | A-700.00_STOREFRONT ELEV.DWG |
| PAGE | 42 of 55 |


K:\24\1524879.0000_DRAWINGS_CAD\2_SHEETS\A-700.00_STOREFRONT ELEV.DWG | Plot Date: Jul. 22, 2025 - 2:50 PM
Last Saved By: MHAMANN | Save Date: 7/22/2025 2:08:33 PM

**NOTES:**
- STOREFRONT SYSTEM SHALL BE KAWNEER TRIFAB 451UT.
- NEW ENTRY SHALL BE KAWNEER 190 ENTRANCE TO MATCH EXISTING STOREFRONT CONDITIONS. DOOR FRAME TO MATCH CUSTOM METAL FINISH AS SCHEDULED
- ENTRY DOOR GLASS TO BE LAMINATED.

STOREFRONT VENDOR TO CONFIRM THICKNESS OF GLASS REQUIRED PRIOR TO COMMENCING ANY CONSTRUCTION / FABRICATION.

## 1 ENLARGED STOREFRONT ELEVATION - WEST

SCALE: 1/2"=1'-0"

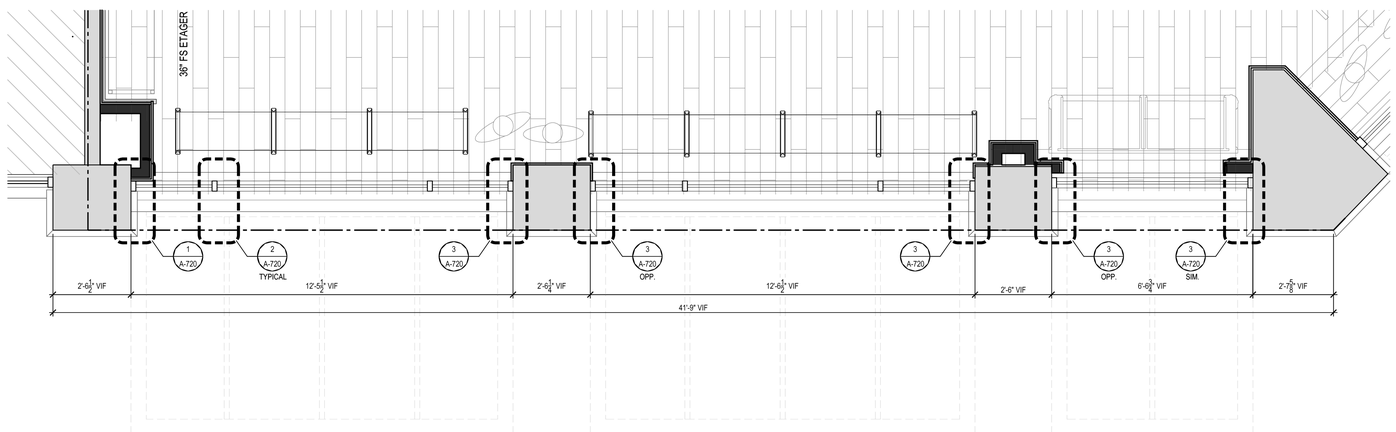


## 2 ENLARGED STOREFRONT PLAN - WEST

SCALE: 1/2"=1'-0"

RALPH LAUREN

**SPACE PLAN**

RALPH LAUREN
STANFORD SHOPPING CENTER
SPACE 383A

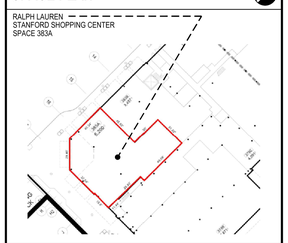

Lam+Tea Engineering

kpff

**SUBMISSION FOR ARCHITECTURAL REVIEW BOARD**

| NO. | REVISION | DATE | BY |
|---|---|---|---|
| 9 | A.R.B. CORRECTIONS 2 (7) | 07.22.2025 | TPG |
| 8 | PERMIT CORRECTIONS 2 (6) | 07.02.2025 | TPG |
| 7 | A.R.B. CORRECTIONS 1 (5) | 05.30.2025 | TPG |
| 6 | BOARD OF HEALTH CORRECTIONS (4) | 04.18.2025 | TPG |
| 5 | LATEST FULL SET UPDATES (3) | 04.14.2025 | TPG |
| 4 | PERMIT CORRECTIONS 1 (2) | 05.23.2025 | TPG |
| 3 | BID ADDENDUM 1 (1) | 03.11.2025 | TPG |
| 2 | ISSUED FOR BID & PERMIT | 01.10.2025 | TPG |
| 1 | PROGRESS SET FOR CLIENT REVIEW | 12.13.2024 | TPG |

TPG Architecture

**TPG ARCHITECTURE, LLP**
**31 PENN PLAZA**
**132 WEST 31ST STREET, 5TH FLOOR, NEW YORK, NY 10001**
**212.768.0800 | TPGARCHITECTURE.COM**

IN CONSIDERATION OF RECEIVING DRAWINGS FROM TPG ARCHITECTURE LLP IN AN ELECTRONIC FORM, THE RECIPIENT AGREES, TO THE FULLEST EXTENT PERMITTED BY LAW, TO HOLD HARMLESS AND INDEMNIFY TPG ARCHITECTURE LLP FROM AND AGAINST ALL CLAIMS, LIABILITIES, LOSSES, DAMAGES, AND COSTS, INCLUDING BUT NOT LIMITED TO ATTORNEY'S FEES, ARISING OUT OF, OR IN ANY WAY CONNECTED WITH THE USE, RE-USE, MIS-USE, MODIFICATION, OR MISINTERPRETATION OF THE MACHINE-READABLE INFORMATION PROVIDED BY TPG ARCHITECTURE LLP UNDER THIS AGREEMENT.

PROJECT
**RALPH LAUREN**
**STANFORD SHOPPING CENTER**
180 EL CAMINO REAL #383A, BLDG. M
PALO ALTO, CA 94304

DRAWING
ENLARGED PLAN & ELEVATIONS
STOREFRONT

SEAL

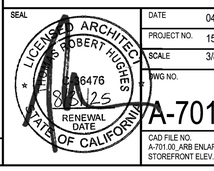


| | |
|---|---|
| DATE | 04/18/2025 |
| PROJECT NO. | 1524879-00 |
| SCALE | 3/8"=1'-0" |
| DWG NO. | A-701.00 |
| CAD FILE NO. | A-701.00_ARB ENLARGED STOREFRONT ELEV.DWG |
| PAGE | 43 of 55 |

K:\24\1524879-0000_DRAWINGS\3_CAD\2_SHEETS\A-701.00_ARB ENLARGED STOREFRONT ELEV.DWG | Plot Date: Jul. 23, 2025 - 6:28 AM
Last Saved By: MHAMANN | Save Date: 7/23/2025 6:24:20 AM

1 ENLARGED STOREFRONT ELEVATION - SOUTHWEST — SCALE: 1/2"=1'-0"

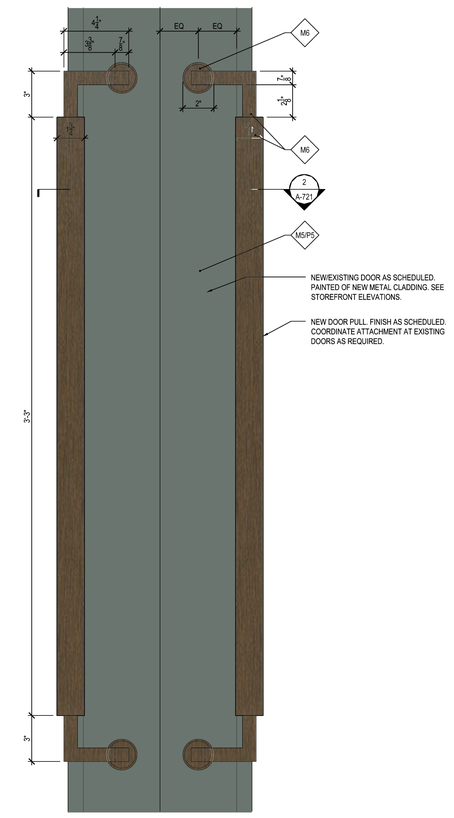


1A ENTRY DOOR HARDWARE — SCALE: 1/2"=1'-0"

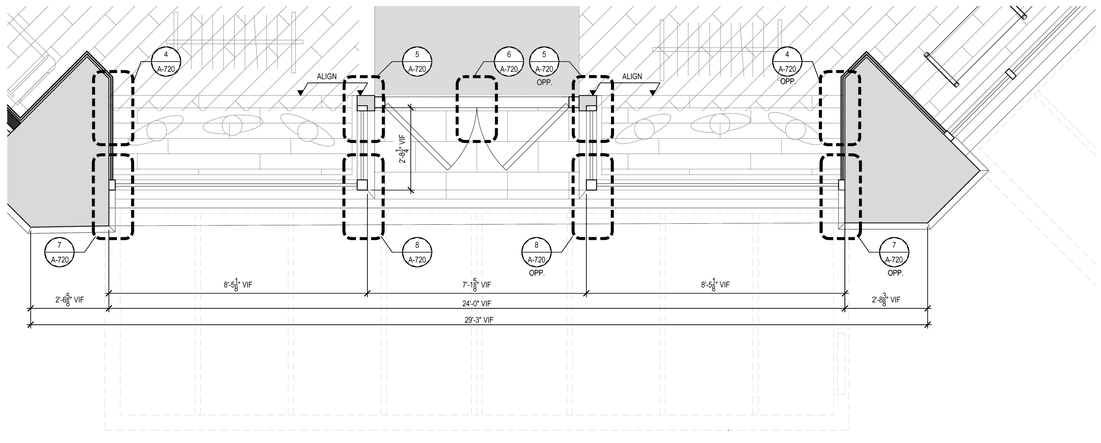


2 ENLARGED STOREFRONT PLAN - SOUTHWEST — SCALE: 1/2"=1'-0"

RALPH LAUREN

## SPACE PLAN

RALPH LAUREN
STANFORD SHOPPING CENTER
SPACE 383A

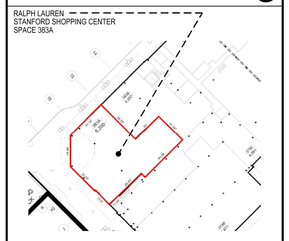

Lam+Tea Engineering

kpff

## SUBMISSION FOR ARCHITECTURAL REVIEW BOARD

| NO. | REVISION | | DATE | BY |
|---|---|---|---|---|
| 9 | A.R.B. CORRECTIONS 2 | 7 | 07.22.2025 | TPG |
| 8 | PERMIT CORRECTIONS 2 | 6 | 07.02.2025 | TPG |
| 7 | A.R.B. CORRECTIONS 1 | 5 | 05.30.2025 | TPG |
| 6 | BOARD OF HEALTH CORRECTIONS | 4 | 04.18.2025 | TPG |
| 5 | LATEST FULL SET UPDATES | 3 | 04.14.2025 | TPG |
| 4 | PERMIT CORRECTIONS 1 | 2 | 05.23.2025 | TPG |
| 3 | BID ADDENDUM 1 | 1 | 03.11.2025 | TPG |
| 2 | ISSUED FOR BID & PERMIT | | 01.10.2025 | TPG |
| 1 | PROGRESS SET FOR CLIENT REVIEW | | 12.13.2024 | TPG |

TPG Architecture

**TPG ARCHITECTURE, LLP**
**31 PENN PLAZA**
**132 WEST 31ST STREET, 5TH FLOOR, NEW YORK, NY 10001**
**212.768.0800 | TPGARCHITECTURE.COM**

IN CONSIDERATION OF RECEIVING DRAWINGS FROM TPG ARCHITECTURE LLP IN AN ELECTRONIC FORM, THE RECIPIENT AGREES, TO THE FULLEST EXTENT PERMITTED BY LAW, TO HOLD HARMLESS AND INDEMNIFY TPG ARCHITECTURE LLP FROM AND AGAINST ALL CLAIMS, LIABILITIES, LOSSES, DAMAGES, AND COSTS, INCLUDING BUT NOT LIMITED TO ATTORNEY'S FEES, ARISING OUT OF, OR IN ANY WAY CONNECTED WITH THE USE, RE-USE, MIS-USE, MODIFICATION, OR MISINTERPRETATION OF THE MACHINE-READABLE INFORMATION PROVIDED BY TPG ARCHITECTURE LLP UNDER THIS AGREEMENT.

PROJECT
**RALPH LAUREN**
**STANFORD SHOPPING CENTER**
180 EL CAMINO REAL #383A, BLDG. M
PALO ALTO, CA 94304

DRAWING
ENLARGED PLAN & ELEVATIONS
STOREFRONT

SEAL

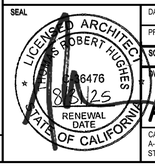


| | |
|---|---|
| DATE | 04/18/2025 |
| PROJECT NO. | 1524879-00 |
| SCALE | 3/8"=1'-0" |
| DWG NO. | A-702.00 |
| CAD FILE NO. | A-701.00_ARB ENLARGED STOREFRONT ELEV.DWG |
| PAGE | 44 of 55 |

K:\24\1524879-00\06_DRAWINGS\2_CAD\3_SHEETS\A-701.00_ARB ENLARGED STOREFRONT ELEV.DWG | Plot Date: Jul. 23, 2025 - 6:26 AM
Last Saved By: MHAMANN | Save Date: 7/23/2025 6:24:29 AM

## 1 ENLARGED STOREFRONT ELEVATION - SOUTH

SCALE: 1/2"=1'-0"

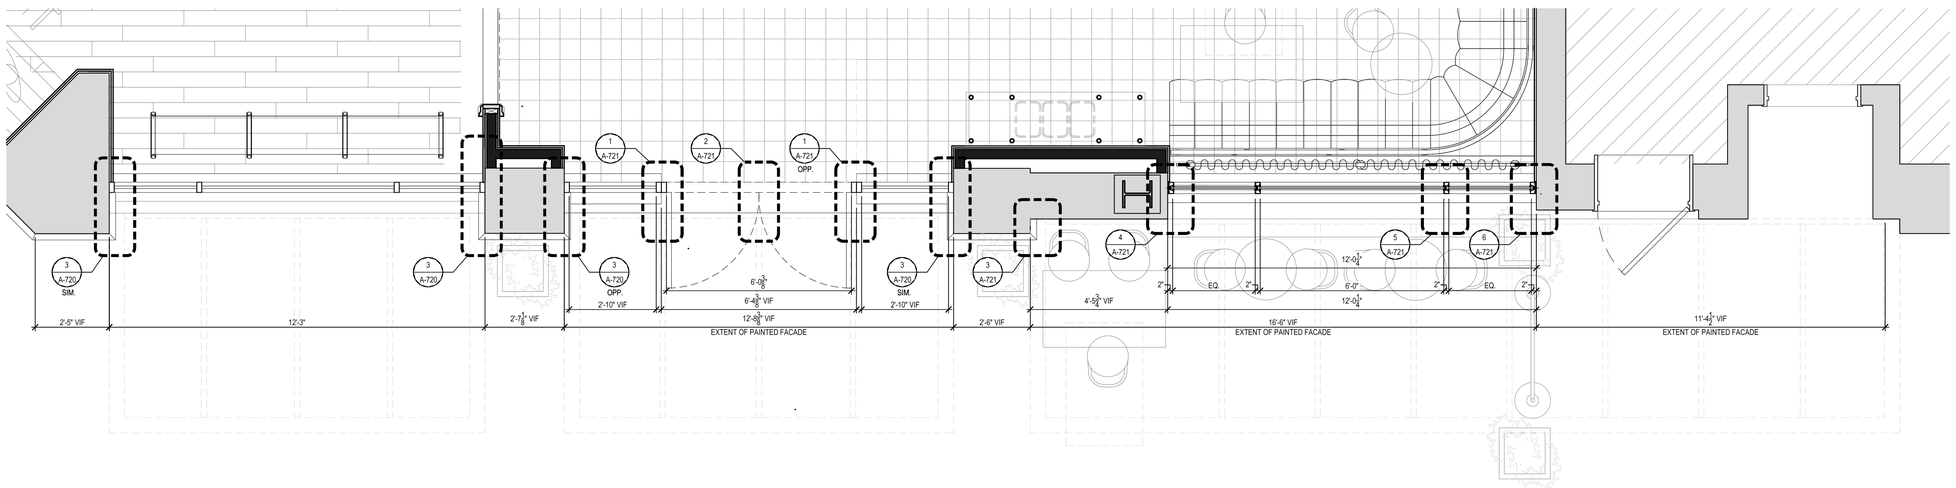


## 2 ENLARGED STOREFRONT PLAN - SOUTH

SCALE: 1/2"=1'-0"

K:\SHS\1524879-0000_DRAWINGS\3_CAD\2_SHEETS\A-701.00_ARB ENLARGED STOREFRONT ELEV.DWG | Plot Date: Jul. 23, 2025 - 6:26 AM
Last Saved By: HAHAANN | Save Date: 7/22/2025 8:24:29 AM

RALPH LAUREN

**SPACE PLAN**

RALPH LAUREN
STANFORD SHOPPING CENTER
SPACE 383A

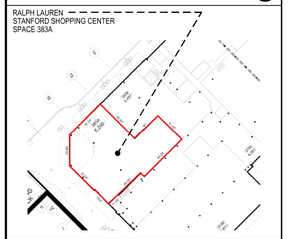

Lam+Tea Engineering

kpff

**SUBMISSION FOR ARCHITECTURAL REVIEW BOARD**

| NO. | REVISION | | DATE | BY |
|---|---|---|---|---|
| 9 | A.R.B. CORRECTIONS 2 | 7 | 07.22.2025 | TPG |
| 8 | PERMIT CORRECTIONS 2 | 6 | 07.02.2025 | TPG |
| 7 | A.R.B. CORRECTIONS 1 | 5 | 05.30.2025 | TPG |
| 6 | BOARD OF HEALTH CORRECTIONS | 4 | 04.18.2025 | TPG |
| 5 | LATEST FULL SET UPDATES | 3 | 04.14.2025 | TPG |
| 4 | PERMIT CORRECTIONS 1 | 2 | 05.23.2025 | TPG |
| 3 | BID ADDENDUM 1 | 1 | 03.11.2025 | TPG |
| 2 | ISSUED FOR BID & PERMIT | | 01.10.2025 | TPG |
| 1 | PROGRESS SET FOR CLIENT REVIEW | | 12.13.2024 | TPG |

TPG Architecture

**TPG ARCHITECTURE, LLP**
**31 PENN PLAZA**
**132 WEST 31ST STREET, 5TH FLOOR, NEW YORK, NY 10001**
**212.768.0800 | TPGARCHITECTURE.COM**

IN CONSIDERATION OF RECEIVING DRAWINGS FROM TPG ARCHITECTURE LLP IN AN ELECTRONIC FORM, THE RECIPIENT AGREES, TO THE FULLEST EXTENT PERMITTED BY LAW, TO HOLD HARMLESS AND INDEMNIFY TPG ARCHITECTURE LLP FROM AND AGAINST ALL CLAIMS, LIABILITIES, LOSSES, DAMAGES, AND COSTS, INCLUDING BUT NOT LIMITED TO ATTORNEY'S FEES, ARISING OUT OF, OR IN ANY WAY CONNECTED WITH THE USE, RE-USE, MIS-USE, MODIFICATION, OR MISINTERPRETATION OF THE MACHINE-READABLE INFORMATION PROVIDED BY TPG ARCHITECTURE LLP UNDER THIS AGREEMENT.

PROJECT
**RALPH LAUREN**
**STANFORD SHOPPING CENTER**
180 EL CAMINO REAL #383A, BLDG. M
PALO ALTO, CA 94304

DRAWING
ENLARGED PLAN & ELEVATIONS
STOREFRONT

SEAL

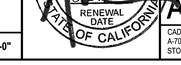


| | |
|---|---|
| DATE | 04/18/2025 |
| PROJECT NO. | 1524879-00 |
| SCALE | 3/8"=1'-0" |
| DWG NO. | A-703.00 |
| CAD FILE NO. | A-701.00_ARB ENLARGED STOREFRONT ELEV.DWG |
| PAGE | 45 of 55 |

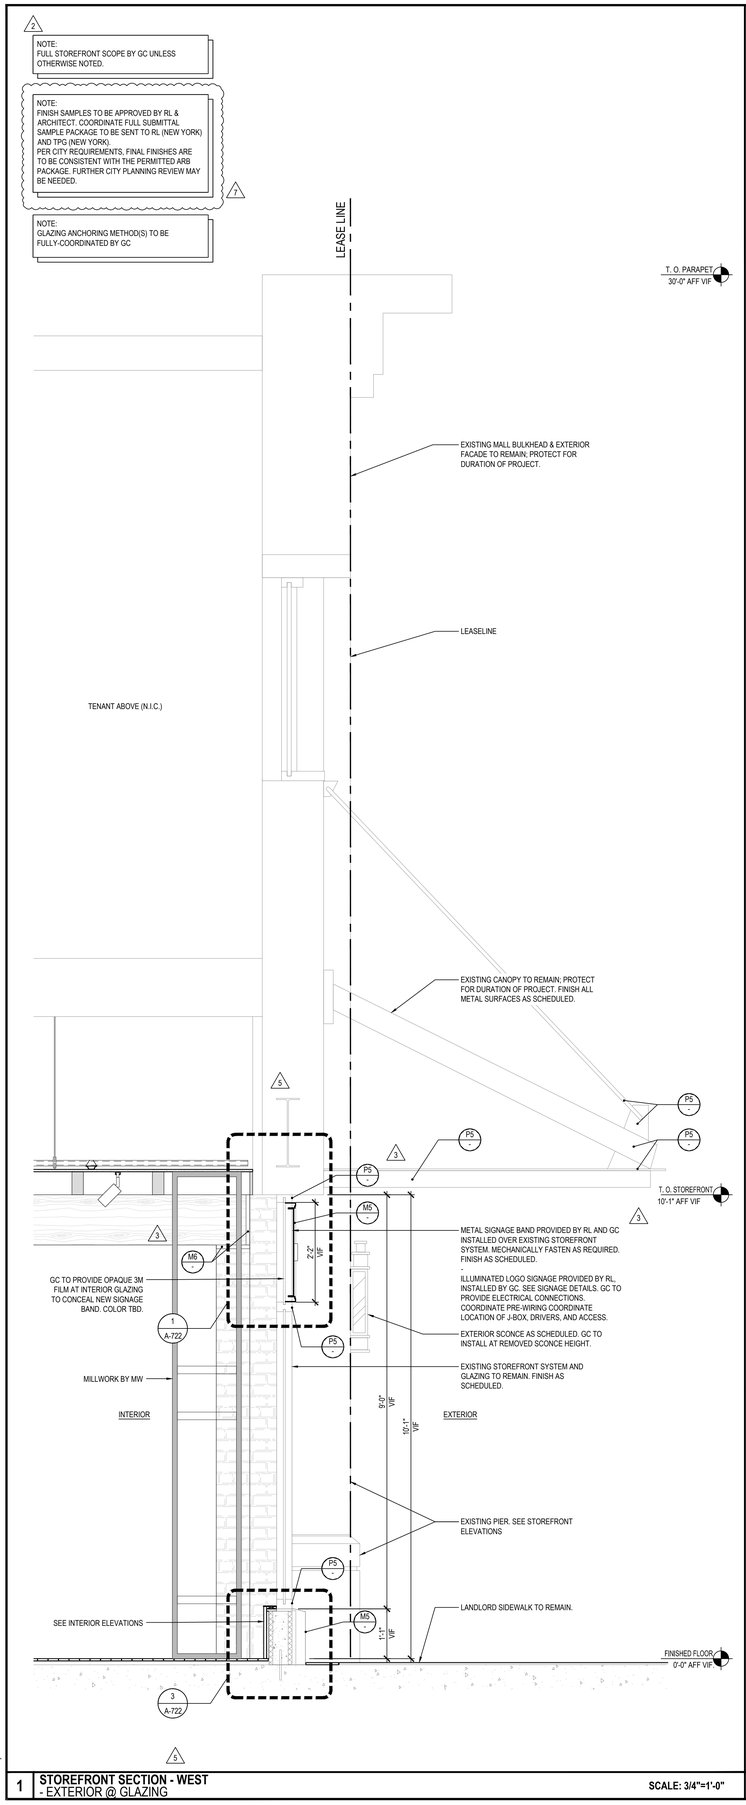


1 **STOREFRONT SECTION - WEST**
- EXTERIOR @ GLAZING
SCALE: 3/4"=1'-0"

2 **STOREFRONT SECTION - SOUTHWEST**
- EXTERIOR @ DISPLAY SHOW WINDOW
SCALE: 3/4"=1'-0"

3 **STOREFRONT SECTION - SOUTHWEST**
- EXTERIOR @ SALES ENTRY DOOR
SCALE: 3/4"=1'-0"

RALPH LAUREN

## SPACE PLAN

RALPH LAUREN
STANFORD SHOPPING CENTER
SPACE 383A

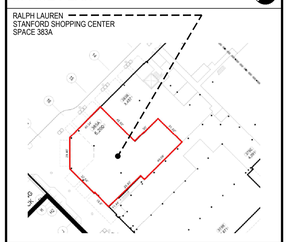

Lam+Tea Engineering

kpff

## SUBMISSION FOR ARCHITECTURAL REVIEW BOARD

| NO. | REVISION | | DATE | BY |
|---|---|---|---|---|
| 9 | A.R.B. CORRECTIONS 2 | 7 | 07.22.2025 | TPG |
| 8 | PERMIT CORRECTIONS 2 | 6 | 07.02.2025 | TPG |
| 7 | A.R.B. CORRECTIONS 1 | 5 | 05.30.2025 | TPG |
| 6 | BOARD OF HEALTH CORRECTIONS | 4 | 04.18.2025 | TPG |
| 5 | LATEST FULL SET UPDATES | 3 | 04.14.2025 | TPG |
| 4 | PERMIT CORRECTIONS 1 | 2 | 05.23.2025 | TPG |
| 3 | BID ADDENDUM 1 | 1 | 03.11.2025 | TPG |
| 2 | ISSUED FOR BID & PERMIT | | 01.10.2025 | TPG |
| 1 | PROGRESS SET FOR CLIENT REVIEW | | 12.13.2024 | TPG |

TPG Architecture

**TPG ARCHITECTURE, LLP**
**31 PENN PLAZA**
**132 WEST 31ST STREET, 5TH FLOOR, NEW YORK, NY 10001**
**212.768.0800 | TPGARCHITECTURE.COM**

IN CONSIDERATION OF RECEIVING DRAWINGS FROM TPG ARCHITECTURE LLP IN AN ELECTRONIC FORM, THE RECIPIENT AGREES, TO THE FULLEST EXTENT PERMITTED BY LAW, TO HOLD HARMLESS AND INDEMNIFY TPG ARCHITECTURE LLP FROM AND AGAINST ALL CLAIMS, LIABILITIES, LOSSES, DAMAGES, AND COSTS, INCLUDING BUT NOT LIMITED TO ATTORNEY'S FEES, ARISING OUT OF, OR IN ANY WAY CONNECTED WITH THE USE, RE-USE, MIS-USE, MODIFICATION, OR MISINTERPRETATION OF THE MACHINE-READABLE INFORMATION PROVIDED BY TPG ARCHITECTURE LLP UNDER THIS AGREEMENT.

PROJECT
**RALPH LAUREN**
**STANFORD SHOPPING CENTER**
180 EL CAMINO REAL #383A, BLDG. M
PALO ALTO, CA 94304

DRAWING
STOREFRONT SECTIONS

SEAL

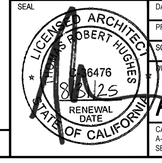


| | |
|---|---|
| DATE | 04/18/2025 |
| PROJECT NO. | 1524879-00 |
| SCALE | 3/4"=1'-0" |
| DWG NO. | A-710.00 |
| CAD FILE NO. | A-710.00_ARB STOREFRONT SECTIONS.DWG |
| PAGE | 46 of 55 |

K:\24\1524879.0000_DRAWINGS\2_CAD_SHEETS\A-710.00_ARB STOREFRONT SECTIONS.DWG | Plot Date: Jul. 22, 2025 - 6:15 PM
Last Saved By: MHAMANN | Save Date: 7/22/2025 6:07:42 PM

NOTE:
FULL STOREFRONT SCOPE BY GC UNLESS OTHERWISE NOTED.

NOTE:
FINISH SAMPLES TO BE APPROVED BY RL & ARCHITECT. COORDINATE FULL SUBMITTAL SAMPLE PACKAGE TO BE SENT TO RL (NEW YORK) AND TPG (NEW YORK).
PER CITY REQUIREMENTS, FINAL FINISHES ARE TO BE CONSISTENT WITH THE PERMITTED ARB PACKAGE. FURTHER CITY PLANNING REVIEW MAY BE NEEDED.

NOTE:
GLAZING ANCHORING METHOD(S) TO BE FULLY-COORDINATED BY GC

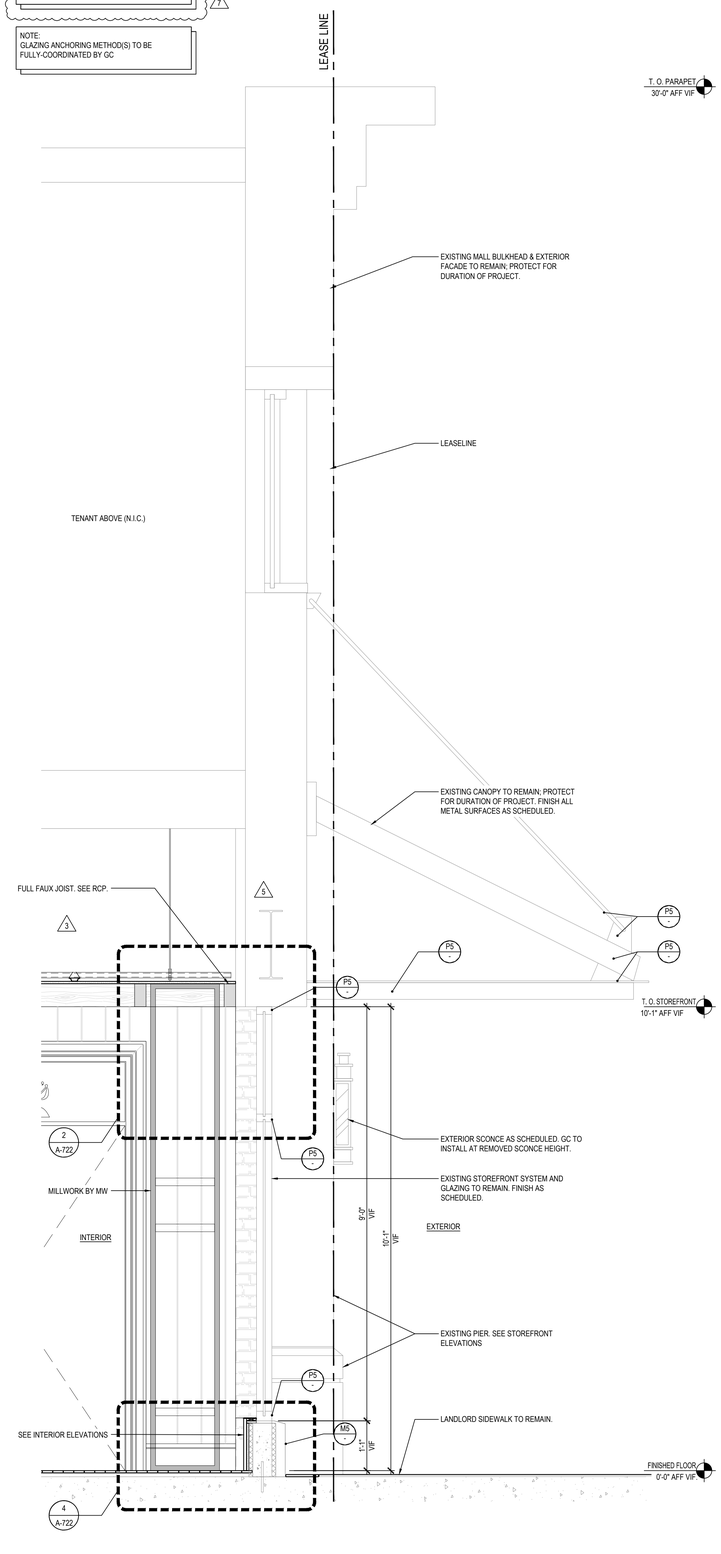


1 | STOREFRONT SECTION - SOUTH - EXTERIOR @ EXISTING CAFE GLAZING — SCALE: 3/4"=1'-0"

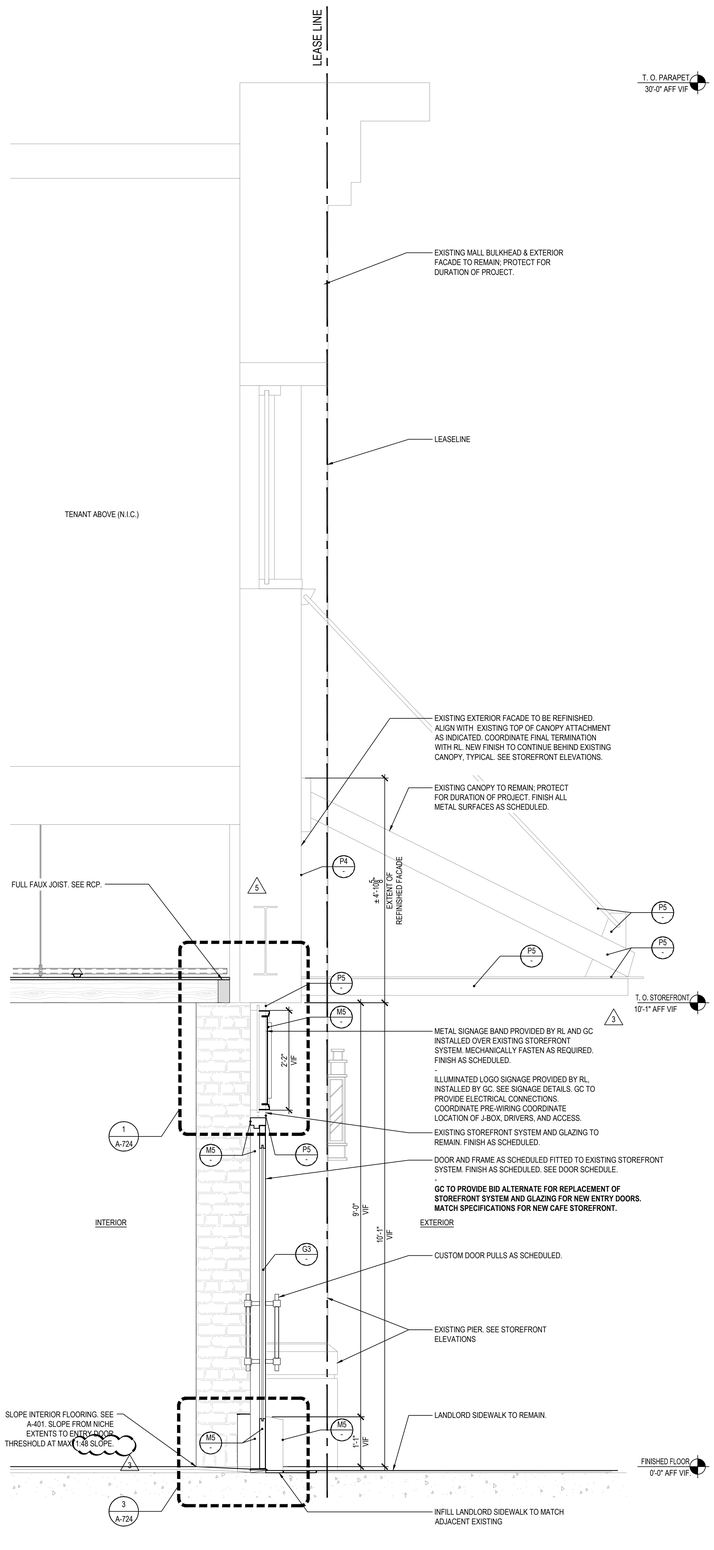


2 | STOREFRONT SECTION - SOUTH - EXTERIOR @ CAFE ENTRY DOOR — SCALE: 3/4"=1'-0"

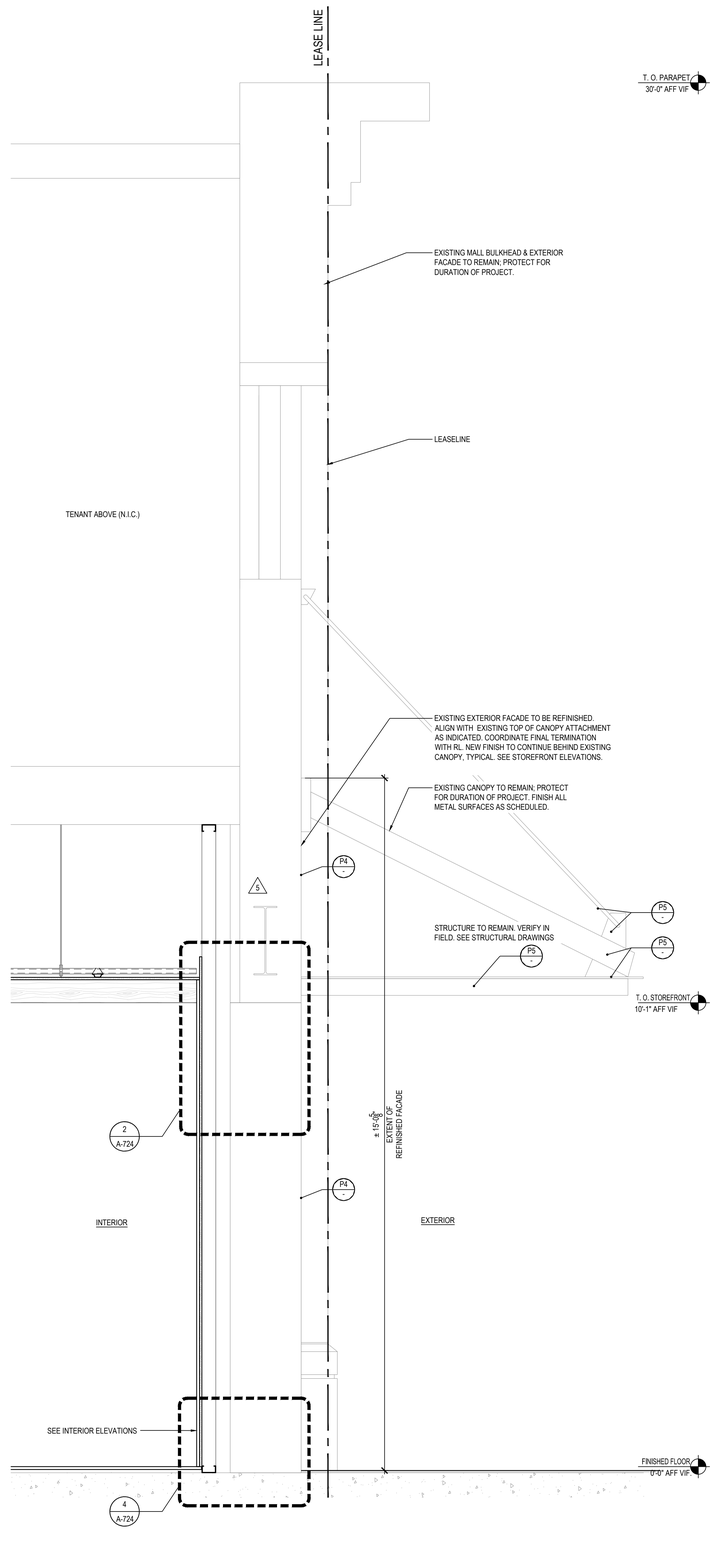


3 | STOREFRONT SECTION - SOUTH - EXTERIOR @ CAFE — SCALE: 3/4"=1'-0"

RALPH LAUREN

## SPACE PLAN

RALPH LAUREN
STANFORD SHOPPING CENTER
SPACE 383A

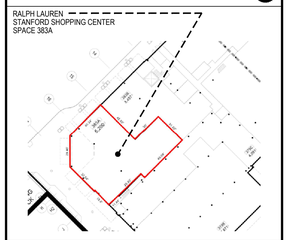

Lam+Tea Engineering

kpff

## SUBMISSION FOR ARCHITECTURAL REVIEW BOARD

| NO. | REVISION | | DATE | BY |
|---|---|---|---|---|
| 9 | A.R.B. CORRECTIONS 2 | 7 | 07.22.2025 | TPG |
| 8 | PERMIT CORRECTIONS 2 | 6 | 07.02.2025 | TPG |
| 7 | A.R.B. CORRECTIONS 1 | 5 | 05.30.2025 | TPG |
| 6 | BOARD OF HEALTH CORRECTIONS | 4 | 04.18.2025 | TPG |
| 5 | LATEST FULL SET UPDATES | 3 | 04.14.2025 | TPG |
| 4 | PERMIT CORRECTIONS 1 | 2 | 05.23.2025 | TPG |
| 3 | BID ADDENDUM 1 | 1 | 03.11.2025 | TPG |
| 2 | ISSUED FOR BID & PERMIT | | 01.10.2025 | TPG |
| 1 | PROGRESS SET FOR CLIENT REVIEW | | 12.13.2024 | TPG |


TPG Architecture

**TPG ARCHITECTURE, LLP**
**31 PENN PLAZA**
**132 WEST 31ST STREET, 5TH FLOOR, NEW YORK, NY 10001**
**212.768.0800 | TPGARCHITECTURE.COM**



IN CONSIDERATION OF RECEIVING DRAWINGS FROM TPG ARCHITECTURE LLP IN AN ELECTRONIC FORM, THE RECIPIENT AGREES, TO THE FULLEST EXTENT PERMITTED BY LAW, TO HOLD HARMLESS AND INDEMNIFY TPG ARCHITECTURE LLP FROM AND AGAINST ALL CLAIMS, LIABILITIES, LOSSES, DAMAGES, AND COSTS, INCLUDING BUT NOT LIMITED TO ATTORNEY'S FEES, ARISING OUT OF, OR IN ANY WAY CONNECTED WITH THE USE, RE-USE, MIS-USE, MODIFICATION, OR MISINTERPRETATION OF THE MACHINE-READABLE INFORMATION PROVIDED BY TPG ARCHITECTURE LLP UNDER THIS AGREEMENT.


PROJECT
**RALPH LAUREN**
**STANFORD SHOPPING CENTER**
180 EL CAMINO REAL #383A, BLDG. M
PALO ALTO, CA 94304

DRAWING
STOREFRONT SECTIONS

SEAL

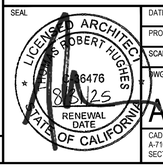


| | |
|---|---|
| DATE | 04/18/2025 |
| PROJECT NO. | 1524879-00 |
| SCALE | 3/4"=1'-0" |
| DWG NO. | A-711.00 |
| CAD FILE NO. | A-710.00_ARB STOREFRONT SECTIONS.DWG |
| PAGE | 47 of 55 |


K:\24\1524879-0008_DRAWINGS\3_CAD\2_SHEETS\A-710.00_ARB STOREFRONT SECTIONS.DWG | Plot Date: Jul. 22, 2025 - 6:15 PM
Last Saved By: MHAHAN | Save Date: 7/22/2025 6:07:42 PM

NOTE:
FULL STOREFRONT SCOPE BY GC UNLESS OTHERWISE NOTED.

NOTE:
FINISH SAMPLES TO BE APPROVED BY RL & ARCHITECT. COORDINATE FULL SUBMITTAL SAMPLE PACKAGE TO BE SENT TO RL (NEW YORK) AND TPG (NEW YORK).
PER CITY REQUIREMENTS, FINAL FINISHES ARE TO BE CONSISTENT WITH THE PERMITTED ARB PACKAGE. FURTHER CITY PLANNING REVIEW MAY BE NEEDED.

NOTE:
GLAZING ANCHORING METHOD(S) TO BE FULLY-COORDINATED BY GC

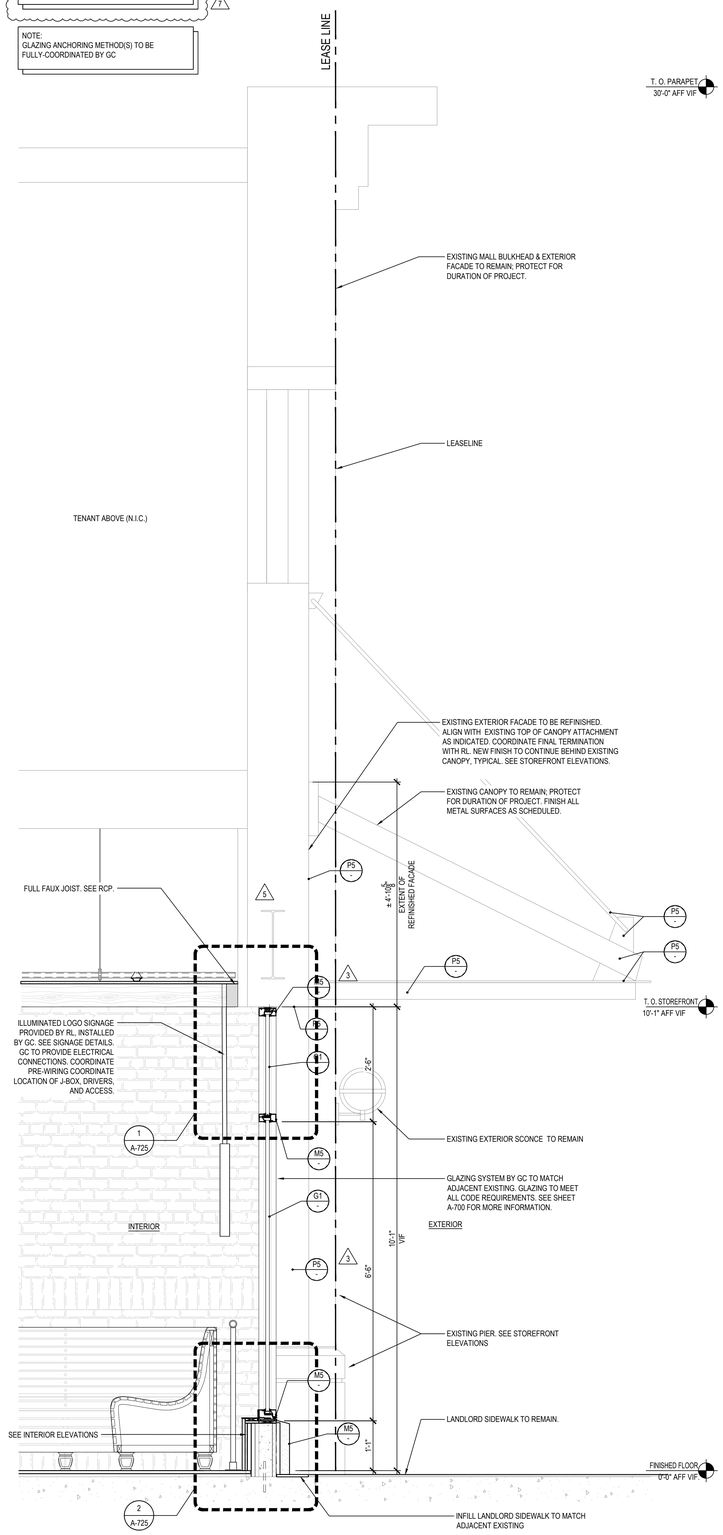


**1 STOREFRONT SECTION - SOUTH**
- EXTERIOR @ CAFE WINDOW

SCALE: 3/4"=1'-0"

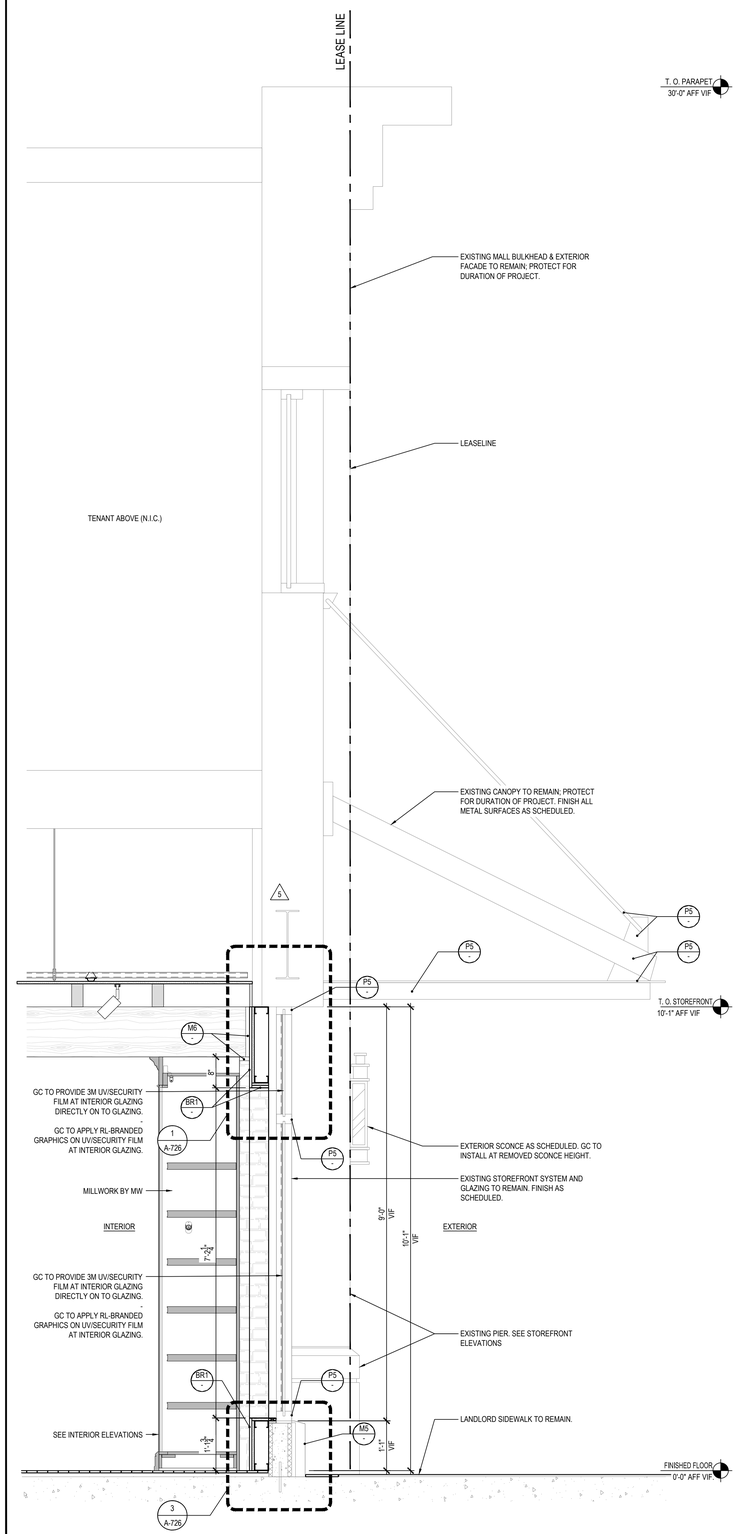


**2 STOREFRONT SECTION - WEST**
- EXTERIOR @ SHOW WINDOW W/ GRAPHICS

SCALE: 3/4"=1'-0"

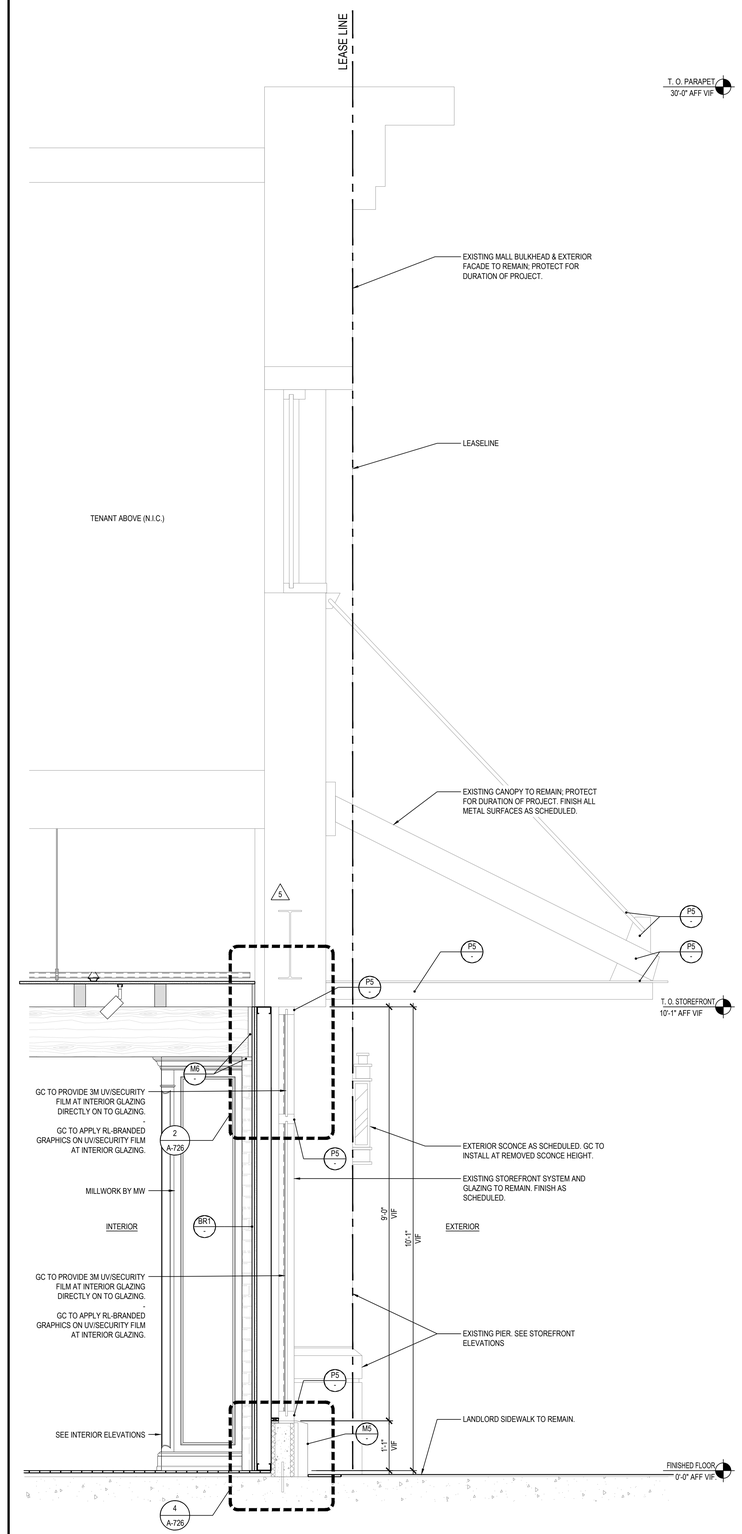


**3 STOREFRONT SECTION - WEST**
- EXTERIOR @ SHOW WINDOW W/ GRAPHICS

SCALE: 3/4"=1'-0"

RALPH LAUREN

## SPACE PLAN

RALPH LAUREN
STANFORD SHOPPING CENTER
SPACE 383A

Lam+Tea Engineering

kpff

## SUBMISSION FOR ARCHITECTURAL REVIEW BOARD

| NO. | REVISION | | DATE | BY |
|---|---|---|---|---|
| 9 | A.R.B. CORRECTIONS 2 | 7 | 07.22.2025 | TPG |
| 8 | PERMIT CORRECTIONS 2 | 6 | 07.02.2025 | TPG |
| 7 | A.R.B. CORRECTIONS 1 | 5 | 05.30.2025 | TPG |
| 6 | BOARD OF HEALTH CORRECTIONS | 4 | 04.18.2025 | TPG |
| 5 | LATEST FULL SET UPDATES | 3 | 04.14.2025 | TPG |
| 4 | PERMIT CORRECTIONS 1 | 2 | 05.23.2025 | TPG |
| 3 | BID ADDENDUM 1 | 1 | 03.11.2025 | TPG |
| 2 | ISSUED FOR BID & PERMIT | | 01.10.2025 | TPG |
| 1 | PROGRESS SET FOR CLIENT REVIEW | | 12.13.2024 | TPG |

TPG Architecture


**TPG ARCHITECTURE, LLP**
**31 PENN PLAZA**
**132 WEST 31ST STREET, 5TH FLOOR, NEW YORK, NY 10001**
**212.768.0800 | TPGARCHITECTURE.COM**



IN CONSIDERATION OF RECEIVING DRAWINGS FROM TPG ARCHITECTURE LLP IN AN ELECTRONIC FORM, THE RECIPIENT AGREES, TO THE FULLEST EXTENT PERMITTED BY LAW, TO HOLD HARMLESS AND INDEMNIFY TPG ARCHITECTURE LLP FROM AND AGAINST ALL CLAIMS, LIABILITIES, LOSSES, DAMAGES, AND COSTS, INCLUDING BUT NOT LIMITED TO ATTORNEY'S FEES, ARISING OUT OF, OR IN ANY WAY CONNECTED WITH THE USE, RE-USE, MIS-USE, MODIFICATION, OR MISINTERPRETATION OF THE MACHINE-READABLE INFORMATION PROVIDED BY TPG ARCHITECTURE LLP UNDER THIS AGREEMENT.


PROJECT
**RALPH LAUREN**
**STANFORD SHOPPING CENTER**
180 EL CAMINO REAL #383A, BLDG. M
PALO ALTO, CA 94304

DRAWING
STOREFRONT SECTIONS

SEAL

LICENSED ARCHITECT
RICHARD ROBERT HUGHES
16476
RENEWAL DATE 08.31.25
STATE OF CALIFORNIA

| | |
|---|---|
| DATE | 04/18/2025 |
| PROJECT NO. | 1524879-00 |
| SCALE | 3/4"=1'-0" |
| DWG NO. | A-712.00 |
| CAD FILE NO. | A-710.00_ARB STOREFRONT SECTIONS.DWG |
| PAGE | 48 of 55 |


K:\2015\1524879.0068_DRAWINGS\2_CAD\2_PHOTEK\A-710.00_ARB STOREFRONT SECTIONS.DWG | Plot Date: Jul. 22, 2025 - 6:15 PM
Last Saved By: MHAANAN | Save Date: 7/22/2025 6:01:42 PM

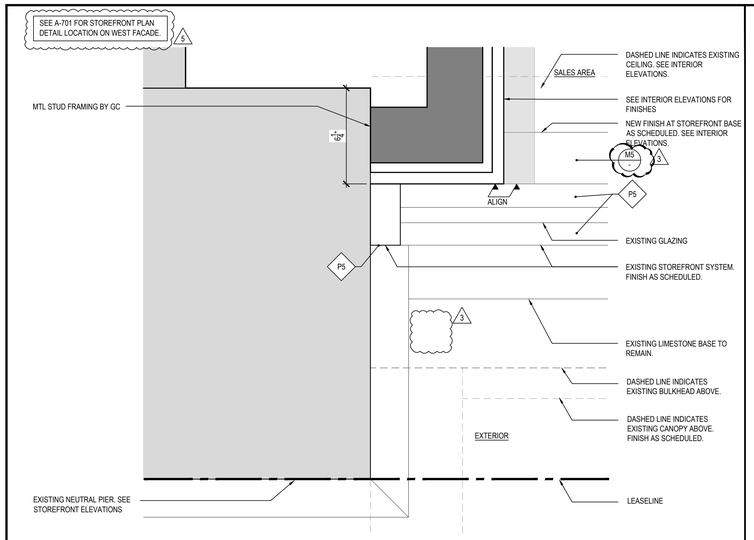


## 1 STOREFRONT PLAN DETAIL - LL NEUTRAL PIER AND EXISTING GLAZING (WEST)

SCALE: 3"=1'-0"

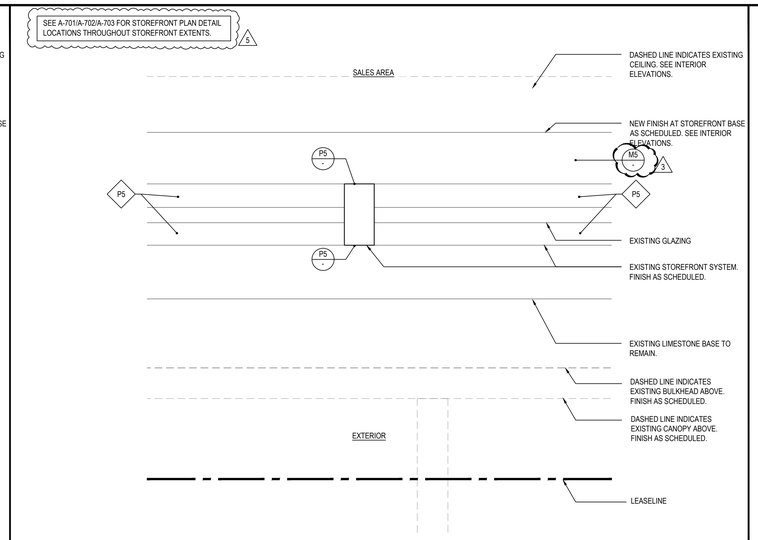


## 2 STOREFRONT PLAN DETAIL - EXISTING GLAZING - TYPICAL

SCALE: 3"=1'-0"

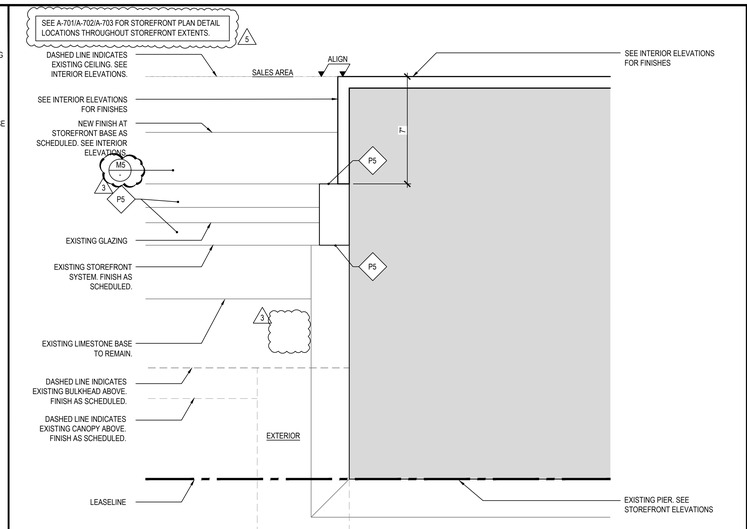


## 3 STOREFRONT PLAN DETAIL - EXISTING GLAZING - TYPICAL

SCALE: 3"=1'-0"

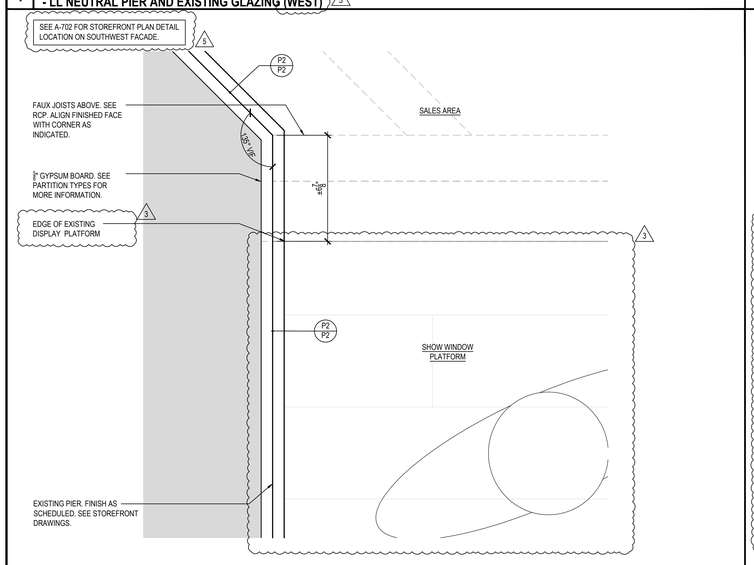


## 4 STOREFRONT PLAN DETAIL - SHOW WINDOW (SOUTHWEST)

SCALE: 3"=1'-0"

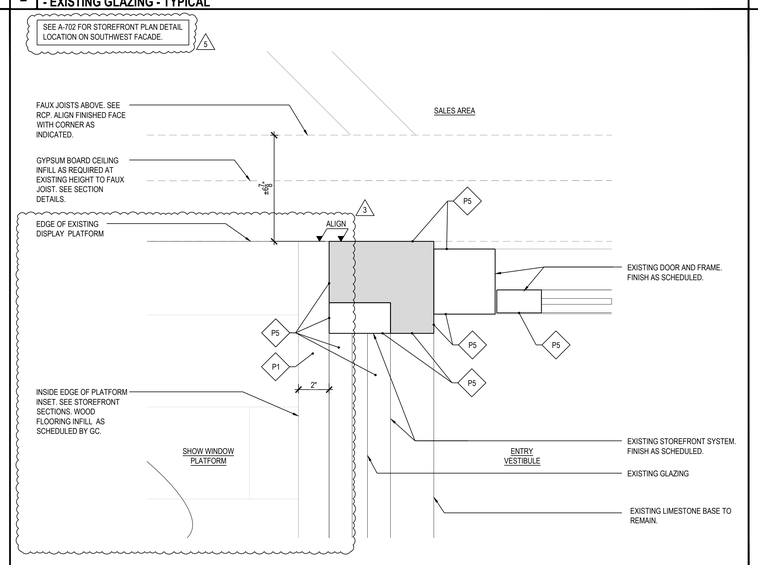


## 5 STOREFRONT PLAN DETAIL - ENTRY (SOUTHWEST)

SCALE: 3"=1'-0"

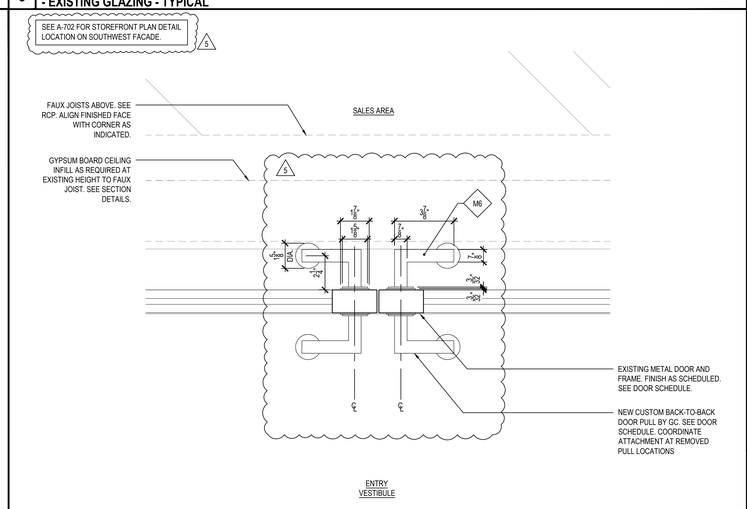


## 6 STOREFRONT PLAN DETAIL - ENTRY (SOUTHWEST)

SCALE: 3"=1'-0"

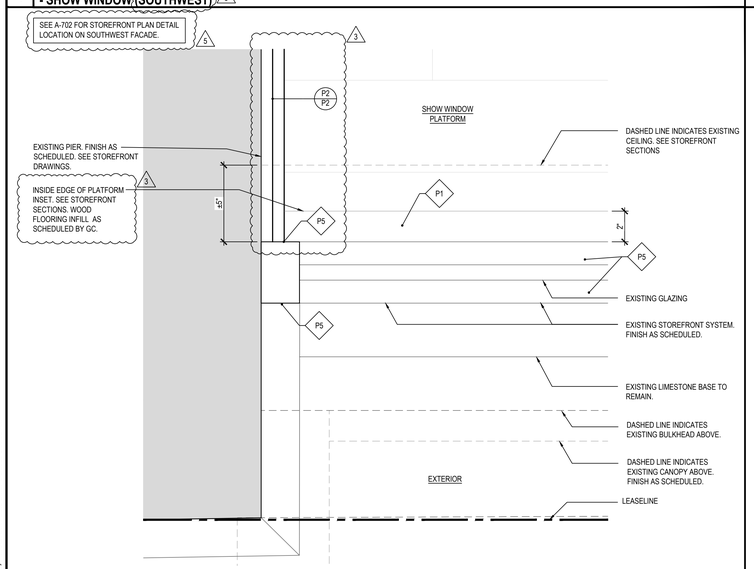


## 7 STOREFRONT PLAN DETAIL - SHOW WINDOW (SOUTHWEST)

SCALE: 3"=1'-0"

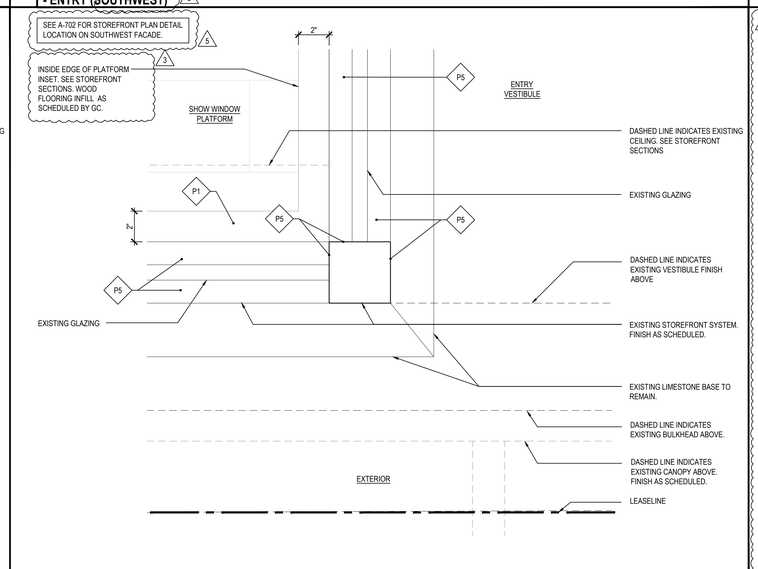


## 8 STOREFRONT PLAN DETAIL - ENTRY VESTIBULE (SOUTHWEST)

SCALE: 3"=1'-0"

## 9 NOT USED

SCALE: 3"=1'-0"

RALPH LAUREN

## SPACE PLAN

RALPH LAUREN
STANFORD SHOPPING CENTER
SPACE 383A

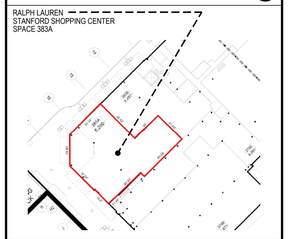

Lam+Tea Engineering

kpff

## SUBMISSION FOR ARCHITECTURAL REVIEW BOARD

| NO. | REVISION | | DATE | BY |
|---|---|---|---|---|
| 9 | A.R.B. CORRECTIONS 2 | 7 | 07.22.2025 | TPG |
| 8 | PERMIT CORRECTIONS 2 | 6 | 07.02.2025 | TPG |
| 7 | A.R.B. CORRECTIONS 1 | 5 | 05.30.2025 | TPG |
| 6 | BOARD OF HEALTH CORRECTIONS | 4 | 04.18.2025 | TPG |
| 5 | LATEST FULL SET UPDATES | 3 | 04.14.2025 | TPG |
| 4 | PERMIT CORRECTIONS 1 | 2 | 05.23.2025 | TPG |
| 3 | BID ADDENDUM 1 | 1 | 03.11.2025 | TPG |
| 2 | ISSUED FOR BID & PERMIT | | 01.10.2025 | TPG |
| 1 | PROGRESS SET FOR CLIENT REVIEW | | 12.13.2024 | TPG |

TPG Architecture

**TPG ARCHITECTURE, LLP**
**31 PENN PLAZA**
**132 WEST 31ST STREET, 5TH FLOOR, NEW YORK, NY 10001**
**212.768.0800 | TPGARCHITECTURE.COM**

IN CONSIDERATION OF RECEIVING DRAWINGS FROM TPG ARCHITECTURE LLP IN AN ELECTRONIC FORM, THE RECIPIENT AGREES, TO THE FULLEST EXTENT PERMITTED BY LAW, TO HOLD HARMLESS AND INDEMNIFY TPG ARCHITECTURE LLP FROM AND AGAINST ALL CLAIMS, LIABILITIES, LOSSES, DAMAGES, AND COSTS, INCLUDING BUT NOT LIMITED TO ATTORNEY'S FEES, ARISING OUT OF, OR IN ANY WAY CONNECTED WITH THE USE, RE-USE, MIS-USE, MODIFICATION, OR MISINTERPRETATION OF THE MACHINE-READABLE INFORMATION PROVIDED BY TPG ARCHITECTURE LLP UNDER THIS AGREEMENT.

PROJECT

**RALPH LAUREN**
**STANFORD SHOPPING CENTER**
180 EL CAMINO REAL #383A, BLDG. M
PALO ALTO, CA 94304

DRAWING

STOREFRONT PLAN DETAILS

SEAL

LICENSED ARCHITECT — EDWARD ROBERT HUGHES — 26476 — RENEWAL DATE 8/31/25 — STATE OF CALIFORNIA

| | |
|---|---|
| DATE | 04/18/2025 |
| PROJECT NO. | 1524879-00 |
| SCALE | 3"=1'-0" |
| DWG NO. | A-720.00 |
| CAD FILE NO. | A-720.00_STOREFRONT PLAN DETAILS.DWG |
| PAGE | 48 of 55 |

K:\241524879.0068_DRAWINGS\2_CAD\2_SHEETS\A-720.00_STOREFRONT PLAN DETAILS.DWG | Plot Date: Jun 2, 2025 - 12:29 PM
Last Saved By: MHAKANI | Save Date: 6/2/2025 6:39:35 AM

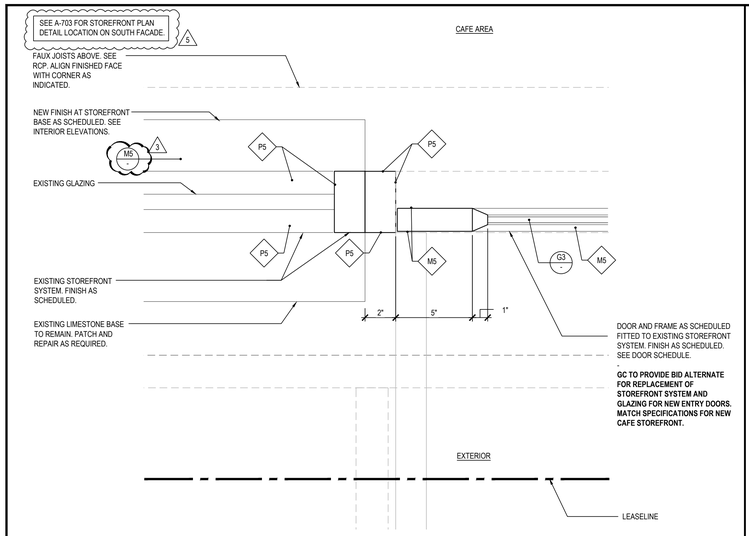


1 **STOREFRONT PLAN DETAIL - CAFE ENTRY (SOUTH)** 5 — SCALE: 3"=1'-0"

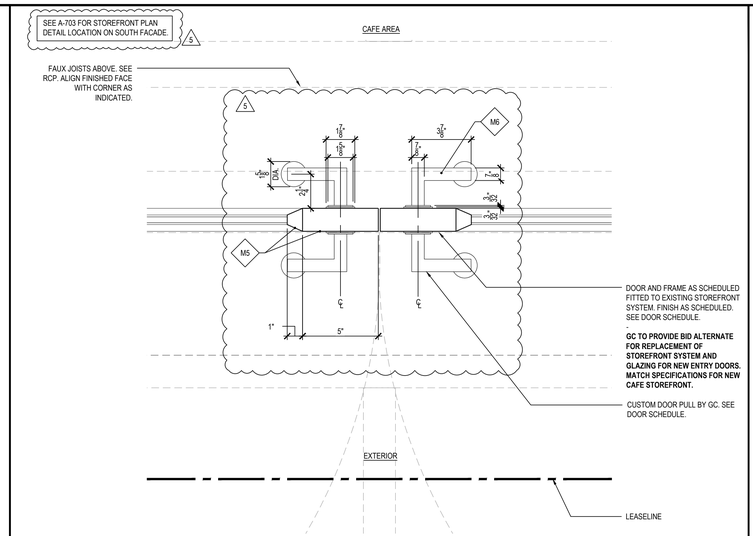


2 **STOREFRONT PLAN DETAIL - CAFE ENTRY (SOUTH)** 5 — SCALE: 3"=1'-0"

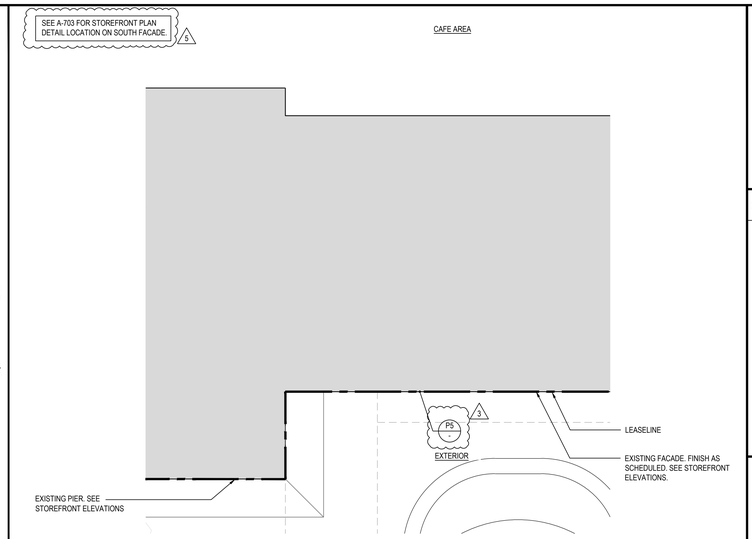


3 **STOREFRONT PLAN DETAIL - SOLID (SOUTH)** 5 — SCALE: 3"=1'-0"

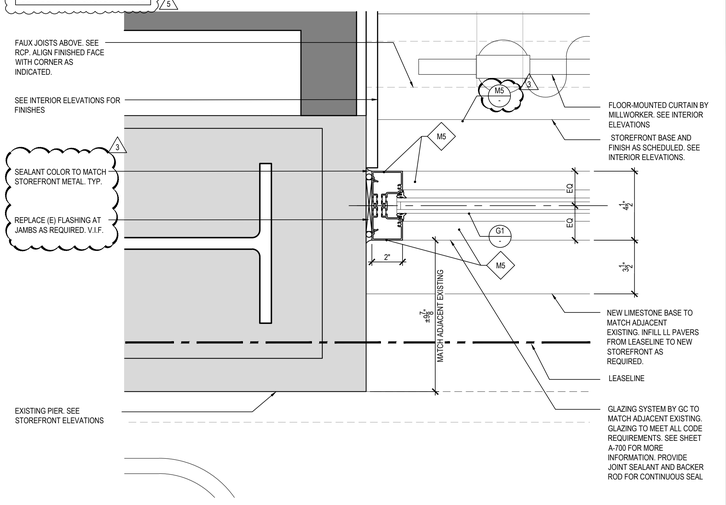


4 **STOREFRONT PLAN DETAIL - NEW CAFE GLAZING (SOUTH)** 4 — SCALE: 3"=1'-0"

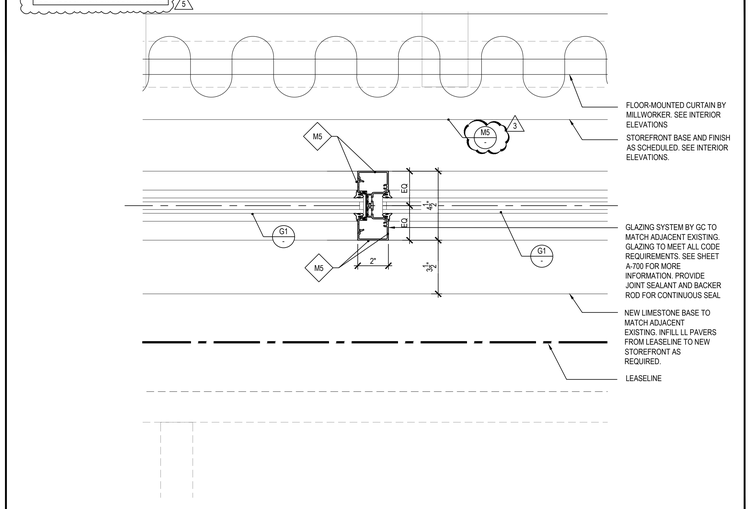


5 **STOREFRONT PLAN DETAIL - NEW CAFE GLAZING (SOUTH)** 4 — SCALE: 3"=1'-0"

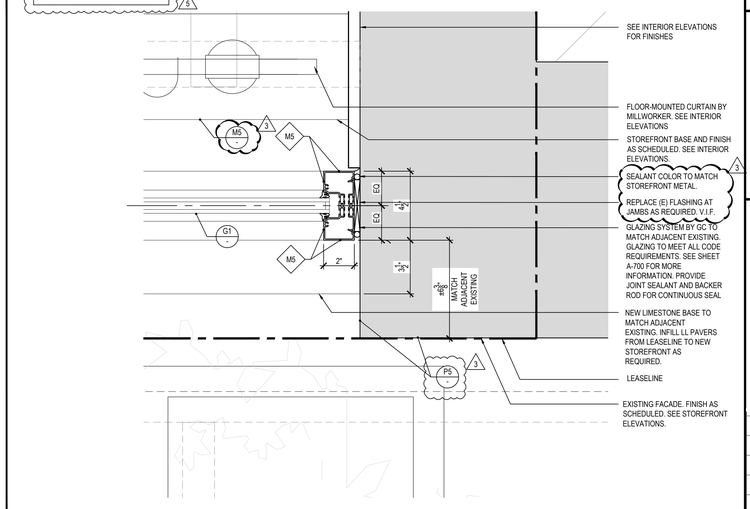


6 **STOREFRONT PLAN DETAIL - NEW CAFE GLAZING AND LL NEUTRAL PIER (SOUTH)** 4 — SCALE: 3"=1'-0"

7 **STOREFRONT PLAN DETAIL - NOT USED** — SCALE: 3"=1'-0"

8 **STOREFRONT PLAN DETAIL - NOT USED** — SCALE: 3"=1'-0"

9 **STOREFRONT PLAN DETAIL - NOT USED** — SCALE: 3"=1'-0"

RALPH LAUREN

## SPACE PLAN

RALPH LAUREN
STANFORD SHOPPING CENTER
SPACE 383A

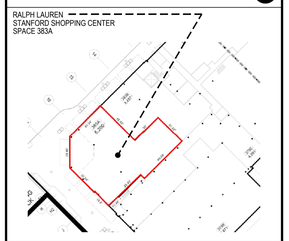

Lam+Tea Engineering

kpff

## SUBMISSION FOR ARCHITECTURAL REVIEW BOARD

| NO. | REVISION | DATE | BY |
|---|---|---|---|
| 9 | A.R.B. CORRECTIONS 2 (7) | 07.22.2025 | TPG |
| 8 | PERMIT CORRECTIONS 2 (6) | 07.02.2025 | TPG |
| 7 | A.R.B. CORRECTIONS 1 (5) | 05.30.2025 | TPG |
| 6 | BOARD OF HEALTH CORRECTIONS (4) | 04.18.2025 | TPG |
| 5 | LATEST FULL SET UPDATES (3) | 04.14.2025 | TPG |
| 4 | PERMIT CORRECTIONS 1 (2) | 05.23.2025 | TPG |
| 3 | BID ADDENDUM 1 (1) | 03.11.2025 | TPG |
| 2 | ISSUED FOR BID & PERMIT | 01.10.2025 | TPG |
| 1 | PROGRESS SET FOR CLIENT REVIEW | 12.13.2024 | TPG |

TPG Architecture

**TPG ARCHITECTURE, LLP**
**31 PENN PLAZA**
**132 WEST 31ST STREET, 5TH FLOOR, NEW YORK, NY 10001**
**212.768.0800 | TPGARCHITECTURE.COM**

IN CONSIDERATION OF RECEIVING DRAWINGS FROM TPG ARCHITECTURE LLP IN AN ELECTRONIC FORM, THE RECIPIENT AGREES, TO THE FULLEST EXTENT PERMITTED BY LAW, TO HOLD HARMLESS AND INDEMNIFY TPG ARCHITECTURE LLP FROM AND AGAINST ALL CLAIMS, LIABILITIES, LOSSES, DAMAGES, AND COSTS, INCLUDING BUT NOT LIMITED TO ATTORNEYS FEES, ARISING OUT OF, OR IN ANY WAY CONNECTED WITH THE USE, RE-USE, MIS-USE, MODIFICATION, OR MISINTERPRETATION OF THE MACHINE-READABLE INFORMATION PROVIDED BY TPG ARCHITECTURE LLP UNDER THIS AGREEMENT.

PROJECT
**RALPH LAUREN**
**STANFORD SHOPPING CENTER**
180 EL CAMINO REAL #383A, BLDG. M
PALO ALTO, CA 94304

DRAWING
STOREFRONT PLAN DETAILS

SEAL

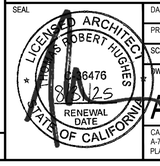


| | |
|---|---|
| DATE | 04/18/2025 |
| PROJECT NO. | 1524879-00 |
| SCALE | 3"=1'-0" |
| DWG NO. | A-721.00 |
| CAD FILE NO. | A-720.00_STOREFRONT PLAN DETAILS.DWG |
| PAGE | 49 of 55 |

K:\24\1524879.0000_DRAWINGS\2_CAPD_SHEETS\A-720.00_STOREFRONT PLAN DETAILS.DWG | Plot Date: Jun. 2 2025 - 12:26 PM
Last Saved By: MHAMANN | Save Date: 6/2/2025 6:39:31 AM

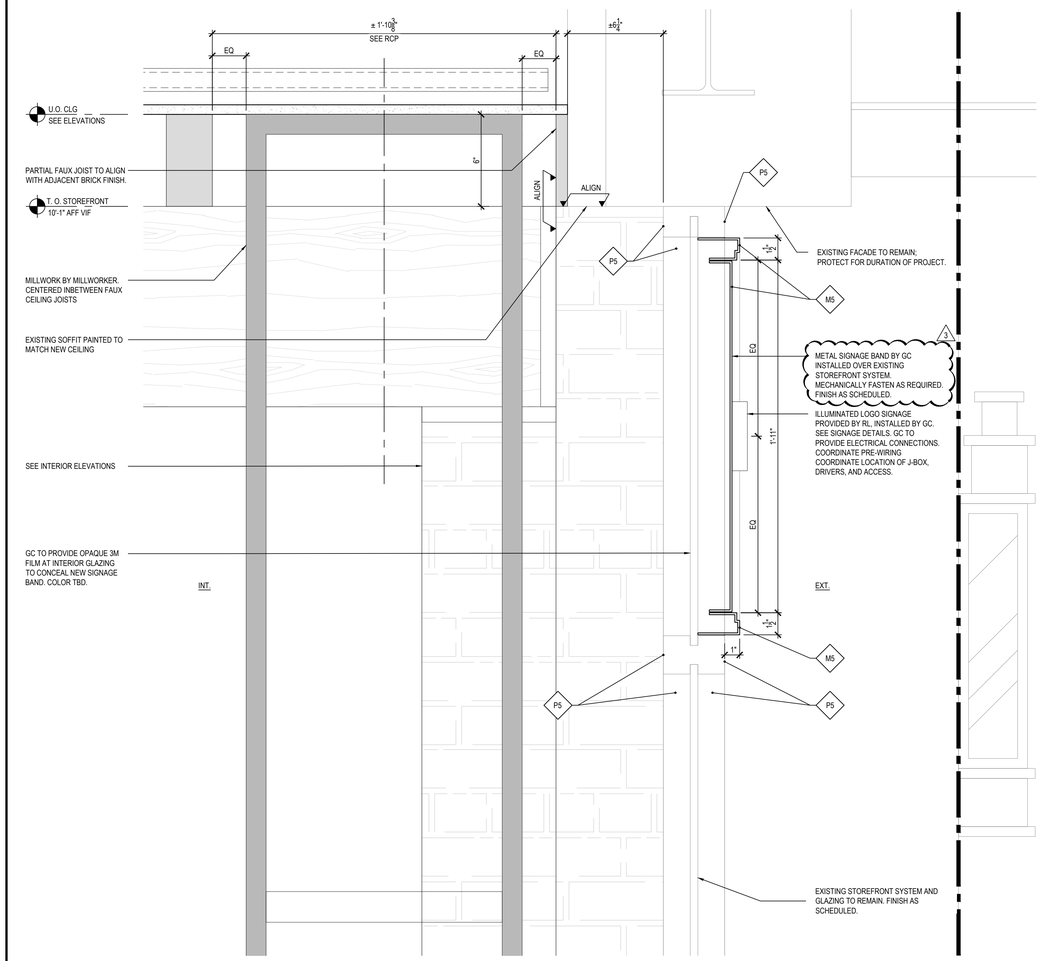


1 STOREFRONT HEAD SECTION DETAIL - TYPICAL SALES AREA (WEST) SCALE: 3"=1'-0"

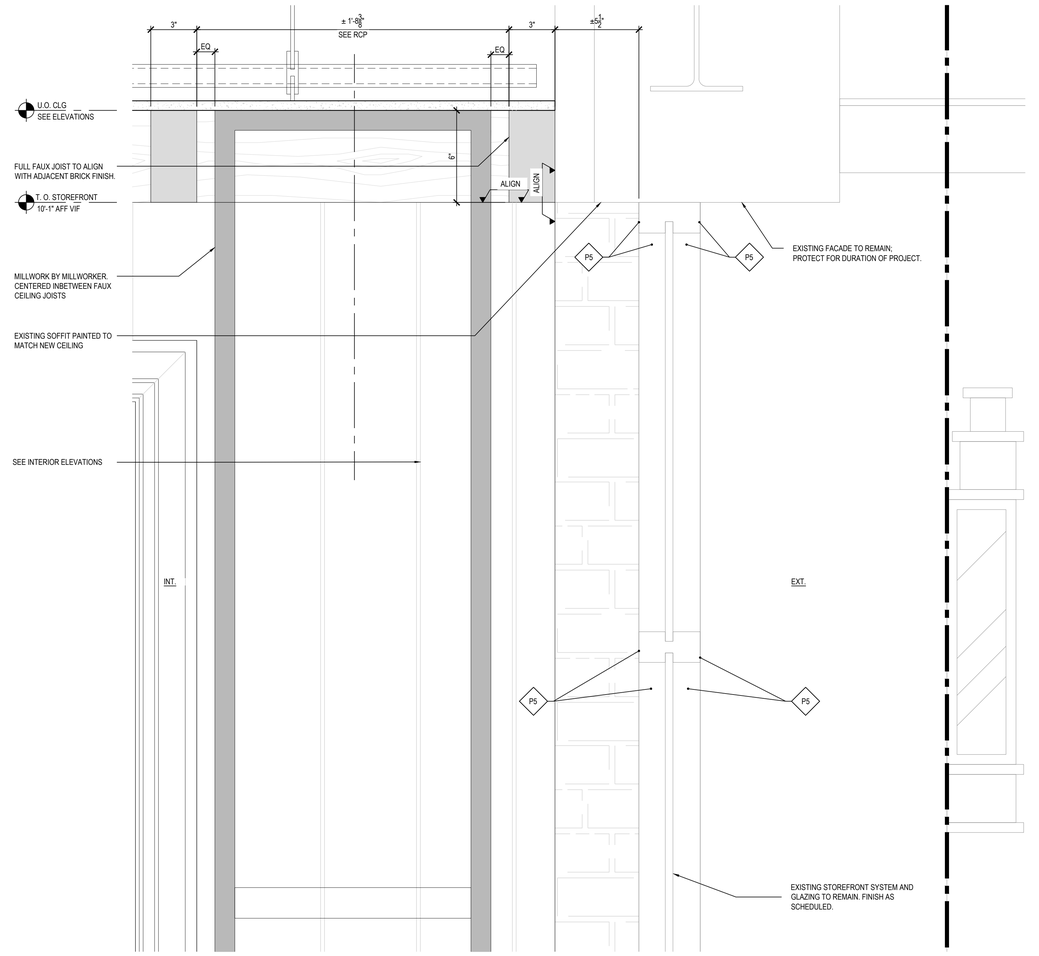


2 STOREFRONT HEAD SECTION DETAIL - TYPICAL SALES AREA (SOUTH) SCALE: 3"=1'-0"

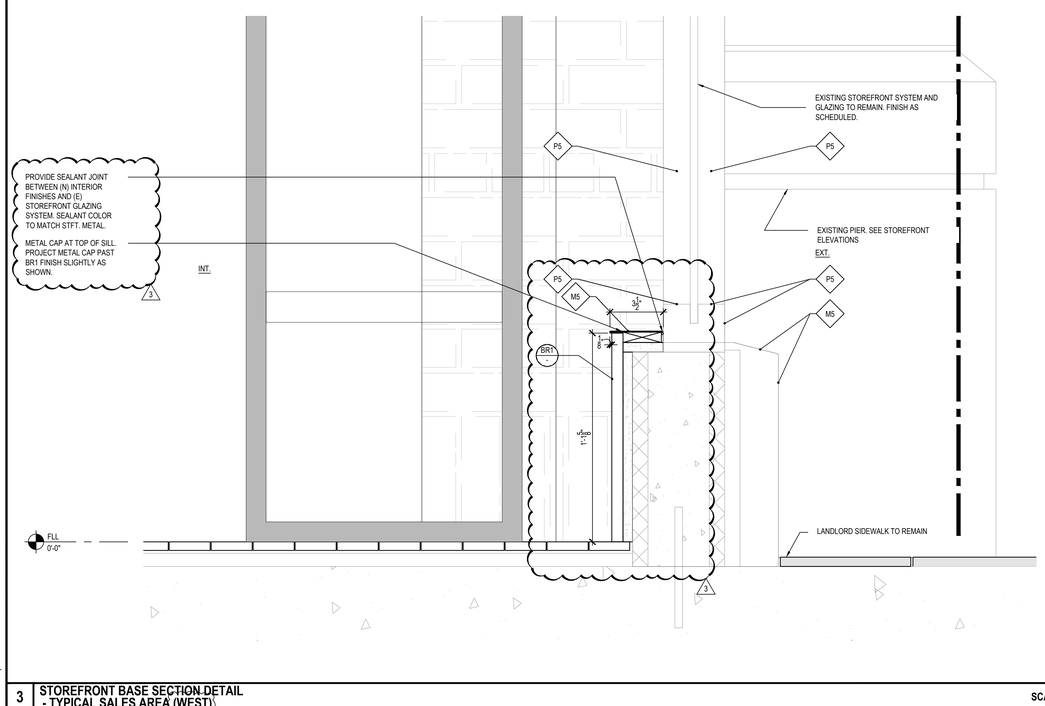


3 STOREFRONT BASE SECTION DETAIL - TYPICAL SALES AREA (WEST) SCALE: 3"=1'-0"

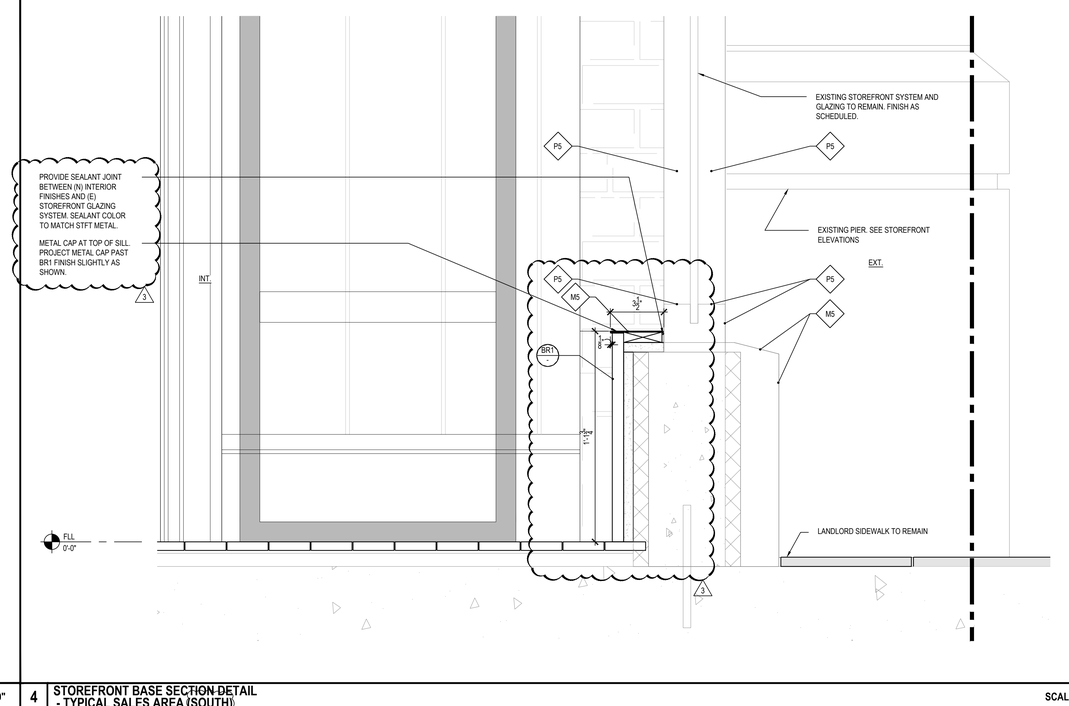


4 STOREFRONT BASE SECTION DETAIL - TYPICAL SALES AREA (SOUTH) SCALE: 3"=1'-0"

K:\241524PA-0008_DRAWINGS_CADD_SHEETS\A-722.00_STOREFRONT SECTION DETAILS.DWG / Plot Date: Jun. 2, 2025 - 12:27 PM
Last Saved By: MHAHANN / Save Date: 6/2/2025 11:41:05 AM

RALPH LAUREN

## SPACE PLAN

RALPH LAUREN
STANFORD SHOPPING CENTER
SPACE 383A

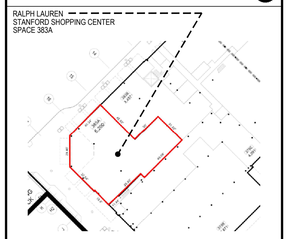

Lam+Tea Engineering

kpff

## SUBMISSION FOR ARCHITECTURAL REVIEW BOARD

| NO. | REVISION | | DATE | BY |
|---|---|---|---|---|
| 9 | A.R.B. CORRECTIONS 2 | 7 | 07.22.2025 | TPG |
| 8 | PERMIT CORRECTIONS 2 | 6 | 07.02.2025 | TPG |
| 7 | A.R.B. CORRECTIONS 1 | 5 | 05.30.2025 | TPG |
| 6 | BOARD OF HEALTH CORRECTIONS | 4 | 04.18.2025 | TPG |
| 5 | LATEST FULL SET UPDATES | 3 | 04.14.2025 | TPG |
| 4 | PERMIT CORRECTIONS 1 | 2 | 05.23.2025 | TPG |
| 3 | BID ADDENDUM 1 | 1 | 03.11.2025 | TPG |
| 2 | ISSUED FOR BID & PERMIT | | 01.10.2025 | TPG |
| 1 | PROGRESS SET FOR CLIENT REVIEW | | 12.13.2024 | TPG |

TPG Architecture

**TPG ARCHITECTURE, LLP**
**31 PENN PLAZA**
**132 WEST 31ST STREET, 5TH FLOOR, NEW YORK, NY 10001**
**212.768.0800 | TPGARCHITECTURE.COM**

IN CONSIDERATION OF RECEIVING DRAWINGS FROM TPG ARCHITECTURE LLP IN AN ELECTRONIC FORM, THE RECIPIENT AGREES, TO THE FULLEST EXTENT PERMITTED BY LAW, TO HOLD HARMLESS AND INDEMNIFY TPG ARCHITECTURE LLP FROM AND AGAINST ALL CLAIMS, LIABILITIES, LOSSES, DAMAGES, AND COSTS, INCLUDING BUT NOT LIMITED TO ATTORNEY'S FEES, ARISING OUT OF, OR IN ANY WAY CONNECTED WITH THE USE, RE-USE, MIS-USE, MODIFICATION, OR MISINTERPRETATION OF THE MACHINE-READABLE INFORMATION PROVIDED BY TPG ARCHITECTURE LLP UNDER THIS AGREEMENT.

PROJECT
**RALPH LAUREN**
**STANFORD SHOPPING CENTER**
180 EL CAMINO REAL #383A, BLDG. M
PALO ALTO, CA 94304

DRAWING
STOREFRONT SECTION DETAILS

SEAL

LICENSED ARCHITECT * THOMAS ROBERT HUGHES * 26476 * 08.31.25 RENEWAL DATE * STATE OF CALIFORNIA

| | |
|---|---|
| DATE | 04/18/2025 |
| PROJECT NO. | 1524879-00 |
| SCALE | 3"=1'-0" |
| DWG NO. | A-722.00_STOREFRONT SECTION DETAILS.DWG |
| | A-722.00 |
| CAD FILE NO. | |
| PAGE | 41 of 66 of 66 |

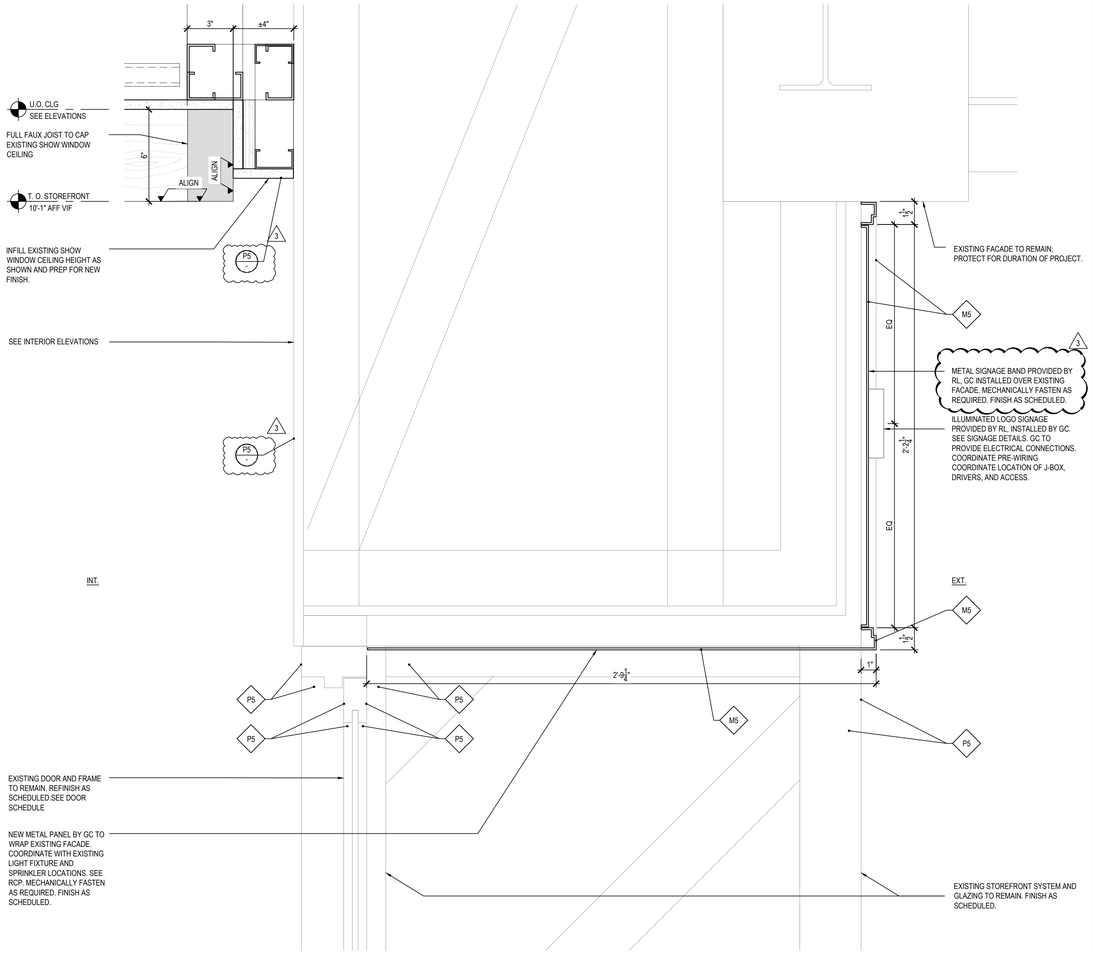


1 **STOREFRONT HEAD SECTION DETAIL - RETAIL ENTRANCE (SOUTHWEST)** SCALE: 3"=1'-0"

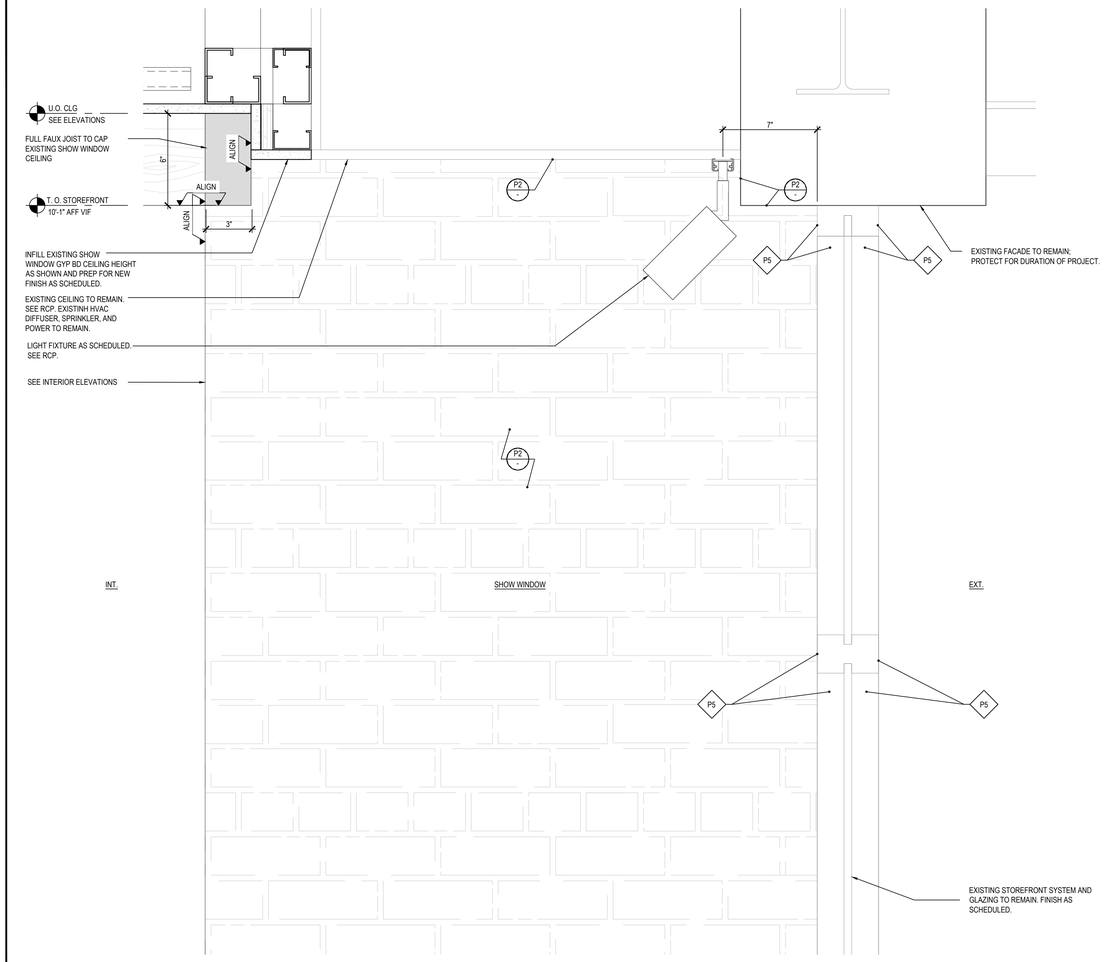


2 **STOREFRONT HEAD SECTION DETAIL - DISPLAY PLATFORM (SOUTHWEST)** SCALE: 3"=1'-0"

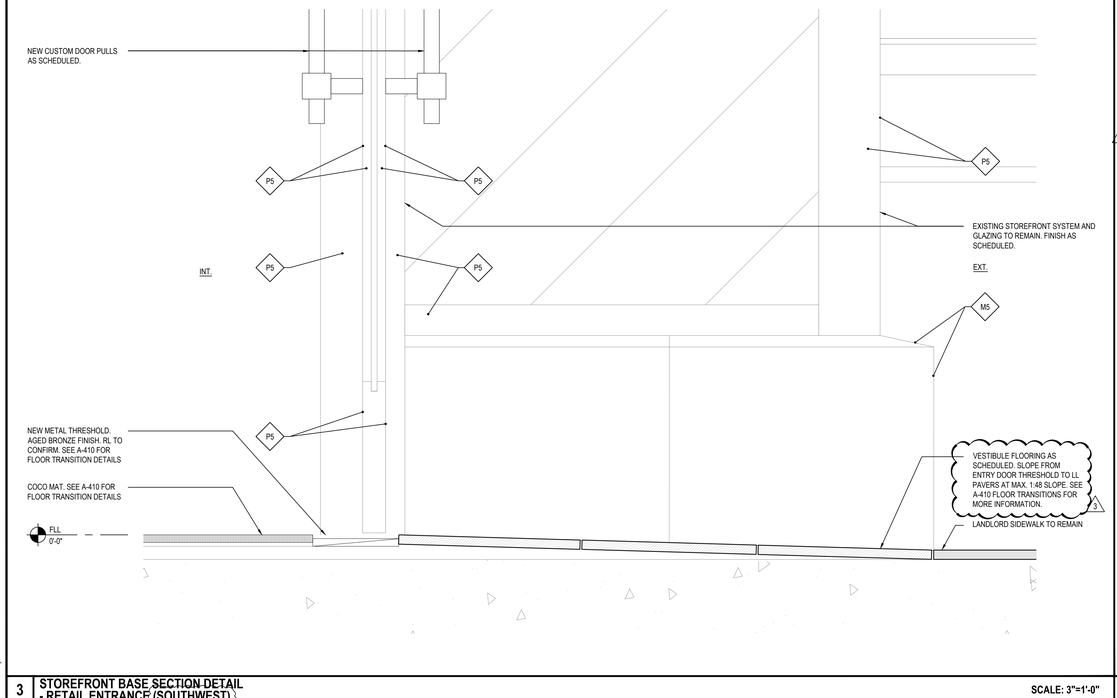


3 **STOREFRONT BASE SECTION DETAIL - RETAIL ENTRANCE (SOUTHWEST)** SCALE: 3"=1'-0"

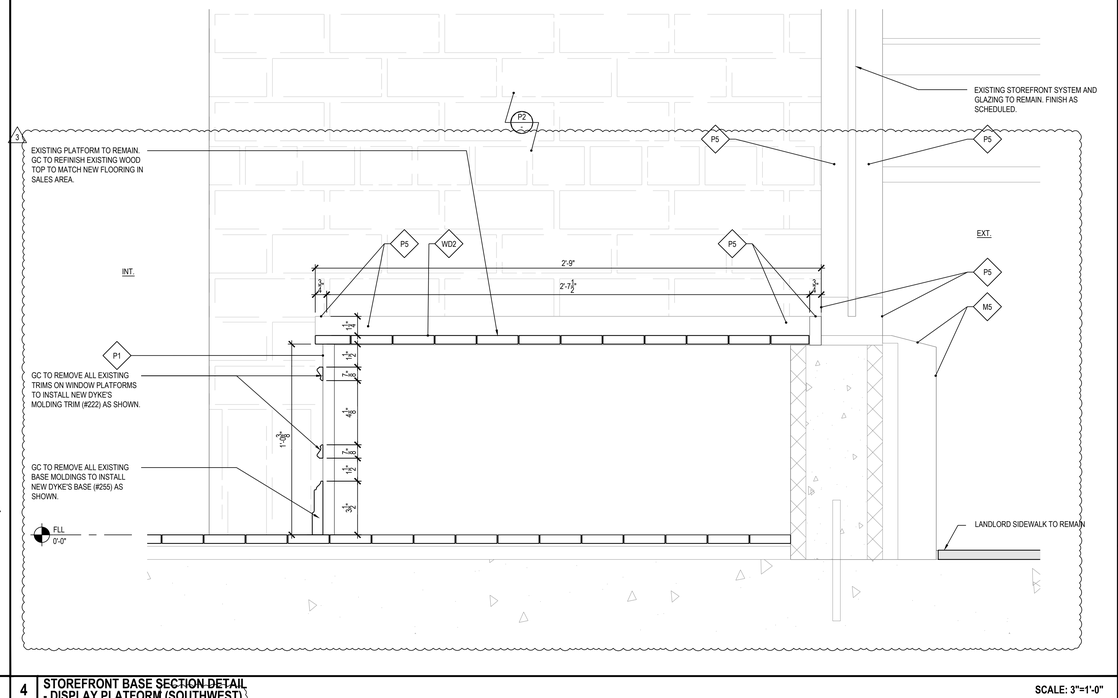


4 **STOREFRONT BASE SECTION DETAIL - DISPLAY PLATFORM (SOUTHWEST)** SCALE: 3"=1'-0"

K:\24\1524879.0008_DRAWINGS_CAD\2_SHEETS\A-723.00_STOREFRONT SECTION DETAILS.DWG | Plot Date: Jun. 2, 2025 - 12:27 PM
Last Saved By: MHAMANI | Save Date: 6/2/2025 11:41:06 AM

RALPH LAUREN

## SPACE PLAN

RALPH LAUREN
STANFORD SHOPPING CENTER
SPACE 383A

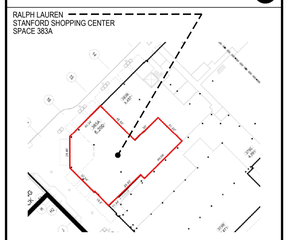

Lam+Tea Engineering

kpff

## SUBMISSION FOR ARCHITECTURAL REVIEW BOARD

| NO. | REVISION | | DATE | BY |
|---|---|---|---|---|
| 9 | A.R.B. CORRECTIONS 2 | 7 | 07.22.2025 | TPG |
| 8 | PERMIT CORRECTIONS 2 | 6 | 07.02.2025 | TPG |
| 7 | A.R.B. CORRECTIONS 1 | 5 | 05.30.2025 | TPG |
| 6 | BOARD OF HEALTH CORRECTIONS | 4 | 04.18.2025 | TPG |
| 5 | LATEST FULL SET UPDATES | 3 | 04.14.2025 | TPG |
| 4 | PERMIT CORRECTIONS 1 | 2 | 05.23.2025 | TPG |
| 3 | BID ADDENDUM 1 | 1 | 03.11.2025 | TPG |
| 2 | ISSUED FOR BID & PERMIT | | 01.10.2025 | TPG |
| 1 | PROGRESS SET FOR CLIENT REVIEW | | 12.13.2024 | TPG |

TPG Architecture

**TPG ARCHITECTURE, LLP**
**31 PENN PLAZA**
**132 WEST 31ST STREET, 5TH FLOOR, NEW YORK, NY 10001**
**212.768.0800 | TPGARCHITECTURE.COM**

IN CONSIDERATION OF RECEIVING DRAWINGS FROM TPG ARCHITECTURE LLP IN AN ELECTRONIC FORM, THE RECIPIENT AGREES, TO THE FULLEST EXTENT PERMITTED BY LAW, TO HOLD HARMLESS AND INDEMNIFY TPG ARCHITECTURE LLP FROM AND AGAINST ALL CLAIMS, LIABILITIES, LOSSES, DAMAGES, AND COSTS, INCLUDING BUT NOT LIMITED TO ATTORNEY'S FEES, ARISING OUT OF, OR IN ANY WAY CONNECTED WITH THE USE, RE-USE, MIS-USE, MODIFICATION, OR MISINTERPRETATION OF THE MACHINE-READABLE INFORMATION PROVIDED BY TPG ARCHITECTURE LLP UNDER THIS AGREEMENT.

PROJECT
**RALPH LAUREN**
**STANFORD SHOPPING CENTER**
180 EL CAMINO REAL #383A, BLDG. M
PALO ALTO, CA 94304

DRAWING
STOREFRONT SECTION DETAILS

SEAL

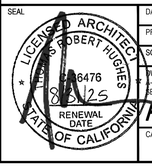


| | |
|---|---|
| DATE | 04/18/2025 |
| PROJECT NO. | 1524879-00 |
| SCALE | 3"=1'-0" |
| DWG NO. | A-723.00_STOREFRONT SECTION DETAILS.DWG |
| CAD FILE NO. | |
| | A-723.00 |
| PAGE | 41 of 66 |

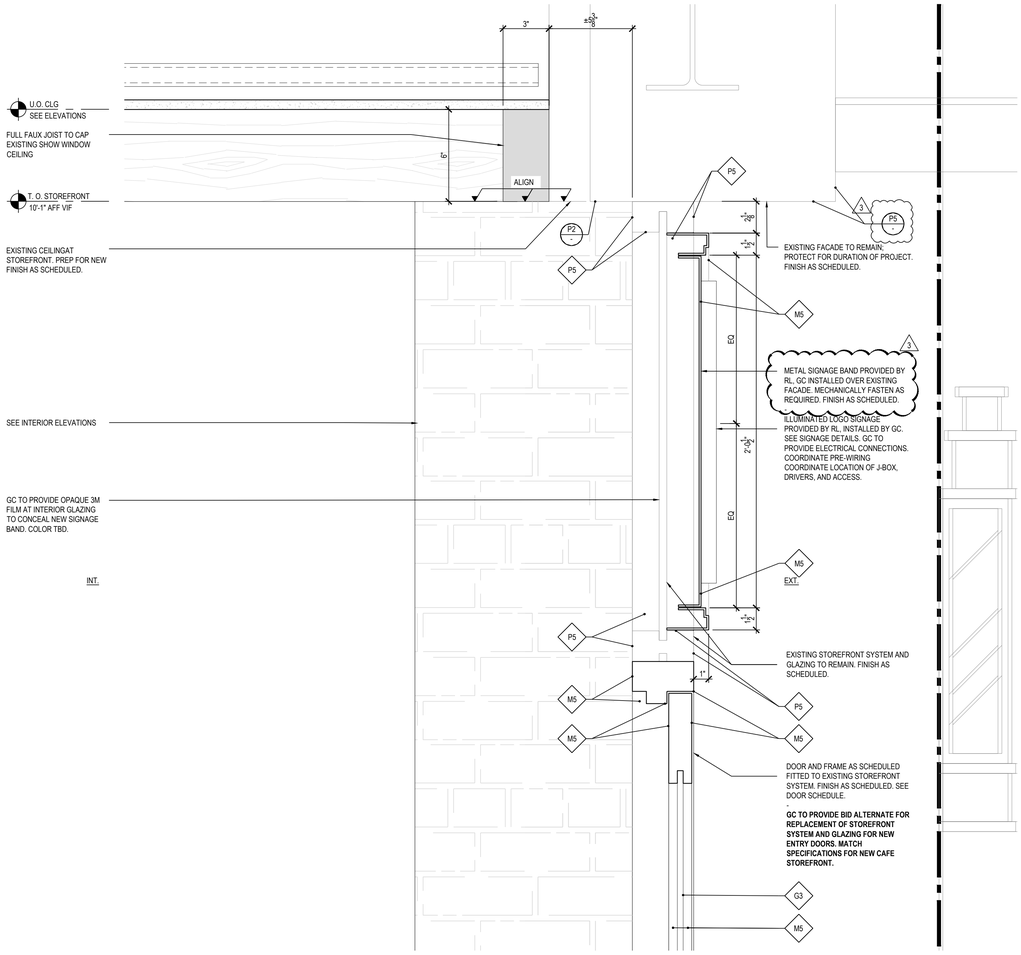


1 **STOREFRONT HEAD SECTION DETAIL - CAFE ENTRANCE (SOUTH)** 5

SCALE: 3"=1'-0"

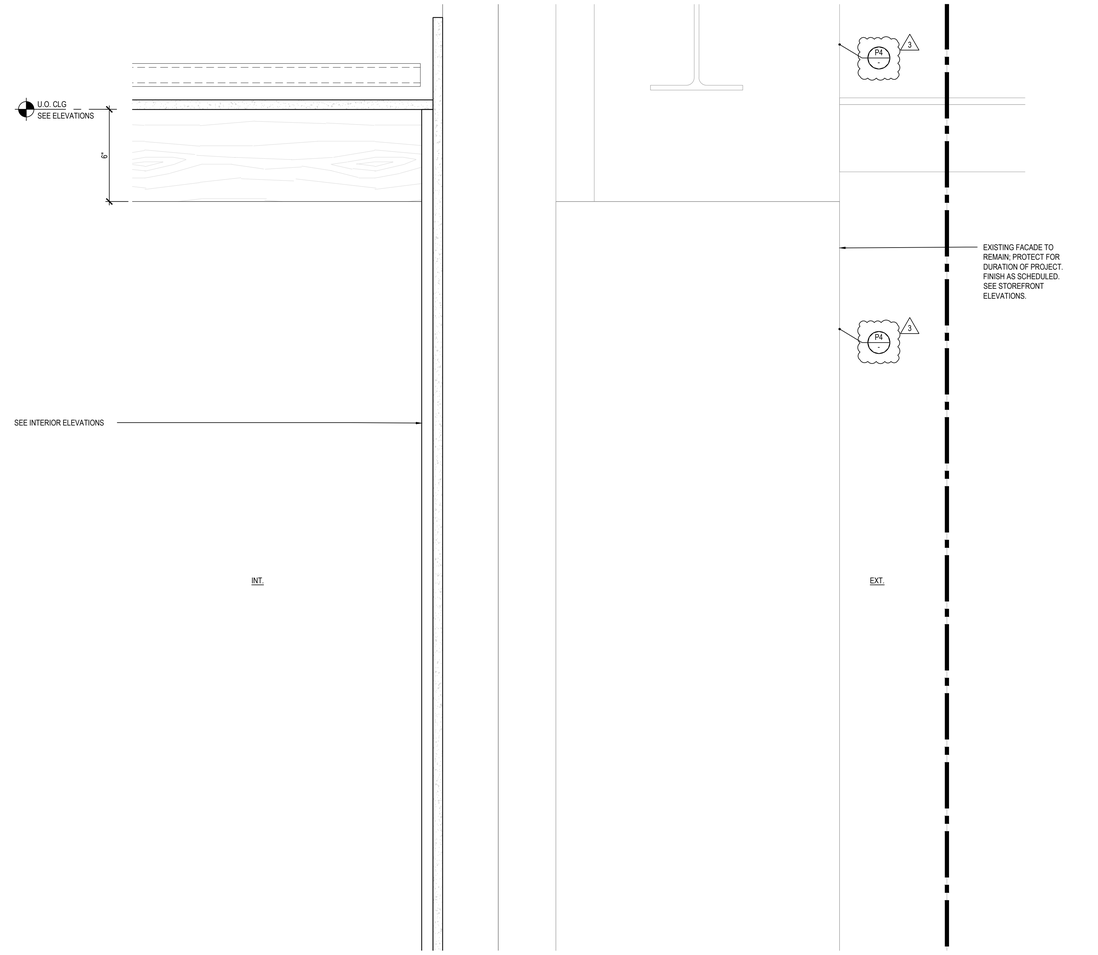


2 **STOREFRONT HEAD SECTION DETAIL - CAFE (SOUTH)** 5

SCALE: 3"=1'-0"

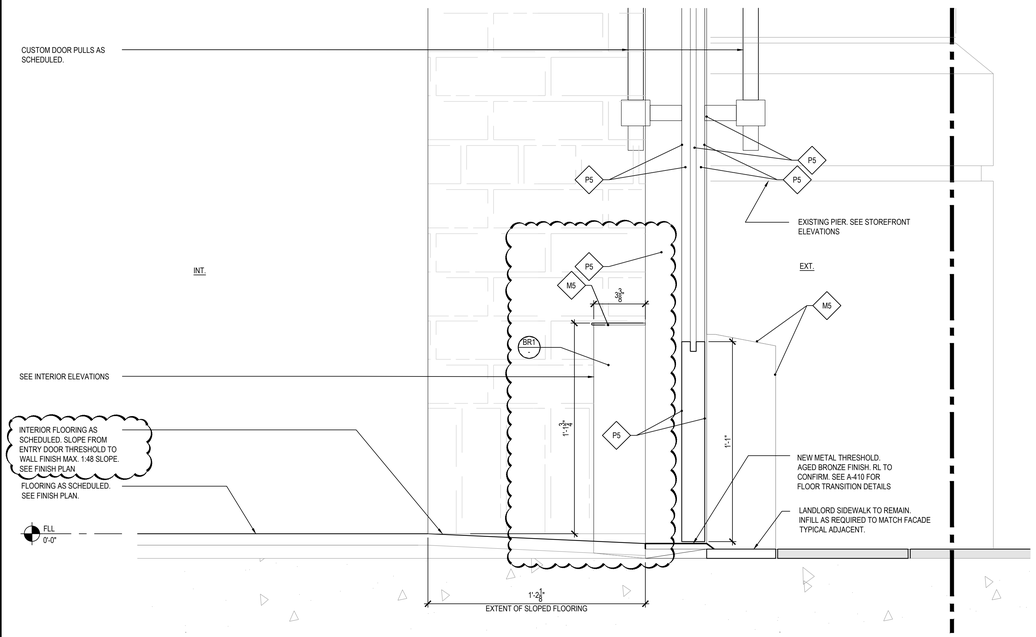


3 **STOREFRONT BASE SECTION DETAIL - CAFE ENTRANCE (SOUTH)** 5

SCALE: 3"=1'-0"

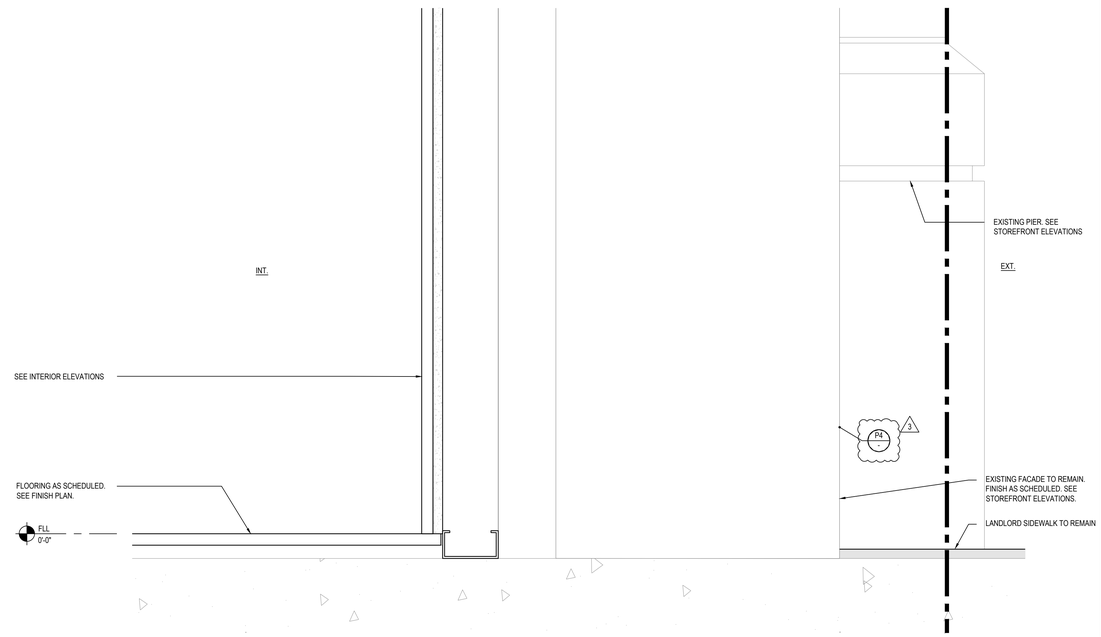


4 **STOREFRONT BASE SECTION DETAIL - CAFE (SOUTH)** 5

SCALE: 3"=1'-0"

K:\24\1524879-00\8_DRAWINGS\2_CAD\3_SHEETS\A-722.00_STOREFRONT SECTION DETAILS.DWG | Plot Date: Jun. 2, 2025 - 12:29 PM
Last Saved By: MHAMANN | Save Date: 6/2/2025 11:41:05 AM

RALPH LAUREN

## SPACE PLAN

RALPH LAUREN
STANFORD SHOPPING CENTER
SPACE 383A

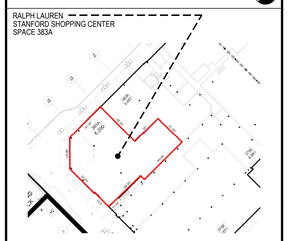

Lam+Tea Engineering

kpff

## SUBMISSION FOR ARCHITECTURAL REVIEW BOARD

| NO. | REVISION | DATE | BY |
|---|---|---|---|
| 9 | A.R.B. CORRECTIONS 2 (7) | 07.22.2025 | TPG |
| 8 | PERMIT CORRECTIONS 2 (6) | 07.02.2025 | TPG |
| 7 | A.R.B. CORRECTIONS 1 (5) | 05.30.2025 | TPG |
| 6 | BOARD OF HEALTH CORRECTIONS (4) | 04.18.2025 | TPG |
| 5 | LATEST FULL SET UPDATES (3) | 04.14.2025 | TPG |
| 4 | PERMIT CORRECTIONS 1 (2) | 05.23.2025 | TPG |
| 3 | BID ADDENDUM 1 (1) | 03.11.2025 | TPG |
| 2 | ISSUED FOR BID & PERMIT | 01.10.2025 | TPG |
| 1 | PROGRESS SET FOR CLIENT REVIEW | 12.13.2024 | TPG |

TPG Architecture


**TPG ARCHITECTURE, LLP**
**31 PENN PLAZA**
**132 WEST 31ST STREET, 5TH FLOOR, NEW YORK, NY 10001**
**212.768.0800 | TPGARCHITECTURE.COM**



IN CONSIDERATION OF RECEIVING DRAWINGS FROM TPG ARCHITECTURE LLP IN AN ELECTRONIC FORM, THE RECIPIENT AGREES, TO THE FULLEST EXTENT PERMITTED BY LAW, TO HOLD HARMLESS AND INDEMNIFY TPG ARCHITECTURE LLP FROM AND AGAINST ALL CLAIMS, LIABILITIES, LOSSES, DAMAGES, AND COSTS, INCLUDING BUT NOT LIMITED TO ATTORNEY'S FEES, ARISING OUT OF, OR IN ANY WAY CONNECTED WITH THE USE, RE-USE, MIS-USE, MODIFICATION, OR MISINTERPRETATION OF THE MACHINE-READABLE INFORMATION PROVIDED BY TPG ARCHITECTURE LLP UNDER THIS AGREEMENT.


PROJECT
**RALPH LAUREN**
**STANFORD SHOPPING CENTER**
180 EL CAMINO REAL #383A, BLDG. M
PALO ALTO, CA 94304

DRAWING
STOREFRONT SECTION DETAILS

SEAL

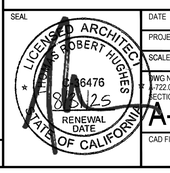


| | |
|---|---|
| DATE | 04/18/2025 |
| PROJECT NO. | 1524879-00 |
| SCALE | 3"=1'-0" |
| DWG NO. | A-724.00_STOREFRONT SECTION DETAILS.DWG |
| CAD FILE NO. | |
| PAGE | 41 of 66 |

A-724.00

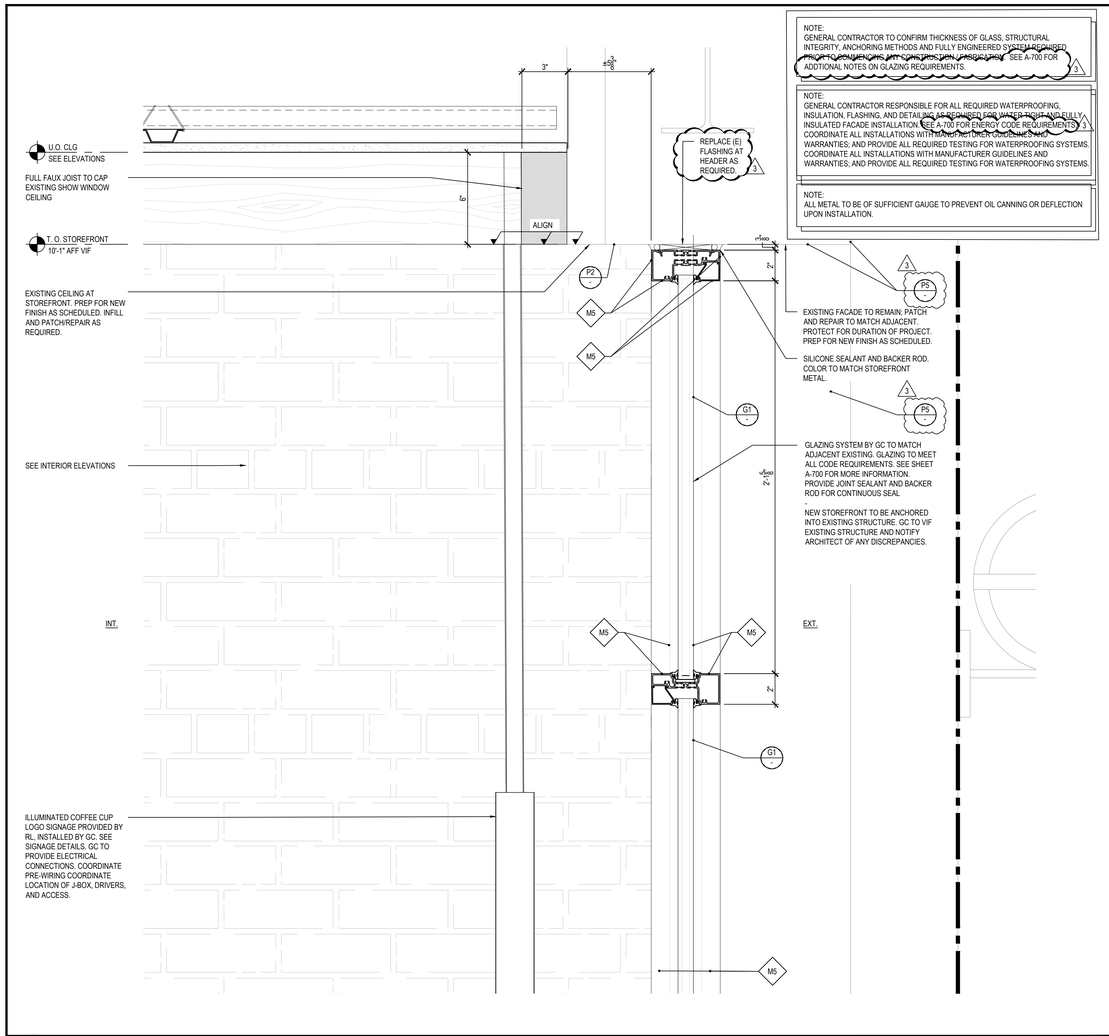


**1 STOREFRONT HEAD SECTION DETAIL - CAFE (SOUTH)** — SCALE: 3"=1'-0"

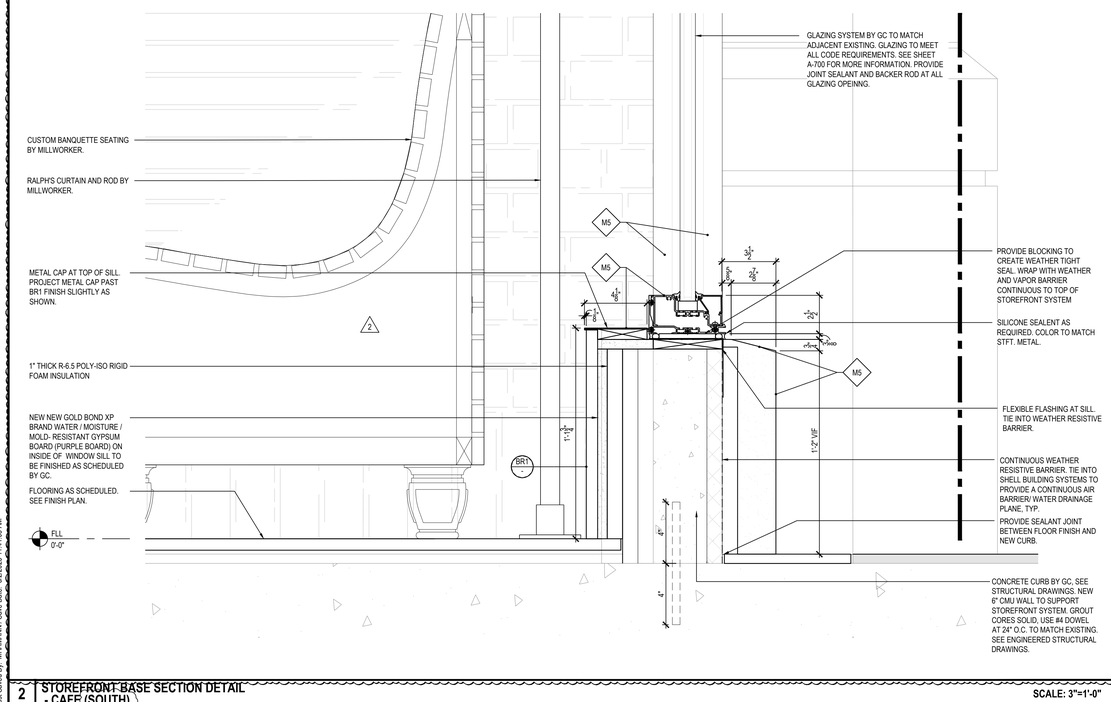


**2 STOREFRONT BASE SECTION DETAIL - CAFE (SOUTH)** — SCALE: 3"=1'-0"

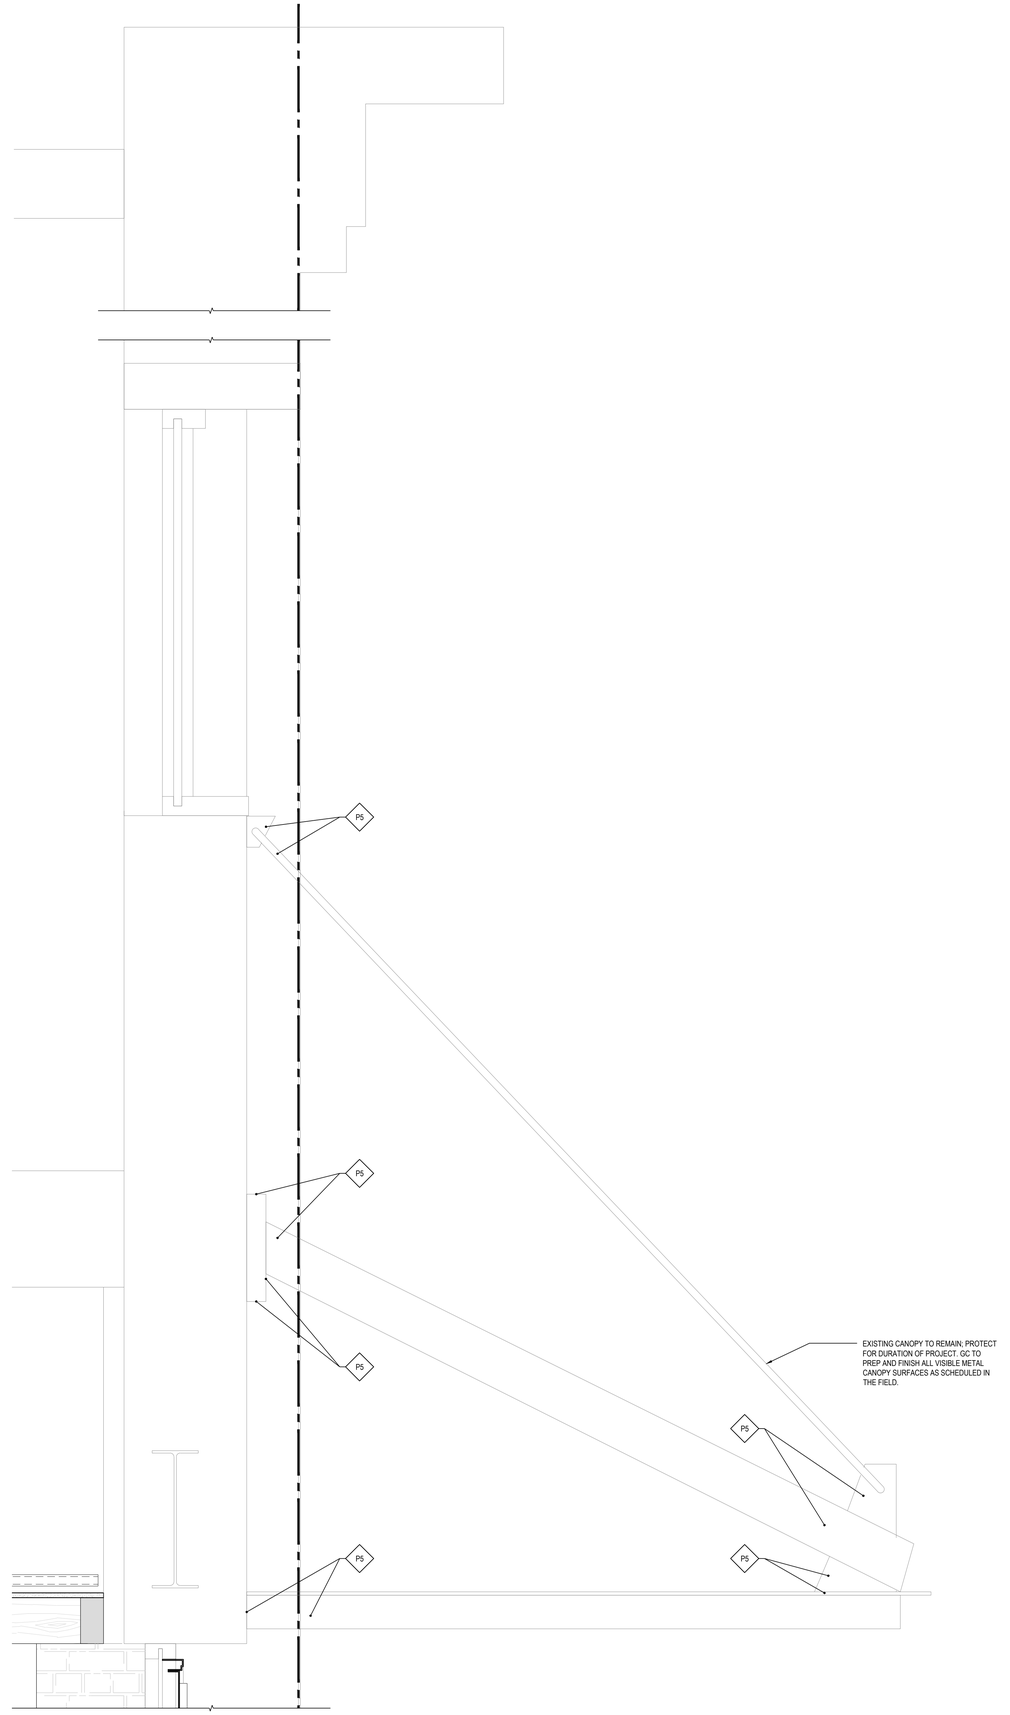


**3 STOREFRONT BASE SECTION DETAIL - TYPICAL EXISTING AWNING** — SCALE: 1 1/2"=1'-0"

RALPH LAUREN

## SPACE PLAN

RALPH LAUREN
STANFORD SHOPPING CENTER
SPACE 383A

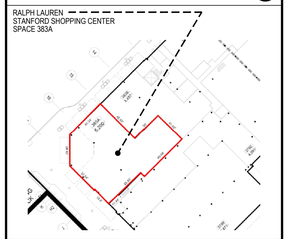

Lam+Tea Engineering

kpff

**SUBMISSION FOR ARCHITECTURAL REVIEW BOARD**

| NO. | REVISION | | DATE | BY |
|---|---|---|---|---|
| 9 | A.R.B. CORRECTIONS 2 | 7 | 07.22.2025 | TPG |
| 8 | PERMIT CORRECTIONS 2 | 6 | 07.02.2025 | TPG |
| 7 | A.R.B. CORRECTIONS 1 | 5 | 05.30.2025 | TPG |
| 6 | BOARD OF HEALTH CORRECTIONS | 4 | 04.18.2025 | TPG |
| 5 | LATEST FULL SET UPDATES | 3 | 04.14.2025 | TPG |
| 4 | PERMIT CORRECTIONS 1 | 2 | 05.23.2025 | TPG |
| 3 | BID ADDENDUM 1 | 1 | 03.11.2025 | TPG |
| 2 | ISSUED FOR BID & PERMIT | | 01.10.2025 | TPG |
| 1 | PROGRESS SET FOR CLIENT REVIEW | | 12.13.2024 | TPG |

TPG Architecture

**TPG ARCHITECTURE, LLP**
**31 PENN PLAZA**
**132 WEST 31ST STREET, 5TH FLOOR, NEW YORK, NY 10001**
**212.768.0800 | TPGARCHITECTURE.COM**

IN CONSIDERATION OF RECEIVING DRAWINGS FROM TPG ARCHITECTURE LLP IN AN ELECTRONIC FORM, THE RECIPIENT AGREES, TO THE FULLEST EXTENT PERMITTED BY LAW, TO HOLD HARMLESS AND INDEMNIFY TPG ARCHITECTURE LLP FROM AND AGAINST ALL CLAIMS, LIABILITIES, LOSSES, DAMAGES, AND COSTS, INCLUDING BUT NOT LIMITED TO ATTORNEY'S FEES, ARISING OUT OF, OR IN ANY WAY CONNECTED WITH THE USE, RE-USE, MIS-USE, MODIFICATION, OR MISINTERPRETATION OF THE MACHINE-READABLE INFORMATION PROVIDED BY TPG ARCHITECTURE LLP UNDER THIS AGREEMENT.

PROJECT
**RALPH LAUREN**
**STANFORD SHOPPING CENTER**
180 EL CAMINO REAL #383A, BLDG. M
PALO ALTO, CA 94304

DRAWING
STOREFRONT SECTION DETAILS

SEAL

LICENSED ARCHITECT ROBERT HUGHES 26476 RENEWAL DATE 8/31/25 STATE OF CALIFORNIA

| | |
|---|---|
| DATE | 04/18/2025 |
| PROJECT NO. | 1524879-00 |
| SCALE | 3"=1'-0" |
| DWG NO. | A-722.00_STOREFRONT SECTION DETAILS.DWG |
| CAD FILE NO. | |
| PAGE | 41 of 66 |

A-725.00

K:\0\1524879-00\08_DRAWINGS\2_CAD\3_SHEETS\A-722.00_STOREFRONT SECTION DETAILS.DWG | Plot Date: Jun. 2, 2025 - 12:26 PM
Last Saved By: MHAANN | Save Date: 6/2/2025 11:41:05 AM

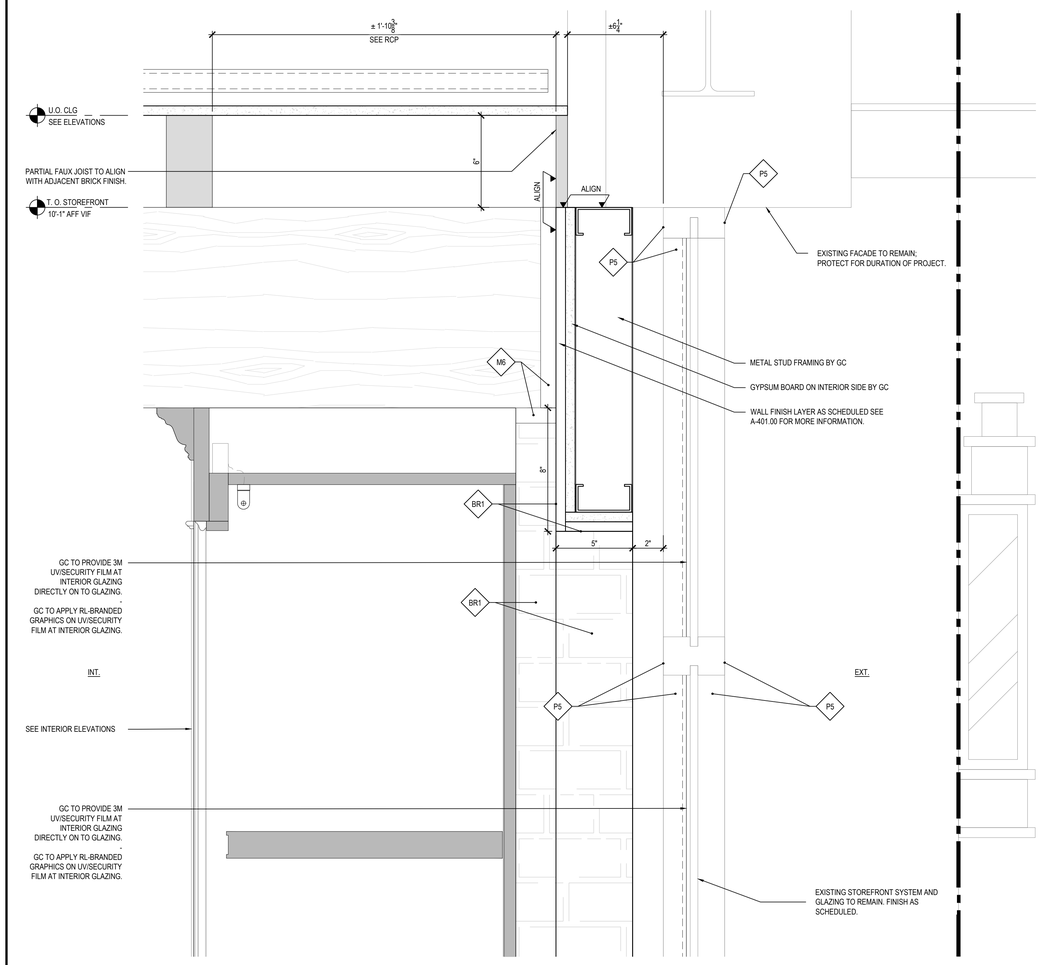


1 **STOREFRONT HEAD SECTION DETAIL**
**- SALES AREA (WEST) SHOW WINDOW W/ GRAPHICS**

SCALE: 3"=1'-0"

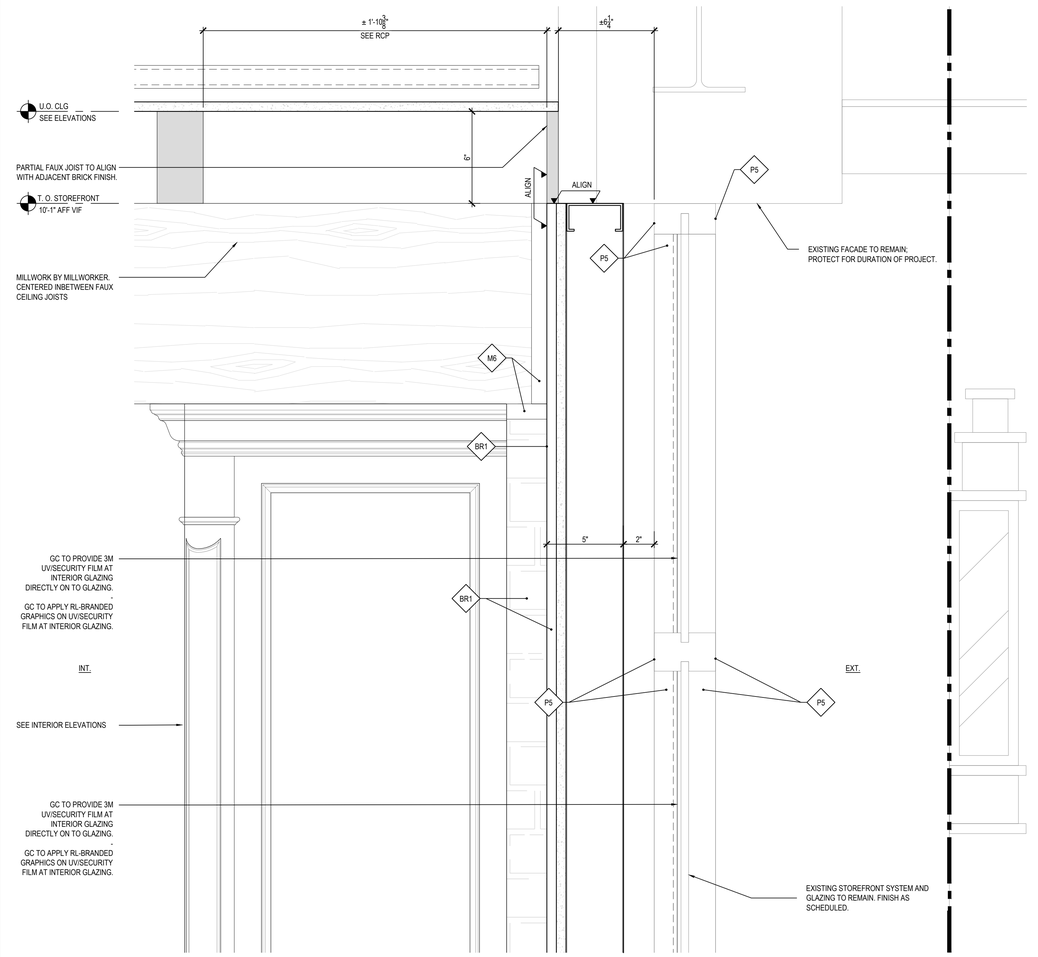


2 **STOREFRONT HEAD SECTION DETAIL**
**- SALES AREA (WEST) SHOW WINDOW W/ GRAPHICS**

SCALE: 3"=1'-0"

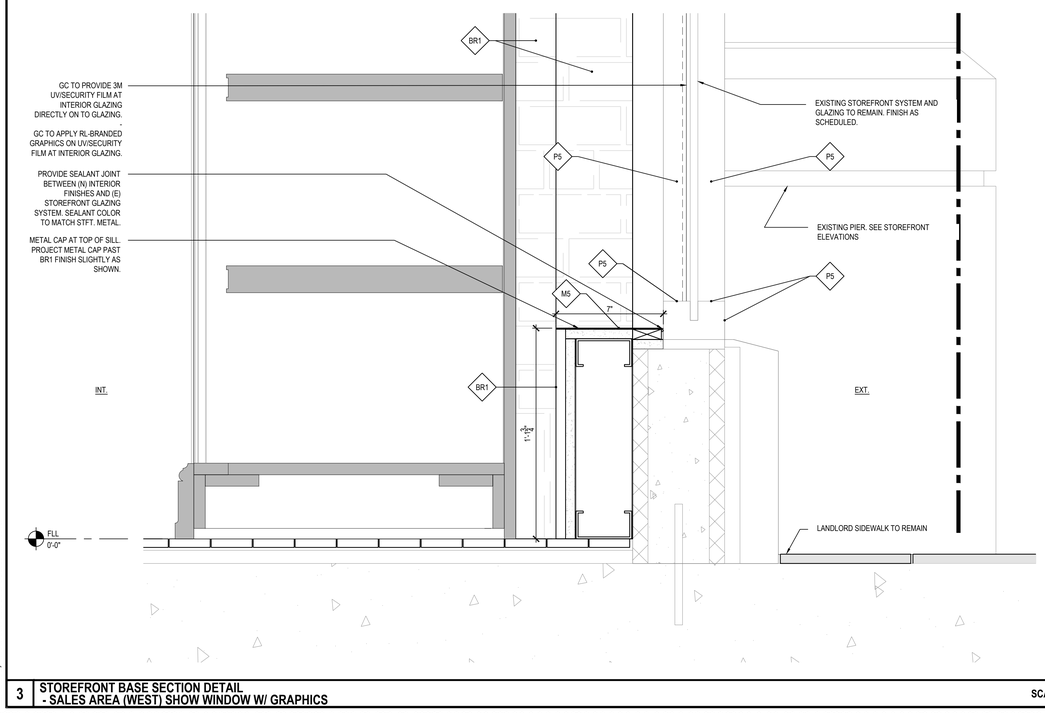


3 **STOREFRONT BASE SECTION DETAIL**
**- SALES AREA (WEST) SHOW WINDOW W/ GRAPHICS**

SCALE: 3"=1'-0"

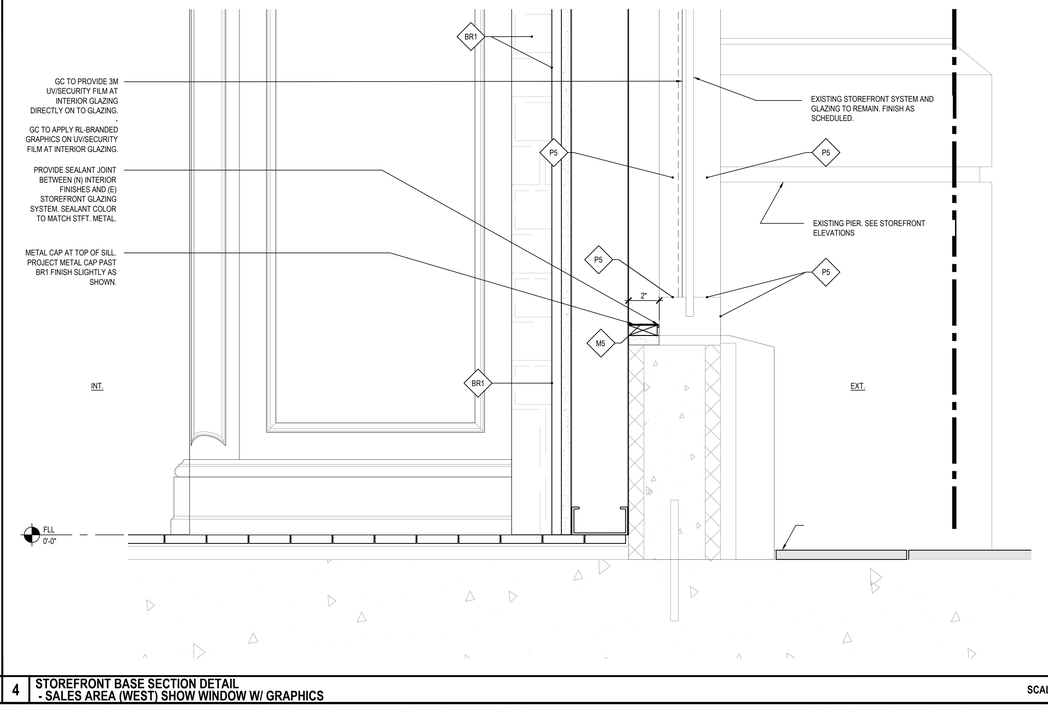


4 **STOREFRONT BASE SECTION DETAIL**
**- SALES AREA (WEST) SHOW WINDOW W/ GRAPHICS**

SCALE: 3"=1'-0"

RALPH LAUREN

**SPACE PLAN**

RALPH LAUREN
STANFORD SHOPPING CENTER
SPACE 383A

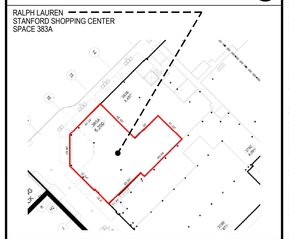

Lam+Tea Engineering

kpff

**SUBMISSION FOR ARCHITECTURAL REVIEW BOARD**

| NO. | REVISION | | DATE | BY |
|---|---|---|---|---|
| 9 | A.R.B. CORRECTIONS 2 | 7 | 07.22.2025 | TPG |
| 8 | PERMIT CORRECTIONS 2 | 6 | 07.02.2025 | TPG |
| 7 | A.R.B. CORRECTIONS 1 | 5 | 05.30.2025 | TPG |
| 6 | BOARD OF HEALTH CORRECTIONS | 4 | 04.18.2025 | TPG |
| 5 | LATEST FULL SET UPDATES | 3 | 04.14.2025 | TPG |
| 4 | PERMIT CORRECTIONS 1 | 2 | 05.23.2025 | TPG |
| 3 | BID ADDENDUM 1 | 1 | 03.11.2025 | TPG |
| 2 | ISSUED FOR BID & PERMIT | | 01.10.2025 | TPG |
| 1 | PROGRESS SET FOR CLIENT REVIEW | | 12.13.2024 | TPG |

TPG Architecture

**TPG ARCHITECTURE, LLP**
**31 PENN PLAZA**
**132 WEST 31ST STREET, 5TH FLOOR, NEW YORK, NY 10001**
**212.768.0800 | TPGARCHITECTURE.COM**

IN CONSIDERATION OF RECEIVING DRAWINGS FROM TPG ARCHITECTURE LLP IN AN ELECTRONIC FORM, THE RECIPIENT AGREES, TO THE FULLEST EXTENT PERMITTED BY LAW, TO HOLD HARMLESS AND INDEMNIFY TPG ARCHITECTURE LLP FROM AND AGAINST ALL CLAIMS, LIABILITIES, LOSSES, DAMAGES, AND COSTS, INCLUDING BUT NOT LIMITED TO ATTORNEY'S FEES, ARISING OUT OF, OR IN ANY WAY CONNECTED WITH THE USE, RE-USE, MIS-USE, MODIFICATION, OR MISINTERPRETATION OF THE MACHINE-READABLE INFORMATION PROVIDED BY TPG ARCHITECTURE LLP UNDER THIS AGREEMENT.

PROJECT
**RALPH LAUREN**
**STANFORD SHOPPING CENTER**
180 EL CAMINO REAL #383A, BLDG. M
PALO ALTO, CA 94304

DRAWING
STOREFRONT SECTION DETAILS

SEAL

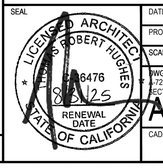


| | |
|---|---|
| DATE | 04/18/2025 |
| PROJECT NO. | 1524879-00 |
| SCALE | 3"=1'-0" |
| DWG NO. | A726.00_STOREFRONT SECTION DETAILS.DWG |
| | A-726.00 |
| CAD FILE NO. | PAGE 41 of 66 |

K:\04\1524879.0000\DRAWINGS_CAD\2_SHEETS\A-726.00_STOREFRONT SECTION DETAILS.DWG | Plot Date: Jun 2, 2025 - 12:20 PM
Last Saved By: MHAHAN | Save Date: 6/2/2025 11:41:05 AM

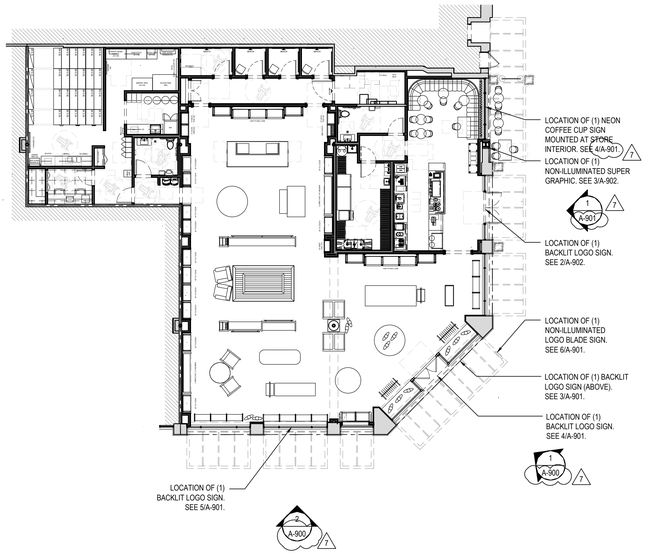


A SIGNAGE LOCATIONS KEY PLAN — SCALE: NTS

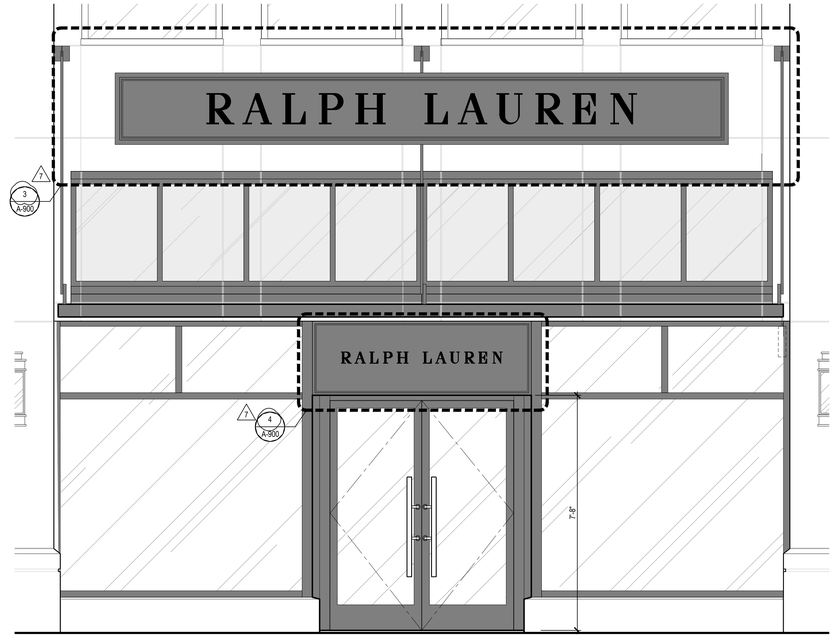


1 RALPH LAUREN LOGO SIGNAGE ELEVATION - SOUTHWEST — SCALE: 1/2"=1'-0"

2 RALPH LAUREN LOGO WINDOW SIGNAGE - WEST — SCALE: 1/2"=1'-0"

RALPH LAUREN

## SPACE PLAN

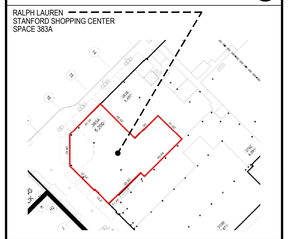


Lam+Tea Engineering

kpff

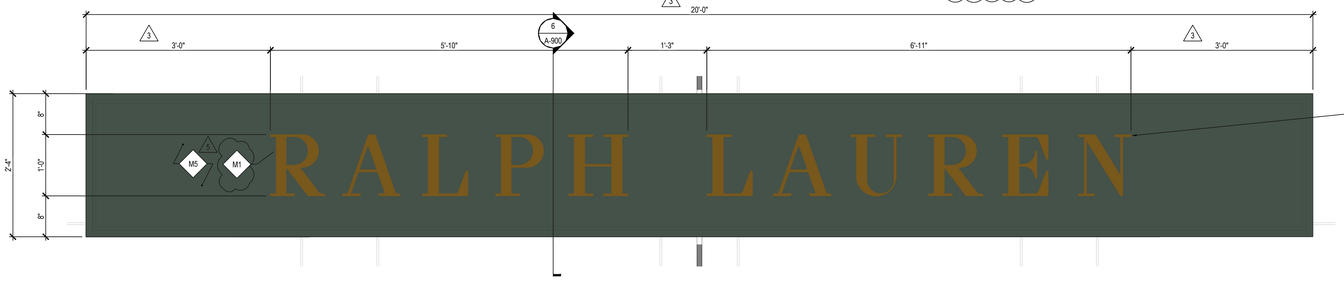


SQUARE FOOTAGE OF LOGO: 14SF

3 RALPH LAUREN PRIMARY SIGNAGE - SOUTHWEST — SCALE: 1"=1'-0"

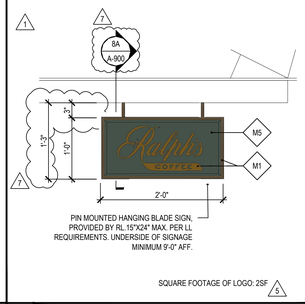


SQUARE FOOTAGE OF LOGO: 2SF

8 NON-ILLUMINATED BLADE SIGN — SCALE: 1"=1'-0"

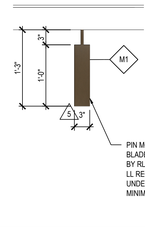


8A BLADE SIGN SECTION — SCALE: 1"=1'-0"

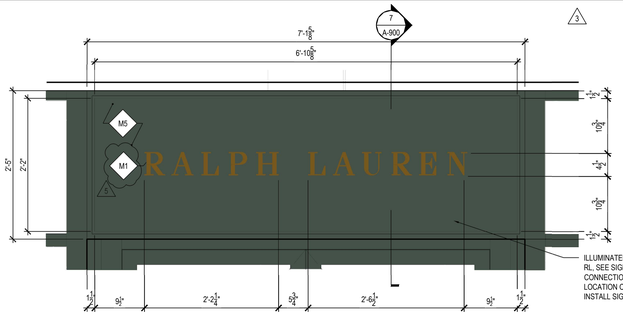


SQUARE FOOTAGE OF LOGO: 1.9SF

4 RALPH LAUREN RETAIL ENTRY SIGNAGE - SOUTHWEST — SCALE: 1"=1'-0"

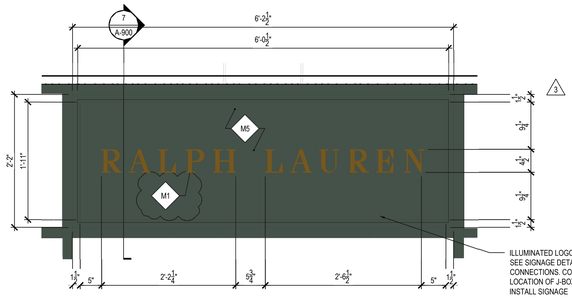


SQUARE FOOTAGE OF LOGO: 1.9SF

5 RALPH LAUREN WINDOW SIGNAGE - WEST — SCALE: 1"=1'-0"

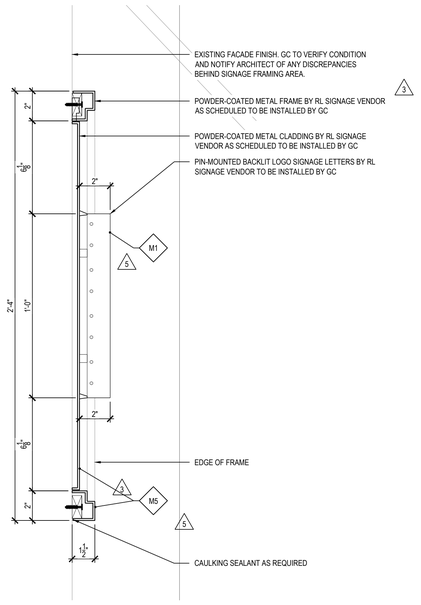


6 RALPH LAUREN PRIMARY SIGNAGE SECTION — SCALE: 3"=1'-0"

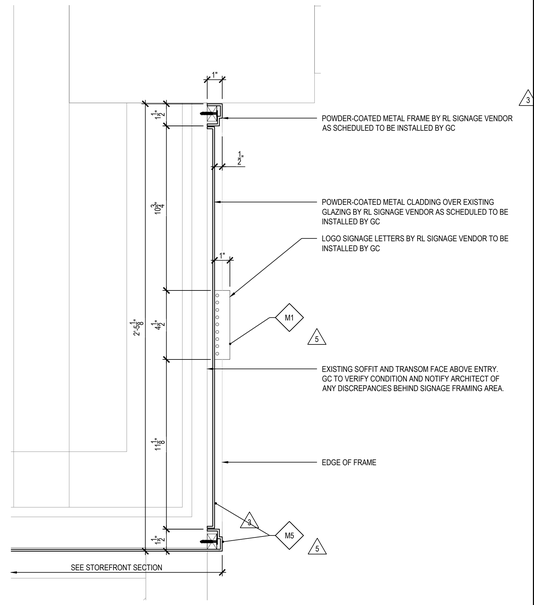


7 RALPH LAUREN ENTRY SIGNAGE SECTION — SCALE: 3"=1'-0"

## SUBMISSION FOR ARCHITECTURAL REVIEW BOARD

| NO. | REVISION | | DATE | BY |
|---|---|---|---|---|
| 9 | A.R.B. CORRECTIONS 2 | 7 | 07.22.2025 | TPG |
| 8 | PERMIT CORRECTIONS 2 | 6 | 07.02.2025 | TPG |
| 7 | A.R.B. CORRECTIONS 1 | 5 | 05.30.2025 | TPG |
| 6 | BOARD OF HEALTH CORRECTIONS | 4 | 04.18.2025 | TPG |
| 5 | LATEST FULL SET UPDATES | 3 | 04.14.2025 | TPG |
| 4 | PERMIT CORRECTIONS 1 | 2 | 05.23.2025 | TPG |
| 3 | BID ADDENDUM 1 | 1 | 03.11.2025 | TPG |
| 2 | ISSUED FOR BID & PERMIT | | 01.10.2025 | TPG |
| 1 | PROGRESS SET FOR CLIENT REVIEW | | 12.13.2024 | TPG |

TPG Architecture

**TPG ARCHITECTURE, LLP**
**31 PENN PLAZA**
**132 WEST 31ST STREET, 5TH FLOOR, NEW YORK, NY 10001**
**212.768.0800 | TPGARCHITECTURE.COM**

IN CONSIDERATION OF RECEIVING DRAWINGS FROM TPG ARCHITECTURE LLP IN AN ELECTRONIC FORM, THE RECIPIENT AGREES, TO THE FULLEST EXTENT PERMITTED BY LAW, TO HOLD HARMLESS AND INDEMNIFY TPG ARCHITECTURE LLP FROM AND AGAINST ALL CLAIMS, LIABILITIES, LOSSES, DAMAGES, AND COSTS, INCLUDING BUT NOT LIMITED TO ATTORNEY'S FEES, ARISING OUT OF, OR IN ANY WAY CONNECTED WITH THE USE, RE-USE, MIS-USE, MODIFICATION, OR MISINTERPRETATION OF THE MACHINE-READABLE INFORMATION PROVIDED BY TPG ARCHITECTURE LLP UNDER THIS AGREEMENT.

PROJECT

**RALPH LAUREN**
**STANFORD SHOPPING CENTER**
180 EL CAMINO REAL #383A, BLDG. M
PALO ALTO, CA 94304

DRAWING

SIGNAGE DETAILS
RETAIL

SEAL

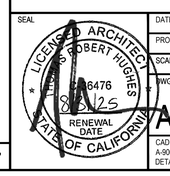


| | |
|---|---|
| DATE | 04/18/2025 |
| PROJECT NO. | 1524879-00 |
| SCALE | AS SHOWN |
| DWG NO. | A-900.00 |
| CAD FILE NO. | A-900.00_SIGNAGE DETAILS.DWG |
| PAGE | 54 of 55 |

K:\241524\PD_0008_DRAWINGS_CAD\2_SHEETS\A-900.00_SIGNAGE DETAILS.DWG | Plot Date: Jul. 24, 2025 - 9:25 AM
Last Saved By: MHAMANI | Save Date: 7/24/2025 9:22:28 AM

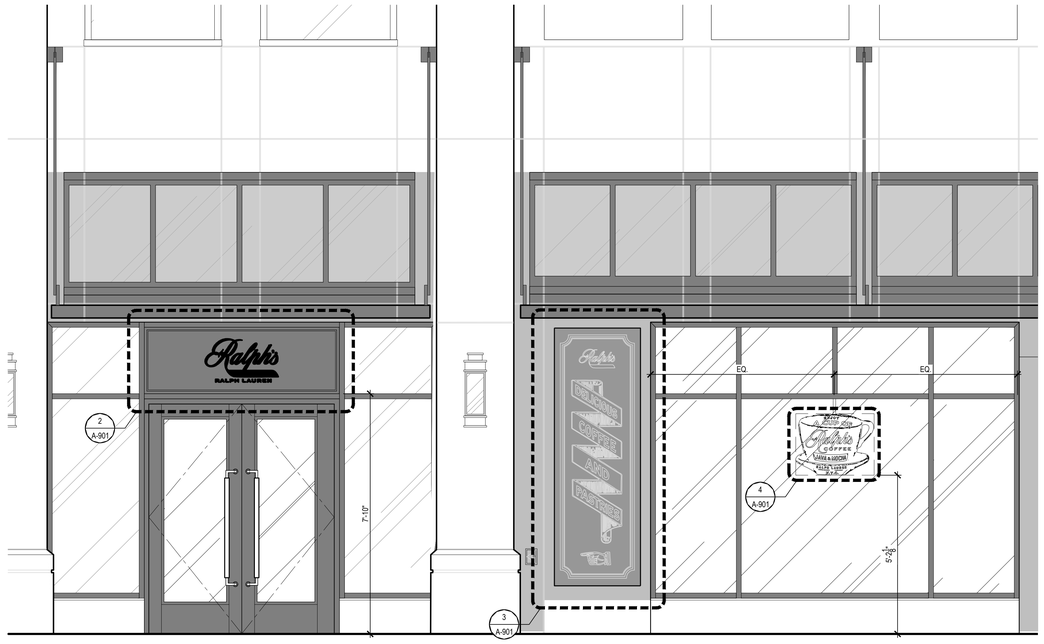


1 | RALPH LAUREN SIDE WINDOW SIGNAGE — SCALE: 1/2"=1'-0"

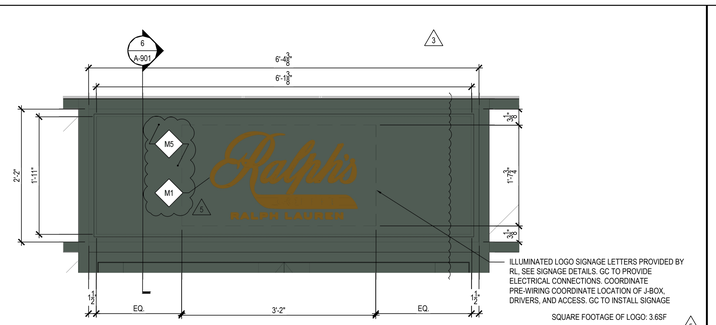


2 | RALPH LAUREN CAFE ENTRY SIGNAGE — SCALE: 1"=1'-0"

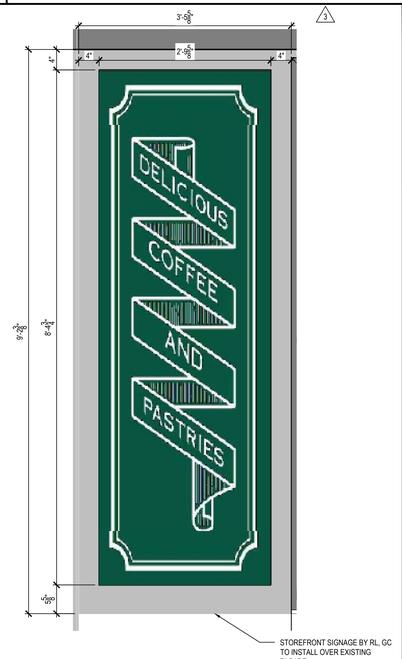


3 | NON-ILLUMINATED CAFE SIGNAGE — SCALE: 1"=1'-0"

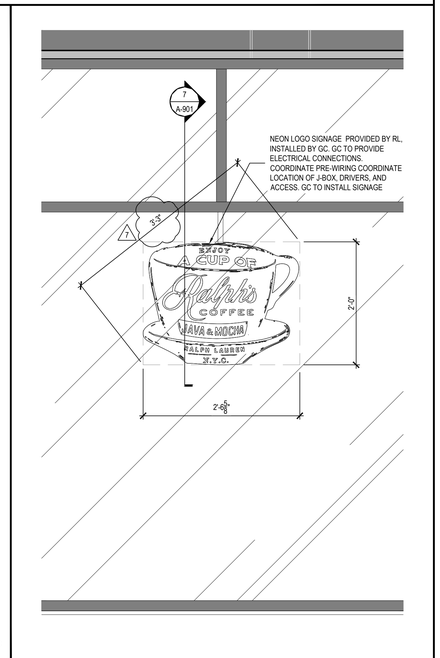


4 | RALPH'S COFFEE CUP WINDOW SIGNAGE — SCALE: 1"=1'-0"

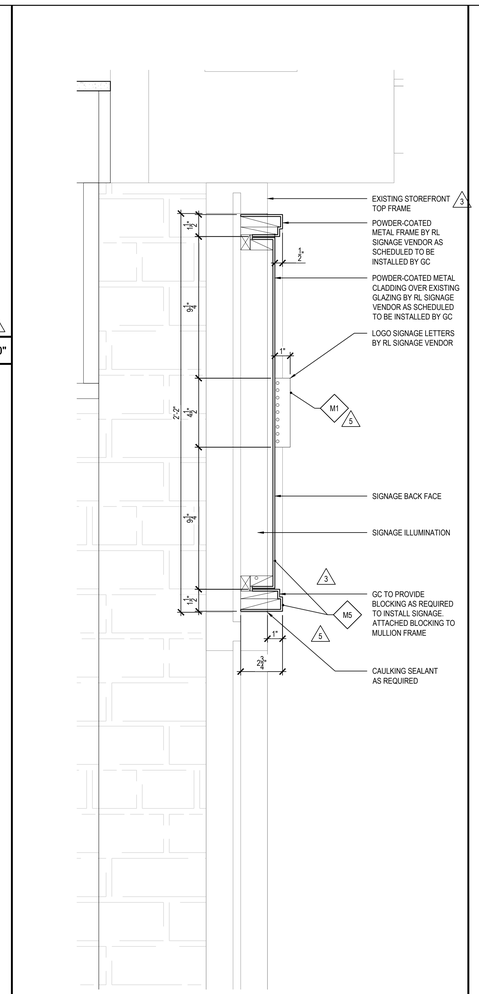


5 | RALPH LAUREN CAFE ENTRY SIGNAGE SECTION — SCALE: 3"=1'-0"

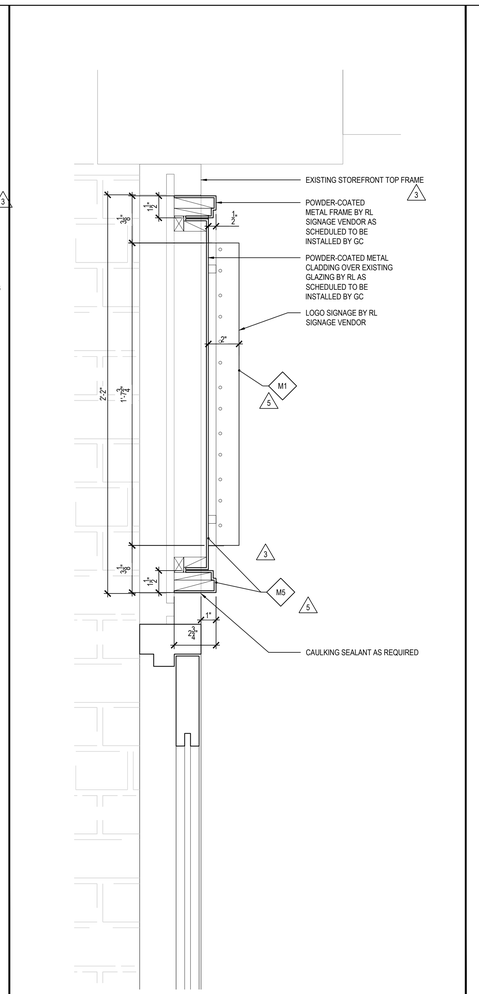


6 | RALPH LAUREN SIDE WINDOW SIGNAGE SECTION — SCALE: 3"=1'-0"

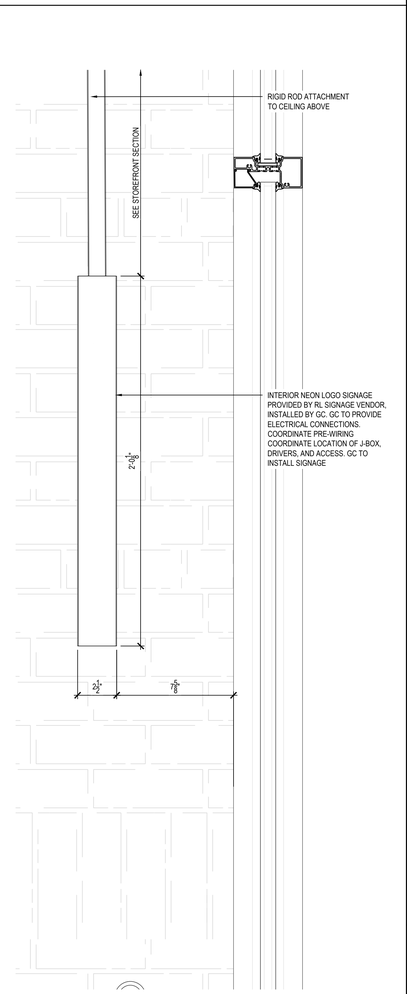


7 | RALPH LAUREN CAFE WINDOW SIGNAGE SECTION — SCALE: 3"=1'-0"

RALPH LAUREN

**SPACE PLAN**

RALPH LAUREN
STANFORD SHOPPING CENTER
SPACE 383A

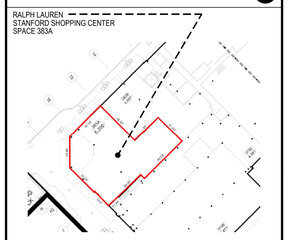

Lam+Tea Engineering

kpff

**SUBMISSION FOR ARCHITECTURAL REVIEW BOARD**

| NO. | REVISION | | DATE | BY |
|---|---|---|---|---|
| 9 | A.R.B. CORRECTIONS 2 | 7 | 07.22.2025 | TPG |
| 8 | PERMIT CORRECTIONS 2 | 6 | 07.02.2025 | TPG |
| 7 | A.R.B. CORRECTIONS 1 | 5 | 05.30.2025 | TPG |
| 6 | BOARD OF HEALTH CORRECTIONS | 4 | 04.18.2025 | TPG |
| 5 | LATEST FULL SET UPDATES | 3 | 04.14.2025 | TPG |
| 4 | PERMIT CORRECTIONS 1 | 2 | 05.23.2025 | TPG |
| 3 | BID ADDENDUM 1 | 1 | 03.11.2025 | TPG |
| 2 | ISSUED FOR BID & PERMIT | | 01.10.2025 | TPG |
| 1 | PROGRESS SET FOR CLIENT REVIEW | | 12.13.2024 | TPG |

TPG Architecture

**TPG ARCHITECTURE, LLP**
**31 PENN PLAZA**
**132 WEST 31ST STREET, 5TH FLOOR, NEW YORK, NY 10001**
**212.768.0800 | TPGARCHITECTURE.COM**

IN CONSIDERATION OF RECEIVING DRAWINGS FROM TPG ARCHITECTURE LLP IN AN ELECTRONIC FORM, THE RECIPIENT AGREES, TO THE FULLEST EXTENT PERMITTED BY LAW, TO HOLD HARMLESS AND INDEMNIFY TPG ARCHITECTURE LLP FROM AND AGAINST ALL CLAIMS, LIABILITIES, LOSSES, DAMAGES, AND COSTS, INCLUDING BUT NOT LIMITED TO ATTORNEY'S FEES, ARISING OUT OF, OR IN ANY WAY CONNECTED WITH THE USE, RE-USE, MIS-USE, MODIFICATION, OR MISINTERPRETATION OF THE MACHINE-READABLE INFORMATION PROVIDED BY TPG ARCHITECTURE LLP UNDER THIS AGREEMENT.

PROJECT
**RALPH LAUREN**
**STANFORD SHOPPING CENTER**
180 EL CAMINO REAL #383A, BLDG. M
PALO ALTO, CA 94304

DRAWING
SIGNAGE DETAILS
CAFE

SEAL

LICENSED ARCHITECT * THOMAS ROBERT HUGHES * 26476 * STATE OF CALIFORNIA * RENEWAL DATE 08/31/25

| | |
|---|---|
| DATE | 04/18/2025 |
| PROJECT NO. | 1524879-00 |
| SCALE | AS SHOWN |
| DWG NO. | A-901.00 |
| CAD FILE NO. | A-900.00_SIGNAGE DETAILS.DWG |
| PAGE | 55 of 55 |

K:\2415\2415879-0000_DRAWINGS_CAD\3_SHEETS\A-900.00_SIGNAGE DETAILS.DWG | Plot Date: Jul. 24, 2025 - 9:25 AM
Last Saved By: MHAMANN | Save Date: 7/24/2025 9:22:28 AM