Dist	COUNTY	ROUTE	POST MILES TOTAL PROJECT	SHEET No.	TOTAL SHEETS
04	SCI	82	18.2/26.4	218	466

AS-AWARDED CONTRACT PLANS
THIS STAMP PLACED IN LIEU OF ORIGINAL SIGNATURE

REGISTERED CIVIL ENGINEER DATE

PLANS APPROVAL DATE

REGISTERED PROFESSIONAL ENGINEER No. Exp. CIVIL STATE OF CALIFORNIA

THE STATE OF CALIFORNIA OR ITS OFFICERS OR AGENTS SHALL NOT BE RESPONSIBLE FOR THE ACCURACY OR COMPLETENESS OF SCANNED COPIES OF THIS PLAN SHEET.

20

NOTE:

FOR ACCURATE RIGHT OF WAY DATA, CONTACT RIGHT OF WAY ENGINEERING AT THE DISTRICT OFFICE.

NOTE:

1. LIMIT LINE IS 4 FT MINIMUM FROM CROSSWALK UNLESS OTHERWISE NOTED.

ABBREVIATION:

CWL HIGHER VISIBILITY CROSSWALKS (LADDER)

LEGEND:

(1) INSTALL BIKE LANE SYMBOL WITH PERSON AND BIKE LANE ARROW ON GREEN PAVEMENT MARKINGS

(2) INSTALL SHARED ROADWAY BICYCLE MARKING PER STANDARD PLAN A24C.

(3) INSTALL BUFFER BETWEEN BIKE LANE AND TRAVEL LANE PER DETAIL B ON SHEET PDD-1


(4) INSTALL SKIP GREEN THERMOPLASTIC PAVEMENT MARKINGS PER DETAIL A ON SHEET PDD-1

GREEN THERMOPLASTIC PAVEMENT (BIKE LANE TREATMENT)

W PAINT MEDIAN NOSE (WHITE)

K-1 OBJECT MARKER, TYPE K-1 (CA)

BL BICYCLE LOOP DETECTOR SYMBOL

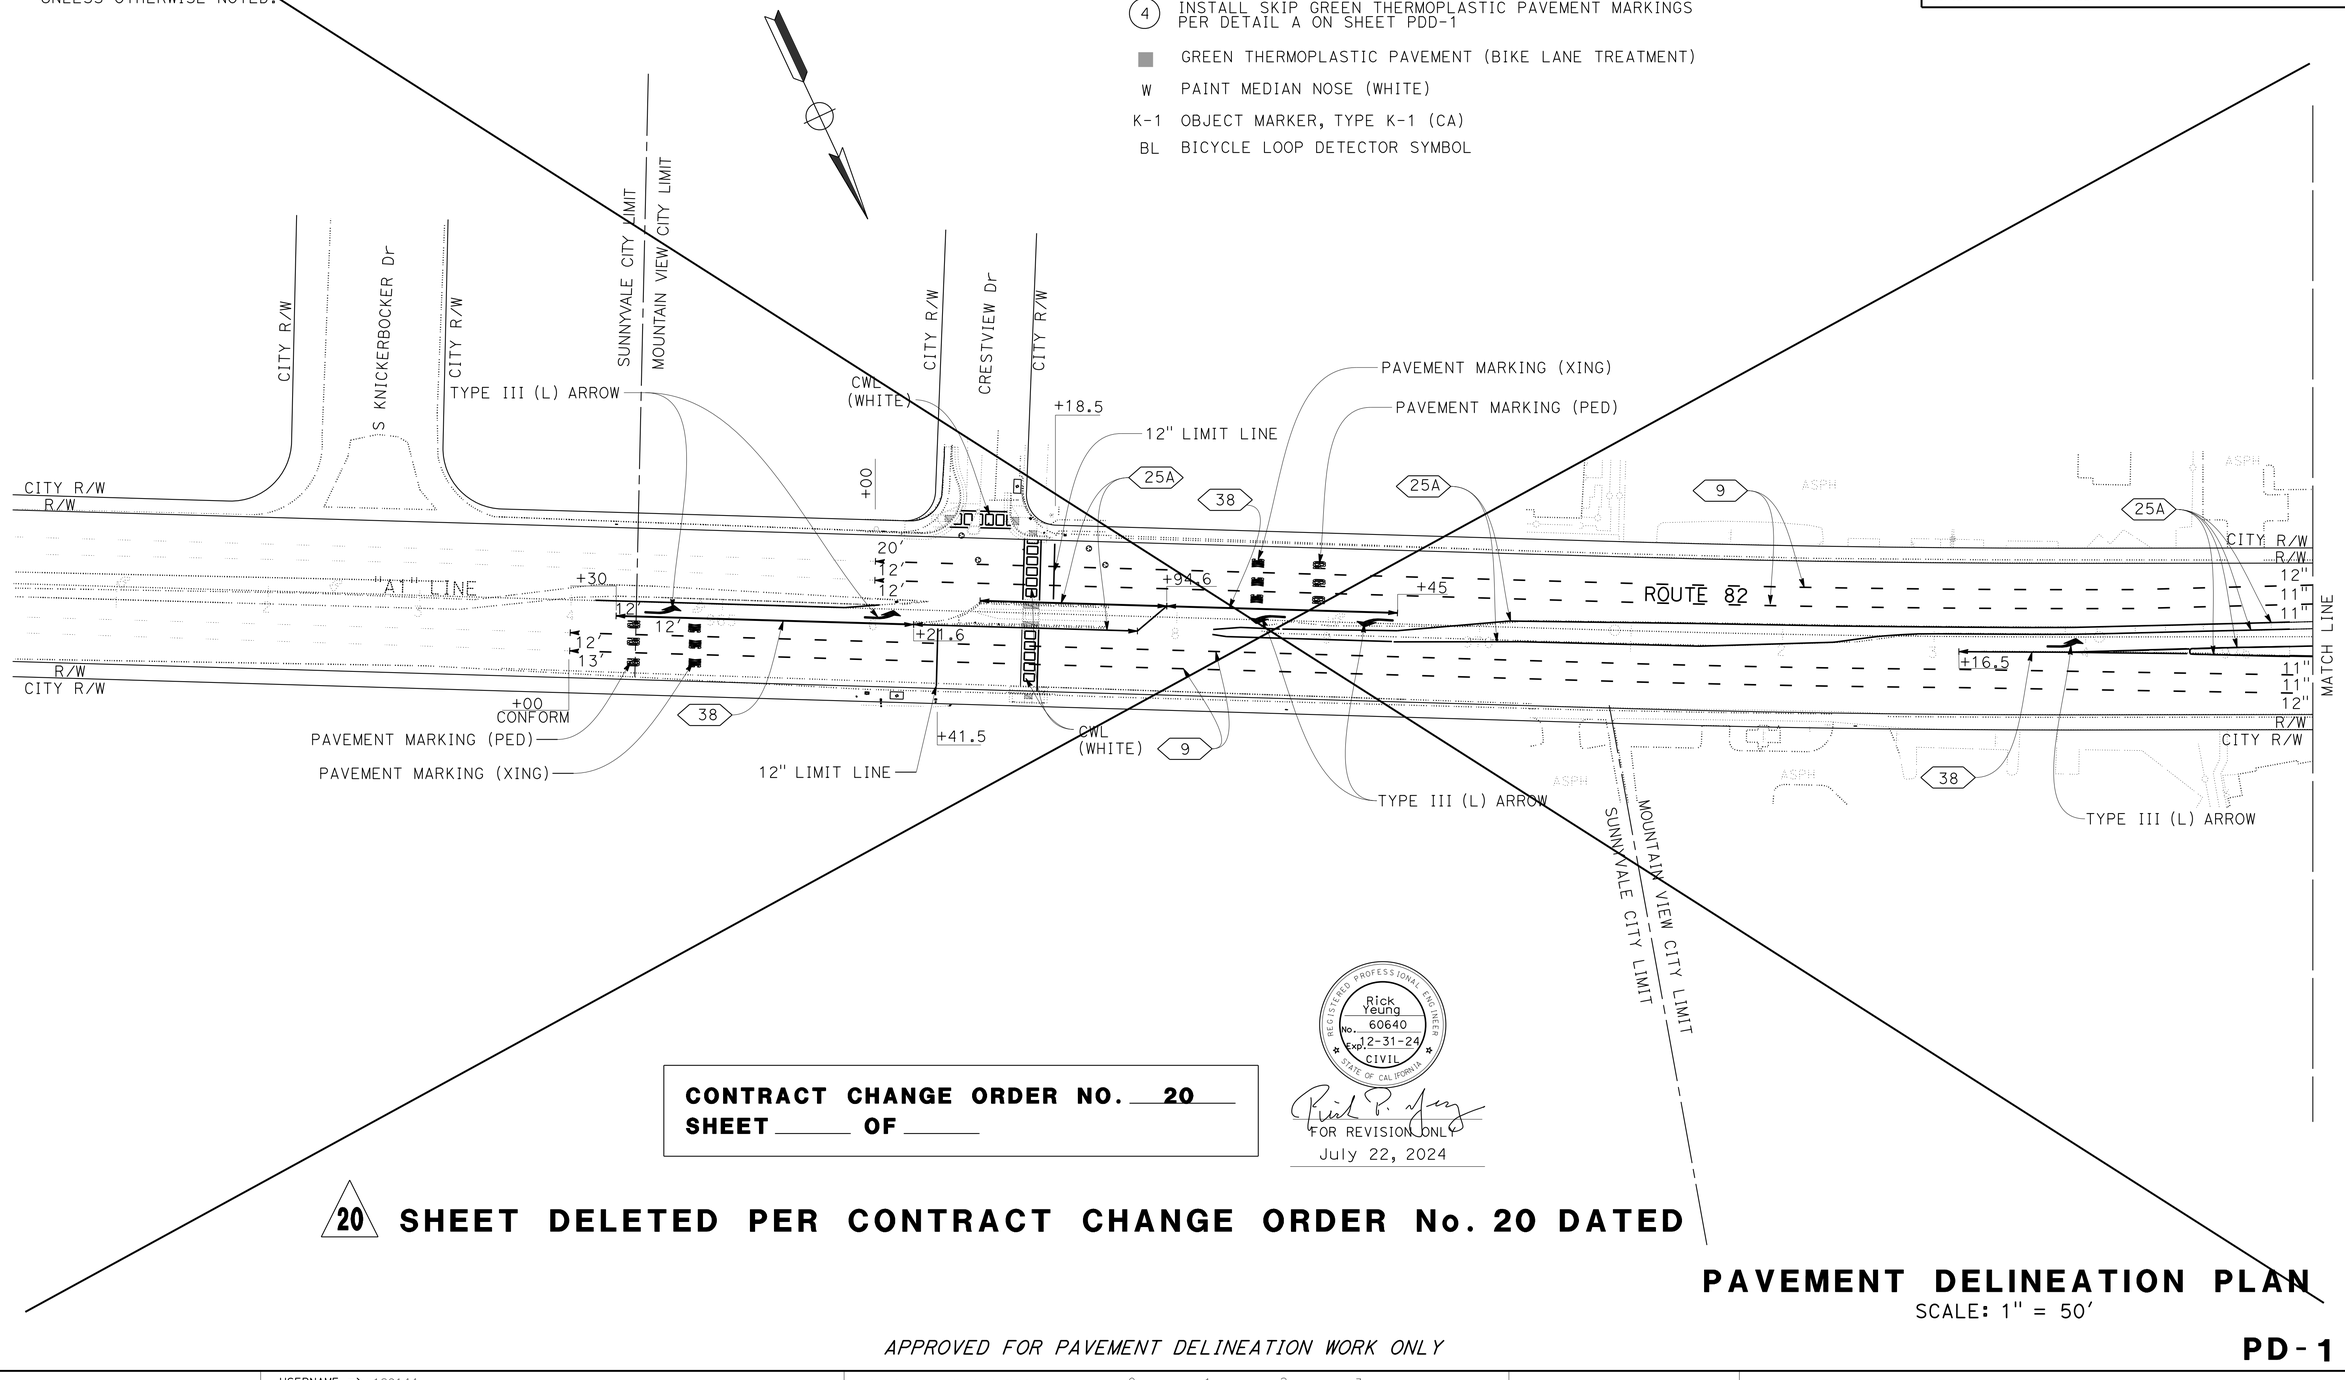

CONTRACT CHANGE ORDER NO. 20
SHEET _____ OF _____

REGISTERED PROFESSIONAL ENGINEER Rick Yeung No. 60640 Exp. 12-31-24 CIVIL STATE OF CALIFORNIA

FOR REVISION ONLY
July 22, 2024

20 **SHEET DELETED PER CONTRACT CHANGE ORDER No. 20 DATED**

PAVEMENT DELINEATION PLAN

SCALE: 1" = 50'

APPROVED FOR PAVEMENT DELINEATION WORK ONLY

PD-1

CALCULATED-DESIGNED BY	CHECKED BY	REVISED BY	DATE REVISED
RICK YEUNG	SON LY	SL	11-18-22

FUNCTIONAL SUPERVISOR: LESTER LEE

STATE OF CALIFORNIA - DEPARTMENT OF TRANSPORTATION
TRAFFIC

LAST REVISION | DATE PLOTTED => 18-NOV-2024
09-15-22 | TIME PLOTTED => 15:07

BORDER LAST REVISED 7/2/2010

USERNAME => s129144
DGN FILE => 0419000140na001.cco

RELATIVE BORDER SCALE IS IN INCHES 0 1 2 3

UNIT 0712

PROJECT NUMBER & PHASE 04190001401

Dist	COUNTY	ROUTE	POST MILES TOTAL PROJECT	SHEET No.	TOTAL SHEETS
04	SCl	82	18.2/26.4	218	466

AS-AWARDED CONTRACT PLANS
THIS STAMP PLACED IN LIEU OF ORIGINAL SIGNATURE

REGISTERED CIVIL ENGINEER DATE

PLANS APPROVAL DATE

REGISTERED PROFESSIONAL ENGINEER No. Exp. CIVIL STATE OF CALIFORNIA

THE STATE OF CALIFORNIA OR ITS OFFICERS OR AGENTS SHALL NOT BE RESPONSIBLE FOR THE ACCURACY OR COMPLETENESS OF SCANNED COPIES OF THIS PLAN SHEET.

20

NOTE:

FOR ACCURATE RIGHT OF WAY DATA, CONTACT RIGHT OF WAY ENGINEERING AT THE DISTRICT OFFICE.

ABBREVIATION:

CWL HIGHER VISIBILITY CROSSWALKS (LADDER)

LEGEND:

(1) INSTALL BIKE LANE SYMBOL WITH PERSON AND BIKE LANE ARROW ON GREEN PAVEMENT MARKINGS

(2) INSTALL SHARED ROADWAY BICYCLE MARKING PLAN A24C ON GREEN PAVEMENT MARKING.

(3) INSTALL BIKE LANE PER DETAIL B ON SHEET PDD-1

(4) INSTALL BIKE LANE PER DETAIL A ON SHEET PDD-1

(5) INSTALL BIKE LANE PER DETAIL C ON SHEET PDD-1

■ ■ THERMOPLASTIC PAVEMENT MARKING (GREEN) (BIKE LANE TREATMENT)

W PAINT MEDIAN NOSE (YELLOW)


K-1 OBJECT MARKER, TYPE K-1 (CA)

BL BICYCLE LOOP DETECTOR SYMBOL

■ BIKE BOX

NOTE:

1. LIMIT LINE IS 4 FT MINIMUM FROM CROSSWALK UNLESS OTHERWISE NOTED.
2. SHARED ROADWAY BICYCLE MARKINGS ARE PLACED AT CENTER OF THE LANE.
3. BIKE LANE WIDTH DO NOT INCLUDE GUTTER UNLESS OTHERWISE NOTED.

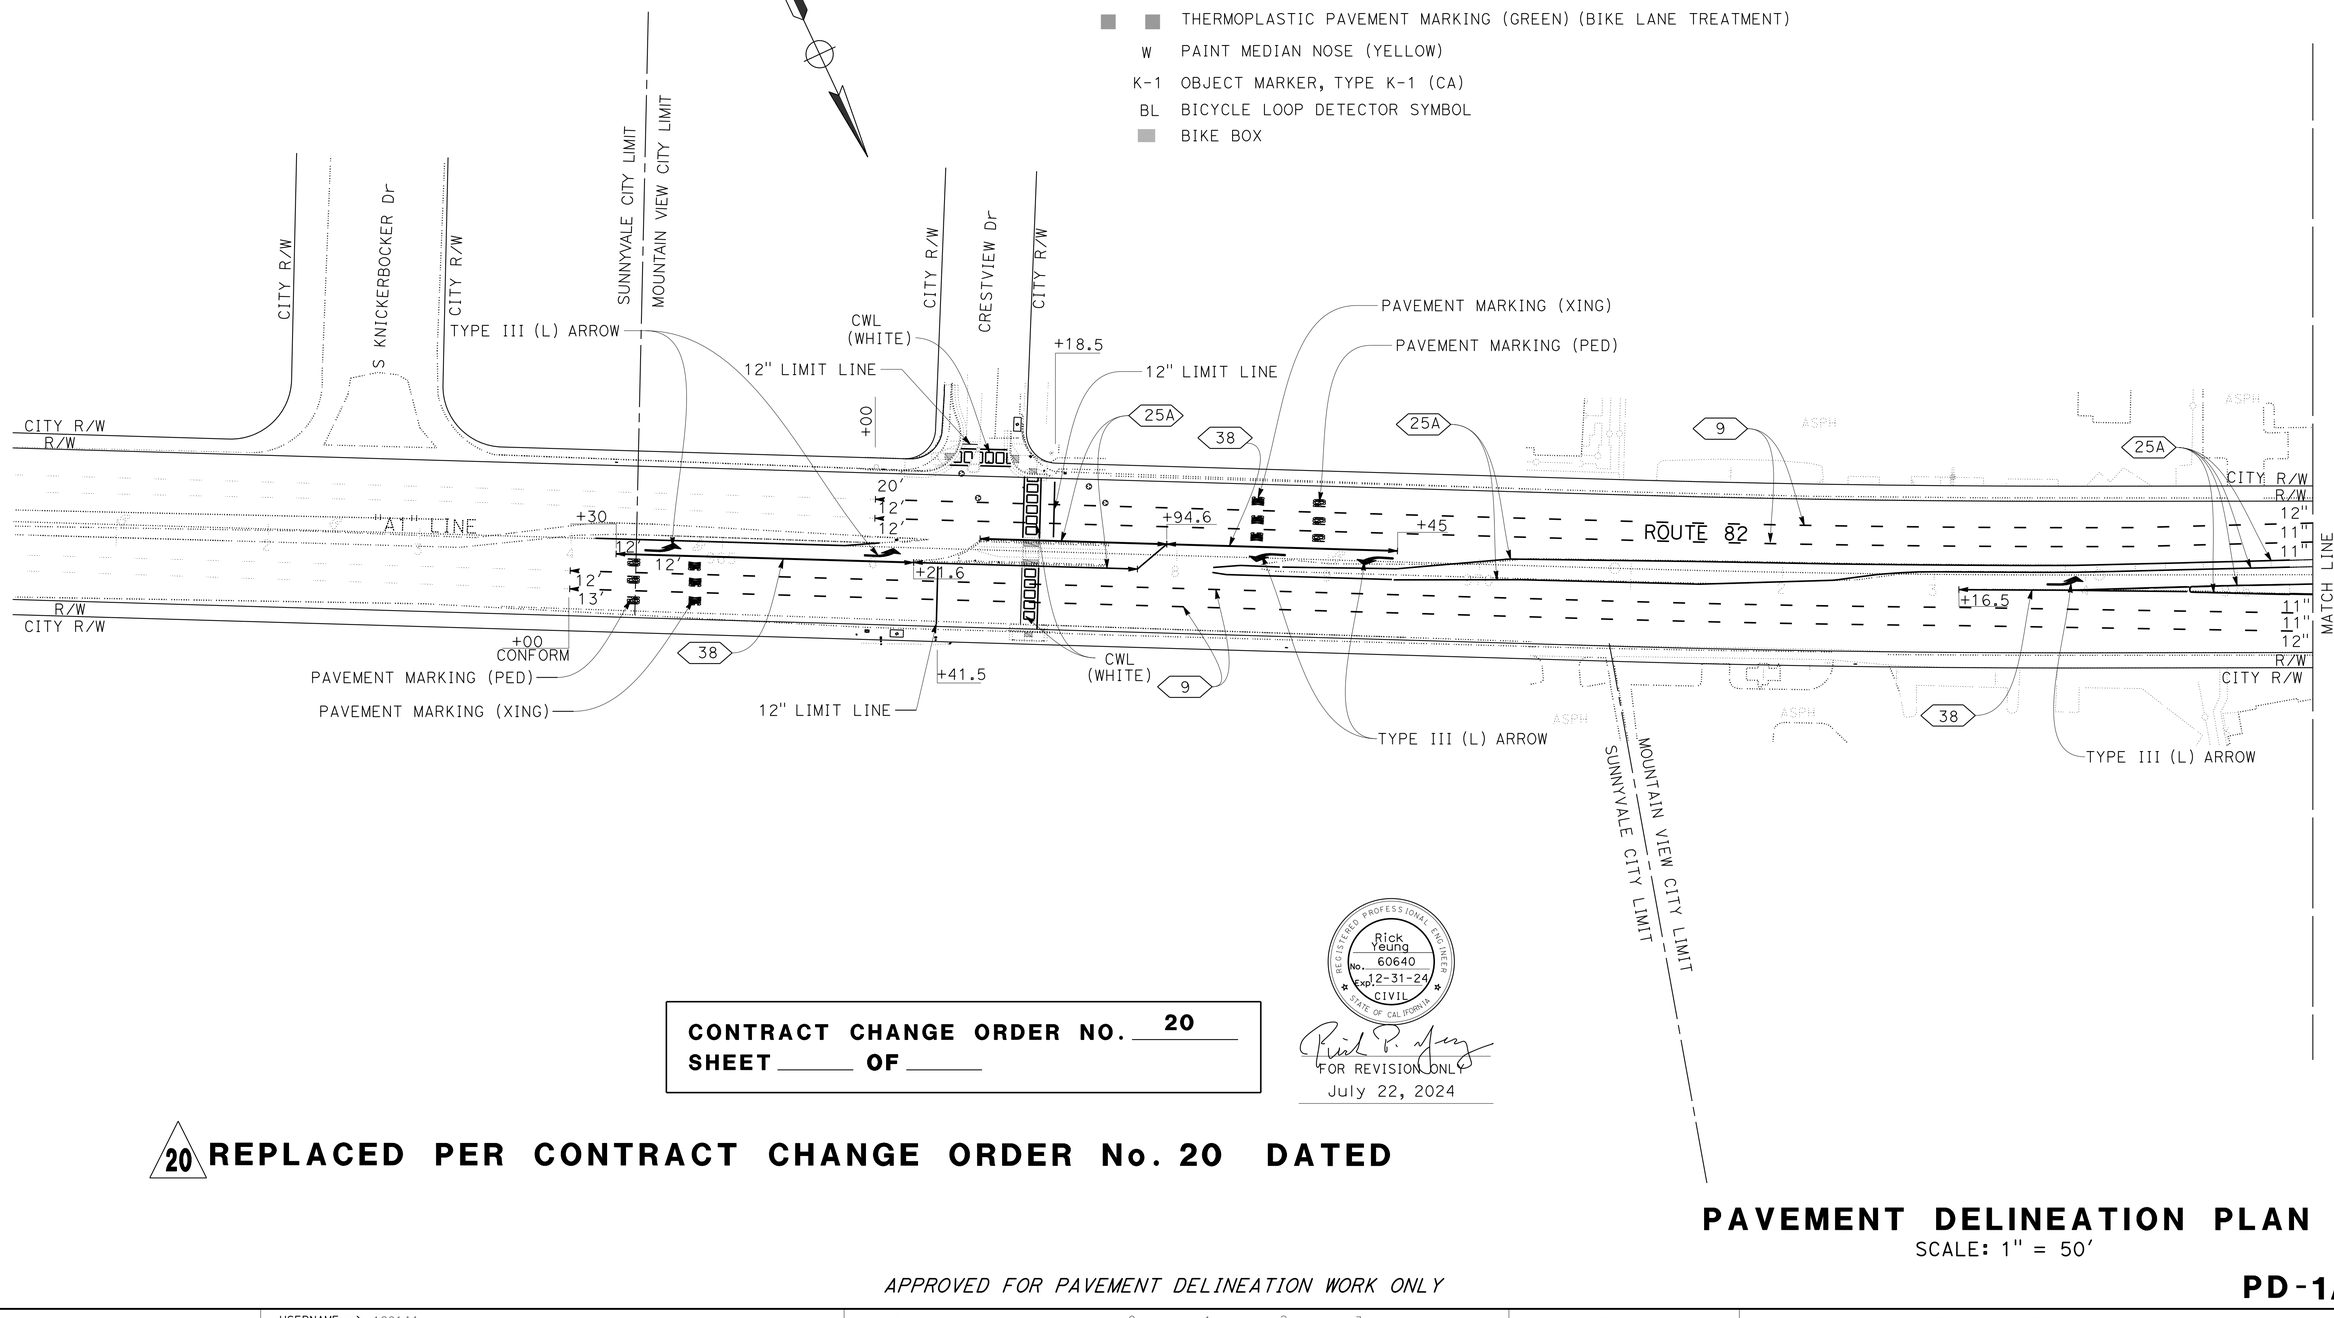

CONTRACT CHANGE ORDER NO. 20
SHEET _____ OF _____

REGISTERED PROFESSIONAL ENGINEER Rick Yeung No. 60640 Exp. 12-31-24 CIVIL STATE OF CALIFORNIA

FOR REVISION ONLY
July 22, 2024

20 REPLACED PER CONTRACT CHANGE ORDER No. 20 DATED

PAVEMENT DELINEATION PLAN

SCALE: 1" = 50'

APPROVED FOR PAVEMENT DELINEATION WORK ONLY

PD-1A

STATE OF CALIFORNIA - DEPARTMENT OF TRANSPORTATION
TRAFFIC
Caltrans

FUNCTIONAL SUPERVISOR: LESTER LEE
CALCULATED-DESIGNED BY:
CHECKED BY:
REVISED BY: SL
DATE REVISED: 11-18-22
SON LY
RICK YEUNG

LAST REVISION DATE PLOTTED => 18-NOV-2024
TIME PLOTTED => 15:07
09-15-22

BORDER LAST REVISED 7/2/2010
USERNAME => s129144
DGN FILE => 0419000140na001A.cco
RELATIVE BORDER SCALE IS IN INCHES 0 1 2 3
UNIT 0712
PROJECT NUMBER & PHASE 04190001401

NOTE:

FOR ACCURATE RIGHT OF WAY DATA, CONTACT
RIGHT OF WAY ENGINEERING AT THE DISTRICT OFFICE.

Dist	COUNTY	ROUTE	POST MILES TOTAL PROJECT	SHEET No.	TOTAL SHEETS
04	SCI	82	18.2/26.4	219	466

AS-AWARDED CONTRACT PLANS
THIS STAMP PLACED IN LIEU OF ORIGINAL SIGNATURE

REGISTERED CIVIL ENGINEER DATE


PLANS APPROVAL DATE

THE STATE OF CALIFORNIA OR ITS OFFICERS OR AGENTS SHALL NOT BE RESPONSIBLE FOR THE ACCURACY OR COMPLETENESS OF SCANNED COPIES OF THIS PLAN SHEET.

REGISTERED PROFESSIONAL ENGINEER — Rick Yeung — No. 60640 — Exp. 12-31-24 — CIVIL — STATE OF CALIFORNIA

20

FOR REVISION ONLY
July 22, 2024

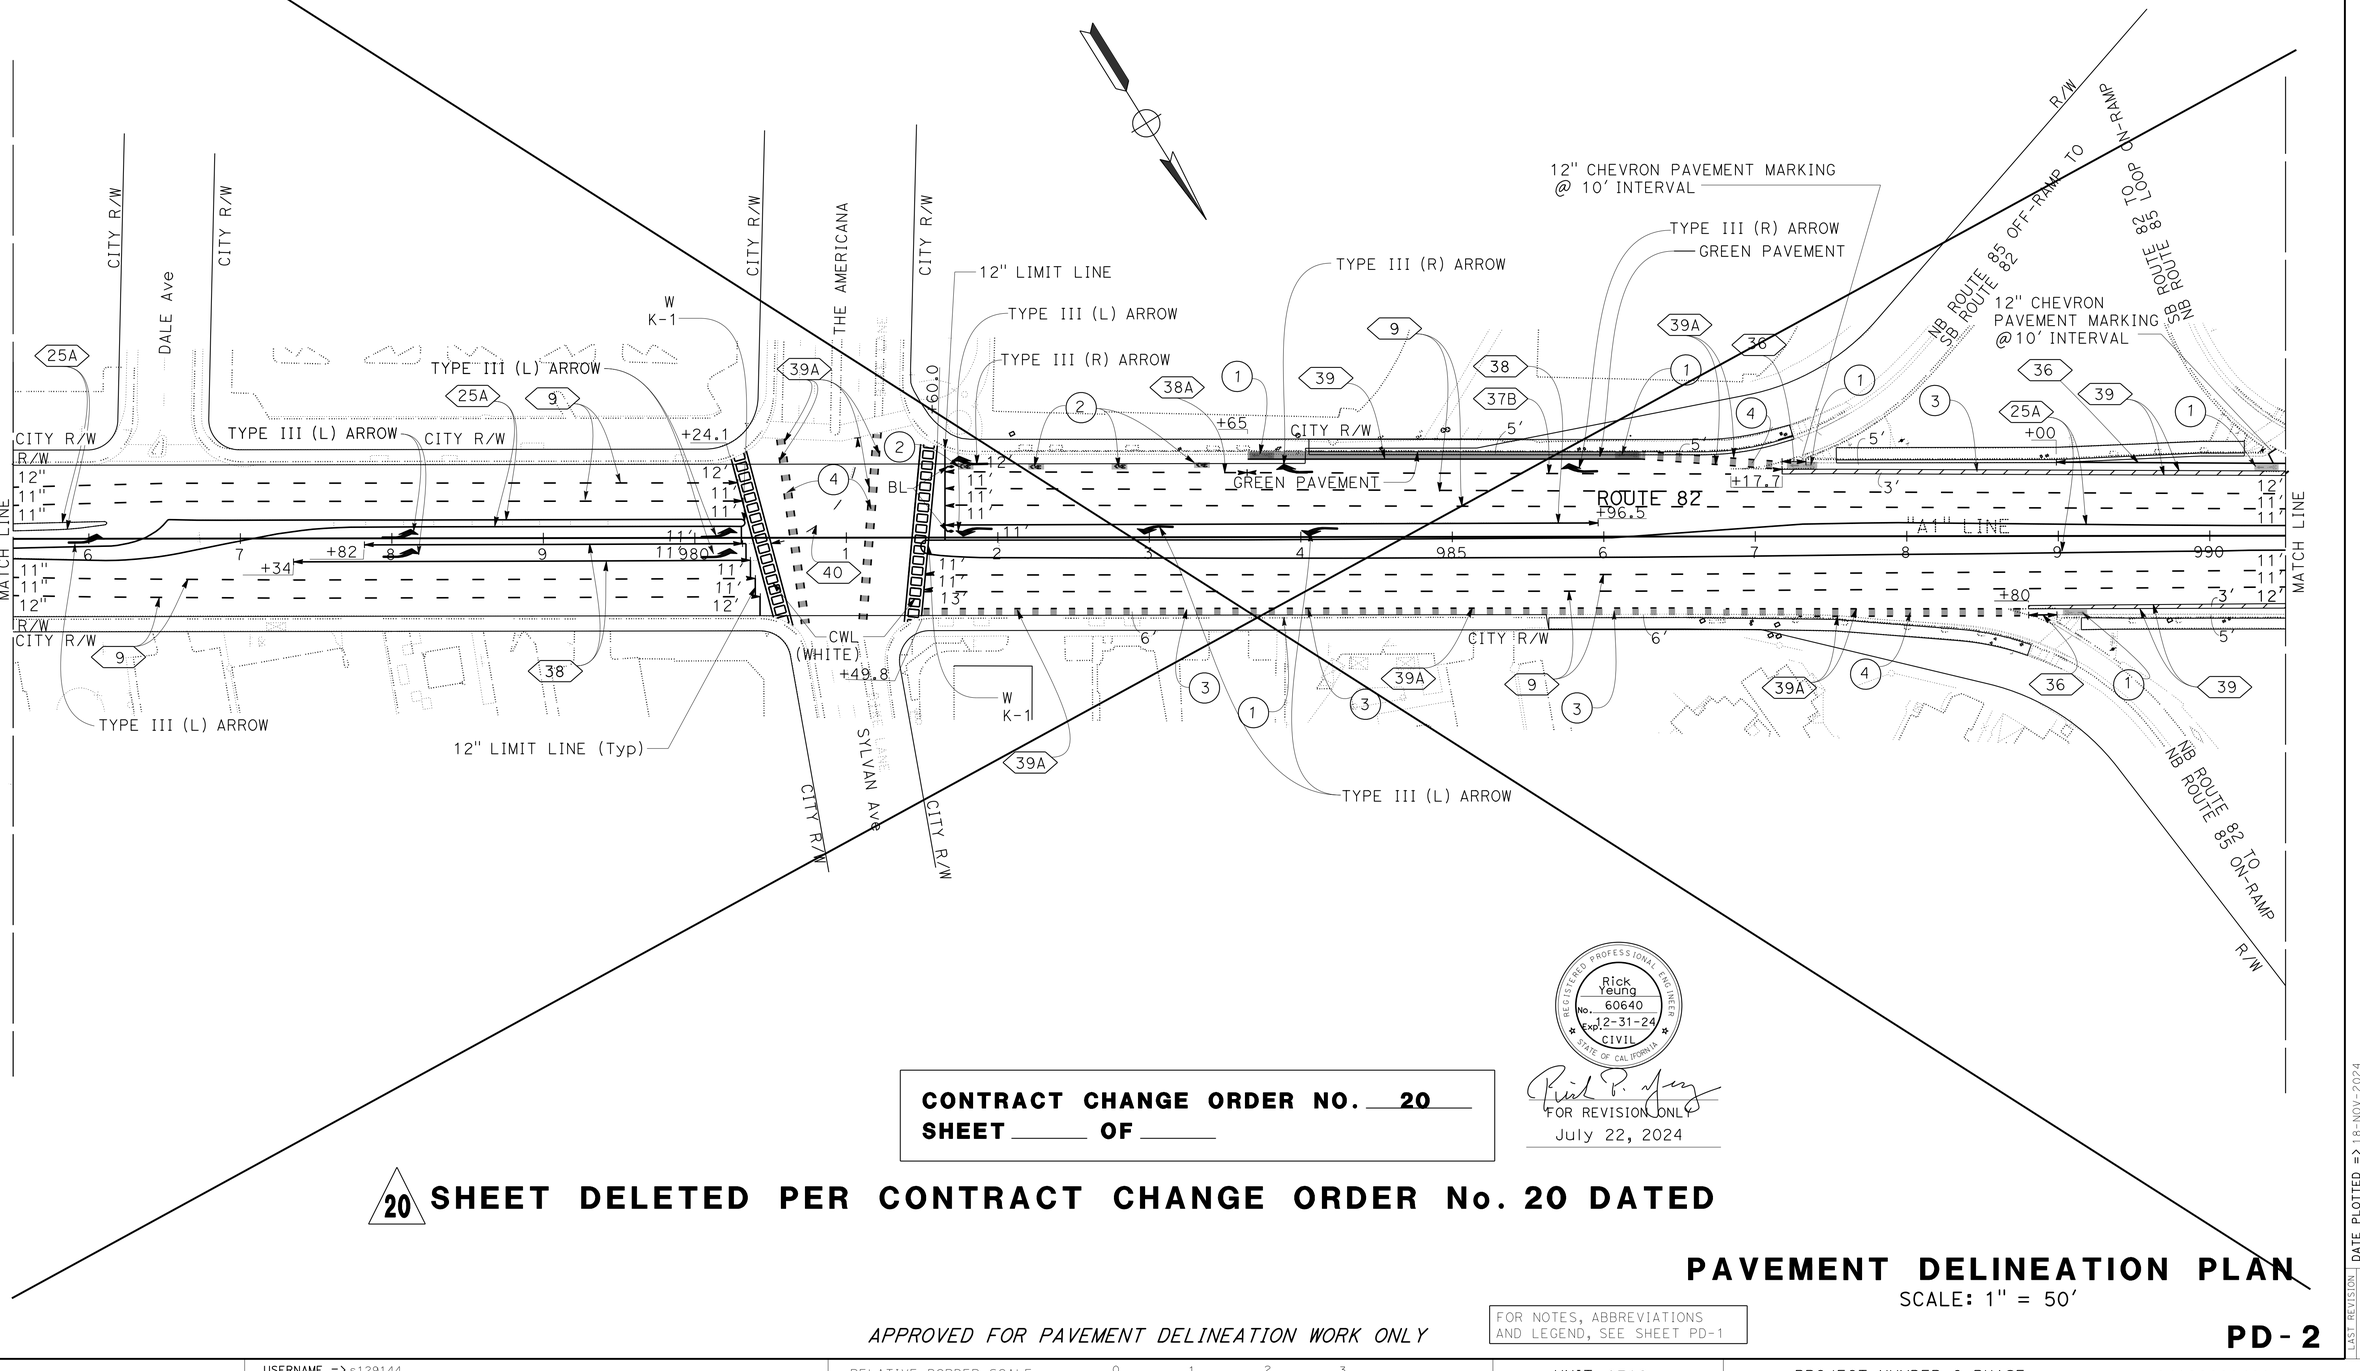

REGISTERED PROFESSIONAL ENGINEER — Rick Yeung — No. 60640 — Exp. 12-31-24 — CIVIL — STATE OF CALIFORNIA

FOR REVISION ONLY
July 22, 2024

CONTRACT CHANGE ORDER NO. 20
SHEET _____ OF _____

20 **SHEET DELETED PER CONTRACT CHANGE ORDER No. 20 DATED**

PAVEMENT DELINEATION PLAN

SCALE: 1" = 50'

APPROVED FOR PAVEMENT DELINEATION WORK ONLY

FOR NOTES, ABBREVIATIONS AND LEGEND, SEE SHEET PD-1

PD-2

CALCULATED-DESIGNED BY	CHECKED BY	REVISED BY	DATE REVISED
RICK YEUNG	SON LY	SL	11-18-22

FUNCTIONAL SUPERVISOR: LESTER LEE

STATE OF CALIFORNIA - DEPARTMENT OF TRANSPORTATION
TRAFFIC

LAST REVISION | DATE PLOTTED => 18-NOV-2024
09-15-22 | TIME PLOTTED => 15:07

BORDER LAST REVISED 7/2/2010 | USERNAME => s129144 | DGN FILE => 0419000140na002.cco | RELATIVE BORDER SCALE IS IN INCHES 0 1 2 3 | UNIT 0712 | PROJECT NUMBER & PHASE 04190001401

NOTE:

FOR ACCURATE RIGHT OF WAY DATA, CONTACT
RIGHT OF WAY ENGINEERING AT THE DISTRICT OFFICE.

Dist	COUNTY	ROUTE	POST MILES TOTAL PROJECT	SHEET No.	TOTAL SHEETS
04	SCI	82	18.2/26.4	219	466

20


AS-AWARDED CONTRACT PLANS
THIS STAMP PLACED IN LIEU OF ORIGINAL SIGNATURE

REGISTERED CIVIL ENGINEER DATE

January 20, 2023
PLANS APPROVAL DATE

REGISTERED PROFESSIONAL ENGINEER
No.
Exp.
CIVIL
STATE OF CALIFORNIA

THE STATE OF CALIFORNIA OR ITS OFFICERS OR AGENTS SHALL NOT BE RESPONSIBLE FOR THE ACCURACY OR COMPLETENESS OF SCANNED COPIES OF THIS PLAN SHEET.

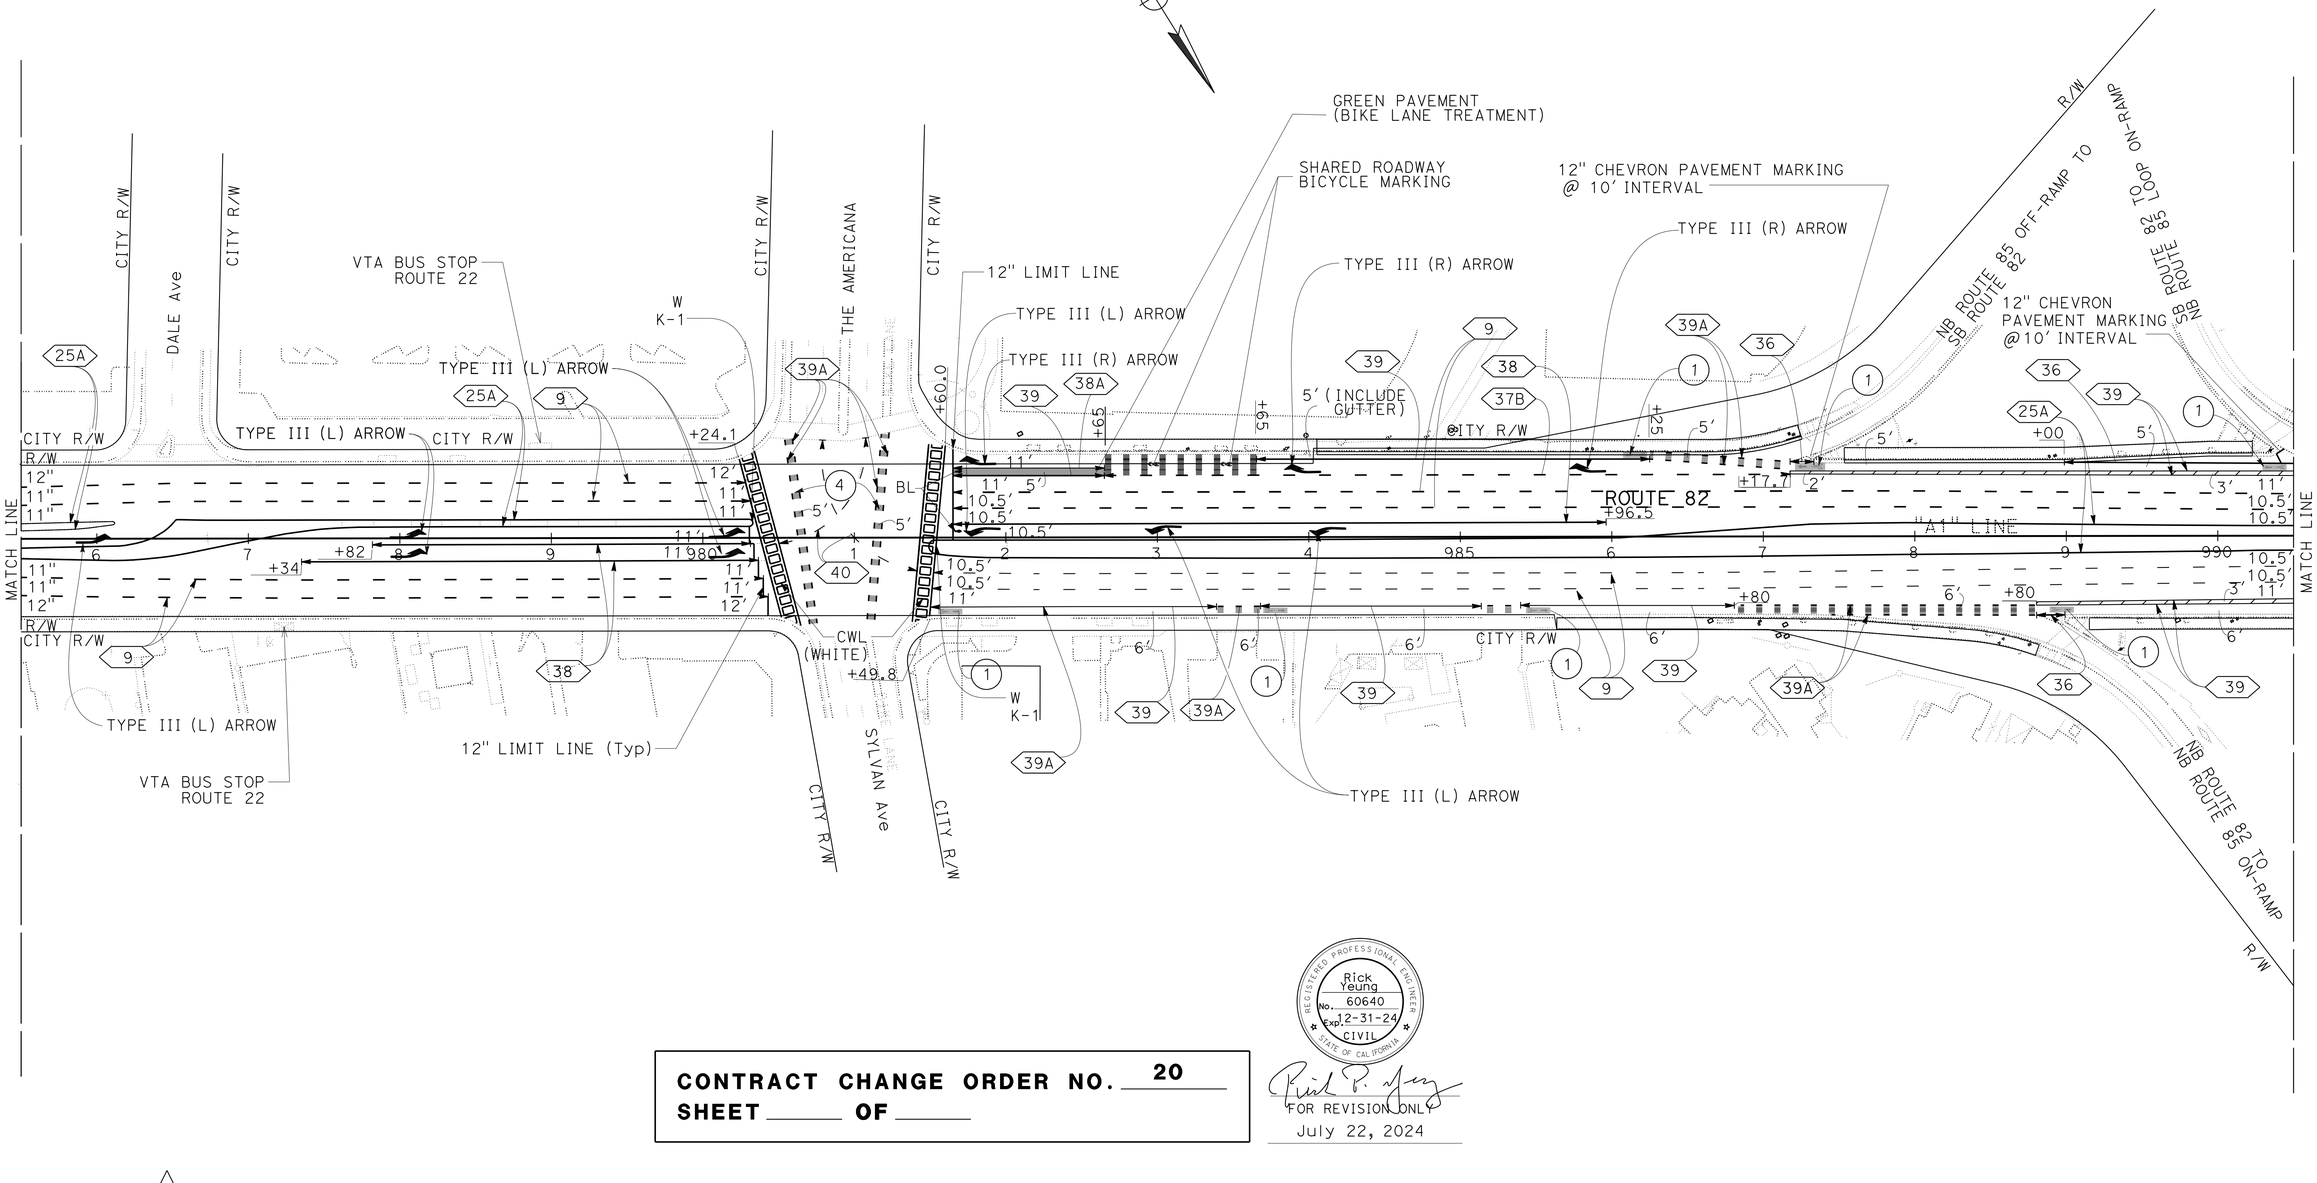

CONTRACT CHANGE ORDER NO. 20
SHEET _____ OF _____

REGISTERED PROFESSIONAL ENGINEER
Rick Yeung
No. 60640
Exp. 12-31-24
CIVIL
STATE OF CALIFORNIA

FOR REVISION ONLY
July 22, 2024

20 REPLACED PER CONTRACT CHANGE ORDER No. 20 DATED

PAVEMENT DELINEATION PLAN

SCALE: 1" = 50'

APPROVED FOR PAVEMENT DELINEATION WORK ONLY

FOR NOTES, ABBREVIATIONS AND LEGEND, SEE SHEET PD-1

PD-2A

REVISED BY	DATE REVISED
SL	11-18-22

CALCULATED-DESIGNED BY: RICK YEUNG
CHECKED BY: SON LY
FUNCTIONAL SUPERVISOR: LESTER LEE

STATE OF CALIFORNIA - DEPARTMENT OF TRANSPORTATION
TRAFFIC

LAST REVISION | DATE PLOTTED => 18-NOV-2024
09-15-22 | TIME PLOTTED => 15:08

BORDER LAST REVISED 7/2/2010
USERNAME => s129144
DGN FILE => 0419000140ng002A.cco
RELATIVE BORDER SCALE IS IN INCHES 0 1 2 3
UNIT 0712
PROJECT NUMBER & PHASE 04190001401

NOTE:

FOR ACCURATE RIGHT OF WAY DATA, CONTACT
RIGHT OF WAY ENGINEERING AT THE DISTRICT OFFICE.

Dist	COUNTY	ROUTE	POST MILES TOTAL PROJECT	SHEET No.	TOTAL SHEETS
04	SCI	82	18.2/26.4	220	466

AS-AWARDED CONTRACT PLANS
THIS STAMP PLACED IN LIEU OF ORIGINAL SIGNATURE

REGISTERED CIVIL ENGINEER DATE


PLANS APPROVAL DATE

THE STATE OF CALIFORNIA OR ITS OFFICERS OR AGENTS SHALL NOT BE RESPONSIBLE FOR THE ACCURACY OR COMPLETENESS OF SCANNED COPIES OF THIS PLAN SHEET.

Rick Yeung No. 60640 Exp. 12-31-24 CIVIL STATE OF CALIFORNIA

FOR REVISION ONLY
July 22, 2024

20

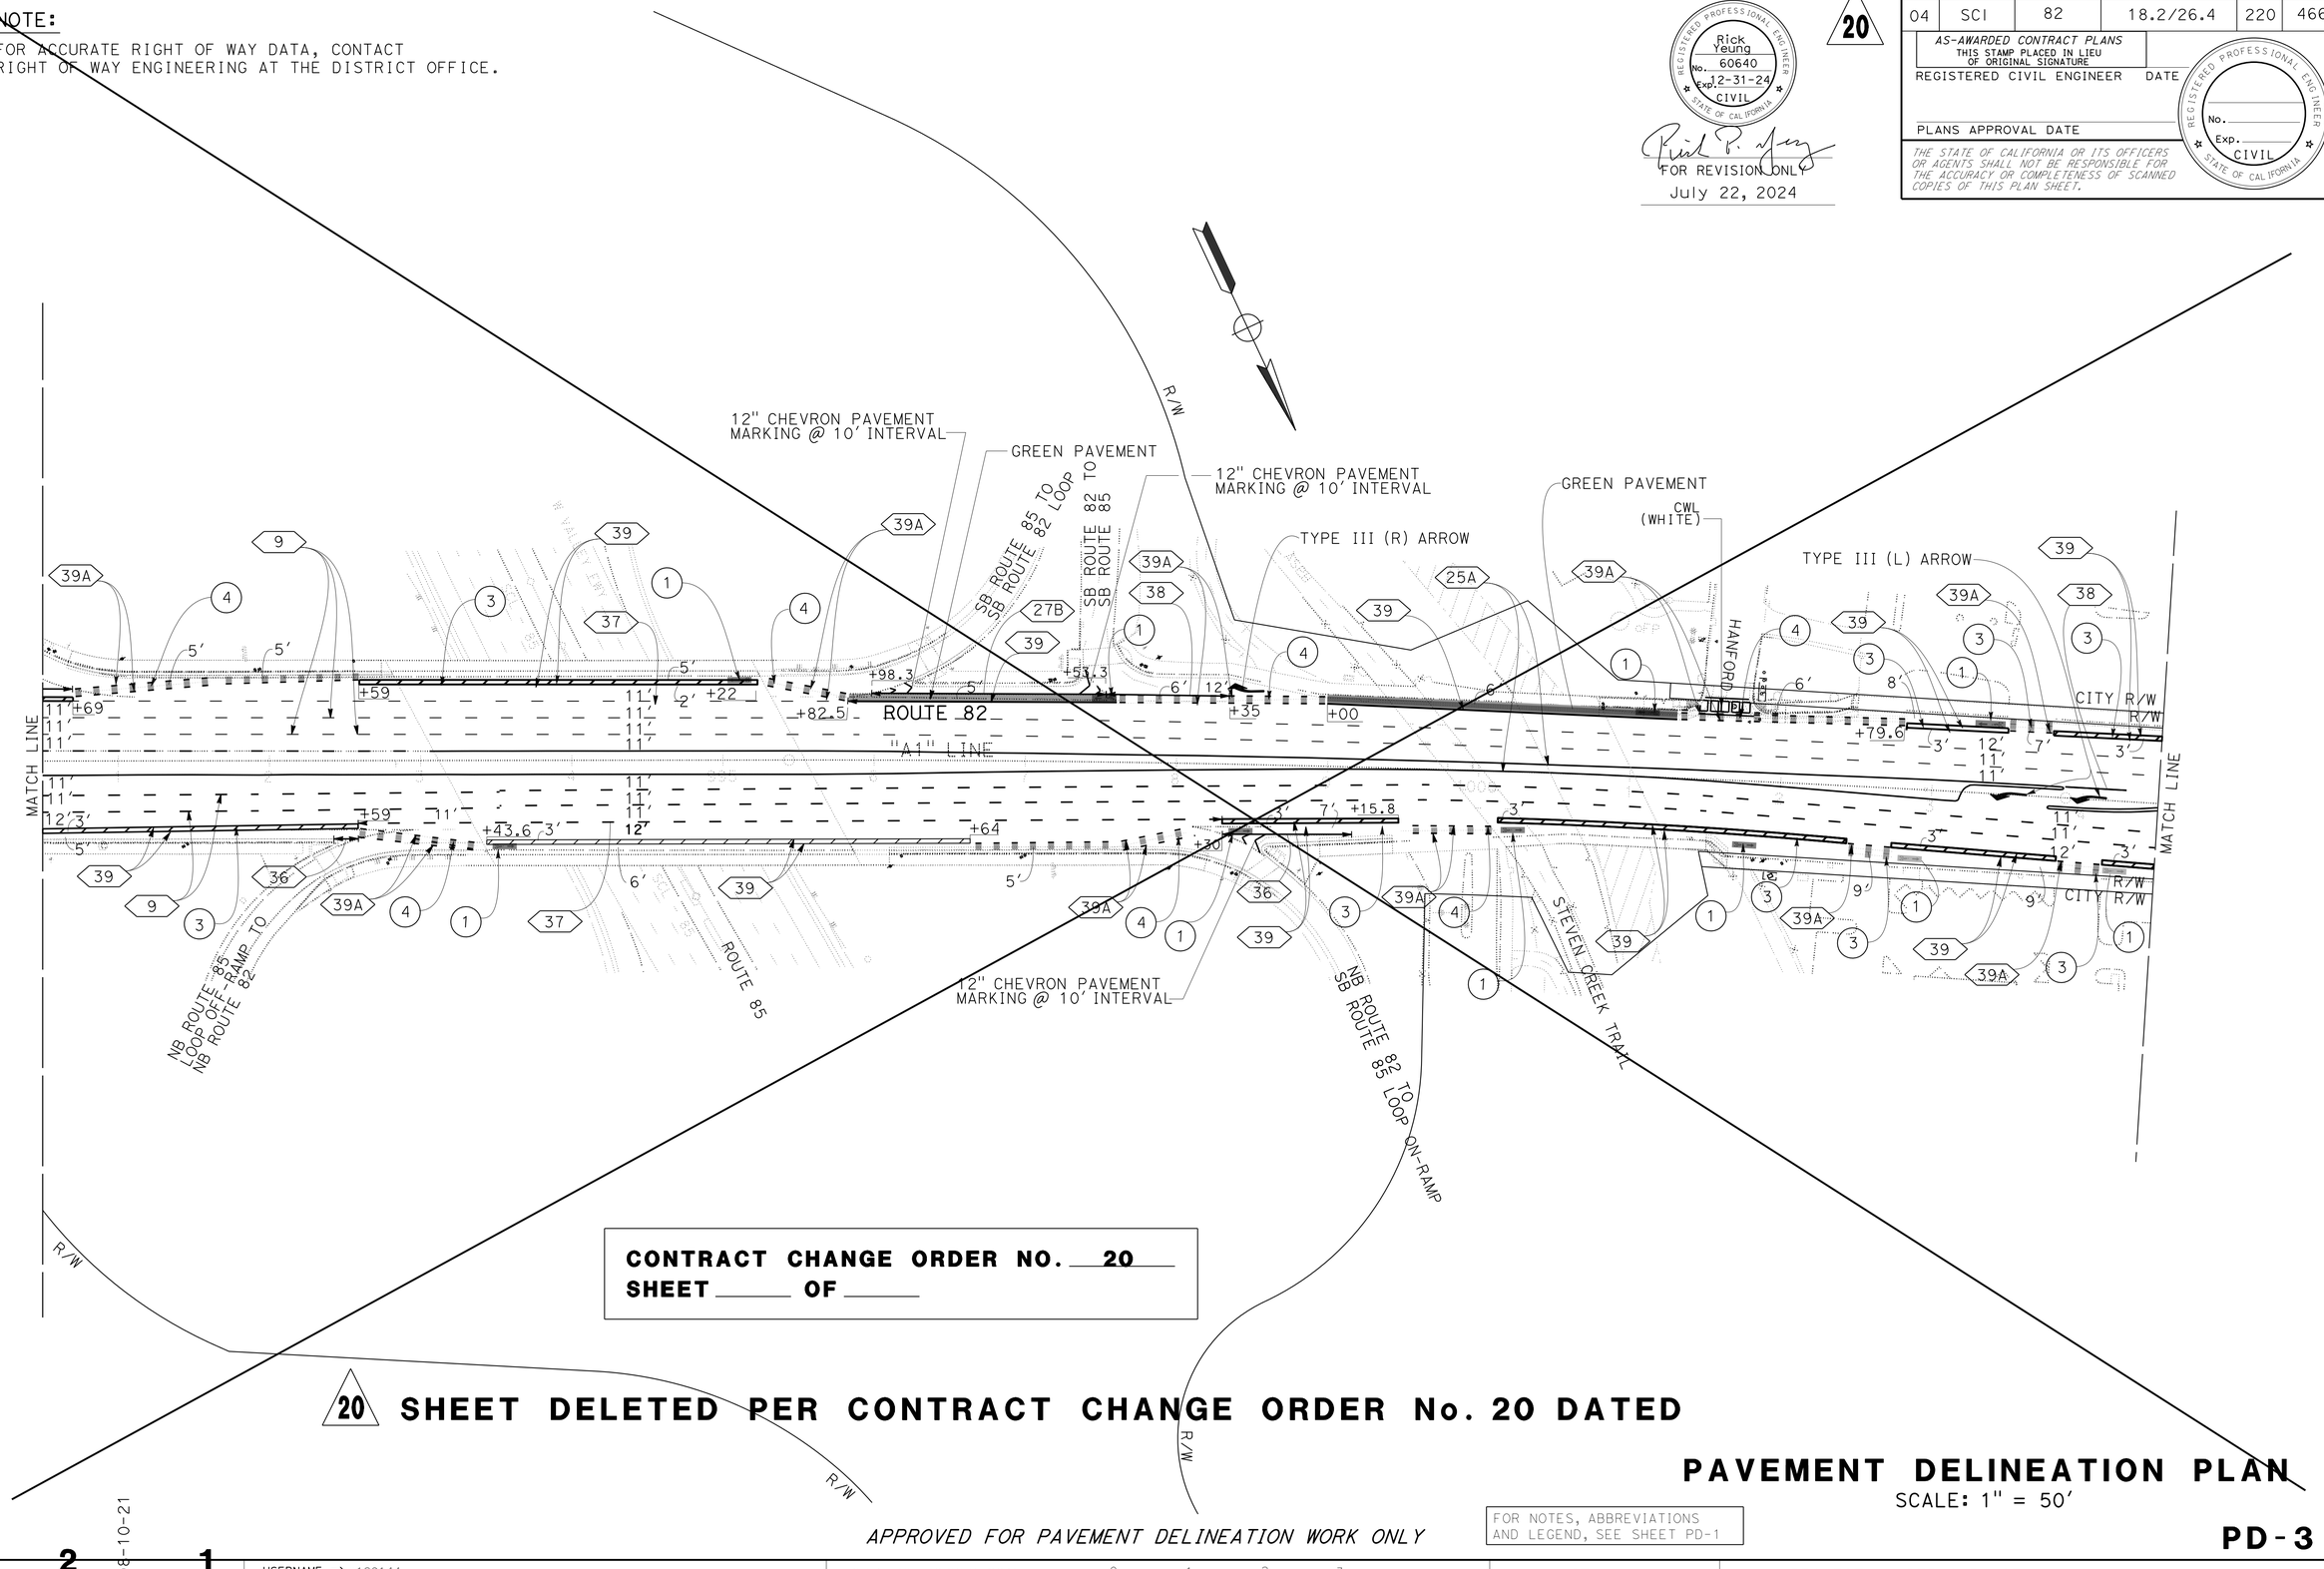

CONTRACT CHANGE ORDER NO. 20
SHEET _____ OF _____

20 **SHEET DELETED PER CONTRACT CHANGE ORDER No. 20 DATED**

08-10-21

APPROVED FOR PAVEMENT DELINEATION WORK ONLY

FOR NOTES, ABBREVIATIONS AND LEGEND, SEE SHEET PD-1

PAVEMENT DELINEATION PLAN

SCALE: 1" = 50'

PD-3

CALCULATED-DESIGNED BY: RICK YEUNG
CHECKED BY: SON LY
REVISED BY: SL
DATE REVISED: 11-18-22
FUNCTIONAL SUPERVISOR: LESTER LEE
STATE OF CALIFORNIA - DEPARTMENT OF TRANSPORTATION
Caltrans® TRAFFIC

LAST REVISION | DATE PLOTTED => 18-NOV-2024
TIME PLOTTED => 15:08

2 1

BORDER LAST REVISED 7/2/2010

USERNAME => s129144
DGN FILE => 0419000140na003.cco

RELATIVE BORDER SCALE IS IN INCHES 0 1 2 3

UNIT 0712

PROJECT NUMBER & PHASE 04190001401

NOTE:

FOR ACCURATE RIGHT OF WAY DATA, CONTACT
RIGHT OF WAY ENGINEERING AT THE DISTRICT OFFICE.

REGISTERED PROFESSIONAL ENGINEER
Rick Yeung
No. 60640
Exp. 12-31-24
CIVIL
STATE OF CALIFORNIA

Rick P. Yeung

FOR REVISION ONLY
July 22, 2024

20

Dist	COUNTY	ROUTE	POST MILES TOTAL PROJECT	SHEET No.	TOTAL SHEETS
04	SCI	82	18.2/26.4	220A	466


AS-AWARDED CONTRACT PLANS
THIS STAMP PLACED IN LIEU OF ORIGINAL SIGNATURE

REGISTERED CIVIL ENGINEER DATE

January 20, 2023
PLANS APPROVAL DATE

REGISTERED PROFESSIONAL ENGINEER
No.
Exp.
CIVIL
STATE OF CALIFORNIA

THE STATE OF CALIFORNIA OR ITS OFFICERS OR AGENTS SHALL NOT BE RESPONSIBLE FOR THE ACCURACY OR COMPLETENESS OF SCANNED COPIES OF THIS PLAN SHEET.

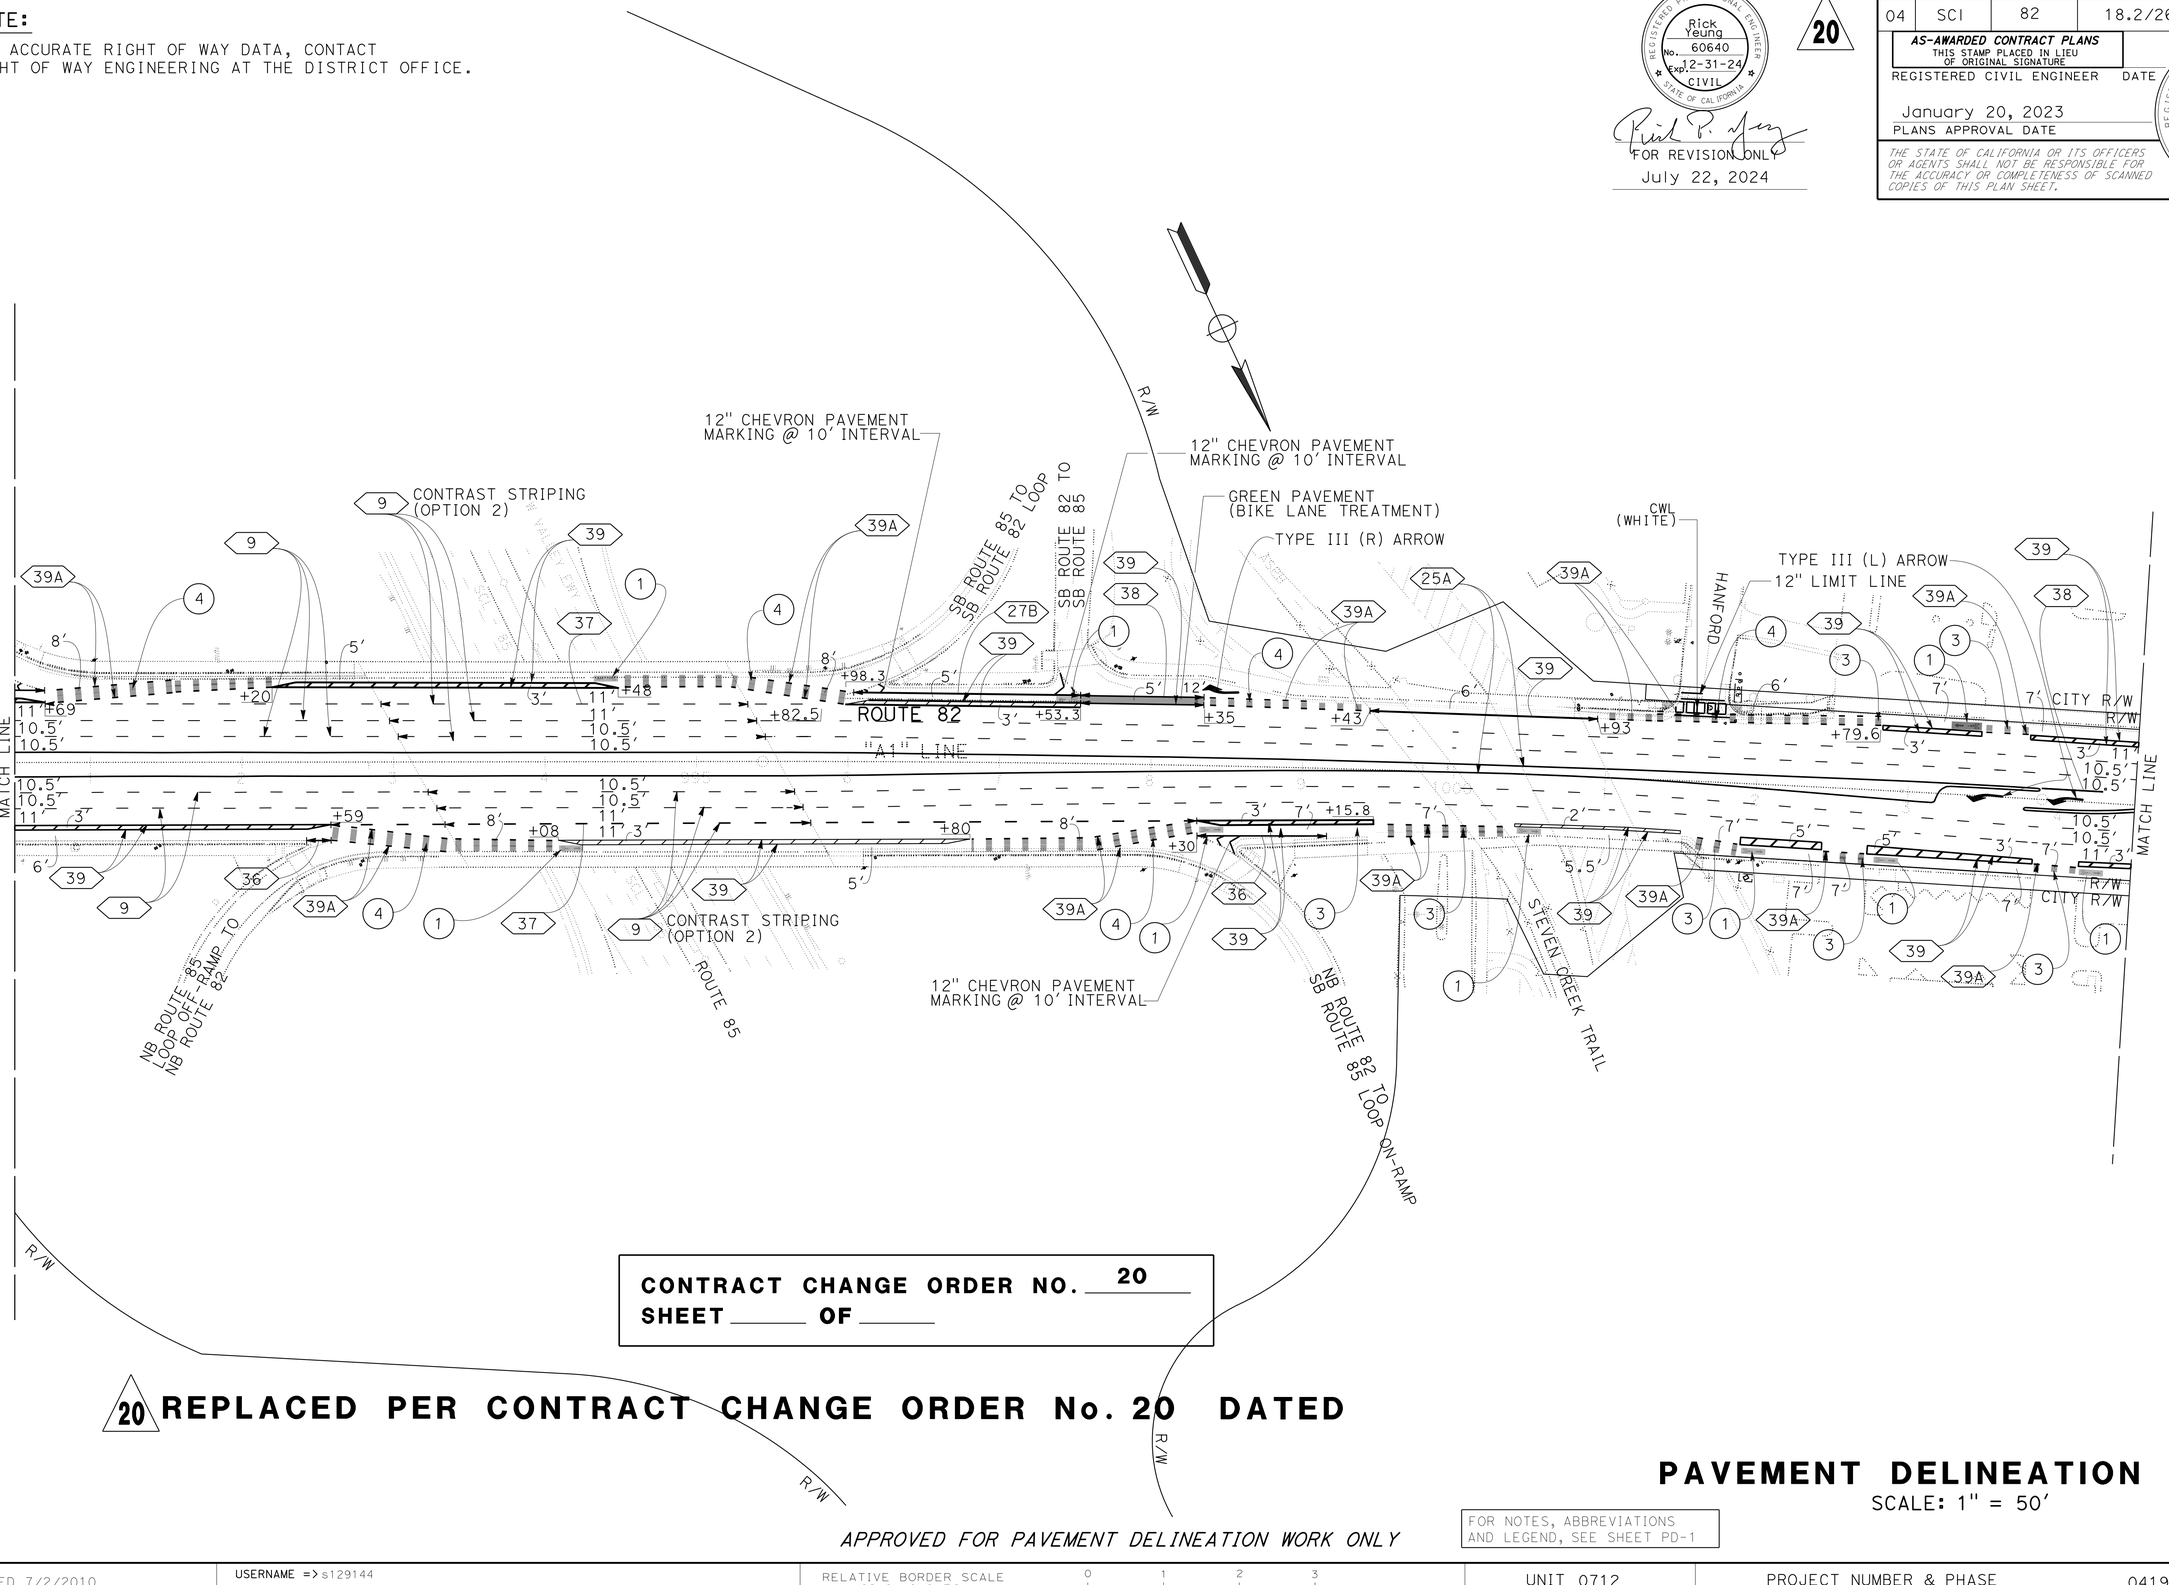

CONTRACT CHANGE ORDER NO. 20
SHEET _____ OF _____

20 REPLACED PER CONTRACT CHANGE ORDER No. 20 DATED

APPROVED FOR PAVEMENT DELINEATION WORK ONLY

FOR NOTES, ABBREVIATIONS AND LEGEND, SEE SHEET PD-1

PAVEMENT DELINEATION PLAN

SCALE: 1" = 50'

PD-3A

REVISED BY	RICK YEUNG	CALCULATED-DESIGNED BY	FUNCTIONAL SUPERVISOR	STATE OF CALIFORNIA - DEPARTMENT OF TRANSPORTATION	TRAFFIC
DATE REVISED	SON LY	CHECKED BY	LESTER LEE	Caltrans	
11-18-22					

LAST REVISION: DATE PLOTTED => 18-NOV-2024
09-15-22 TIME PLOTTED => 15:08

BORDER LAST REVISED 7/2/2010 | USERNAME => s129144 | DGN FILE => 0419000140na003A.cco | RELATIVE BORDER SCALE IS IN INCHES 0 1 2 3 | UNIT 0712 | PROJECT NUMBER & PHASE 04190001401

NOTE:

FOR ACCURATE RIGHT OF WAY DATA, CONTACT
RIGHT OF WAY ENGINEERING AT THE DISTRICT OFFICE.

REGISTERED PROFESSIONAL ENGINEER
Rick Yeung
No. 60640
Exp. 12-31-24
CIVIL
STATE OF CALIFORNIA

FOR REVISION ONLY
July 22, 2024

20

Dist	COUNTY	ROUTE	POST MILES TOTAL PROJECT	SHEET No.	TOTAL SHEETS
04	SCI	82	18.2/26.4	221	466


AS-AWARDED CONTRACT PLANS
THIS STAMP PLACED IN LIEU OF ORIGINAL SIGNATURE

REGISTERED CIVIL ENGINEER DATE

PLANS APPROVAL DATE

REGISTERED PROFESSIONAL ENGINEER
No.
Exp.
CIVIL
STATE OF CALIFORNIA

THE STATE OF CALIFORNIA OR ITS OFFICERS OR AGENTS SHALL NOT BE RESPONSIBLE FOR THE ACCURACY OR COMPLETENESS OF SCANNED COPIES OF THIS PLAN SHEET.

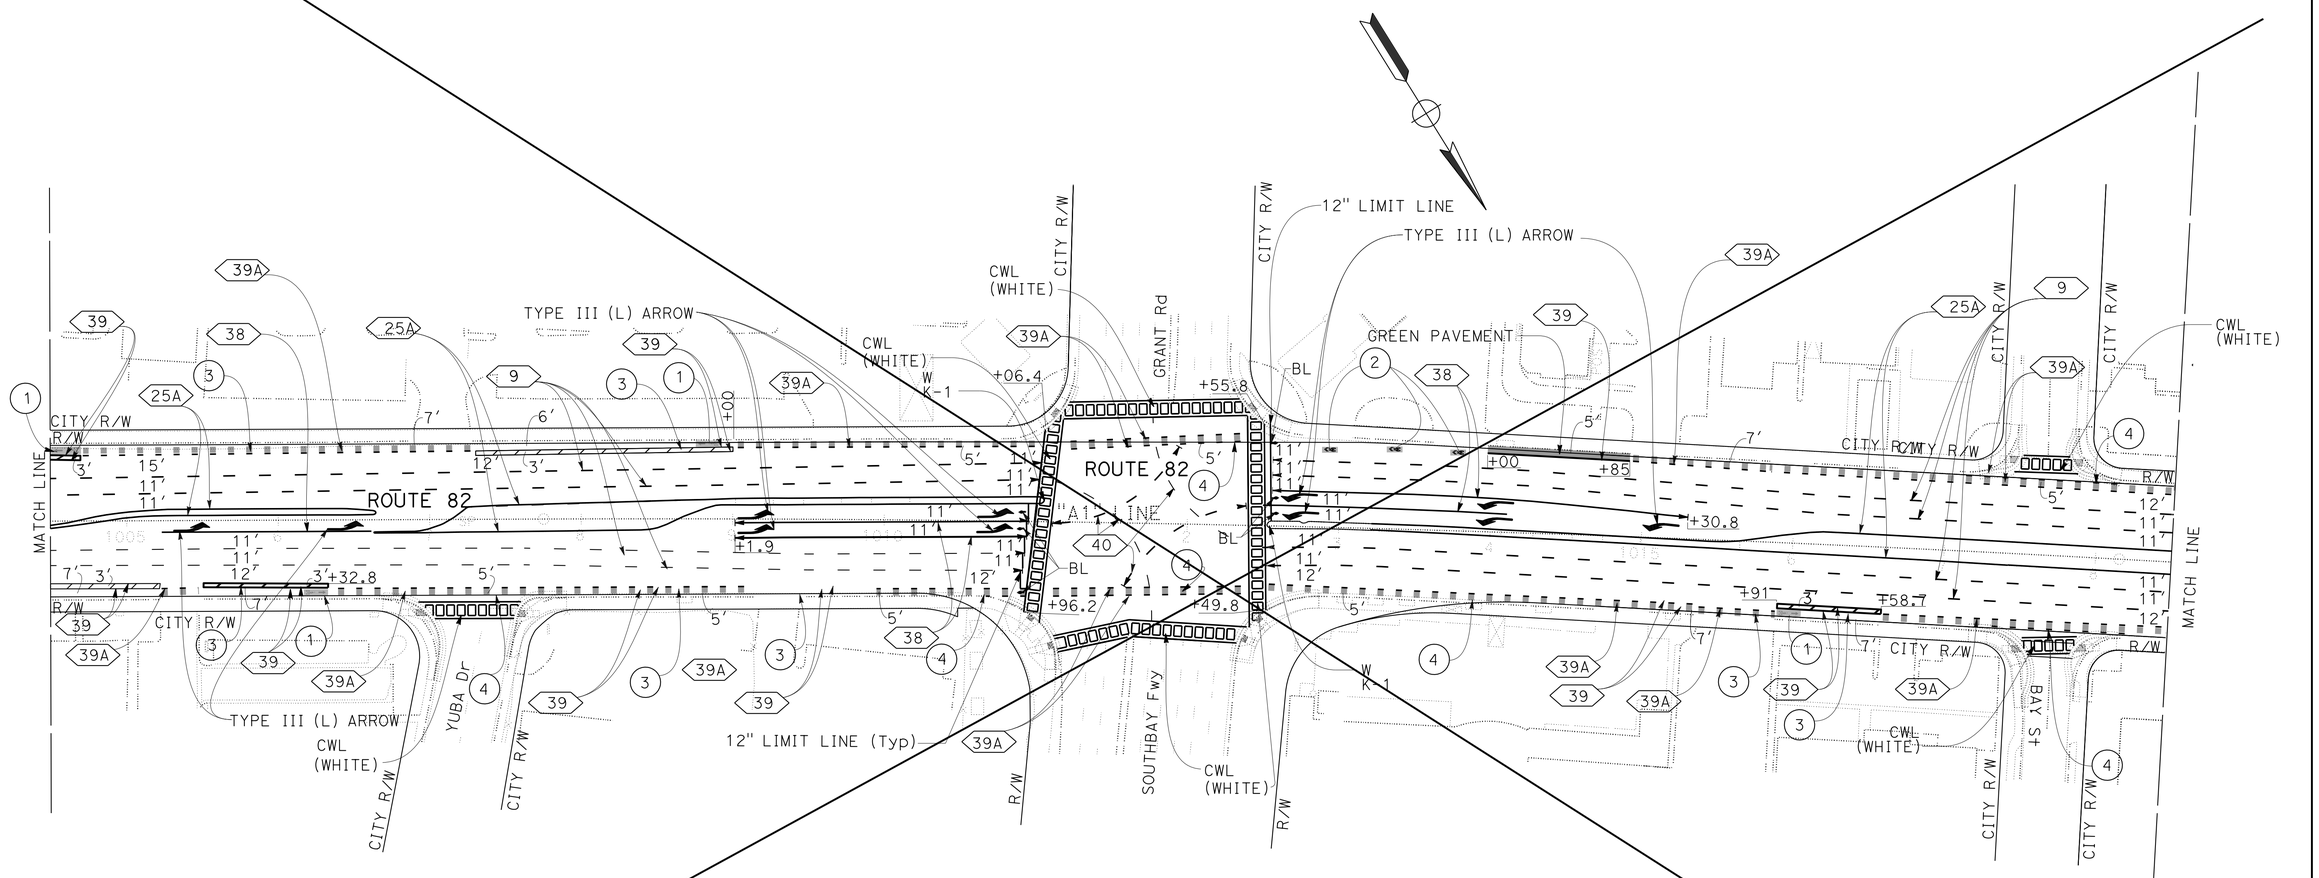

CONTRACT CHANGE ORDER NO. 20
SHEET _____ OF _____

20 **SHEET DELETED PER CONTRACT CHANGE ORDER No. 20 DATED**

PAVEMENT DELINEATION PLAN

SCALE: 1" = 50'

APPROVED FOR PAVEMENT DELINEATION WORK ONLY

FOR NOTES, ABBREVIATIONS AND LEGEND, SEE SHEET PD-1

PD-4

REVISED BY	DATE REVISED
SL	11-18-22

CALCULATED-DESIGNED BY: RICK YEUNG
CHECKED BY: SON LY
FUNCTIONAL SUPERVISOR: LESTER LEE

STATE OF CALIFORNIA - DEPARTMENT OF TRANSPORTATION
Caltrans®
TRAFFIC

LAST REVISION: DATE PLOTTED => 18-NOV-2024, TIME PLOTTED => 15:08
09-15-22

BORDER LAST REVISED 7/2/2010

USERNAME => s129144
DGN FILE => 0419000140na004.cco

RELATIVE BORDER SCALE IS IN INCHES 0 1 2 3

UNIT 0712

PROJECT NUMBER & PHASE 04190001401

NOTE:

FOR ACCURATE RIGHT OF WAY DATA, CONTACT
RIGHT OF WAY ENGINEERING AT THE DISTRICT OFFICE.

REGISTERED PROFESSIONAL ENGINEER
Rick Yeung
No. 60640
Exp. 12-31-24
CIVIL
STATE OF CALIFORNIA

FOR REVISION ONLY
July 22, 2024

20

Dist	COUNTY	ROUTE	POST MILES TOTAL PROJECT	SHEET No.	TOTAL SHEETS
04	SCI	82	18.2/26.4	221	466


AS-AWARDED CONTRACT PLANS
THIS STAMP PLACED IN LIEU OF ORIGINAL SIGNATURE

REGISTERED CIVIL ENGINEER DATE

January 20, 2023
PLANS APPROVAL DATE

REGISTERED PROFESSIONAL ENGINEER
No.
Exp.
CIVIL
STATE OF CALIFORNIA

THE STATE OF CALIFORNIA OR ITS OFFICERS OR AGENTS SHALL NOT BE RESPONSIBLE FOR THE ACCURACY OR COMPLETENESS OF SCANNED COPIES OF THIS PLAN SHEET.

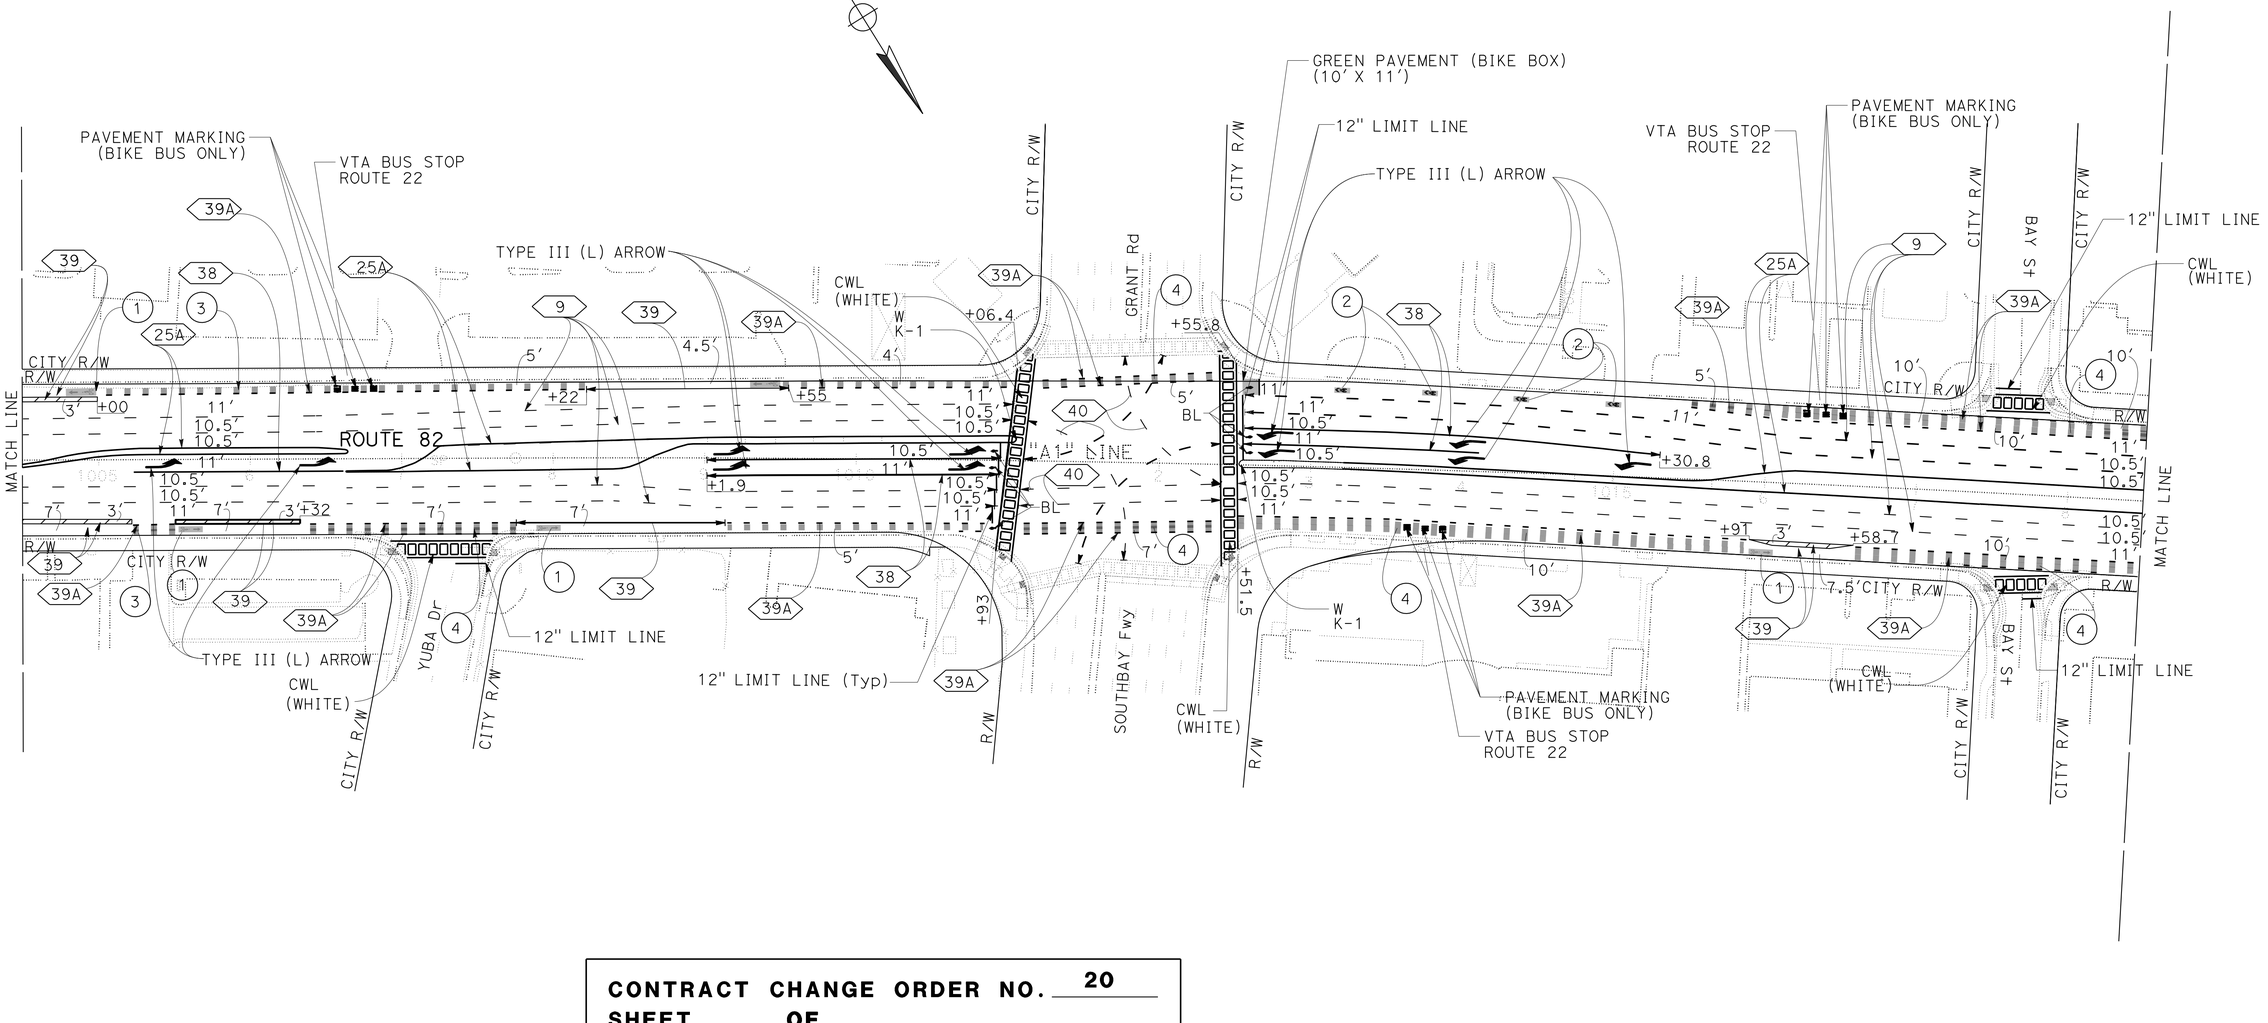

CONTRACT CHANGE ORDER NO. 20
SHEET _____ OF _____

20 REPLACED PER CONTRACT CHANGE ORDER No. 20 DATED

PAVEMENT DELINEATION PLAN

SCALE: 1" = 50'

APPROVED FOR PAVEMENT DELINEATION WORK ONLY

FOR NOTES, ABBREVIATIONS AND LEGEND, SEE SHEET PD-1

PD-4A

STATE OF CALIFORNIA - DEPARTMENT OF TRANSPORTATION
TRAFFIC
Caltrans

CALCULATED-DESIGNED BY	CHECKED BY	FUNCTIONAL SUPERVISOR
SON LY	RICK YEUNG	LESTER LEE

REVISED BY	DATE REVISED
SL	11-18-22

LAST REVISION DATE PLOTTED => 18-NOV-2024
TIME PLOTTED => 15:08
09-15-22

BORDER LAST REVISED 7/2/2010

USERNAME => s129144
DGN FILE => 0419000140na004A.cco

RELATIVE BORDER SCALE IS IN INCHES 0 1 2 3

UNIT 0712

PROJECT NUMBER & PHASE 04190001401

NOTE:

FOR ACCURATE RIGHT OF WAY DATA, CONTACT
RIGHT OF WAY ENGINEERING AT THE DISTRICT OFFICE.

REGISTERED PROFESSIONAL ENGINEER
Rick Yeung
No. 60640
Exp. 12-31-24
CIVIL
STATE OF CALIFORNIA

FOR REVISION ONLY
July 22, 2024

20

Dist	COUNTY	ROUTE	POST MILES TOTAL PROJECT	SHEET No.	TOTAL SHEETS
04	SCI	82	18.2/26.4	222	466


AS-AWARDED CONTRACT PLANS
THIS STAMP PLACED IN LIEU OF ORIGINAL SIGNATURE

REGISTERED CIVIL ENGINEER DATE

PLANS APPROVAL DATE

REGISTERED PROFESSIONAL ENGINEER
No.
Exp.
CIVIL
STATE OF CALIFORNIA

THE STATE OF CALIFORNIA OR ITS OFFICERS OR AGENTS SHALL NOT BE RESPONSIBLE FOR THE ACCURACY OR COMPLETENESS OF SCANNED COPIES OF THIS PLAN SHEET.

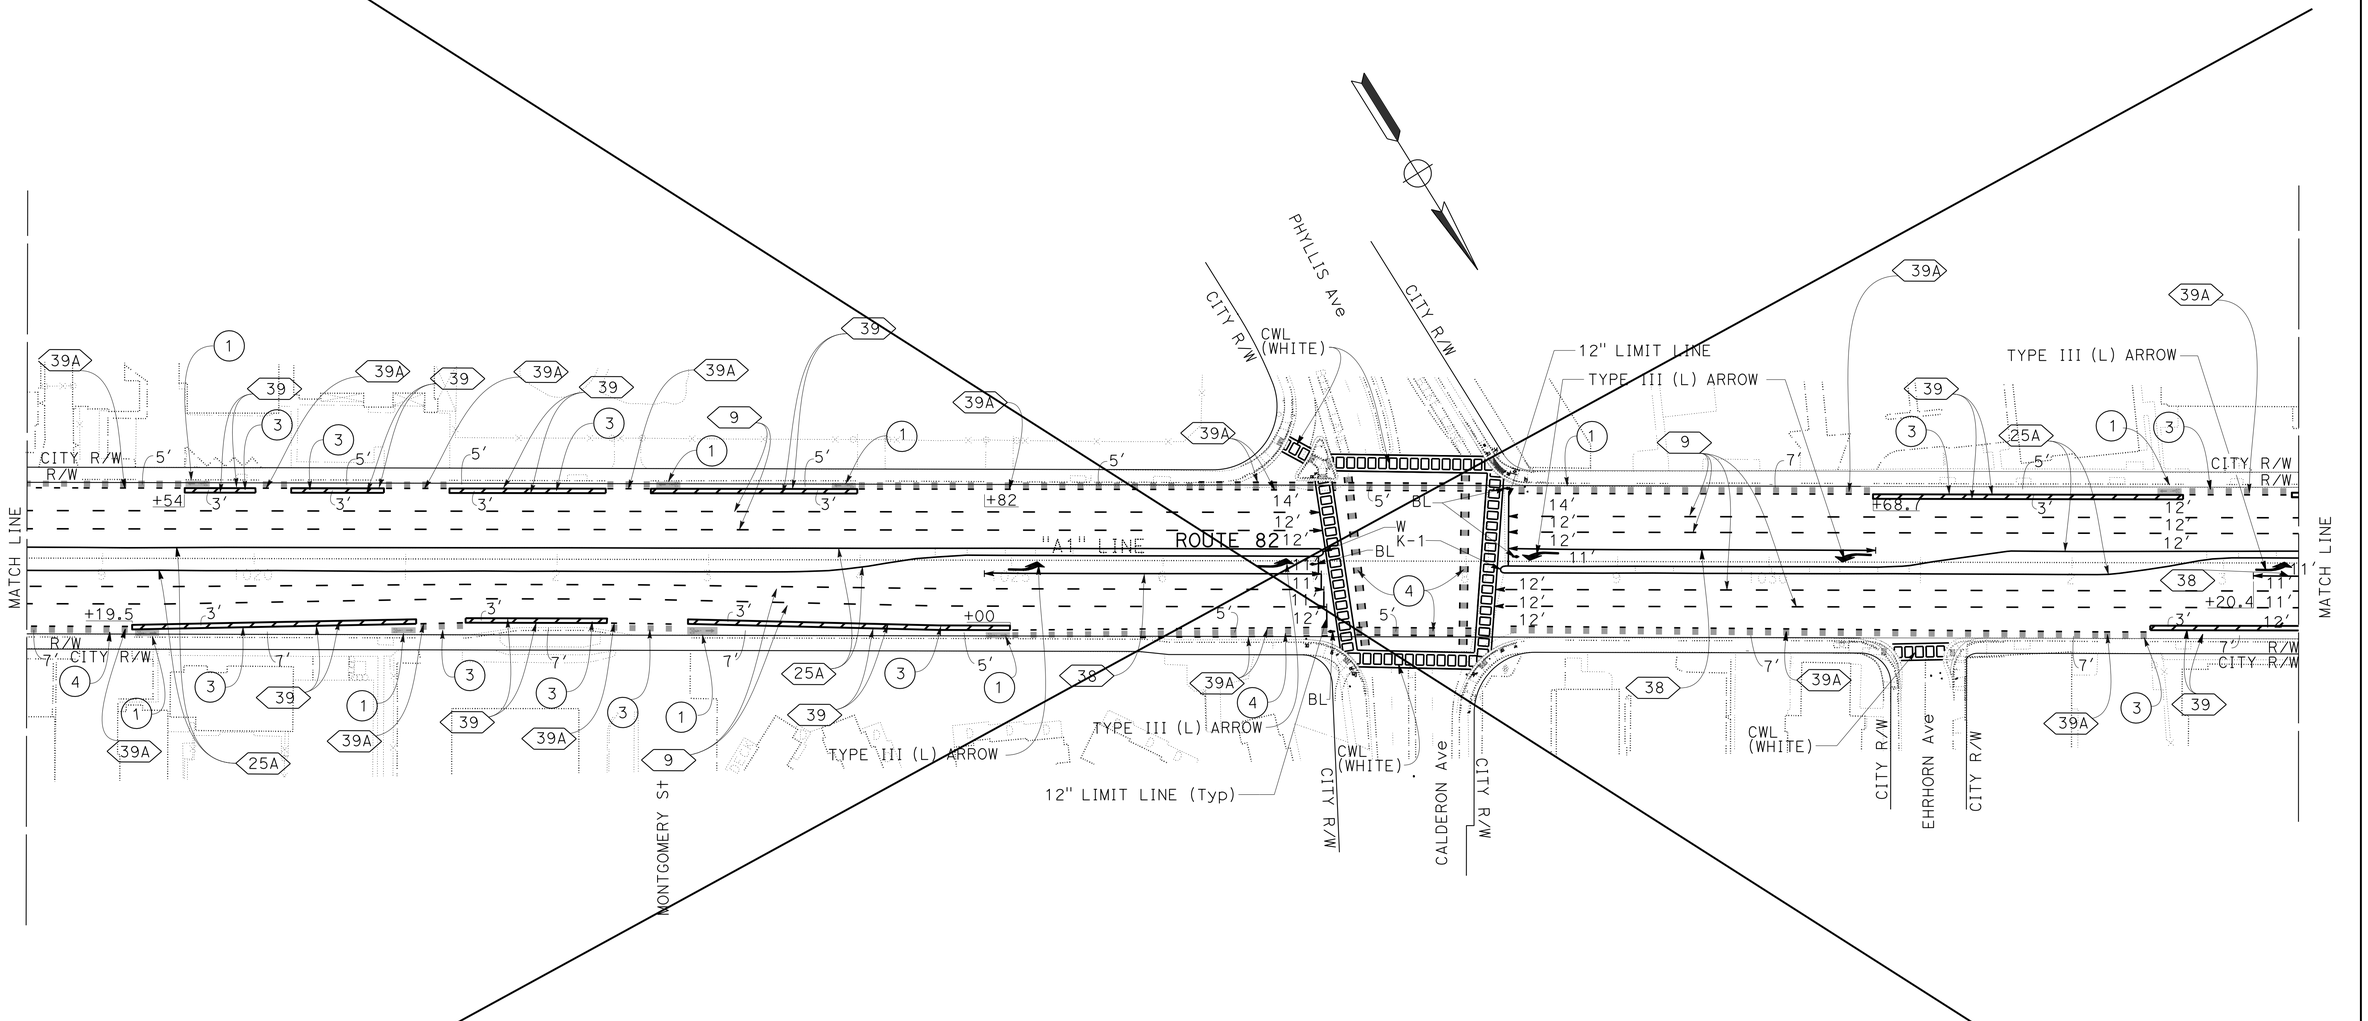

CONTRACT CHANGE ORDER NO. 20
SHEET _____ OF _____

20 **SHEET DELETED PER CONTRACT CHANGE ORDER No. 20 DATED**

PAVEMENT DELINEATION PLAN

SCALE: 1" = 50'

APPROVED FOR PAVEMENT DELINEATION WORK ONLY

FOR NOTES, ABBREVIATIONS AND LEGEND, SEE SHEET PD-1

PD-5

CALCULATED-DESIGNED BY		REVISED BY	
CHECKED BY		DATE REVISED	11-18-22
RICK YEUNG			
SON LY			
FUNCTIONAL SUPERVISOR			
LESTER LEE			

STATE OF CALIFORNIA - DEPARTMENT OF TRANSPORTATION
TRAFFIC

LAST REVISION | DATE PLOTTED => 18-NOV-2024
09-15-22 | TIME PLOTTED => 15:08

BORDER LAST REVISED 7/2/2010 | USERNAME => s129144 | DGN FILE => 0419000140na005.cco | RELATIVE BORDER SCALE IS IN INCHES 0 1 2 3 | UNIT 0712 | PROJECT NUMBER & PHASE 04190001401

NOTE:

FOR ACCURATE RIGHT OF WAY DATA, CONTACT
RIGHT OF WAY ENGINEERING AT THE DISTRICT OFFICE.

Rick Yeung
No. 60640
Exp. 12-31-24
CIVIL
REGISTERED PROFESSIONAL ENGINEER
STATE OF CALIFORNIA

20

FOR REVISION ONLY
July 22, 2024

Dist	COUNTY	ROUTE	POST MILES TOTAL PROJECT	SHEET No.	TOTAL SHEETS
04	SCl	82	18.2/26.4	222A	466


AS-AWARDED CONTRACT PLANS
THIS STAMP PLACED IN LIEU OF ORIGINAL SIGNATURE

REGISTERED CIVIL ENGINEER DATE

January 20, 2023
PLANS APPROVAL DATE

REGISTERED PROFESSIONAL ENGINEER
No.
Exp.
CIVIL
STATE OF CALIFORNIA

THE STATE OF CALIFORNIA OR ITS OFFICERS OR AGENTS SHALL NOT BE RESPONSIBLE FOR THE ACCURACY OR COMPLETENESS OF SCANNED COPIES OF THIS PLAN SHEET.

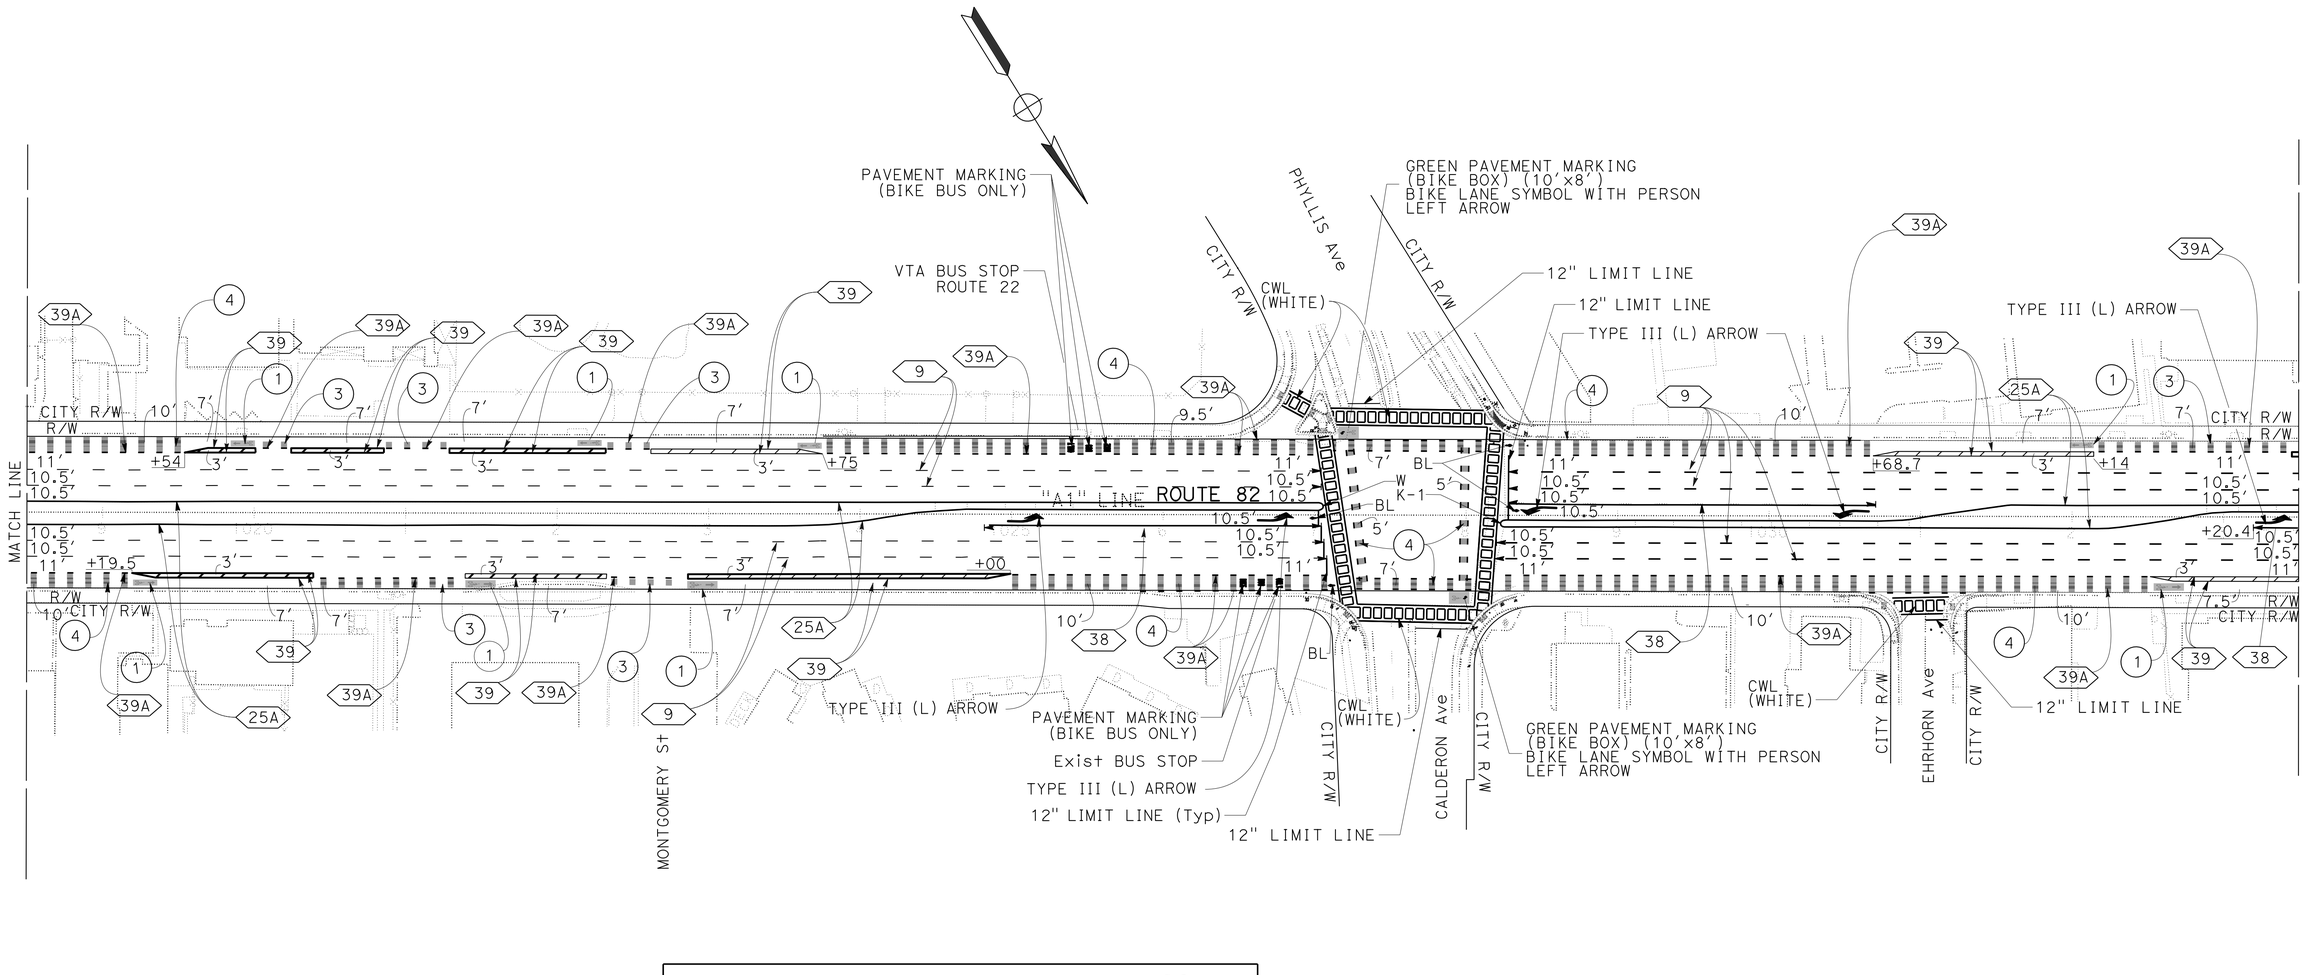

CONTRACT CHANGE ORDER NO. 20
SHEET _____ OF _____

20 REPLACED PER CONTRACT CHANGE ORDER No. 20 DATED

PAVEMENT DELINEATION PLAN

SCALE: 1" = 50'

APPROVED FOR PAVEMENT DELINEATION WORK ONLY

FOR NOTES, ABBREVIATIONS AND LEGEND, SEE SHEET PD-1

PD-5A

REVISED BY	DATE REVISED
SL	11-18-22

CALCULATED-DESIGNED BY: SON LY
CHECKED BY: RICK YEUNG
FUNCTIONAL SUPERVISOR: LESTER LEE

STATE OF CALIFORNIA - DEPARTMENT OF TRANSPORTATION
TRAFFIC

LAST REVISION | DATE PLOTTED => 18-NOV-2024
09-15-22 | TIME PLOTTED => 15:08

BORDER LAST REVISED 7/2/2010

USERNAME => s129144
DGN FILE => 0419000140na005A.cco

RELATIVE BORDER SCALE IS IN INCHES 0 1 2 3

UNIT 0712 | PROJECT NUMBER & PHASE 04190001401

NOTE:

FOR ACCURATE RIGHT OF WAY DATA, CONTACT
RIGHT OF WAY ENGINEERING AT THE DISTRICT OFFICE.

REGISTERED PROFESSIONAL ENGINEER
Rick Yeung
No. 60640
Exp. 12-31-24
CIVIL
STATE OF CALIFORNIA

FOR REVISION ONLY
July 22, 2024

20

Dist	COUNTY	ROUTE	POST MILES TOTAL PROJECT	SHEET No.	TOTAL SHEETS
04	SCI	82	18.2/26.4	223	466


AS-AWARDED CONTRACT PLANS
THIS STAMP PLACED IN LIEU OF ORIGINAL SIGNATURE

REGISTERED CIVIL ENGINEER DATE

PLANS APPROVAL DATE

REGISTERED PROFESSIONAL ENGINEER
No.
Exp.
CIVIL
STATE OF CALIFORNIA

THE STATE OF CALIFORNIA OR ITS OFFICERS OR AGENTS SHALL NOT BE RESPONSIBLE FOR THE ACCURACY OR COMPLETENESS OF SCANNED COPIES OF THIS PLAN SHEET.

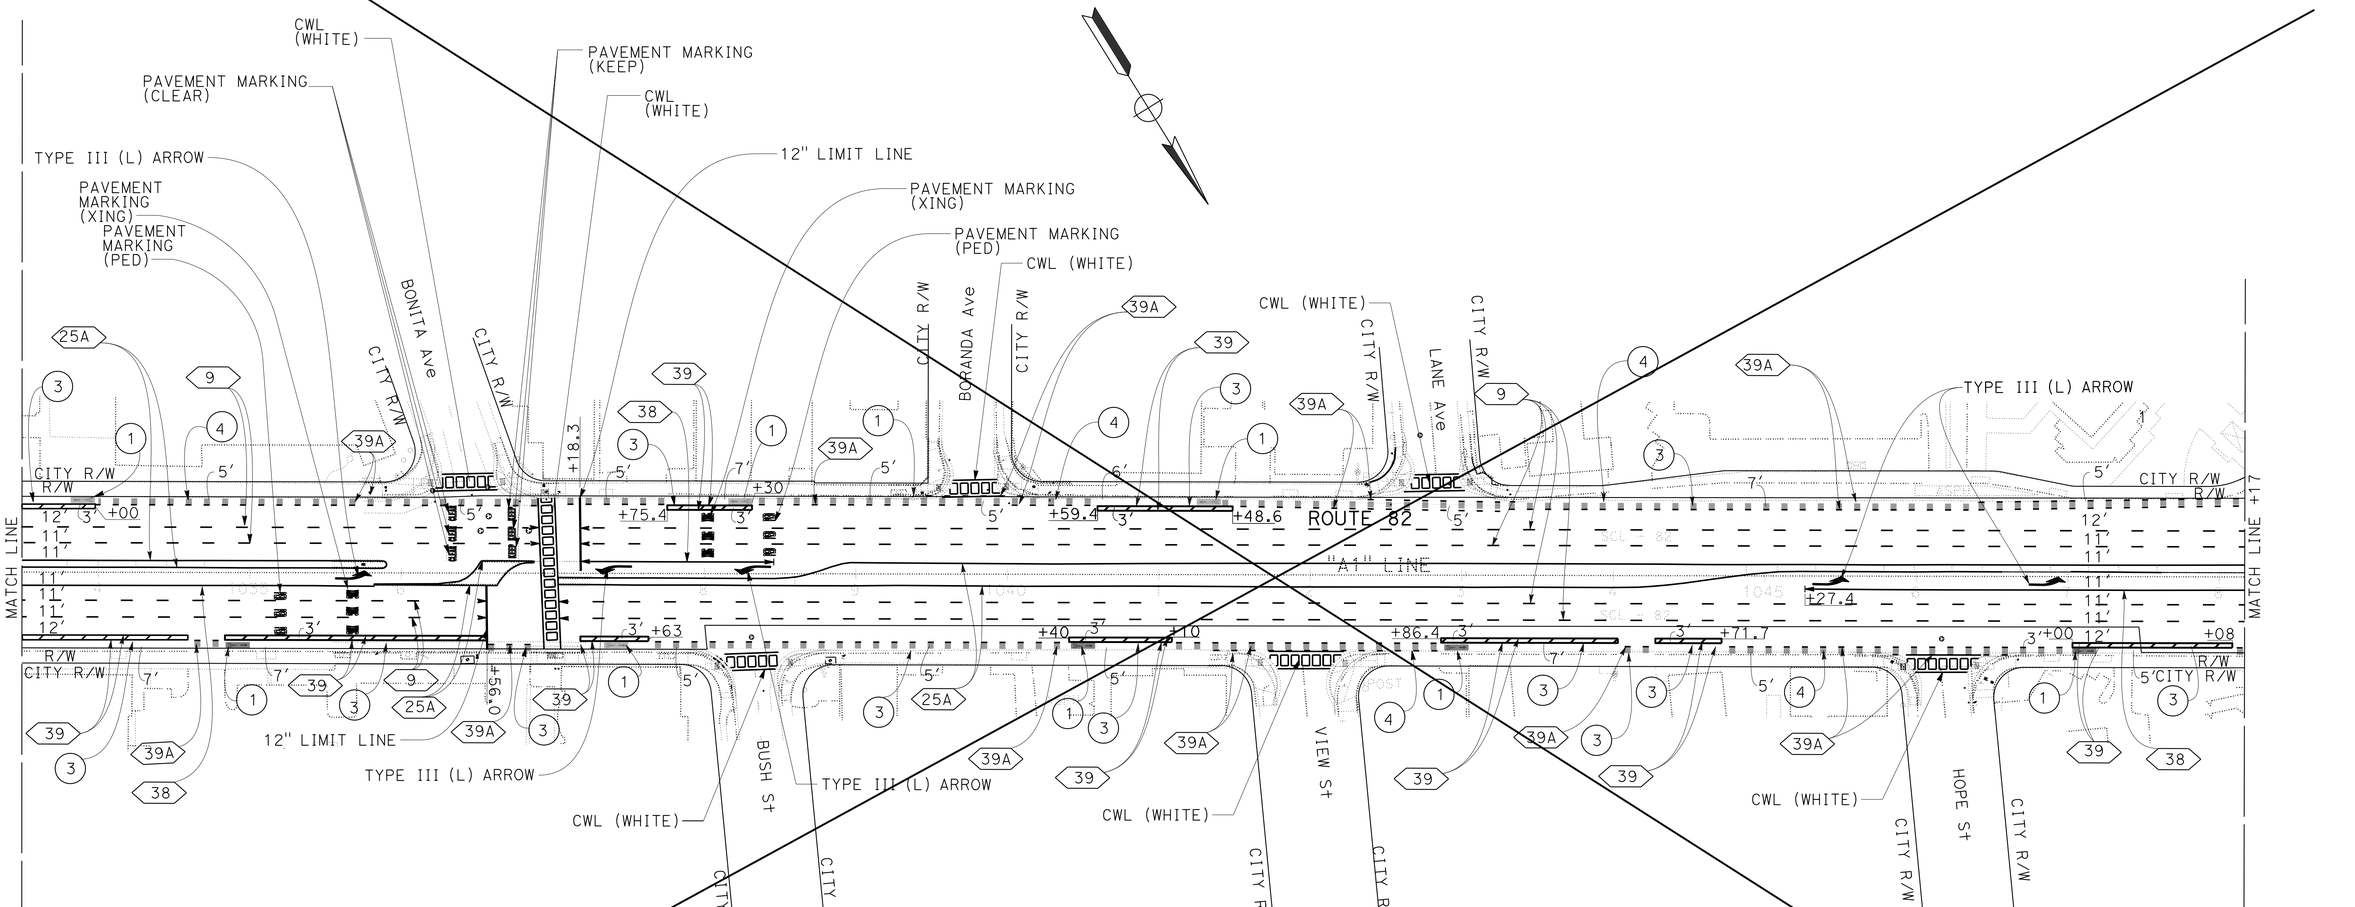

CONTRACT CHANGE ORDER NO. 20
SHEET _____ OF _____

20 **SHEET DELETED PER CONTRACT CHANGE ORDER No. 20 DATED**

PAVEMENT DELINEATION PLAN

SCALE: 1" = 50'

APPROVED FOR PAVEMENT DELINEATION WORK ONLY

FOR NOTES, ABBREVIATIONS AND LEGEND, SEE SHEET PD-1

PD-6

REVISED BY	DATE REVISED
SL	11-18-22

CALCULATED-DESIGNED BY: RICK YEUNG
CHECKED BY: SON LY
FUNCTIONAL SUPERVISOR: LESTER LEE

STATE OF CALIFORNIA - DEPARTMENT OF TRANSPORTATION
Caltrans®
TRAFFIC

LAST REVISION: DATE PLOTTED => 09-15-22
DATE PLOTTED => 18-NOV-2024
TIME PLOTTED => 15:09

BORDER LAST REVISED 7/2/2010

USERNAME => s129144
DGN FILE => 0419000140na006.cco

RELATIVE BORDER SCALE IS IN INCHES 0 1 2 3

UNIT 0712

PROJECT NUMBER & PHASE 04190001401

NOTE:

FOR ACCURATE RIGHT OF WAY DATA, CONTACT
RIGHT OF WAY ENGINEERING AT THE DISTRICT OFFICE.

REGISTERED PROFESSIONAL ENGINEER
Rick Yeung
No. 60640
Exp. 12-31-24
CIVIL
STATE OF CALIFORNIA

20

FOR REVISION ONLY
July 22, 2024

Dist	COUNTY	ROUTE	POST MILES TOTAL PROJECT	SHEET No.	TOTAL SHEETS
04	SCI	82	18.2/26.4	223	466


AS-AWARDED CONTRACT PLANS
THIS STAMP PLACED IN LIEU OF ORIGINAL SIGNATURE

REGISTERED CIVIL ENGINEER DATE

PLANS APPROVAL DATE

REGISTERED PROFESSIONAL ENGINEER
No.
Exp.
CIVIL
STATE OF CALIFORNIA

THE STATE OF CALIFORNIA OR ITS OFFICERS OR AGENTS SHALL NOT BE RESPONSIBLE FOR THE ACCURACY OR COMPLETENESS OF SCANNED COPIES OF THIS PLAN SHEET.

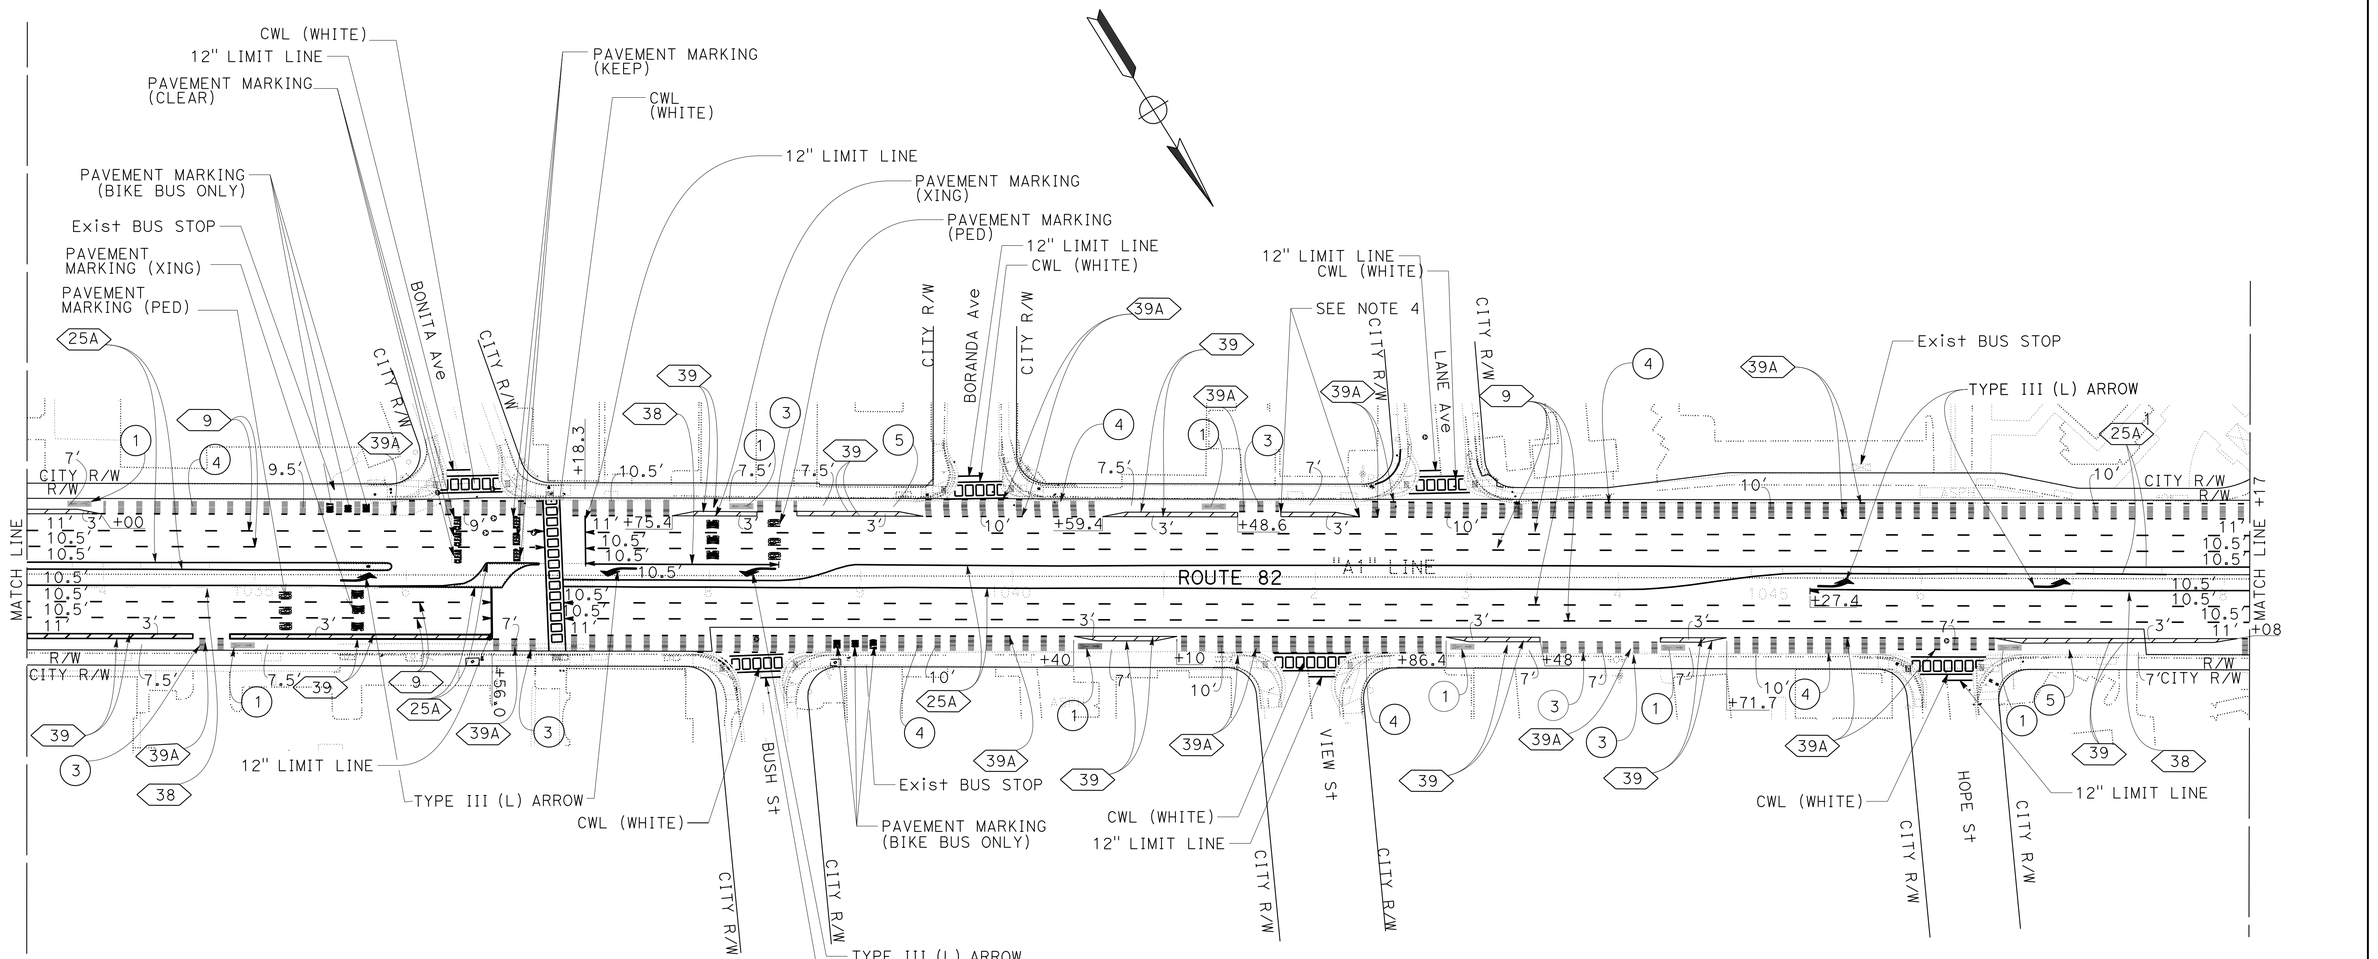

CONTRACT CHANGE ORDER NO. 20
SHEET _____ OF _____

20 REPLACED PER CONTRACT CHANGE ORDER No. 20 DATED

PAVEMENT DELINEATION PLAN

SCALE: 1" = 50′

APPROVED FOR PAVEMENT DELINEATION WORK ONLY

FOR NOTES, ABBREVIATIONS AND LEGEND, SEE SHEET PD-1

PD-6A

REVISED BY	DATE REVISED
SL	11-18-22

CALCULATED-DESIGNED BY: SON LY
CHECKED BY: RICK YEUNG
FUNCTIONAL SUPERVISOR: LESTER LEE

STATE OF CALIFORNIA - DEPARTMENT OF TRANSPORTATION
Caltrans®
TRAFFIC

LAST REVISION: DATE PLOTTED => 18-NOV-2024, TIME PLOTTED => 15:09
09-15-22

BORDER LAST REVISED 7/2/2010

USERNAME => s129144
DGN FILE => 0419000140na006A.cco

RELATIVE BORDER SCALE IS IN INCHES 0 1 2 3

UNIT 0712 | PROJECT NUMBER & PHASE 04190001401

NOTE:

FOR ACCURATE RIGHT OF WAY DATA, CONTACT
RIGHT OF WAY ENGINEERING AT THE DISTRICT OFFICE.

Dist	COUNTY	ROUTE	POST MILES TOTAL PROJECT	SHEET No.	TOTAL SHEETS
04	SCI	82	18.2/26.4	224	466

AS-AWARDED CONTRACT PLANS
THIS STAMP PLACED IN LIEU OF ORIGINAL SIGNATURE

REGISTERED CIVIL ENGINEER DATE


PLANS APPROVAL DATE

THE STATE OF CALIFORNIA OR ITS OFFICERS OR AGENTS SHALL NOT BE RESPONSIBLE FOR THE ACCURACY OR COMPLETENESS OF SCANNED COPIES OF THIS PLAN SHEET.

Rick Yeung No. 60640 Exp. 12-31-24 CIVIL
REGISTERED PROFESSIONAL ENGINEER STATE OF CALIFORNIA

20

FOR REVISION ONLY
July 22, 2024

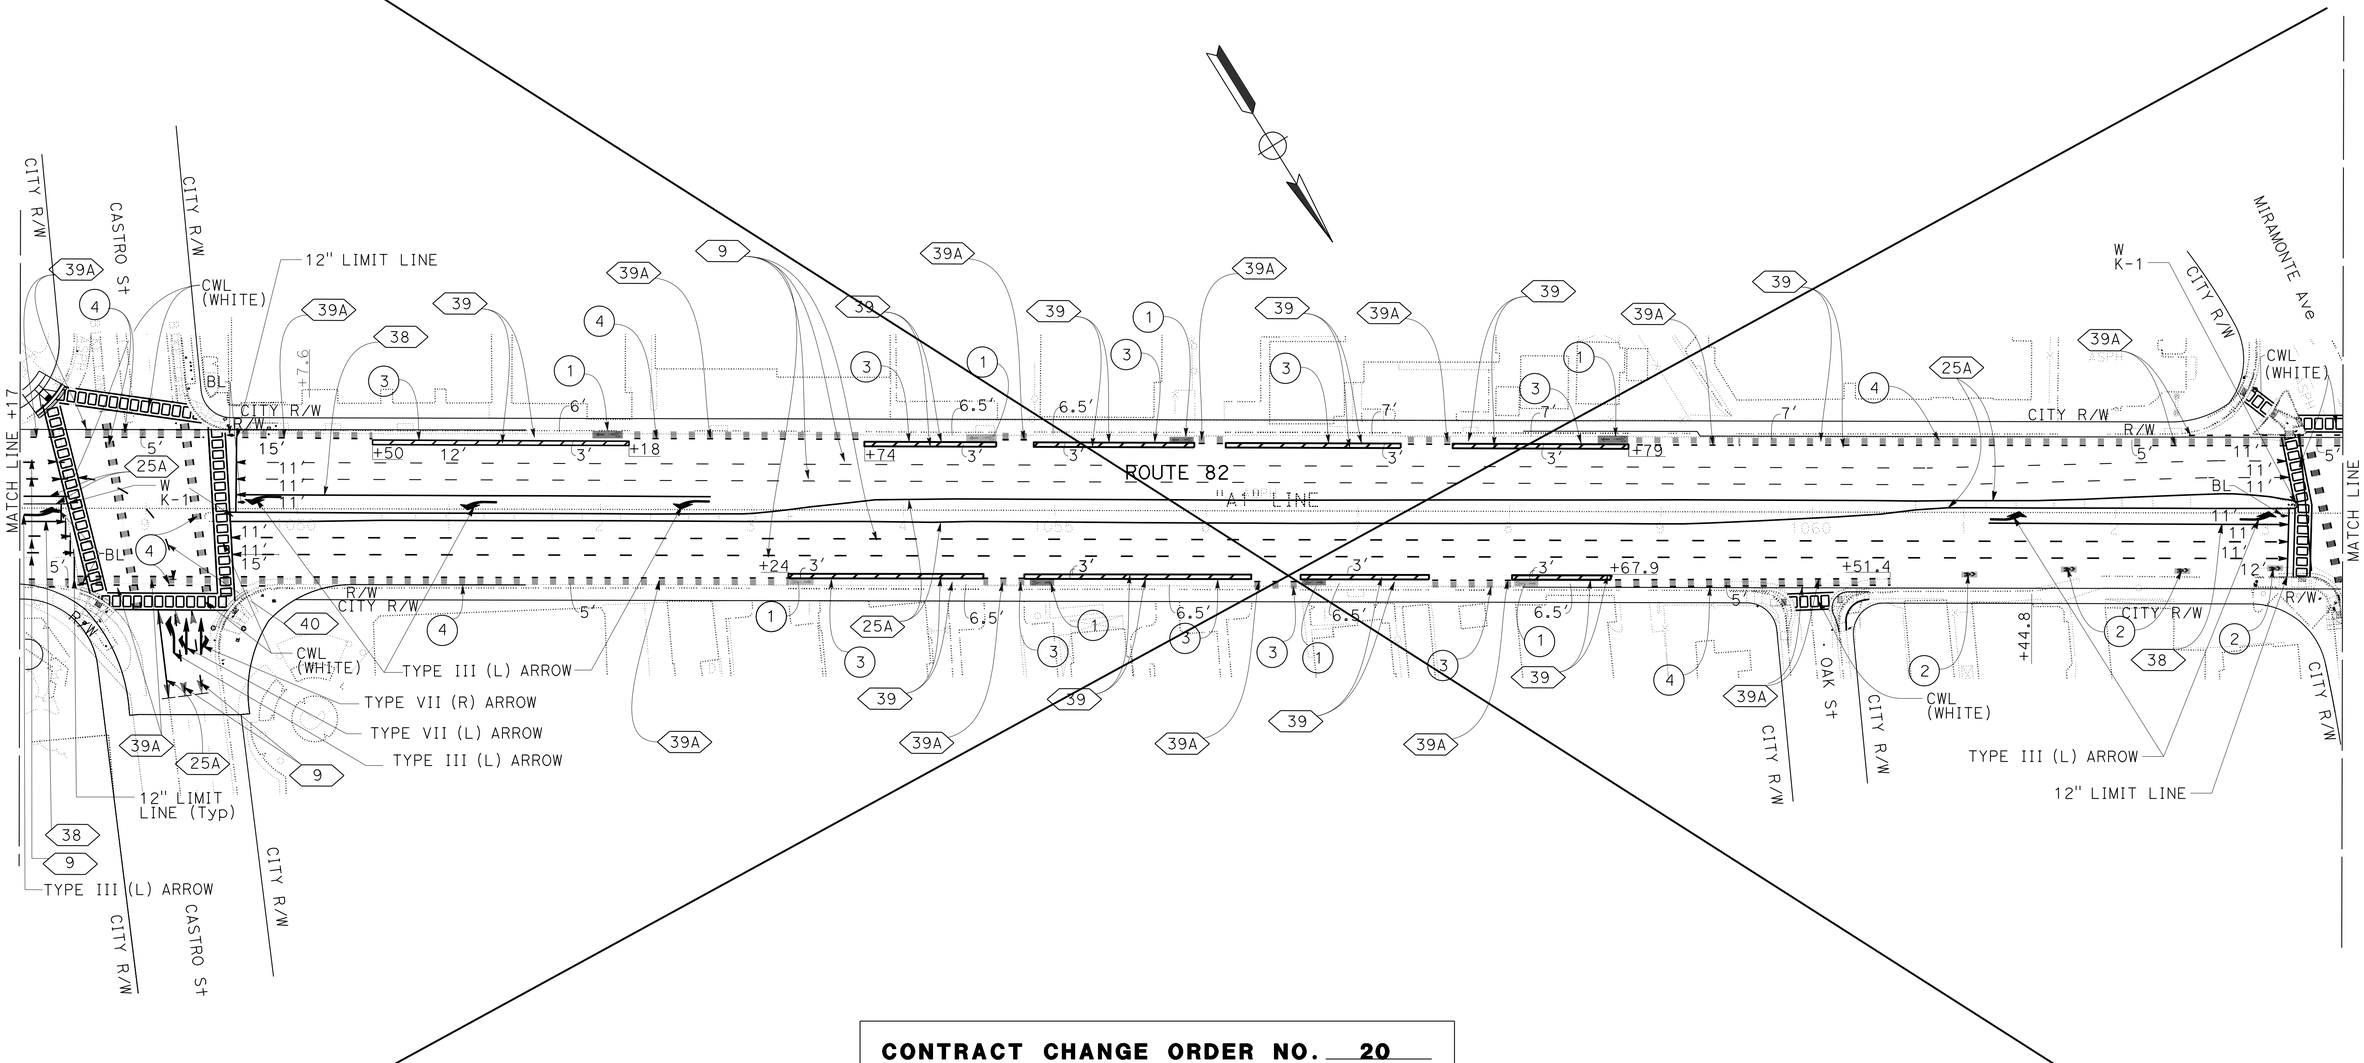

CONTRACT CHANGE ORDER NO. 20
SHEET _____ OF _____

20 **SHEET DELETED PER CONTRACT CHANGE ORDER No. 20 DATED**

PAVEMENT DELINEATION PLAN

SCALE: 1" = 50'

APPROVED FOR PAVEMENT DELINEATION WORK ONLY

FOR NOTES, ABBREVIATIONS AND LEGEND, SEE SHEET PD-1

PD-7

REVISED BY	DATE REVISED
SL	11-18-22

CALCULATED-DESIGNED BY: RICK YEUNG
CHECKED BY: SON LY
FUNCTIONAL SUPERVISOR: LESTER LEE

STATE OF CALIFORNIA - DEPARTMENT OF TRANSPORTATION
TRAFFIC
Caltrans

LAST REVISION DATE PLOTTED => 18-NOV-2024
TIME PLOTTED => 15:09

BORDER LAST REVISED 7/2/2010
USERNAME => s129144
DGN FILE => 0419000140na007.cco
RELATIVE BORDER SCALE IS IN INCHES 0 1 2 3
UNIT 0712
PROJECT NUMBER & PHASE 04190001401

NOTE:

FOR ACCURATE RIGHT OF WAY DATA, CONTACT
RIGHT OF WAY ENGINEERING AT THE DISTRICT OFFICE.

REGISTERED PROFESSIONAL ENGINEER
Rick Yeung
No. 60640
Exp. 12-31-24
CIVIL
STATE OF CALIFORNIA

20

FOR REVISION ONLY
July 22, 2024

Dist	COUNTY	ROUTE	POST MILES TOTAL PROJECT	SHEET No.	TOTAL SHEETS
04	SCI	82	18.2/26.4	224	466


AS-AWARDED CONTRACT PLANS
THIS STAMP PLACED IN LIEU OF ORIGINAL SIGNATURE

REGISTERED CIVIL ENGINEER DATE

January 20, 2023
PLANS APPROVAL DATE

REGISTERED PROFESSIONAL ENGINEER
No.
Exp.
CIVIL
STATE OF CALIFORNIA

THE STATE OF CALIFORNIA OR ITS OFFICERS OR AGENTS SHALL NOT BE RESPONSIBLE FOR THE ACCURACY OR COMPLETENESS OF SCANNED COPIES OF THIS PLAN SHEET.

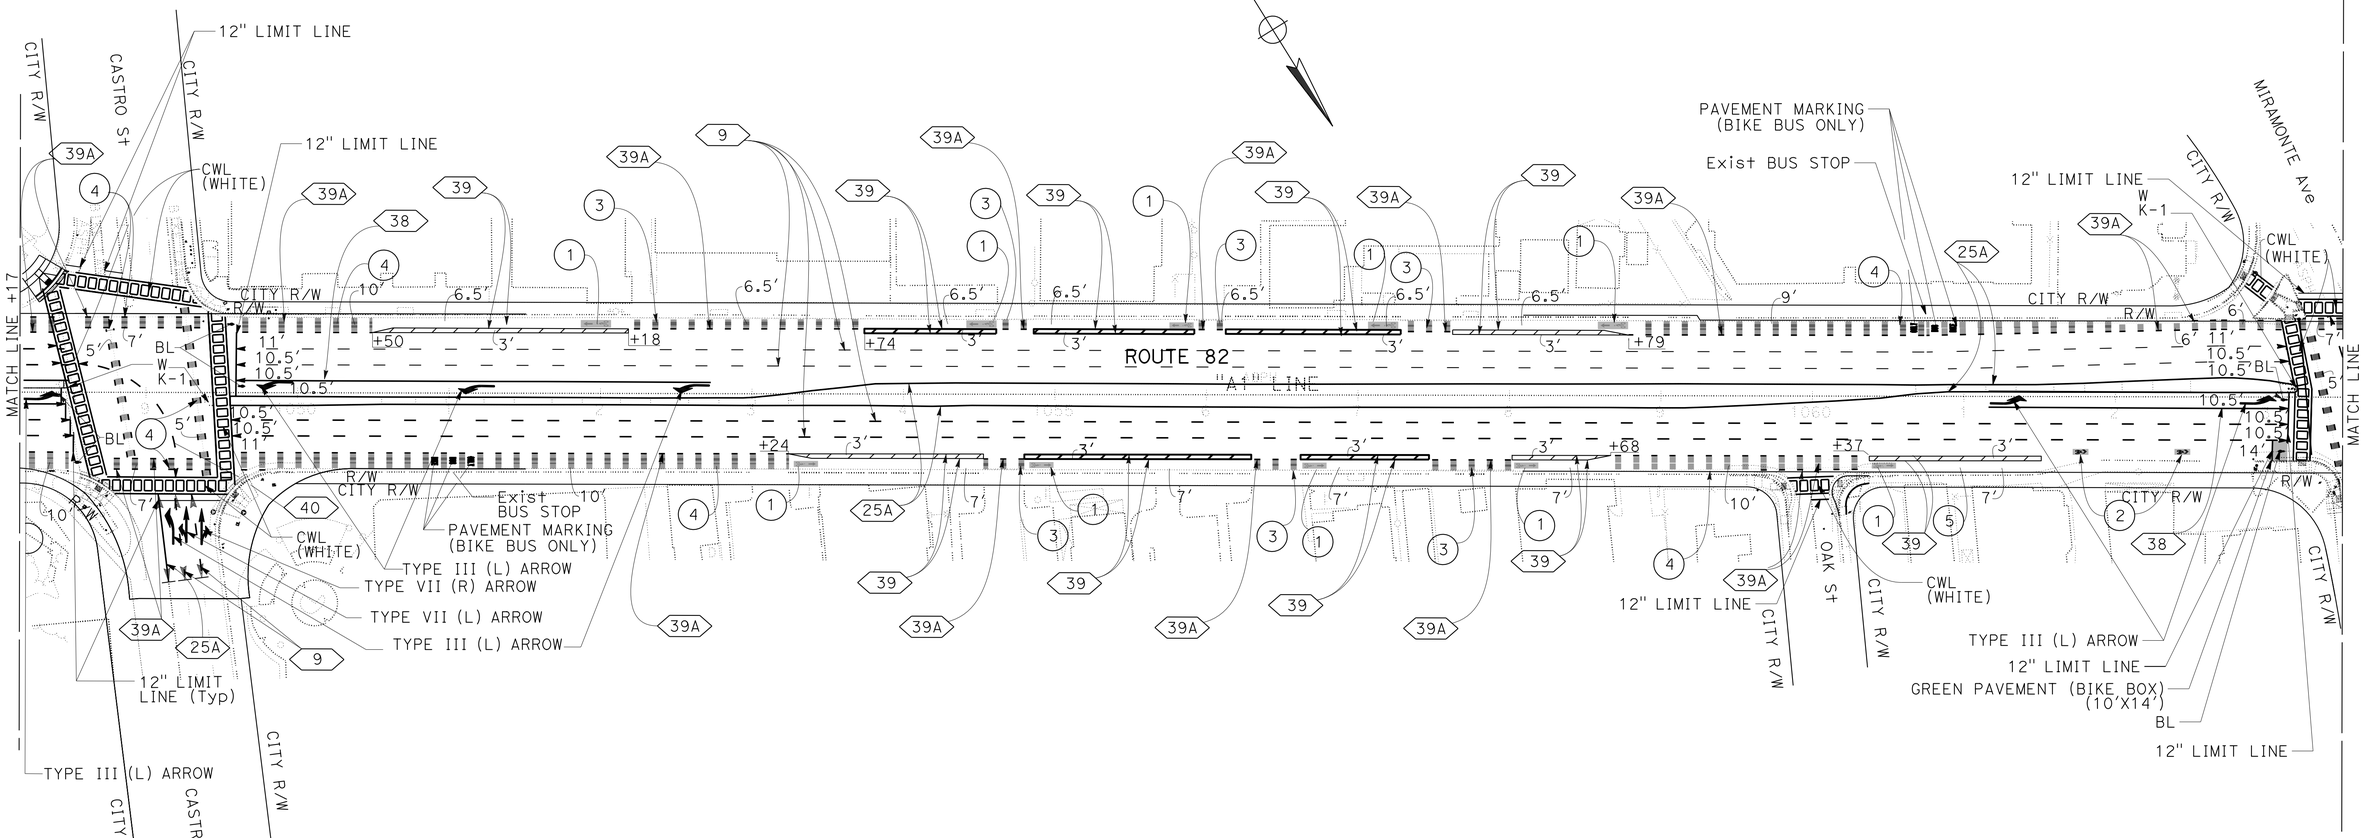

CONTRACT CHANGE ORDER NO. 20
SHEET _____ OF _____

20 REPLACED PER CONTRACT CHANGE ORDER No. 20 DATED

PAVEMENT DELINEATION PLAN

SCALE: 1" = 50'

APPROVED FOR PAVEMENT DELINEATION WORK ONLY

FOR NOTES, ABBREVIATIONS AND LEGEND, SEE SHEET PD-1

PD-7A

STATE OF CALIFORNIA - DEPARTMENT OF TRANSPORTATION
TRAFFIC
FUNCTIONAL SUPERVISOR: LESTER LEE
CALCULATED-DESIGNED BY: SON LY
CHECKED BY: RICK YEUNG
REVISED BY: SL
DATE REVISED: 11-18-22
LAST REVISION DATE PLOTTED => 18-NOV-2024
TIME PLOTTED => 15:09

BORDER LAST REVISED 7/2/2010
USERNAME => s129144
DGN FILE => 0419000140na007A.cco
RELATIVE BORDER SCALE IS IN INCHES 0 1 2 3
UNIT 0712
PROJECT NUMBER & PHASE 04190001401

NOTE:

FOR ACCURATE RIGHT OF WAY DATA, CONTACT
RIGHT OF WAY ENGINEERING AT THE DISTRICT OFFICE.

Dist	COUNTY	ROUTE	POST MILES TOTAL PROJECT	SHEET No.	TOTAL SHEETS
04	SCI	82	18.2/26.4	225	466

AS-AWARDED CONTRACT PLANS
THIS STAMP PLACED IN LIEU OF ORIGINAL SIGNATURE

REGISTERED CIVIL ENGINEER DATE

PLANS APPROVAL DATE


REGISTERED PROFESSIONAL ENGINEER — No. — Exp. — CIVIL — STATE OF CALIFORNIA

THE STATE OF CALIFORNIA OR ITS OFFICERS OR AGENTS SHALL NOT BE RESPONSIBLE FOR THE ACCURACY OR COMPLETENESS OF SCANNED COPIES OF THIS PLAN SHEET.

REGISTERED PROFESSIONAL ENGINEER — Rick Yeung — 60640 — 12-31-24 — CIVIL — STATE OF CALIFORNIA

FOR REVISION ONLY
July 22, 2024

20

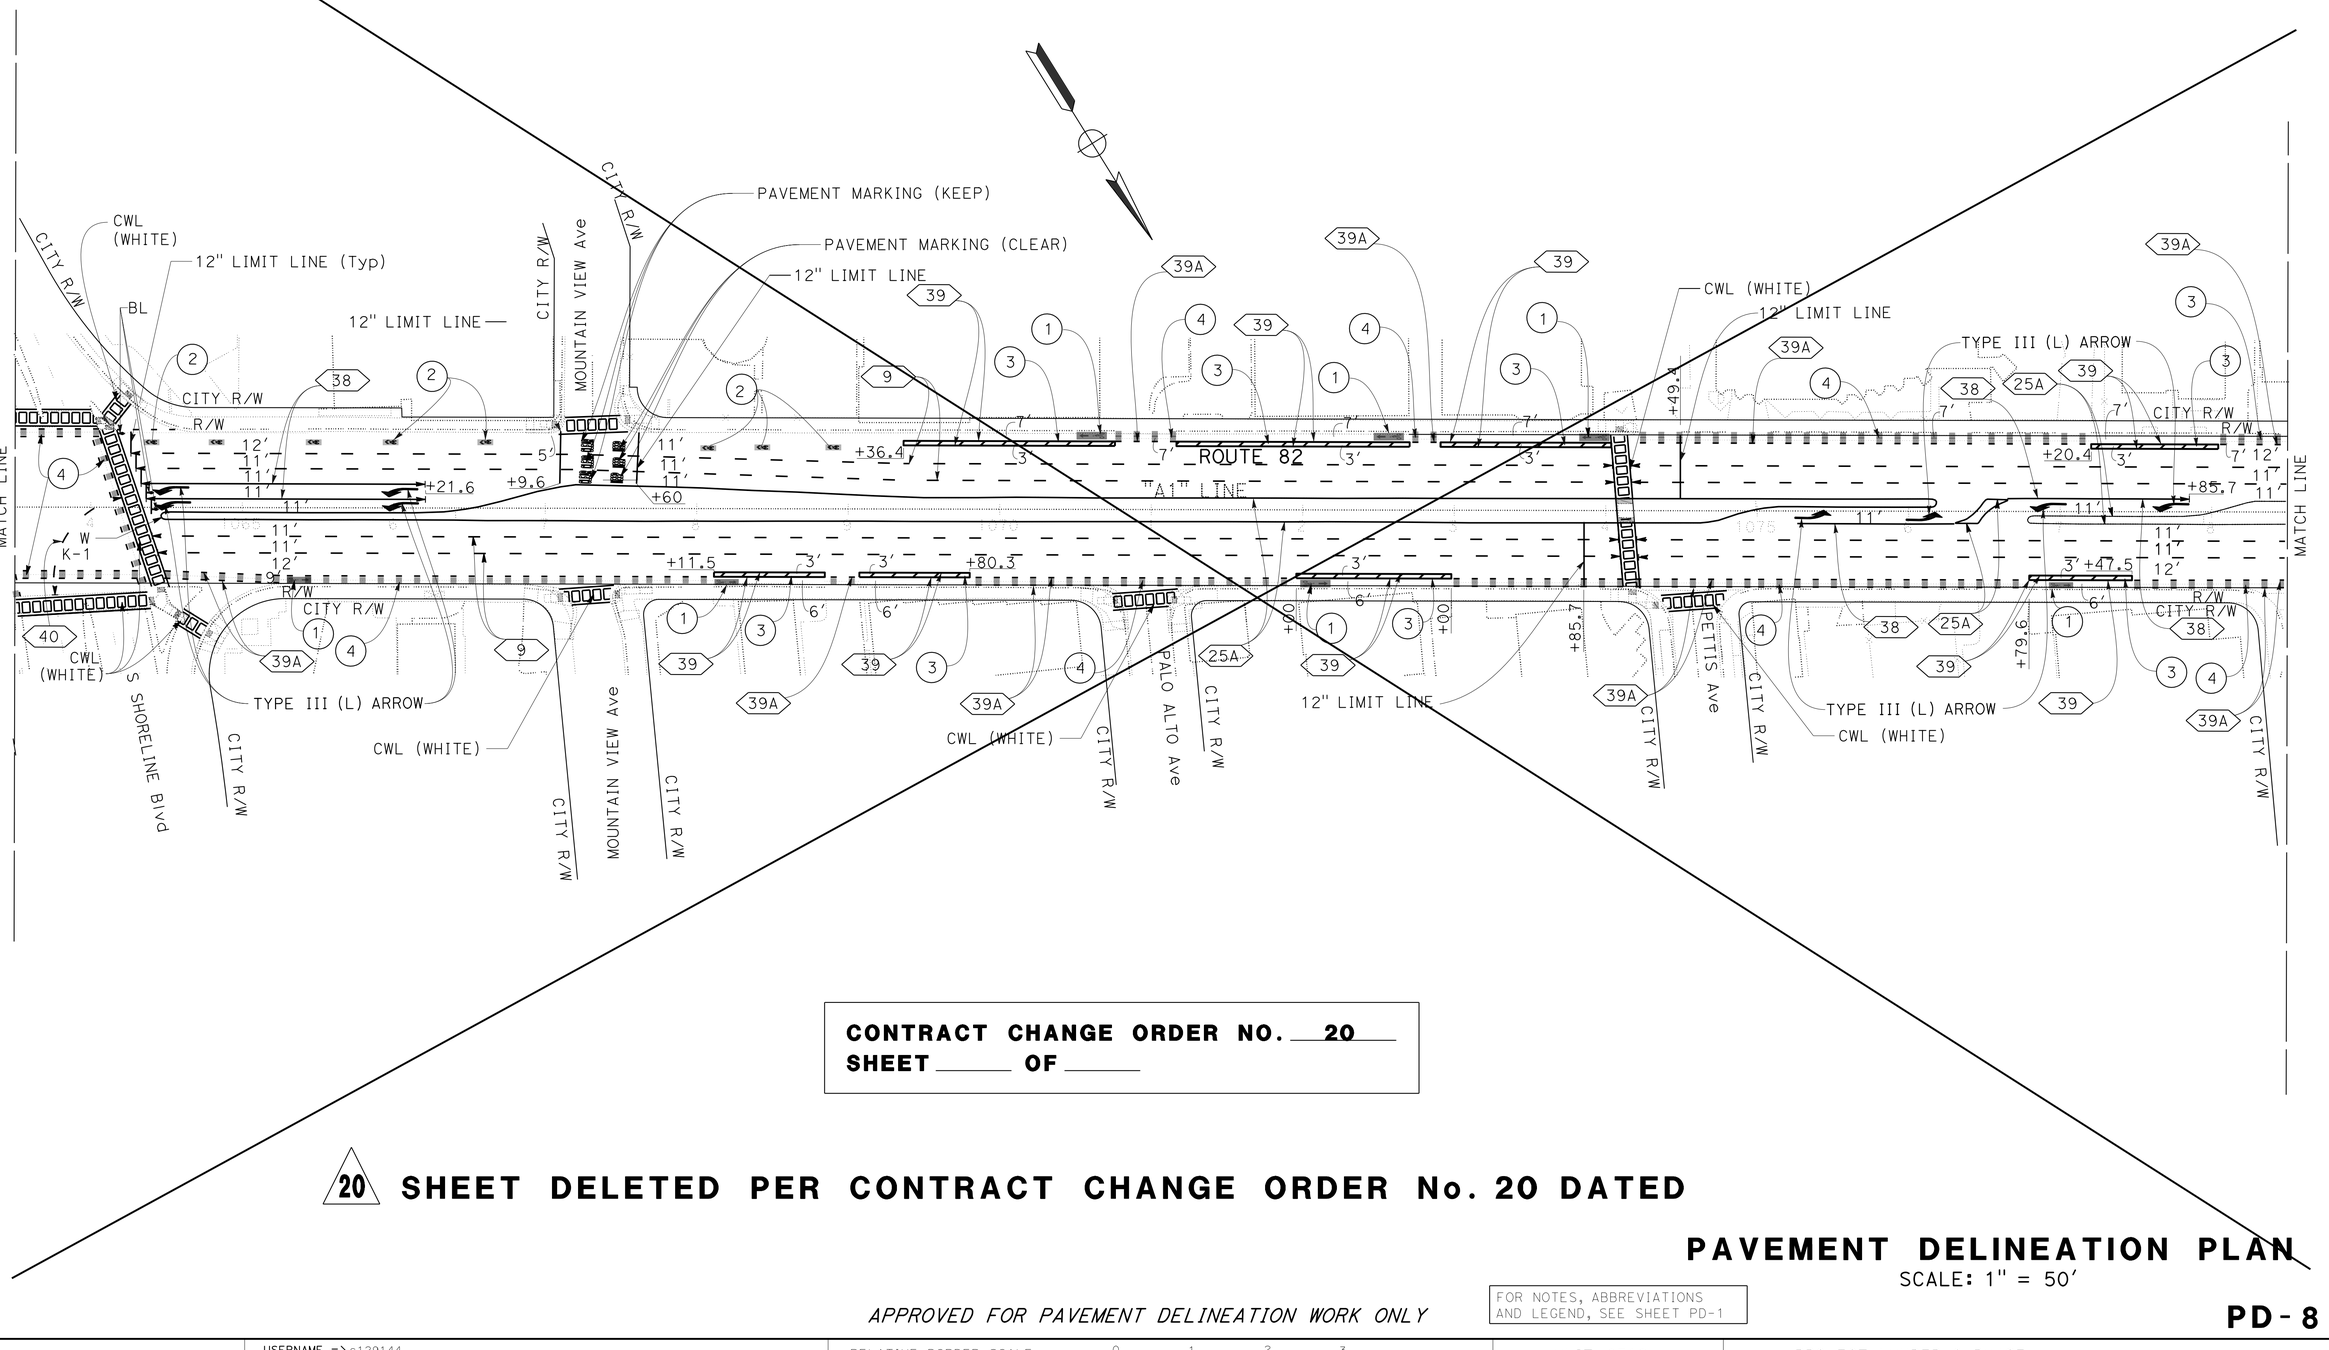

CONTRACT CHANGE ORDER NO. 20
SHEET _____ OF _____

20 **SHEET DELETED PER CONTRACT CHANGE ORDER No. 20 DATED**

PAVEMENT DELINEATION PLAN

SCALE: 1" = 50'

APPROVED FOR PAVEMENT DELINEATION WORK ONLY

FOR NOTES, ABBREVIATIONS AND LEGEND, SEE SHEET PD-1

PD-8

REVISED BY	DATE REVISED
SL	11-18-22

CALCULATED-DESIGNED BY: RICK YEUNG
CHECKED BY: SON LY

FUNCTIONAL SUPERVISOR: LESTER LEE

STATE OF CALIFORNIA - DEPARTMENT OF TRANSPORTATION
Caltrans®
TRAFFIC

LAST REVISION DATE PLOTTED => 18-NOV-2024
TIME PLOTTED => 15:09
01-17-23

BORDER LAST REVISED 7/2/2010

USERNAME => s129144
DGN FILE => 0419000140na008.cco

RELATIVE BORDER SCALE IS IN INCHES 0 1 2 3

UNIT 0712

PROJECT NUMBER & PHASE 04190001401

NOTE:

FOR ACCURATE RIGHT OF WAY DATA, CONTACT
RIGHT OF WAY ENGINEERING AT THE DISTRICT OFFICE.

REGISTERED PROFESSIONAL ENGINEER
Rick Yeung
No. 60640
Exp. 12-31-24
CIVIL
STATE OF CALIFORNIA

20

FOR REVISION ONLY
July 22, 2024

Dist	COUNTY	ROUTE	POST MILES TOTAL PROJECT	SHEET No.	TOTAL SHEETS
04	SCl	82	18.2/26.4	225	466


AS-AWARDED CONTRACT PLANS
THIS STAMP PLACED IN LIEU OF ORIGINAL SIGNATURE

REGISTERED CIVIL ENGINEER DATE

January 20, 2023
PLANS APPROVAL DATE

REGISTERED PROFESSIONAL ENGINEER
No.
Exp.
CIVIL
STATE OF CALIFORNIA

THE STATE OF CALIFORNIA OR ITS OFFICERS OR AGENTS SHALL NOT BE RESPONSIBLE FOR THE ACCURACY OR COMPLETENESS OF SCANNED COPIES OF THIS PLAN SHEET.

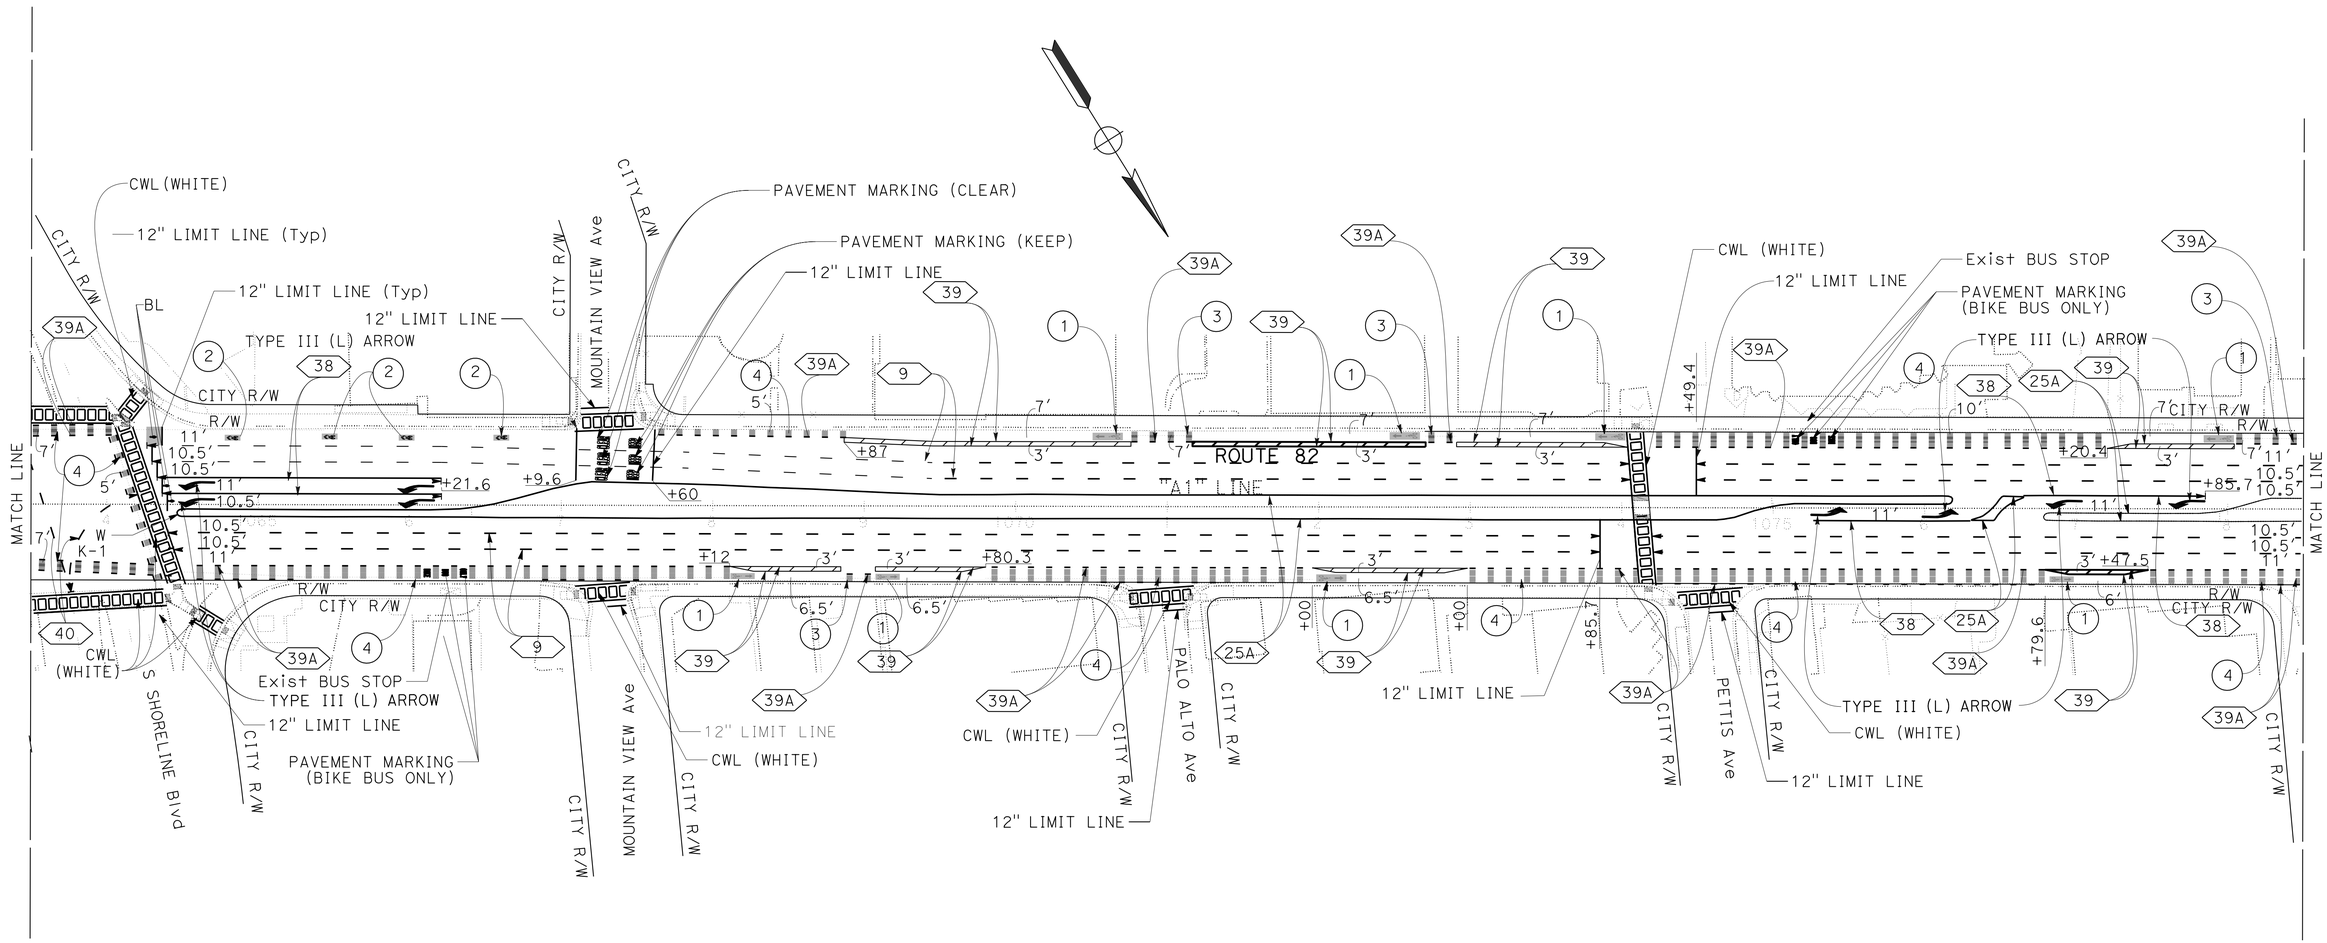

CONTRACT CHANGE ORDER NO. 20
SHEET _____ OF _____

20 REPLACED PER CONTRACT CHANGE ORDER No. 20 DATED

PAVEMENT DELINEATION PLAN

SCALE: 1" = 50'

APPROVED FOR PAVEMENT DELINEATION WORK ONLY

FOR NOTES, ABBREVIATIONS AND LEGEND, SEE SHEET PD-1

PD-8A

REVISED BY	DATE REVISED
SL	11-18-22

CALCULATED-DESIGNED BY: SON LY
CHECKED BY: RICK YEUNG
FUNCTIONAL SUPERVISOR: LESTER LEE

STATE OF CALIFORNIA - DEPARTMENT OF TRANSPORTATION
Caltrans®
TRAFFIC

LAST REVISION DATE PLOTTED => 18-NOV-2024
TIME PLOTTED => 15:09
01-17-23

BORDER LAST REVISED 7/2/2010

USERNAME => s129144
DGN FILE => 0419000140na008A.cco


RELATIVE BORDER SCALE IS IN INCHES 0 1 2 3

UNIT 0712

PROJECT NUMBER & PHASE 04190001401

NOTE:

FOR ACCURATE RIGHT OF WAY DATA, CONTACT
RIGHT OF WAY ENGINEERING AT THE DISTRICT OFFICE.

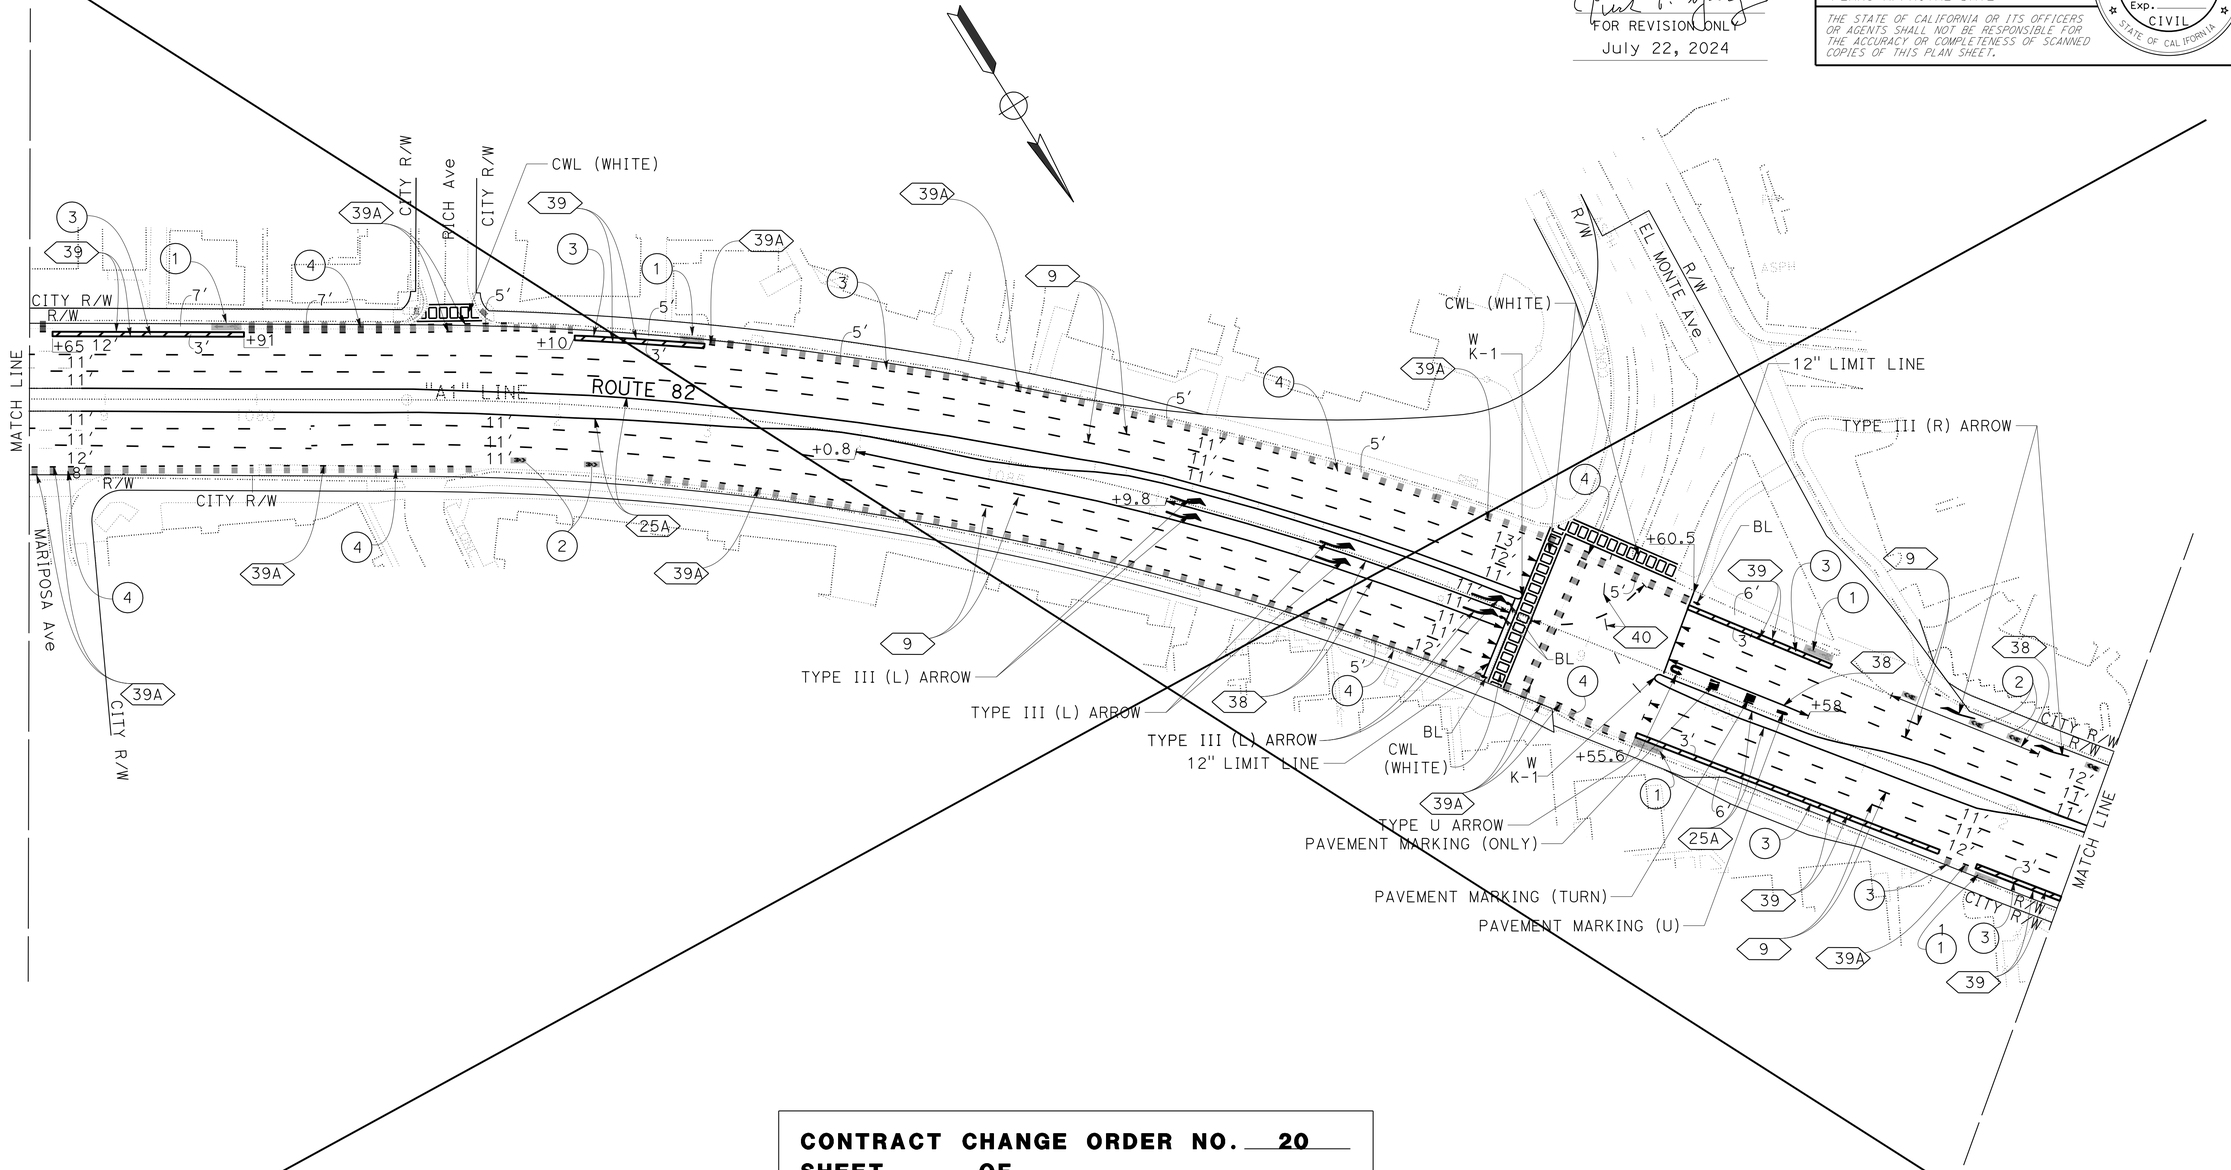

CONTRACT CHANGE ORDER NO. 20
SHEET _____ OF _____

20 SHEET DELETED PER CONTRACT CHANGE ORDER No. 20 DATED

PAVEMENT DELINEATION PLAN

SCALE: 1" = 50'

APPROVED FOR PAVEMENT DELINEATION WORK ONLY

FOR NOTES, ABBREVIATIONS AND LEGEND, SEE SHEET PD-1

PD-9

Rick Yeung
No. 60640
Exp. 12-31-24
CIVIL
STATE OF CALIFORNIA
REGISTERED PROFESSIONAL ENGINEER

FOR REVISION ONLY
July 22, 2024

20

Dist	COUNTY	ROUTE	POST MILES TOTAL PROJECT	SHEET No.	TOTAL SHEETS
04	SCI	82	18.2/26.4	226	466

AS-AWARDED CONTRACT PLANS
THIS STAMP PLACED IN LIEU OF ORIGINAL SIGNATURE

REGISTERED CIVIL ENGINEER DATE

PLANS APPROVAL DATE

REGISTERED PROFESSIONAL ENGINEER No. Exp. CIVIL STATE OF CALIFORNIA


THE STATE OF CALIFORNIA OR ITS OFFICERS OR AGENTS SHALL NOT BE RESPONSIBLE FOR THE ACCURACY OR COMPLETENESS OF SCANNED COPIES OF THIS PLAN SHEET.

STATE OF CALIFORNIA - DEPARTMENT OF TRANSPORTATION
TRAFFIC
FUNCTIONAL SUPERVISOR: LESTER LEE
CALCULATED-DESIGNED BY: RICK YEUNG
CHECKED BY: SON LY
REVISED BY: SL
DATE REVISED: 11-18-22

LAST REVISION
DATE PLOTTED => 18-NOV-2024
TIME PLOTTED => 15:09
01-17-23

NOTE:

FOR ACCURATE RIGHT OF WAY DATA, CONTACT
RIGHT OF WAY ENGINEERING AT THE DISTRICT OFFICE.

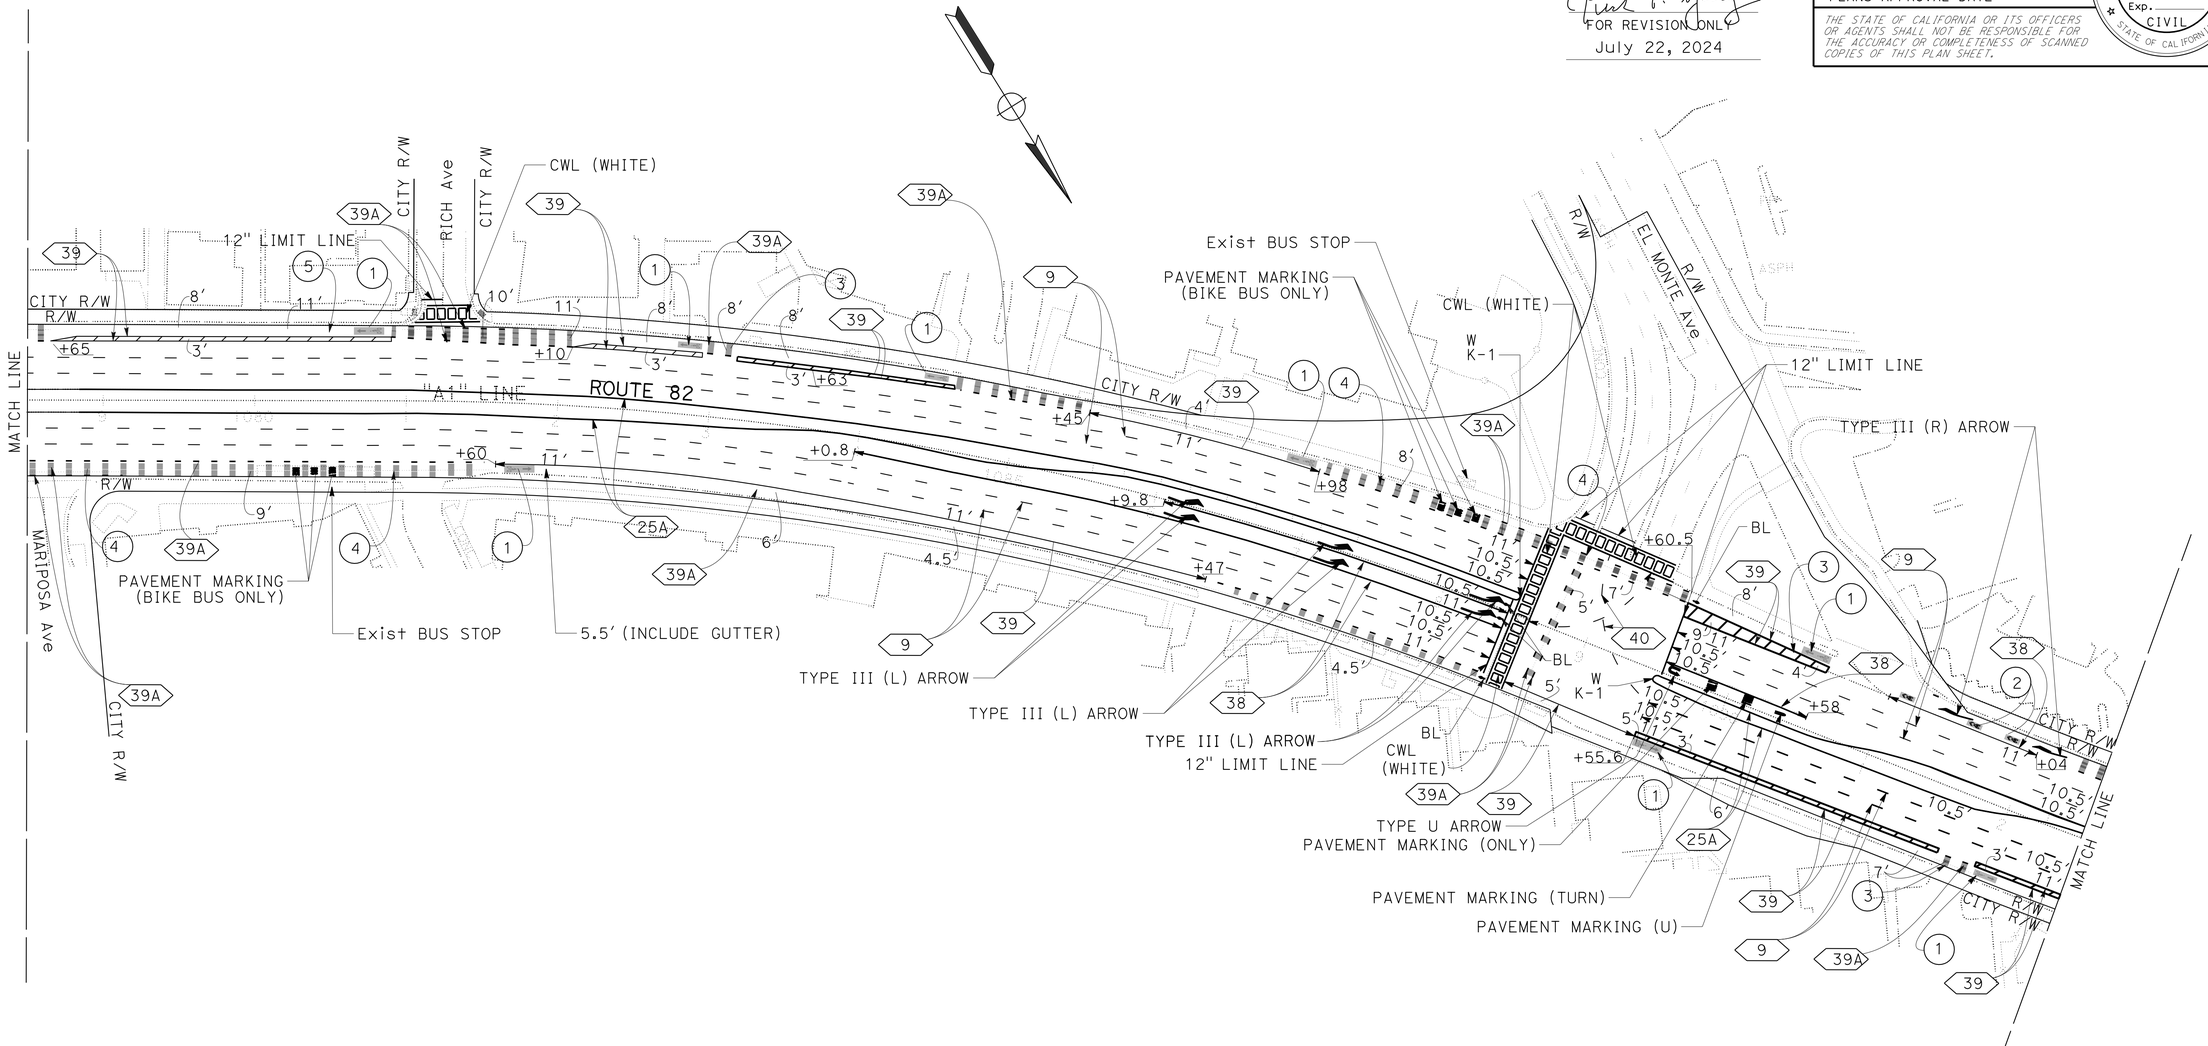

Dist	COUNTY	ROUTE	POST MILES TOTAL PROJECT	SHEET No.	TOTAL SHEETS
04	SCI	82	18.2/26.4	226	466

AS-AWARDED CONTRACT PLANS
THIS STAMP PLACED IN LIEU OF ORIGINAL SIGNATURE

REGISTERED CIVIL ENGINEER DATE

PLANS APPROVAL DATE

THE STATE OF CALIFORNIA OR ITS OFFICERS OR AGENTS SHALL NOT BE RESPONSIBLE FOR THE ACCURACY OR COMPLETENESS OF SCANNED COPIES OF THIS PLAN SHEET.

Rick Yeung No. 60640 Exp. 12-31-24 CIVIL REGISTERED PROFESSIONAL ENGINEER STATE OF CALIFORNIA

20

FOR REVISION ONLY
July 22, 2024

CONTRACT CHANGE ORDER NO. 20
SHEET _____ OF _____

20 REPLACED PER CONTRACT CHANGE ORDER No. 20 DATED

PAVEMENT DELINEATION PLAN

SCALE: 1" = 50'

APPROVED FOR PAVEMENT DELINEATION WORK ONLY

FOR NOTES, ABBREVIATIONS AND LEGEND, SEE SHEET PD-1

PD-9A


REVISED BY	SL	CALCULATED-DESIGNED BY	STATE OF CALIFORNIA - DEPARTMENT OF TRANSPORTATION
DATE REVISED	11-18-22	CHECKED BY	TRAFFIC
SON LY		FUNCTIONAL SUPERVISOR	Caltrans
RICK YEUNG		LESTER LEE	

LAST REVISION | DATE PLOTTED => 18-NOV-2024
01-17-23 | TIME PLOTTED => 15:10

BORDER LAST REVISED 7/2/2010 | USERNAME => s129144 | DGN FILE => 0419000140na009A.cco | RELATIVE BORDER SCALE IS IN INCHES 0 1 2 3 | UNIT 0712 | PROJECT NUMBER & PHASE 04190001401

NOTE:

FOR ACCURATE RIGHT OF WAY DATA, CONTACT
RIGHT OF WAY ENGINEERING AT THE DISTRICT OFFICE.

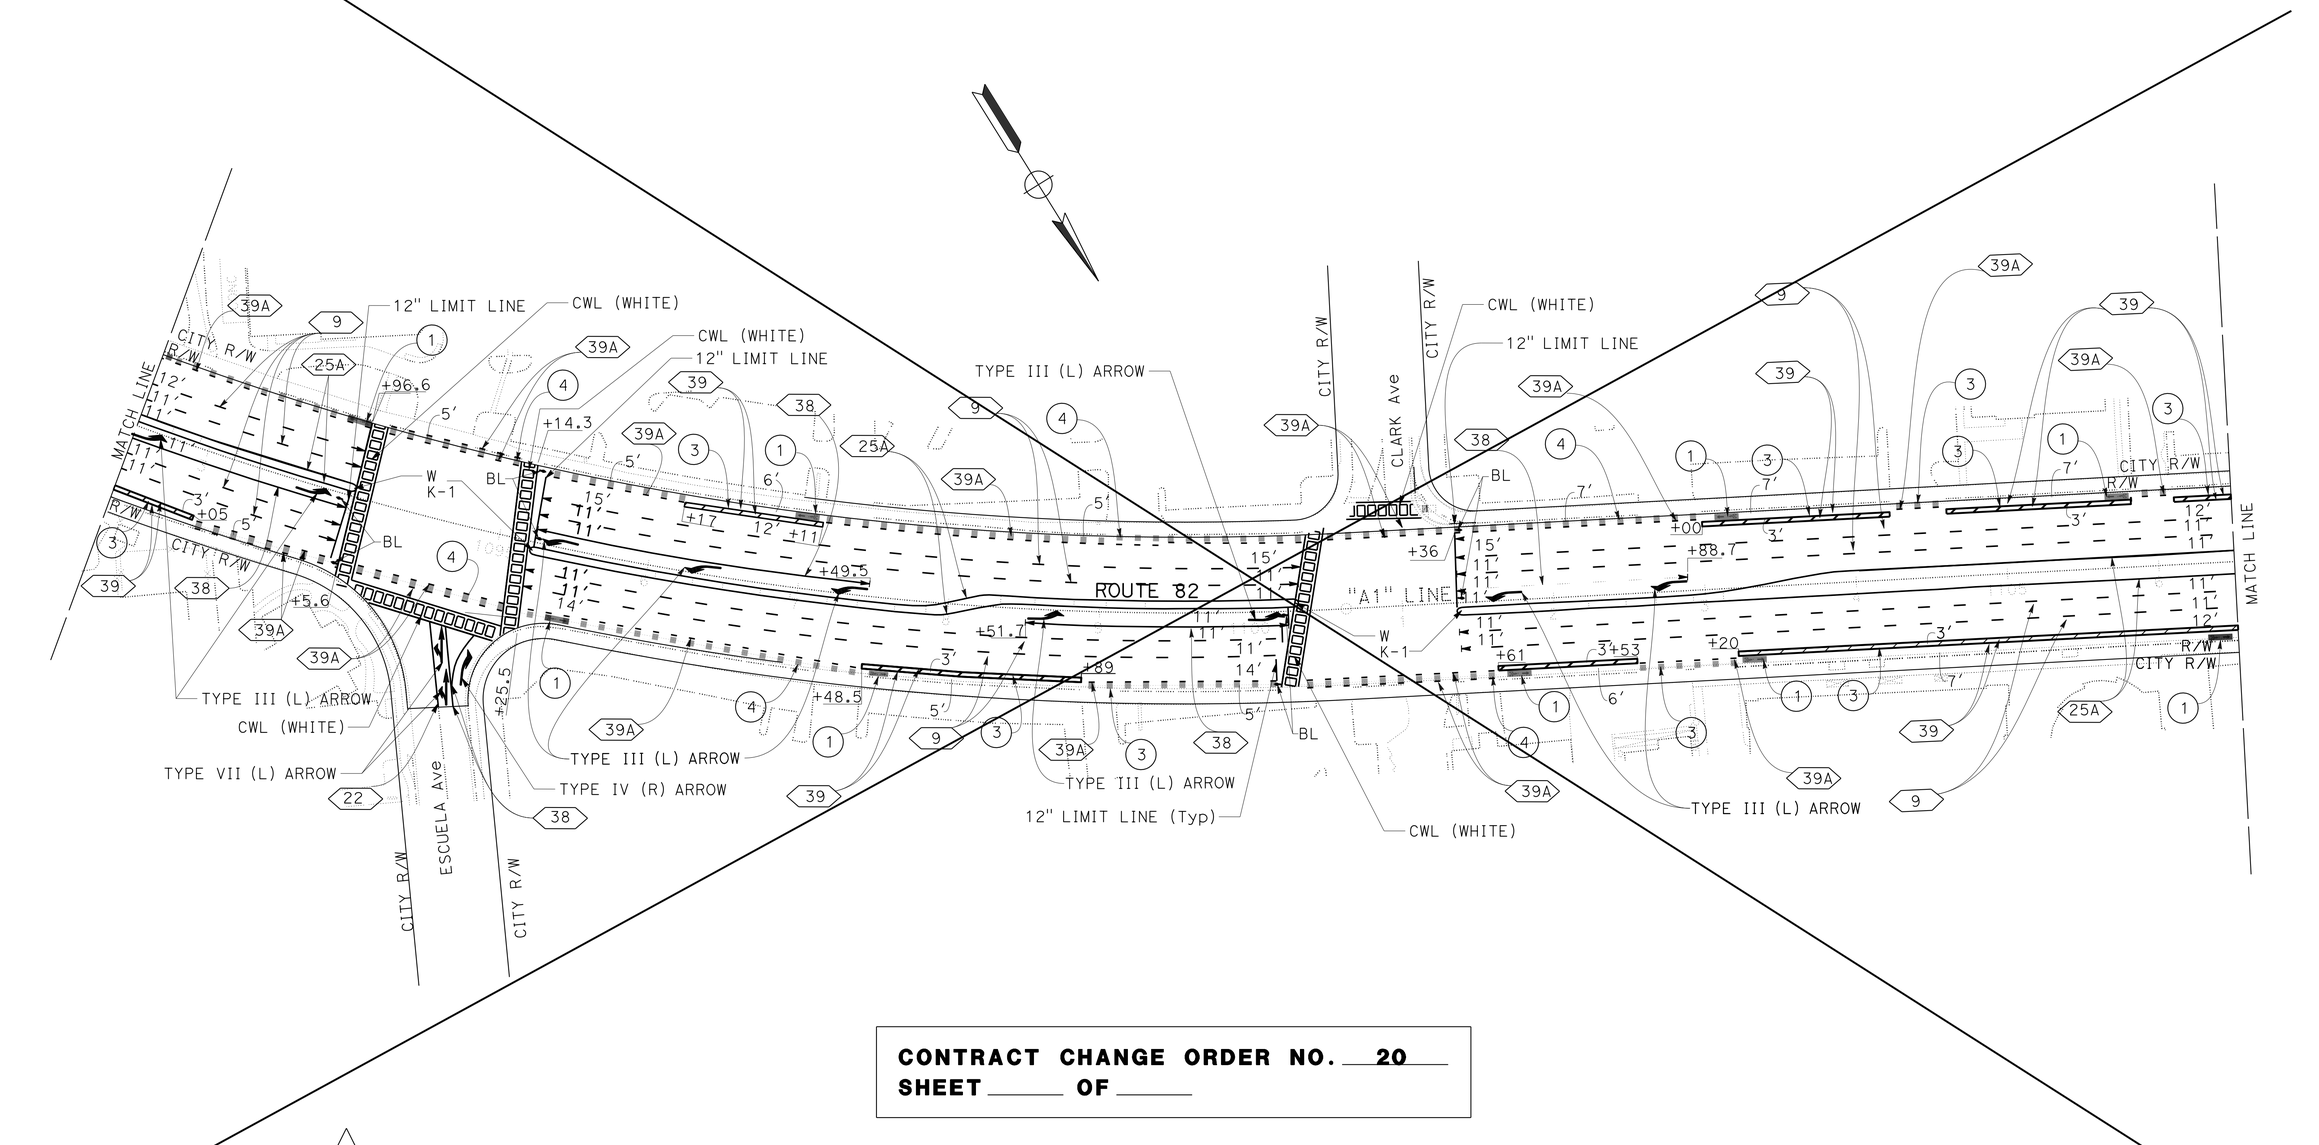

CONTRACT CHANGE ORDER NO. 20
SHEET _____ OF _____

20 SHEET DELETED PER CONTRACT CHANGE ORDER No. 20 DATED

PAVEMENT DELINEATION PLAN

SCALE: 1" = 50'

APPROVED FOR PAVEMENT DELINEATION WORK ONLY

FOR NOTES, ABBREVIATIONS AND LEGEND, SEE SHEET PD-1

PD-10

Rick Yeung
No. 60640
Exp. 12-31-24
CIVIL
REGISTERED PROFESSIONAL ENGINEER
STATE OF CALIFORNIA

FOR REVISION ONLY
July 22, 2024

20

Dist	COUNTY	ROUTE	POST MILES TOTAL PROJECT	SHEET No.	TOTAL SHEETS
04	SCI	82	18.2/26.4	227	466

AS-AWARDED CONTRACT PLANS
THIS STAMP PLACED IN LIEU OF ORIGINAL SIGNATURE

REGISTERED CIVIL ENGINEER DATE

PLANS APPROVAL DATE

THE STATE OF CALIFORNIA OR ITS OFFICERS OR AGENTS SHALL NOT BE RESPONSIBLE FOR THE ACCURACY OR COMPLETENESS OF SCANNED COPIES OF THIS PLAN SHEET.

REGISTERED PROFESSIONAL ENGINEER
No.
Exp.
CIVIL
STATE OF CALIFORNIA

CALCULATED-DESIGNED BY	CHECKED BY	REVISED BY	DATE REVISED
RICK YEUNG	SON LY	SL	11-18-22

FUNCTIONAL SUPERVISOR: LESTER LEE

STATE OF CALIFORNIA - DEPARTMENT OF TRANSPORTATION
Caltrans
TRAFFIC

LAST REVISION | DATE PLOTTED => 18-NOV-2024
01-17-23 | TIME PLOTTED => 15:10

BORDER LAST REVISED 7/2/2010 | USERNAME => s129144 | DGN FILE => 0419000140na010.cco | RELATIVE BORDER SCALE IS IN INCHES 0 1 2 3 | UNIT 0712 | PROJECT NUMBER & PHASE 04190001401

NOTE:

FOR ACCURATE RIGHT OF WAY DATA, CONTACT
RIGHT OF WAY ENGINEERING AT THE DISTRICT OFFICE.

REGISTERED PROFESSIONAL ENGINEER
Rick Yeung
No. 60640
Exp. 12-31-24
CIVIL
STATE OF CALIFORNIA

FOR REVISION ONLY
July 22, 2024

20

Dist	COUNTY	ROUTE	POST MILES TOTAL PROJECT	SHEET No.	TOTAL SHEETS
04	SCI	82	18.2/26.4	227A	466


AS-AWARDED CONTRACT PLANS
THIS STAMP PLACED IN LIEU OF ORIGINAL SIGNATURE

REGISTERED CIVIL ENGINEER DATE

January 20, 2023
PLANS APPROVAL DATE

REGISTERED PROFESSIONAL ENGINEER
No.
Exp.
CIVIL
STATE OF CALIFORNIA

THE STATE OF CALIFORNIA OR ITS OFFICERS OR AGENTS SHALL NOT BE RESPONSIBLE FOR THE ACCURACY OR COMPLETENESS OF SCANNED COPIES OF THIS PLAN SHEET.

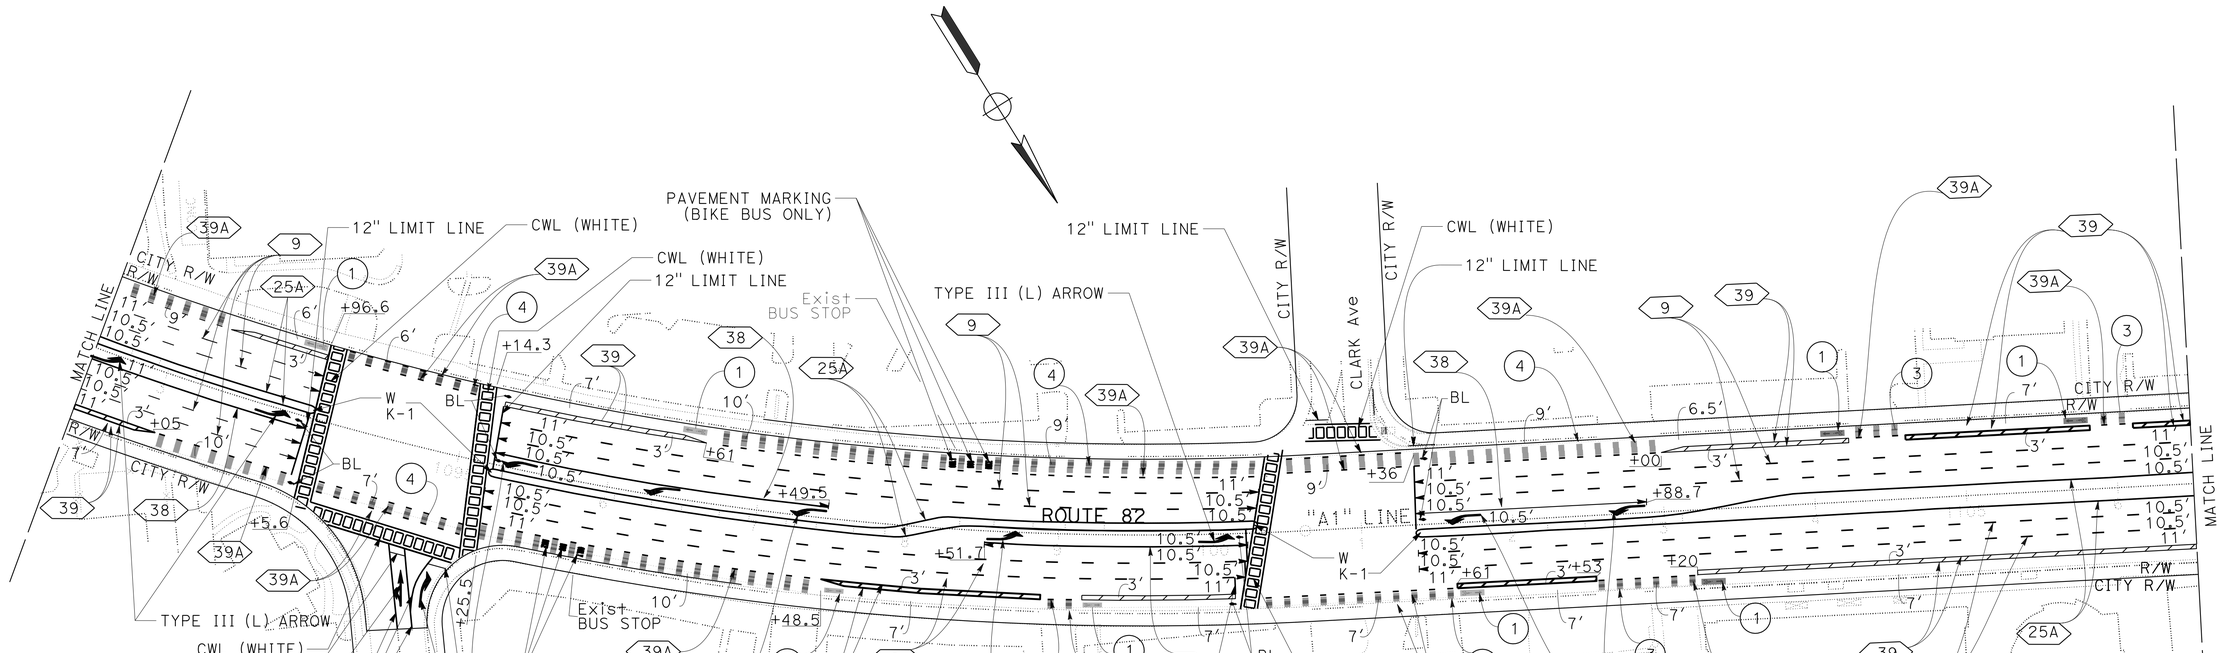

CONTRACT CHANGE ORDER NO. 20
SHEET _____ OF _____

20 REPLACED PER CONTRACT CHANGE ORDER No. 20 DATED

PAVEMENT DELINEATION PLAN

SCALE: 1" = 50'

APPROVED FOR PAVEMENT DELINEATION WORK ONLY

FOR NOTES, ABBREVIATIONS AND LEGEND, SEE SHEET PD-1

PD-10A

REVISED BY	SL		
DATE REVISED	11-18-22		
CALCULATED-DESIGNED BY	SON LY	FUNCTIONAL SUPERVISOR	LESTER LEE
CHECKED BY	RICK YEUNG	STATE OF CALIFORNIA - DEPARTMENT OF TRANSPORTATION	TRAFFIC

LAST REVISION DATE PLOTTED => 18-NOV-2024
TIME PLOTTED => 15:10
01-17-23

BORDER LAST REVISED 7/2/2010 | USERNAME => s129144 | DGN FILE => 04190000140na010A.cco | RELATIVE BORDER SCALE IS IN INCHES 0 1 2 3 | UNIT 0712 | PROJECT NUMBER & PHASE 04190001401

NOTE:

FOR ACCURATE RIGHT OF WAY DATA, CONTACT
RIGHT OF WAY ENGINEERING AT THE DISTRICT OFFICE.

Dist	COUNTY	ROUTE	POST MILES TOTAL PROJECT	SHEET No.	TOTAL SHEETS
04	SCI	82	18.2/26.4	228	466

AS-AWARDED CONTRACT PLANS
THIS STAMP PLACED IN LIEU OF ORIGINAL SIGNATURE

REGISTERED CIVIL ENGINEER DATE


PLANS APPROVAL DATE

THE STATE OF CALIFORNIA OR ITS OFFICERS OR AGENTS SHALL NOT BE RESPONSIBLE FOR THE ACCURACY OR COMPLETENESS OF SCANNED COPIES OF THIS PLAN SHEET.

REGISTERED PROFESSIONAL ENGINEER — Rick Yeung — No. 60640 — Exp. 12-31-24 — CIVIL — STATE OF CALIFORNIA

20

FOR REVISION ONLY
July 22, 2024

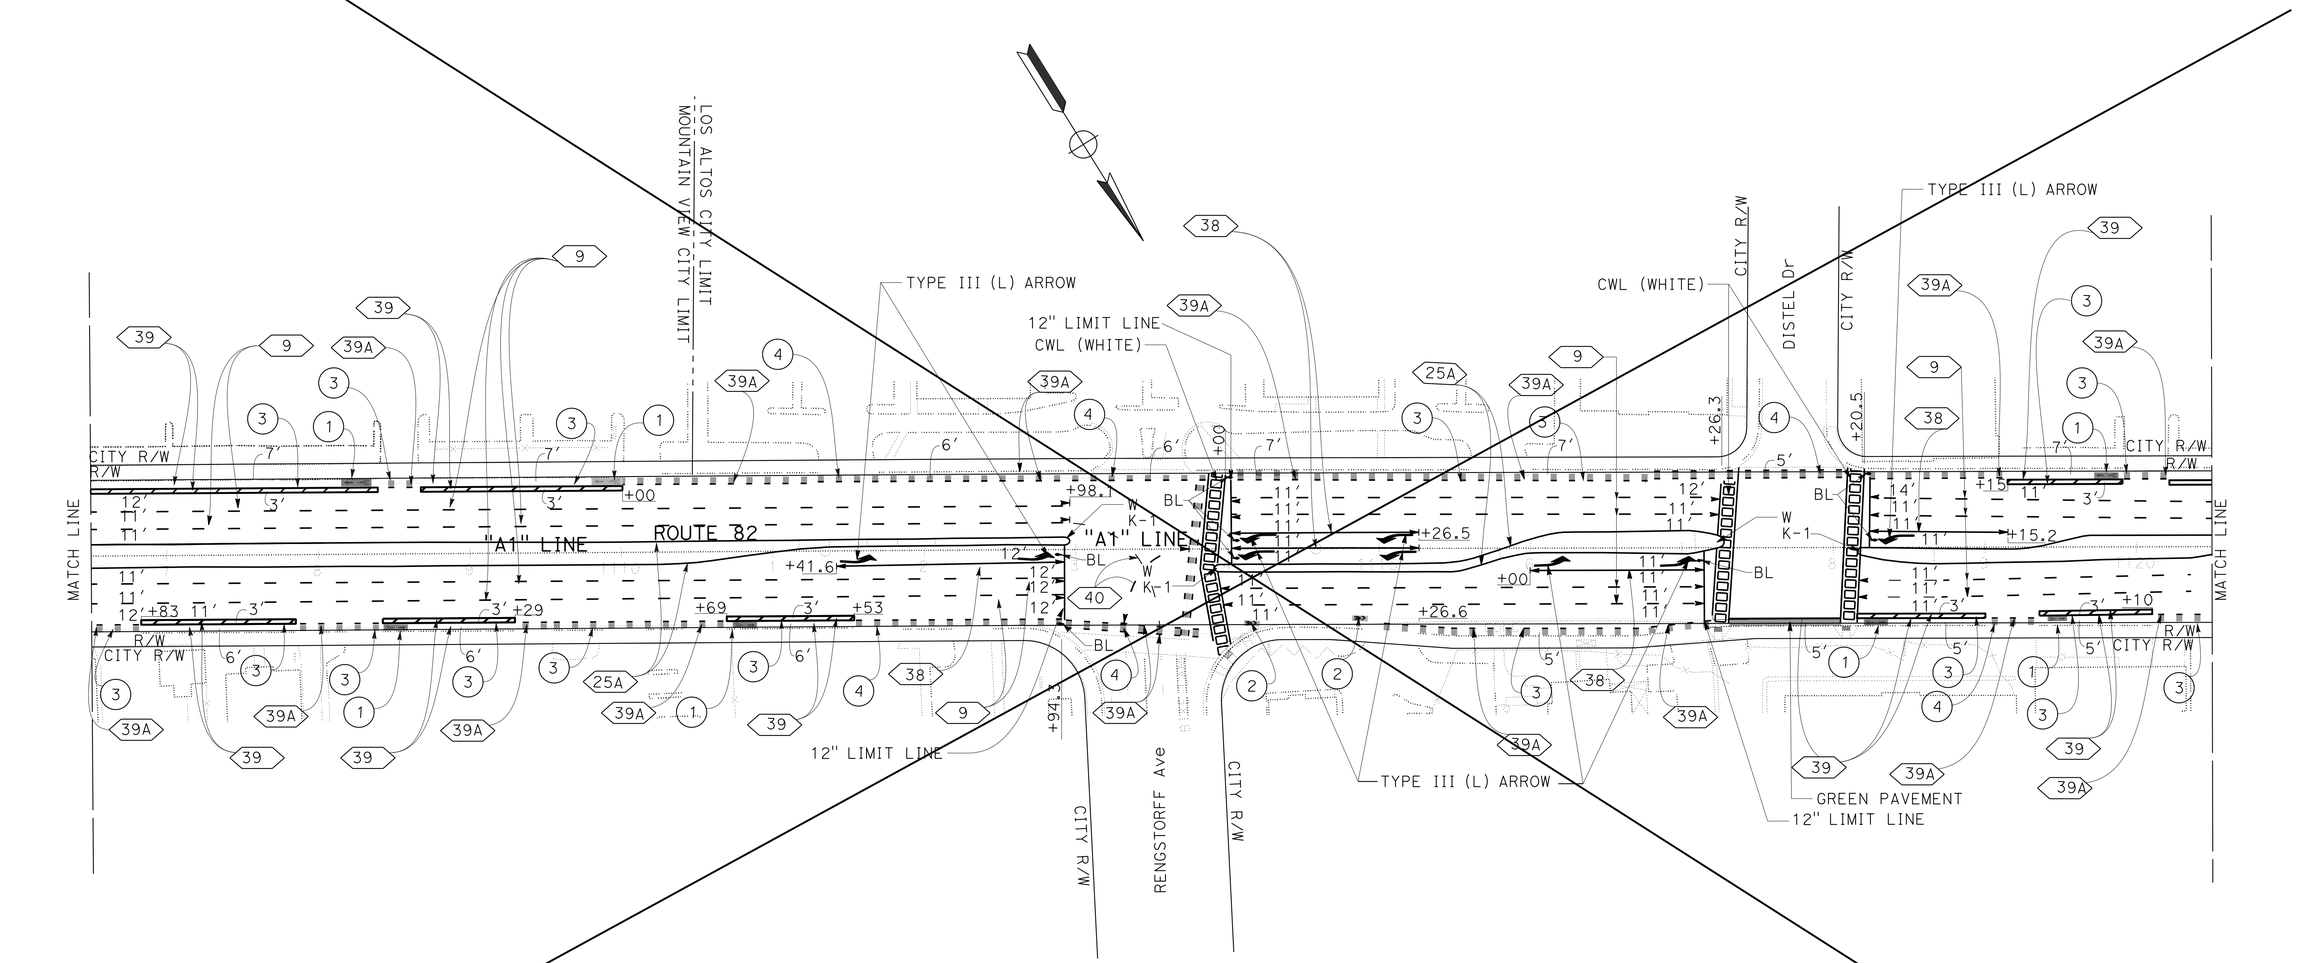

CONTRACT CHANGE ORDER NO. 20
SHEET _____ OF _____

20 **SHEET DELETED PER CONTRACT CHANGE ORDER No. 20 DATED**

PAVEMENT DELINEATION PLAN

SCALE: 1" = 50'

APPROVED FOR PAVEMENT DELINEATION WORK ONLY

FOR NOTES, ABBREVIATIONS AND LEGEND, SEE SHEET PD-1

PD-11

STATE OF CALIFORNIA - DEPARTMENT OF TRANSPORTATION
Caltrans®
TRAFFIC

FUNCTIONAL SUPERVISOR: LESTER LEE

CALCULATED-DESIGNED BY: RICK YEUNG
CHECKED BY: SON LY

REVISED BY: SL
DATE REVISED: 11-18-22

LAST REVISION DATE PLOTTED => 18-NOV-2024
TIME PLOTTED => 15:10

BORDER LAST REVISED 7/2/2010

USERNAME => s129144
DGN FILE => 0419000140na011.cco

RELATIVE BORDER SCALE IS IN INCHES 0 1 2 3

UNIT 0712

PROJECT NUMBER & PHASE 04190001401

NOTE:

FOR ACCURATE RIGHT OF WAY DATA, CONTACT
RIGHT OF WAY ENGINEERING AT THE DISTRICT OFFICE.

Dist	COUNTY	ROUTE	POST MILES TOTAL PROJECT	SHEET No.	TOTAL SHEETS
04	SCI	82	18.2/26.4	228	466

AS-AWARDED CONTRACT PLANS
THIS STAMP PLACED IN LIEU OF ORIGINAL SIGNATURE

REGISTERED CIVIL ENGINEER DATE


PLANS APPROVAL DATE

THE STATE OF CALIFORNIA OR ITS OFFICERS OR AGENTS SHALL NOT BE RESPONSIBLE FOR THE ACCURACY OR COMPLETENESS OF SCANNED COPIES OF THIS PLAN SHEET.

REGISTERED PROFESSIONAL ENGINEER — Rick Yeung — No. 60640 — Exp. 12-31-24 — CIVIL — STATE OF CALIFORNIA

20

FOR REVISION ONLY
July 22, 2024

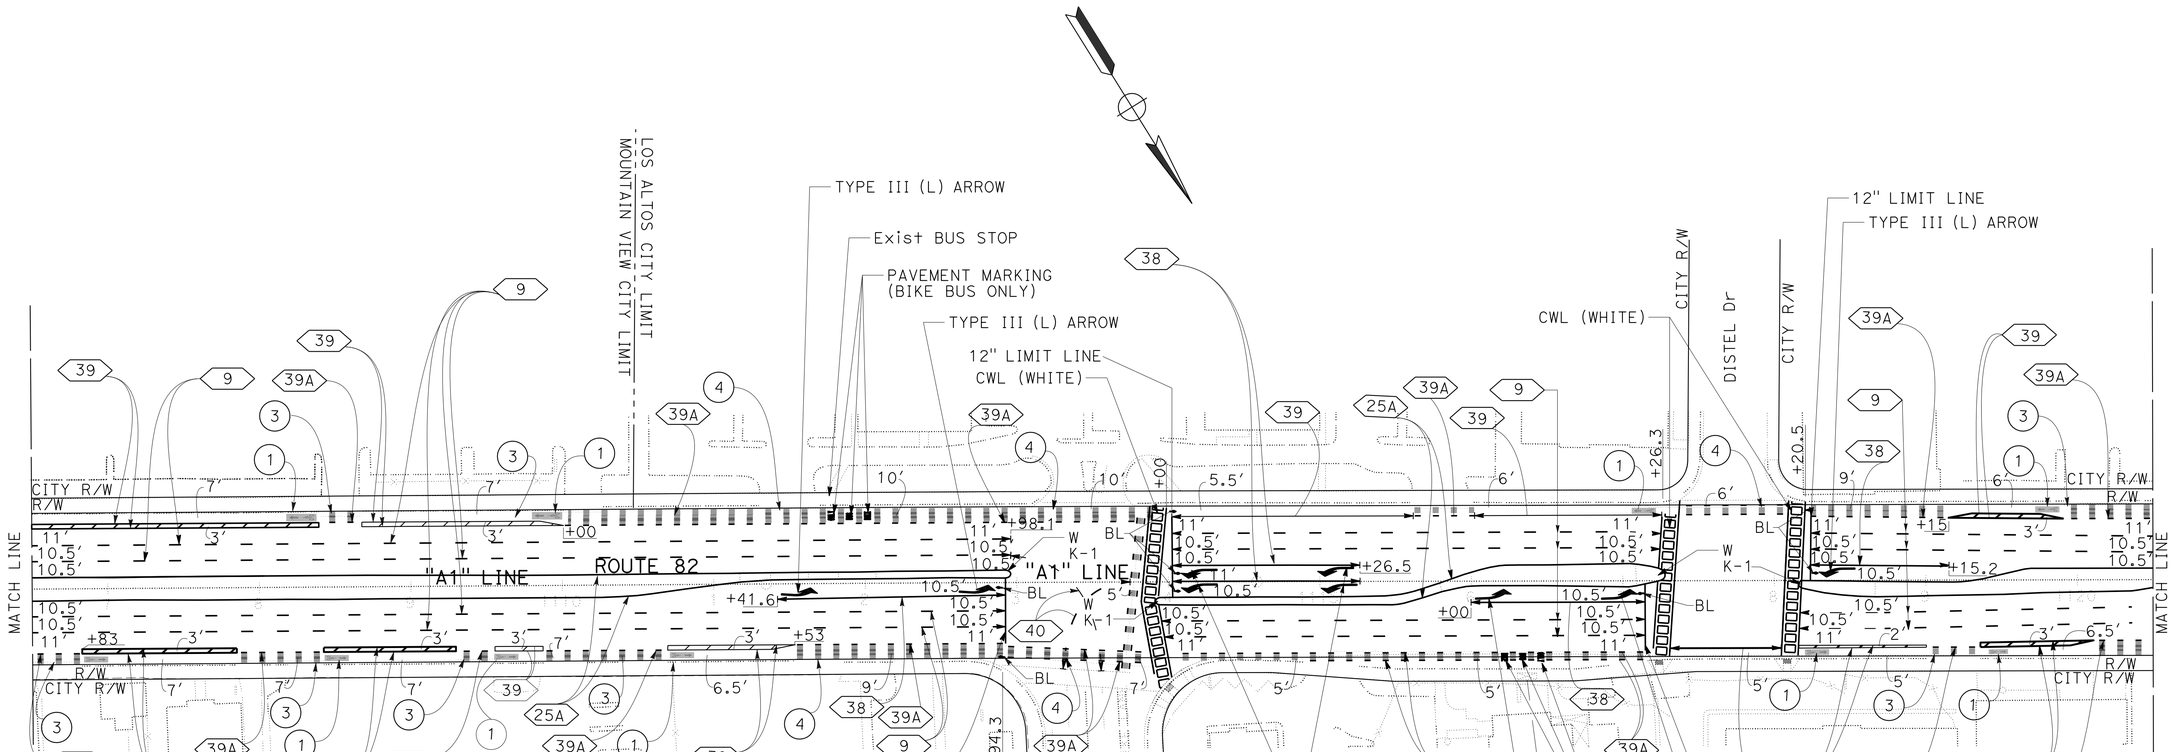

CONTRACT CHANGE ORDER NO. 20
SHEET _____ OF _____

20 REPLACED PER CONTRACT CHANGE ORDER No. 20 DATED

PAVEMENT DELINEATION PLAN

SCALE: 1" = 50'

APPROVED FOR PAVEMENT DELINEATION WORK ONLY

FOR NOTES, ABBREVIATIONS AND LEGEND, SEE SHEET PD-1

PD-11A

STATE OF CALIFORNIA - DEPARTMENT OF TRANSPORTATION
TRAFFIC
FUNCTIONAL SUPERVISOR: LESTER LEE
CALCULATED-DESIGNED BY: SON LY
CHECKED BY: RICK YEUNG
REVISED BY
DATE REVISED: 11-18-22

LAST REVISION | DATE PLOTTED => 18-NOV-2024
TIME PLOTTED => 15:10
09-15-22

BORDER LAST REVISED 7/2/2010
USERNAME => s129144
DGN FILE => 0419000140na011A.cco
RELATIVE BORDER SCALE IS IN INCHES 0 1 2 3
UNIT 0712
PROJECT NUMBER & PHASE 04190001401

NOTE:

FOR ACCURATE RIGHT OF WAY DATA, CONTACT
RIGHT OF WAY ENGINEERING AT THE DISTRICT OFFICE.

Dist	COUNTY	ROUTE	POST MILES TOTAL PROJECT	SHEET No.	TOTAL SHEETS
04	SCI	82	18.2/26.4	229	466

AS-AWARDED CONTRACT PLANS
THIS STAMP PLACED IN LIEU OF ORIGINAL SIGNATURE

REGISTERED CIVIL ENGINEER DATE


January 20, 2023
PLANS APPROVAL DATE

THE STATE OF CALIFORNIA OR ITS OFFICERS OR AGENTS SHALL NOT BE RESPONSIBLE FOR THE ACCURACY OR COMPLETENESS OF SCANNED COPIES OF THIS PLAN SHEET.

REGISTERED PROFESSIONAL ENGINEER — Rick Yeung — No. 60640 — Exp. 12-31-24 — CIVIL — STATE OF CALIFORNIA

20

FOR REVISION ONLY
July 22, 2024

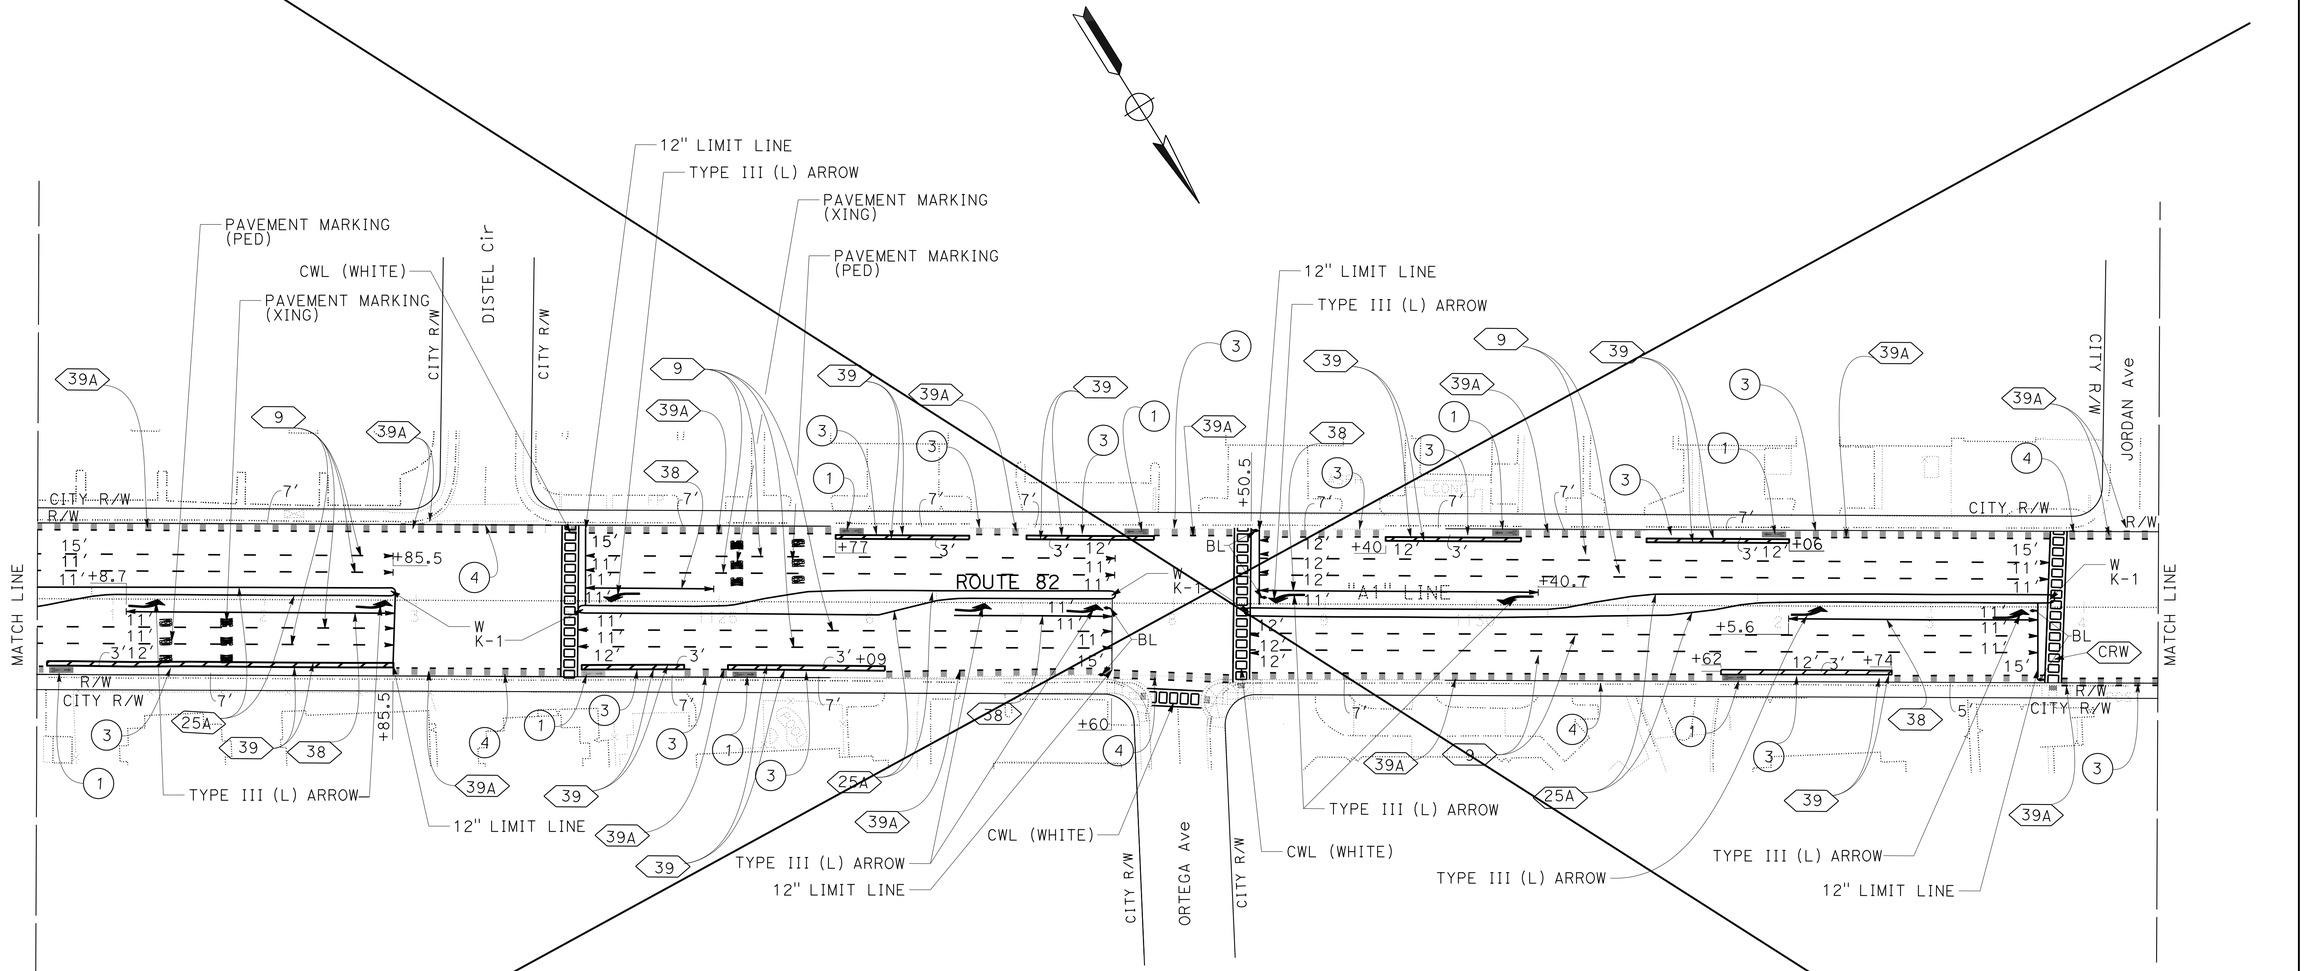

CONTRACT CHANGE ORDER NO. 20
SHEET _____ OF _____

20 **SHEET DELETED PER CONTRACT CHANGE ORDER No. 20 DATED**

PAVEMENT DELINEATION PLAN

SCALE: 1" = 50'

APPROVED FOR PAVEMENT DELINEATION WORK ONLY

FOR NOTES, ABBREVIATIONS AND LEGEND, SEE SHEET PD-1

PD-12

CALCULATED-DESIGNED BY		
CHECKED BY		
REVISED BY	SL	
DATE REVISED	11-18-22	
RICK YEUNG		
SON LY		
FUNCTIONAL SUPERVISOR		
LESTER LEE		

STATE OF CALIFORNIA - DEPARTMENT OF TRANSPORTATION
Caltrans®
TRAFFIC

LAST REVISION DATE PLOTTED => 18-NOV-2024
TIME PLOTTED => 15:10
01-17-23

BORDER LAST REVISED 7/2/2010

USERNAME => s129144
DGN FILE => 0419000140na012.cco

RELATIVE BORDER SCALE IS IN INCHES 0 1 2 3

UNIT 0712

PROJECT NUMBER & PHASE 04190001401

NOTE:

FOR ACCURATE RIGHT OF WAY DATA, CONTACT
RIGHT OF WAY ENGINEERING AT THE DISTRICT OFFICE.

REGISTERED PROFESSIONAL ENGINEER
Rick Yeung
No. 60640
Exp. 12-31-24
CIVIL
STATE OF CALIFORNIA

20

FOR REVISION ONLY
July 22, 2024

Dist	COUNTY	ROUTE	POST MILES TOTAL PROJECT	SHEET No.	TOTAL SHEETS
04	SCI	82	18.2/26.4	229A	466


AS-AWARDED CONTRACT PLANS
THIS STAMP PLACED IN LIEU OF ORIGINAL SIGNATURE

REGISTERED CIVIL ENGINEER DATE

January 20, 2023
PLANS APPROVAL DATE

REGISTERED PROFESSIONAL ENGINEER
Rick Yeung
No. 60640
Exp. 12-31-24
CIVIL
STATE OF CALIFORNIA

THE STATE OF CALIFORNIA OR ITS OFFICERS OR AGENTS SHALL NOT BE RESPONSIBLE FOR THE ACCURACY OR COMPLETENESS OF SCANNED COPIES OF THIS PLAN SHEET.

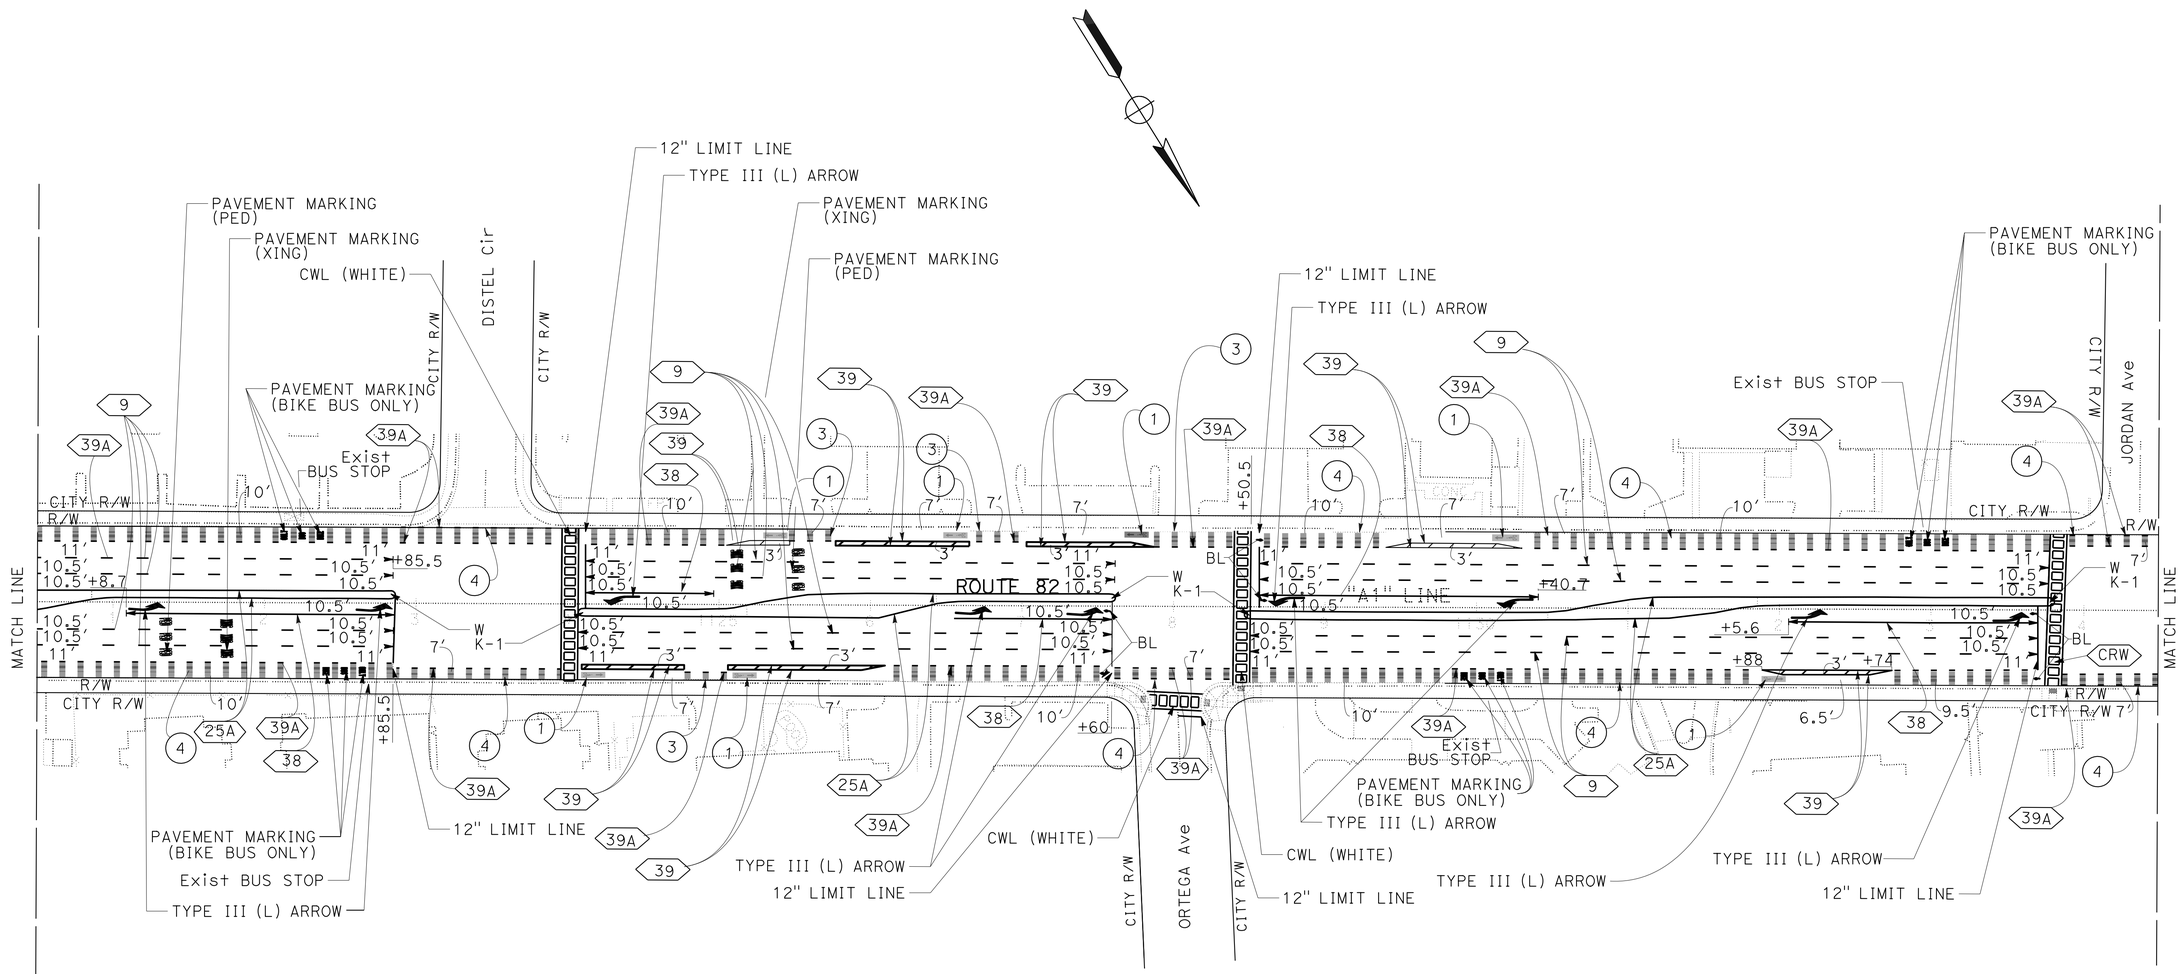

CONTRACT CHANGE ORDER NO. 20
SHEET _____ OF _____

20 REPLACED PER CONTRACT CHANGE ORDER No. 20 DATED

PAVEMENT DELINEATION PLAN

SCALE: 1" = 50'

APPROVED FOR PAVEMENT DELINEATION WORK ONLY

FOR NOTES, ABBREVIATIONS AND LEGEND, SEE SHEET PD-1

PD-12A

STATE OF CALIFORNIA - DEPARTMENT OF TRANSPORTATION
TRAFFIC
FUNCTIONAL SUPERVISOR: LESTER LEE
CALCULATED-DESIGNED BY: SON LY
CHECKED BY: RICK YEUNG
REVISED BY | DATE REVISED: SL | 11-18-22

LAST REVISION | DATE PLOTTED => 18-NOV-2024
TIME PLOTTED => 15:10
01-17-23

BORDER LAST REVISED 7/2/2010
USERNAME => s129144
DGN FILE => 0419000140na012A.cco
RELATIVE BORDER SCALE IS IN INCHES 0 1 2 3
UNIT 0712
PROJECT NUMBER & PHASE 04190001401

Dist	COUNTY	ROUTE	POST MILES TOTAL PROJECT	SHEET No.	TOTAL SHEETS
04	SCl	82	18.2/26.4	230	466

AS-AWARDED CONTRACT PLANS
THIS STAMP PLACED IN LIEU OF ORIGINAL SIGNATURE

REGISTERED CIVIL ENGINEER DATE

PLANS APPROVAL DATE


REGISTERED PROFESSIONAL ENGINEER — No. Exp. CIVIL — STATE OF CALIFORNIA

THE STATE OF CALIFORNIA OR ITS OFFICERS OR AGENTS SHALL NOT BE RESPONSIBLE FOR THE ACCURACY OR COMPLETENESS OF SCANNED COPIES OF THIS PLAN SHEET.

20

NOTE:

FOR ACCURATE RIGHT OF WAY DATA, CONTACT
RIGHT OF WAY ENGINEERING AT THE DISTRICT OFFICE.

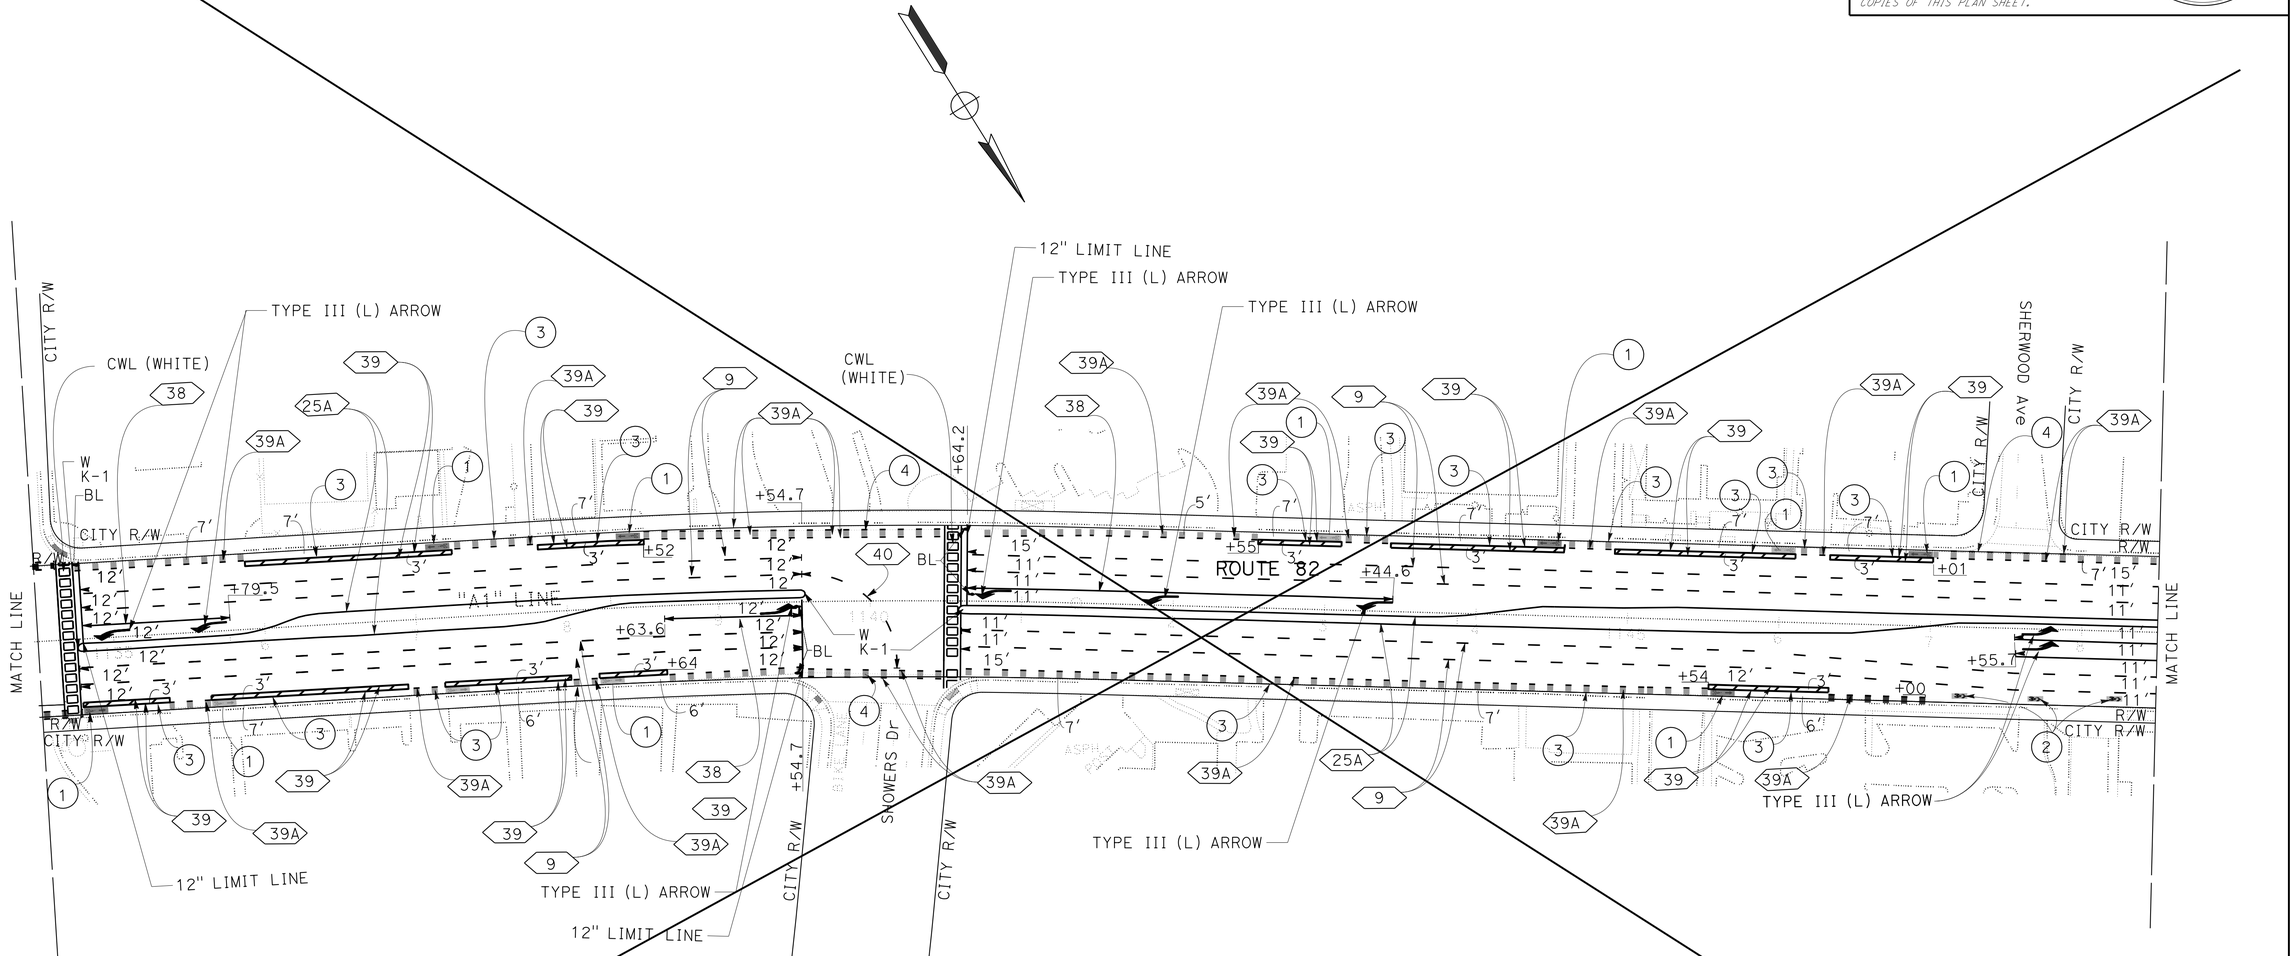

Rick Yeung 60640 12-31-24 CIVIL — REGISTERED PROFESSIONAL ENGINEER — STATE OF CALIFORNIA

FOR REVISION ONLY
July 22, 2024

CONTRACT CHANGE ORDER NO. 20
SHEET _____ OF _____

20 SHEET DELETED PER CONTRACT CHANGE ORDER No. 20 DATED

PAVEMENT DELINEATION PLAN

SCALE: 1" = 50'

APPROVED FOR PAVEMENT DELINEATION WORK ONLY

FOR NOTES, ABBREVIATIONS AND LEGEND, SEE SHEET PD-1

PD-13

STATE OF CALIFORNIA - DEPARTMENT OF TRANSPORTATION
TRAFFIC
Caltrans

FUNCTIONAL SUPERVISOR: LESTER LEE
CALCULATED-DESIGNED BY: RICK YEUNG
CHECKED BY: SON LY
REVISED BY: SL
DATE REVISED: 11-18-22

LAST REVISION | DATE PLOTTED => 18-NOV-2024
TIME PLOTTED => 15:10
01-17-23

BORDER LAST REVISED 7/2/2010
USERNAME => s129144
DGN FILE => 0419000140na013.cco
RELATIVE BORDER SCALE IS IN INCHES 0 1 2 3
UNIT 0712
PROJECT NUMBER & PHASE 04190001401

NOTE:

FOR ACCURATE RIGHT OF WAY DATA, CONTACT
RIGHT OF WAY ENGINEERING AT THE DISTRICT OFFICE.

Dist	COUNTY	ROUTE	POST MILES TOTAL PROJECT	SHEET No.	TOTAL SHEETS
04	SCI	82	18.2/26.4	230A	466


AS-AWARDED CONTRACT PLANS
THIS STAMP PLACED IN LIEU OF ORIGINAL SIGNATURE

REGISTERED CIVIL ENGINEER DATE

January 20, 2023
PLANS APPROVAL DATE

REGISTERED PROFESSIONAL ENGINEER — No. Exp. CIVIL — STATE OF CALIFORNIA

THE STATE OF CALIFORNIA OR ITS OFFICERS OR AGENTS SHALL NOT BE RESPONSIBLE FOR THE ACCURACY OR COMPLETENESS OF SCANNED COPIES OF THIS PLAN SHEET.

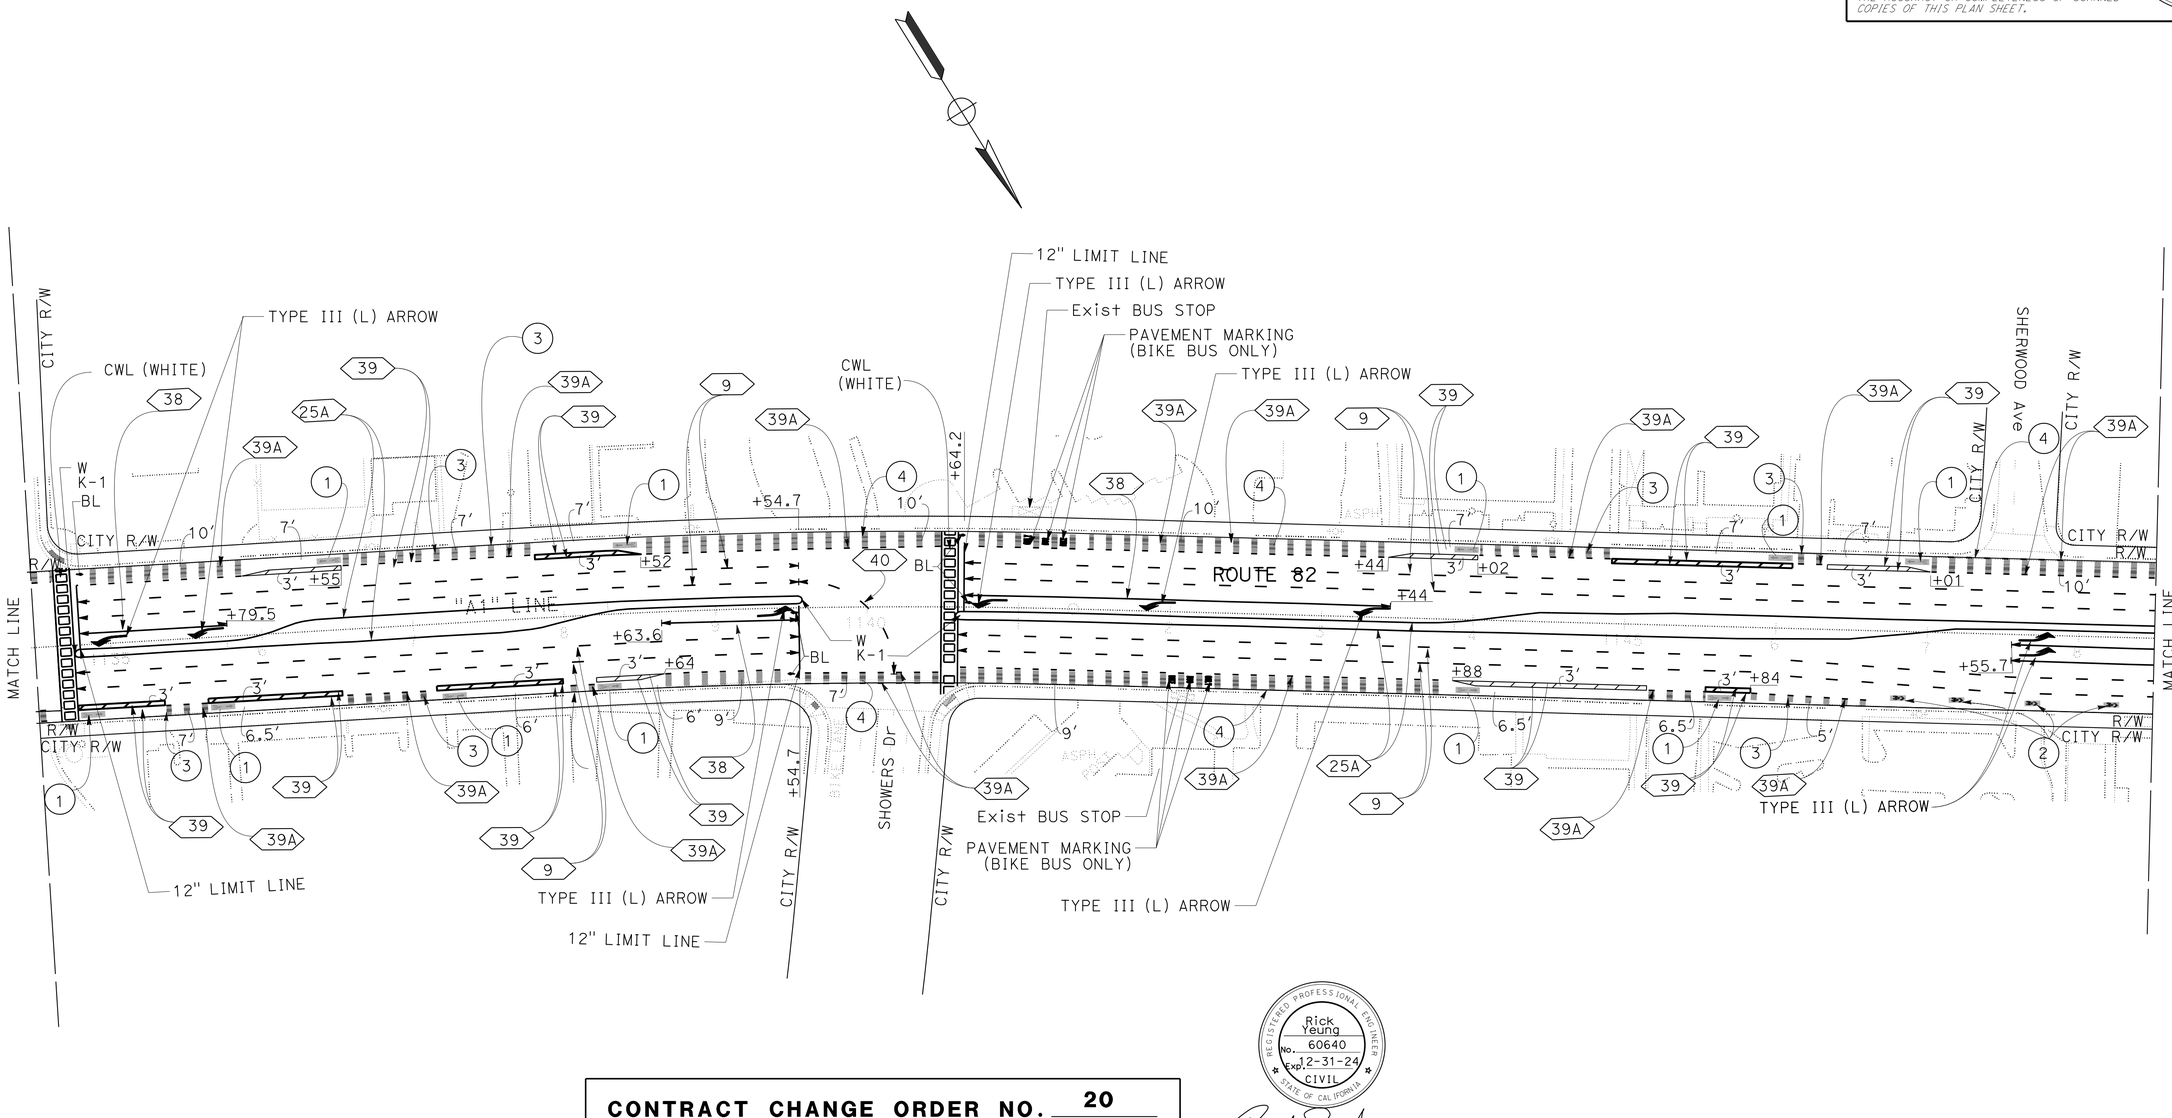

CONTRACT CHANGE ORDER NO. 20
SHEET _____ OF _____

Rick Yeung
No. 60640
Exp. 12-31-24
CIVIL
STATE OF CALIFORNIA

FOR REVISION ONLY
July 22, 2024

20 REPLACED PER CONTRACT CHANGE ORDER No. 20 DATED

PAVEMENT DELINEATION PLAN

SCALE: 1" = 50'

APPROVED FOR PAVEMENT DELINEATION WORK ONLY

FOR NOTES, ABBREVIATIONS AND LEGEND, SEE SHEET PD-1

PD-13A

CALCULATED-DESIGNED BY	SL	REVISED BY	
CHECKED BY	RICK YEUNG	DATE REVISED	11-18-22
FUNCTIONAL SUPERVISOR	LESTER LEE		
STATE OF CALIFORNIA - DEPARTMENT OF TRANSPORTATION	TRAFFIC		

LAST REVISION DATE PLOTTED => 18-NOV-2024
TIME PLOTTED => 15:11
01-17-23

BORDER LAST REVISED 7/2/2010 | USERNAME => s129144 | DGN FILE => 04190001401na013A.cco | RELATIVE BORDER SCALE IS IN INCHES 0 1 2 3 | UNIT 0712 | PROJECT NUMBER & PHASE 04190001401

Dist	COUNTY	ROUTE	POST MILES TOTAL PROJECT	SHEET No.	TOTAL SHEETS
04	SCI	82	18.2/26.4	231	466

AS-AWARDED CONTRACT PLANS
THIS STAMP PLACED IN LIEU OF ORIGINAL SIGNATURE

REGISTERED CIVIL ENGINEER DATE

PLANS APPROVAL DATE


REGISTERED PROFESSIONAL ENGINEER — No. Exp. CIVIL — STATE OF CALIFORNIA

THE STATE OF CALIFORNIA OR ITS OFFICERS OR AGENTS SHALL NOT BE RESPONSIBLE FOR THE ACCURACY OR COMPLETENESS OF SCANNED COPIES OF THIS PLAN SHEET.

20

NOTE:

FOR ACCURATE RIGHT OF WAY DATA, CONTACT
RIGHT OF WAY ENGINEERING AT THE DISTRICT OFFICE.

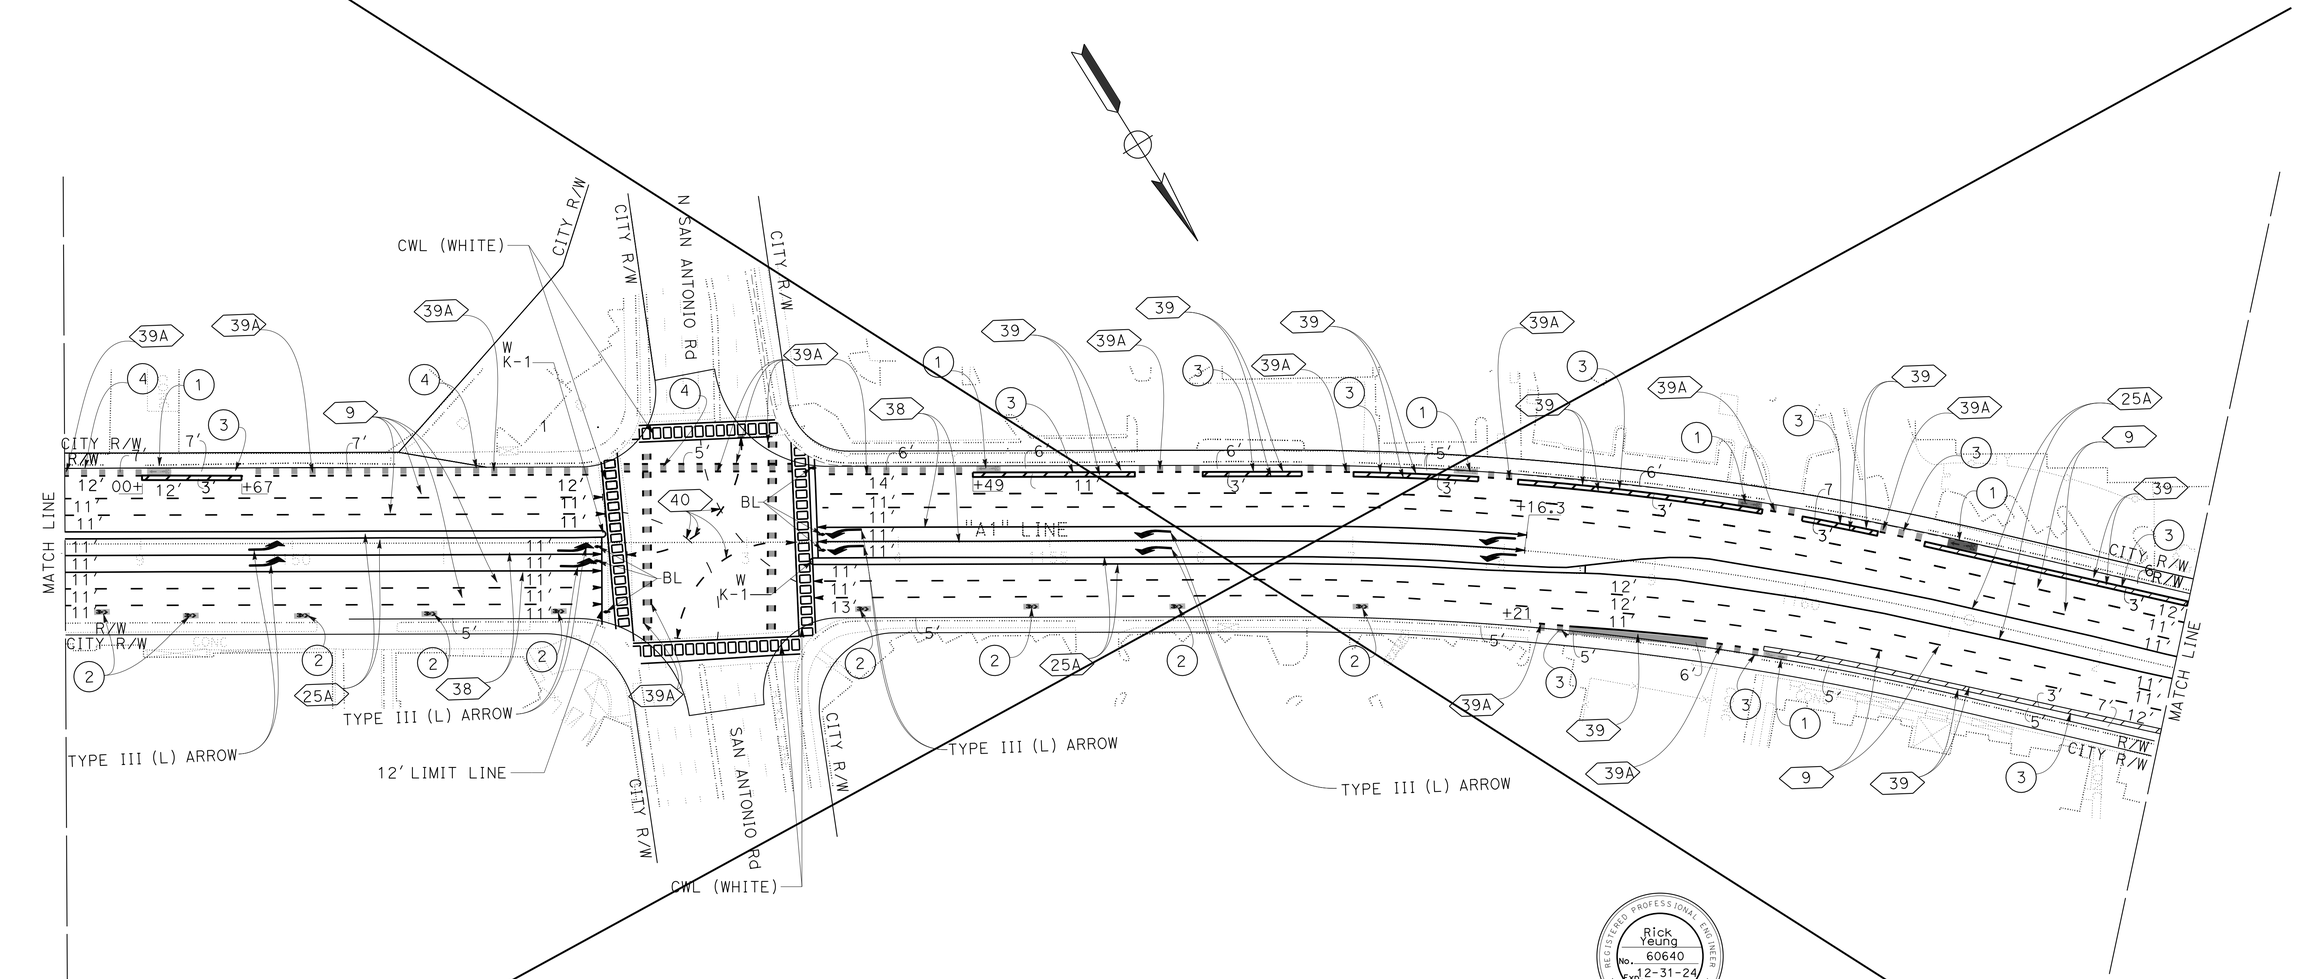

Rick Yeung
No. 60640
Exp. 12-31-24
CIVIL
STATE OF CALIFORNIA

FOR REVISION ONLY
July 22, 2024

CONTRACT CHANGE ORDER NO. 20
SHEET _____ OF _____

20 SHEET DELETED PER CONTRACT CHANGE ORDER No. 20 DATED

PAVEMENT DELINEATION PLAN

SCALE: 1" = 50'

APPROVED FOR PAVEMENT DELINEATION WORK ONLY

FOR NOTES, ABBREVIATIONS AND LEGEND, SEE SHEET PD-1

PD-14

CALCULATED-DESIGNED BY: RICK YEUNG
CHECKED BY: SON LY
REVISED BY: SL
DATE REVISED: 11-18-22
FUNCTIONAL SUPERVISOR: LESTER LEE

STATE OF CALIFORNIA - DEPARTMENT OF TRANSPORTATION
TRAFFIC

LAST REVISION DATE PLOTTED => 18-NOV-2024
TIME PLOTTED => 15:11
01-17-23

BORDER LAST REVISED 7/2/2010
USERNAME => s129144
DGN FILE => 0419000140na014.cco
RELATIVE BORDER SCALE IS IN INCHES 0 1 2 3
UNIT 0712
PROJECT NUMBER & PHASE 04190001401

Dist	COUNTY	ROUTE	POST MILES TOTAL PROJECT	SHEET No.	TOTAL SHEETS
04	SCl	82	18.2/26.4	231	466

AS-AWARDED CONTRACT PLANS
THIS STAMP PLACED IN LIEU OF ORIGINAL SIGNATURE

REGISTERED CIVIL ENGINEER DATE

PLANS APPROVAL DATE


REGISTERED PROFESSIONAL ENGINEER — No. Exp. CIVIL — STATE OF CALIFORNIA

THE STATE OF CALIFORNIA OR ITS OFFICERS OR AGENTS SHALL NOT BE RESPONSIBLE FOR THE ACCURACY OR COMPLETENESS OF SCANNED COPIES OF THIS PLAN SHEET.

20

NOTE:

FOR ACCURATE RIGHT OF WAY DATA, CONTACT
RIGHT OF WAY ENGINEERING AT THE DISTRICT OFFICE.

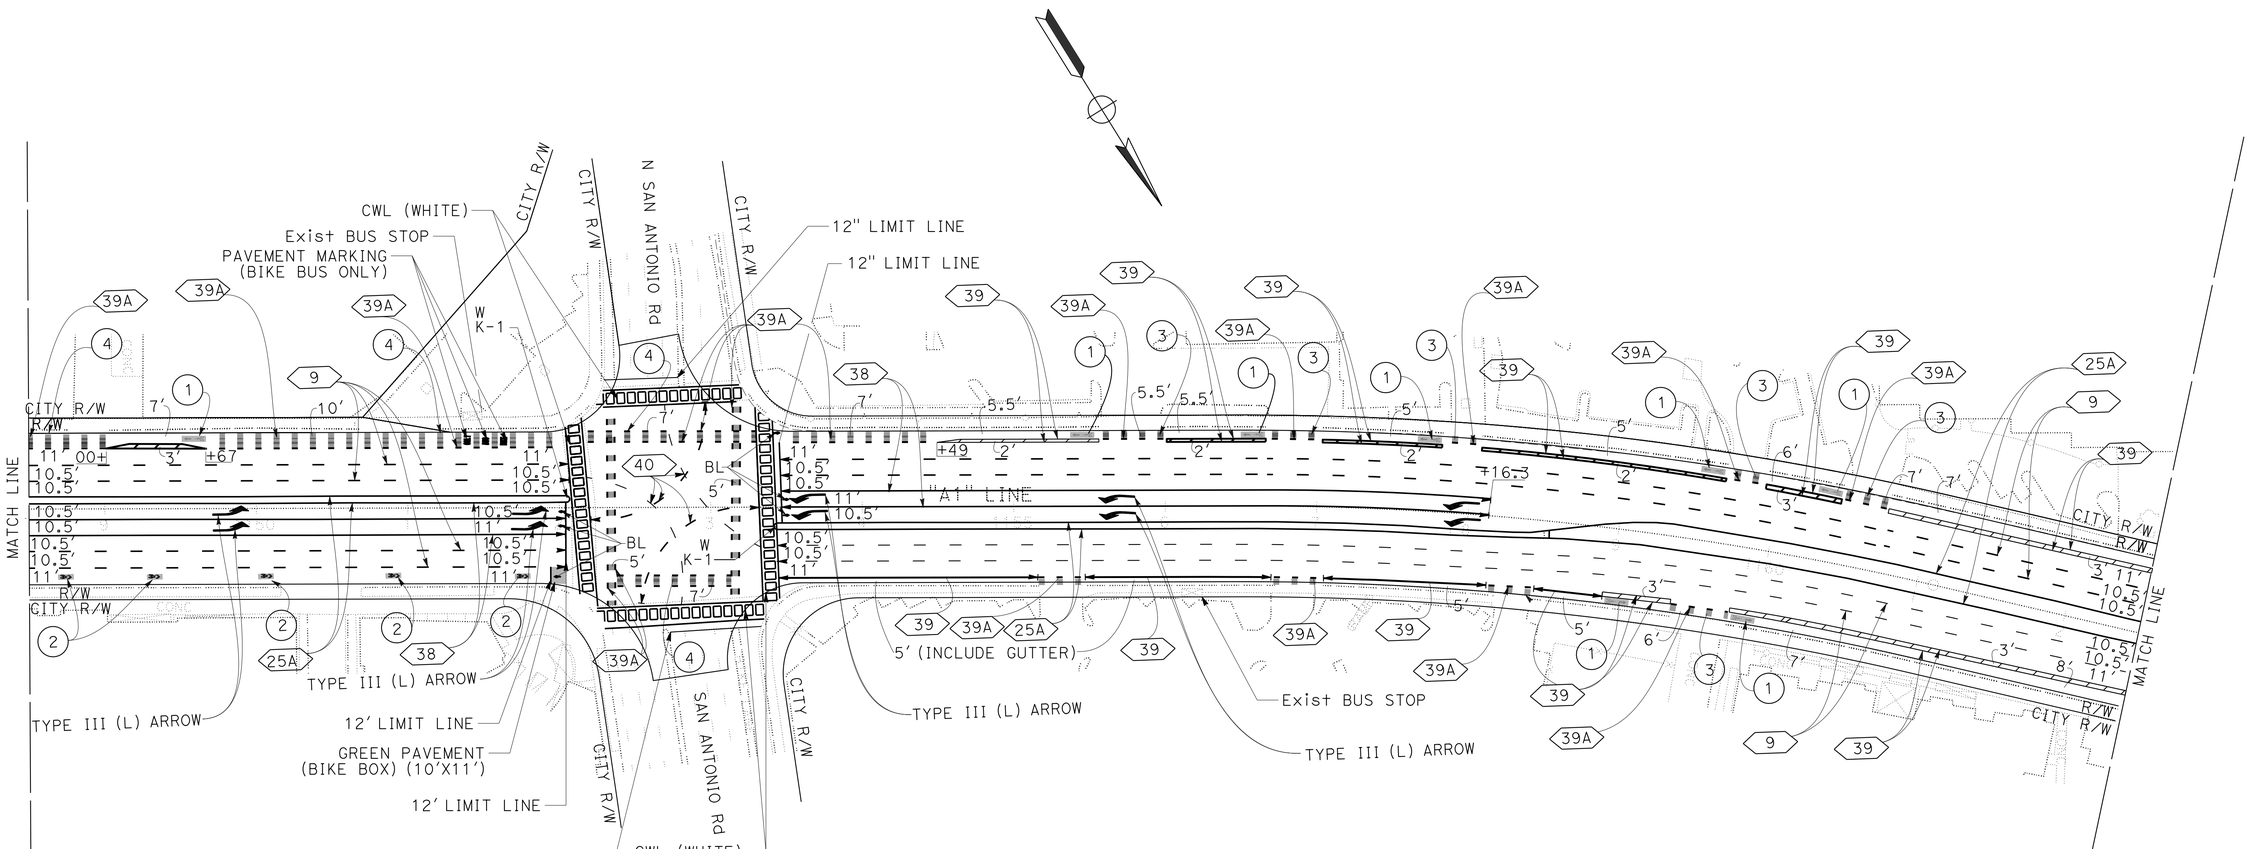

CONTRACT CHANGE ORDER NO. 20
SHEET _____ OF _____

Rick Yeung
No. 60640
Exp. 12-31-24
CIVIL
REGISTERED PROFESSIONAL ENGINEER — STATE OF CALIFORNIA

FOR REVISION ONLY
July 22, 2024

20 REPLACED PER CONTRACT CHANGE ORDER No. 20 DATED

PAVEMENT DELINEATION PLAN

SCALE: 1" = 50'

APPROVED FOR PAVEMENT DELINEATION WORK ONLY

FOR NOTES, ABBREVIATIONS AND LEGEND, SEE SHEET PD-1

PD-14A

CALCULATED-DESIGNED BY	CHECKED BY	REVISED BY	DATE REVISED
SON LY	RICK YEUNG	SL	11-18-22

FUNCTIONAL SUPERVISOR: LESTER LEE

STATE OF CALIFORNIA - DEPARTMENT OF TRANSPORTATION
TRAFFIC

LAST REVISION | DATE PLOTTED => 18-NOV-2024
TIME PLOTTED => 15:11
01-17-23

BORDER LAST REVISED 7/2/2010

USERNAME => s129144
DGN FILE => 0419000140na014A.cco

RELATIVE BORDER SCALE IS IN INCHES 0 1 2 3

UNIT 0712 | PROJECT NUMBER & PHASE 04190001401

NOTE:

FOR ACCURATE RIGHT OF WAY DATA, CONTACT
RIGHT OF WAY ENGINEERING AT THE DISTRICT OFFICE.

Dist	COUNTY	ROUTE	POST MILES TOTAL PROJECT	SHEET No.	TOTAL SHEETS
04	SCI	82	18.2/26.4	232	466

20


AS-AWARDED CONTRACT PLANS
THIS STAMP PLACED IN LIEU OF ORIGINAL SIGNATURE

REGISTERED CIVIL ENGINEER DATE

PLANS APPROVAL DATE

REGISTERED PROFESSIONAL ENGINEER
No.
Exp.
CIVIL
STATE OF CALIFORNIA

THE STATE OF CALIFORNIA OR ITS OFFICERS OR AGENTS SHALL NOT BE RESPONSIBLE FOR THE ACCURACY OR COMPLETENESS OF SCANNED COPIES OF THIS PLAN SHEET.

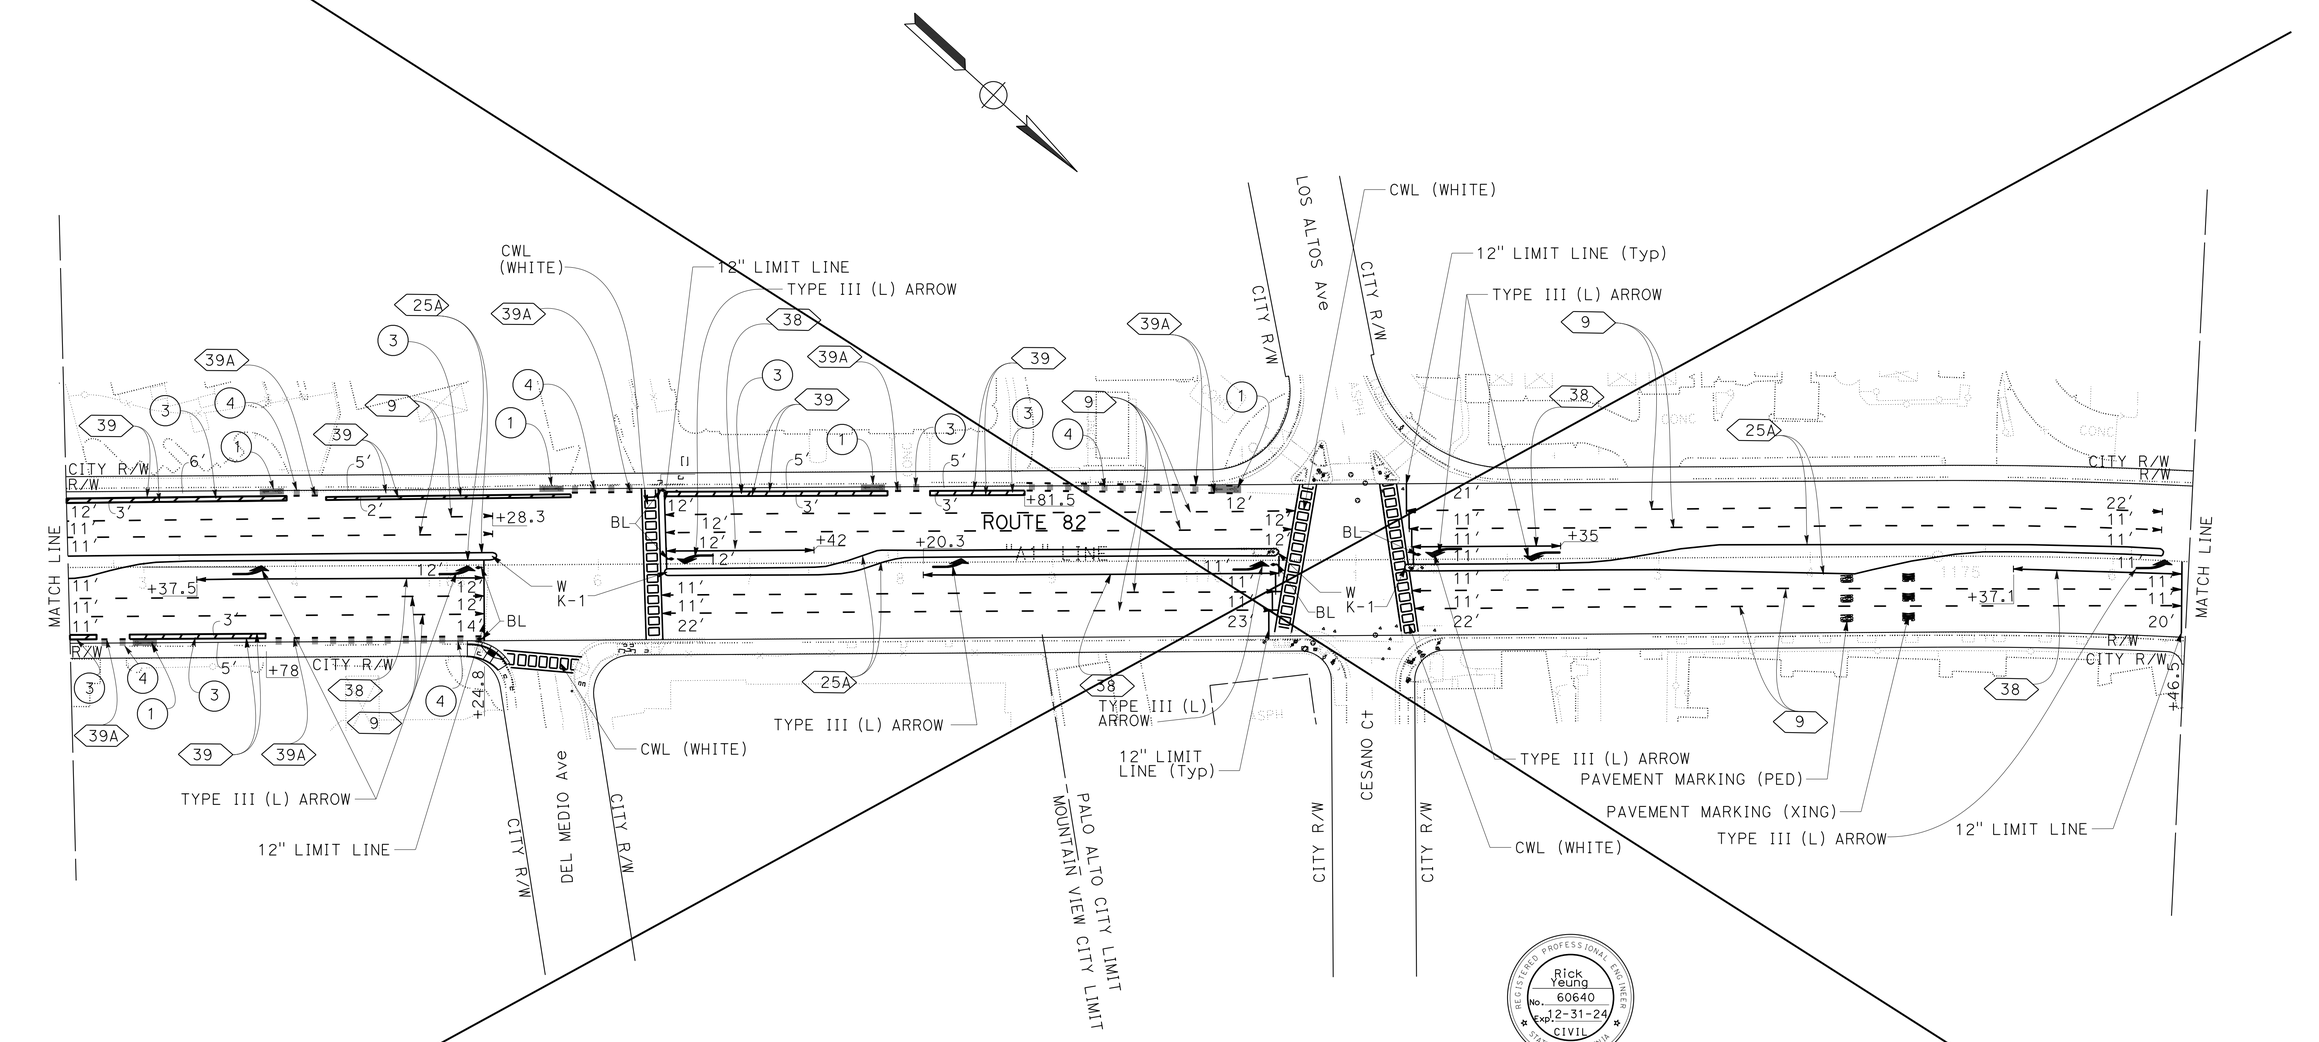

REGISTERED PROFESSIONAL ENGINEER
Rick Yeung
No. 60640
Exp. 12-31-24
CIVIL
STATE OF CALIFORNIA

CONTRACT CHANGE ORDER NO. 20
SHEET _____ OF _____

FOR REVISION ONLY
July 22, 2024

20 **SHEET DELETED PER CONTRACT CHANGE ORDER No. 20 DATED**

PAVEMENT DELINEATION PLAN

SCALE: 1" = 50'

APPROVED FOR PAVEMENT DELINEATION WORK ONLY

FOR NOTES, ABBREVIATIONS AND LEGEND, SEE SHEET PD-1

PD-15

CALCULATED-DESIGNED BY	CHECKED BY	REVISED BY	DATE REVISED
RICK YEUNG	SON LY	SL	11-18-22

FUNCTIONAL SUPERVISOR: LESTER LEE

STATE OF CALIFORNIA - DEPARTMENT OF TRANSPORTATION
Caltrans® TRAFFIC

LAST REVISION: DATE PLOTTED => 18-NOV-2024
TIME PLOTTED => 15:11
09-15-22

BORDER LAST REVISED 7/2/2010 | USERNAME => s129144 | DGN FILE => 0419000140na015.cco | RELATIVE BORDER SCALE IS IN INCHES 0 1 2 3 | UNIT 0712 | PROJECT NUMBER & PHASE 04190001401

NOTE:

FOR ACCURATE RIGHT OF WAY DATA, CONTACT
RIGHT OF WAY ENGINEERING AT THE DISTRICT OFFICE.

Dist	COUNTY	ROUTE	POST MILES TOTAL PROJECT	SHEET No.	TOTAL SHEETS
04	SCI	82	18.2/26.4	232	466

20


AS-AWARDED CONTRACT PLANS
THIS STAMP PLACED IN LIEU OF ORIGINAL SIGNATURE

REGISTERED CIVIL ENGINEER DATE

PLANS APPROVAL DATE

REGISTERED PROFESSIONAL ENGINEER
No.
Exp.
CIVIL
STATE OF CALIFORNIA

THE STATE OF CALIFORNIA OR ITS OFFICERS OR AGENTS SHALL NOT BE RESPONSIBLE FOR THE ACCURACY OR COMPLETENESS OF SCANNED COPIES OF THIS PLAN SHEET.

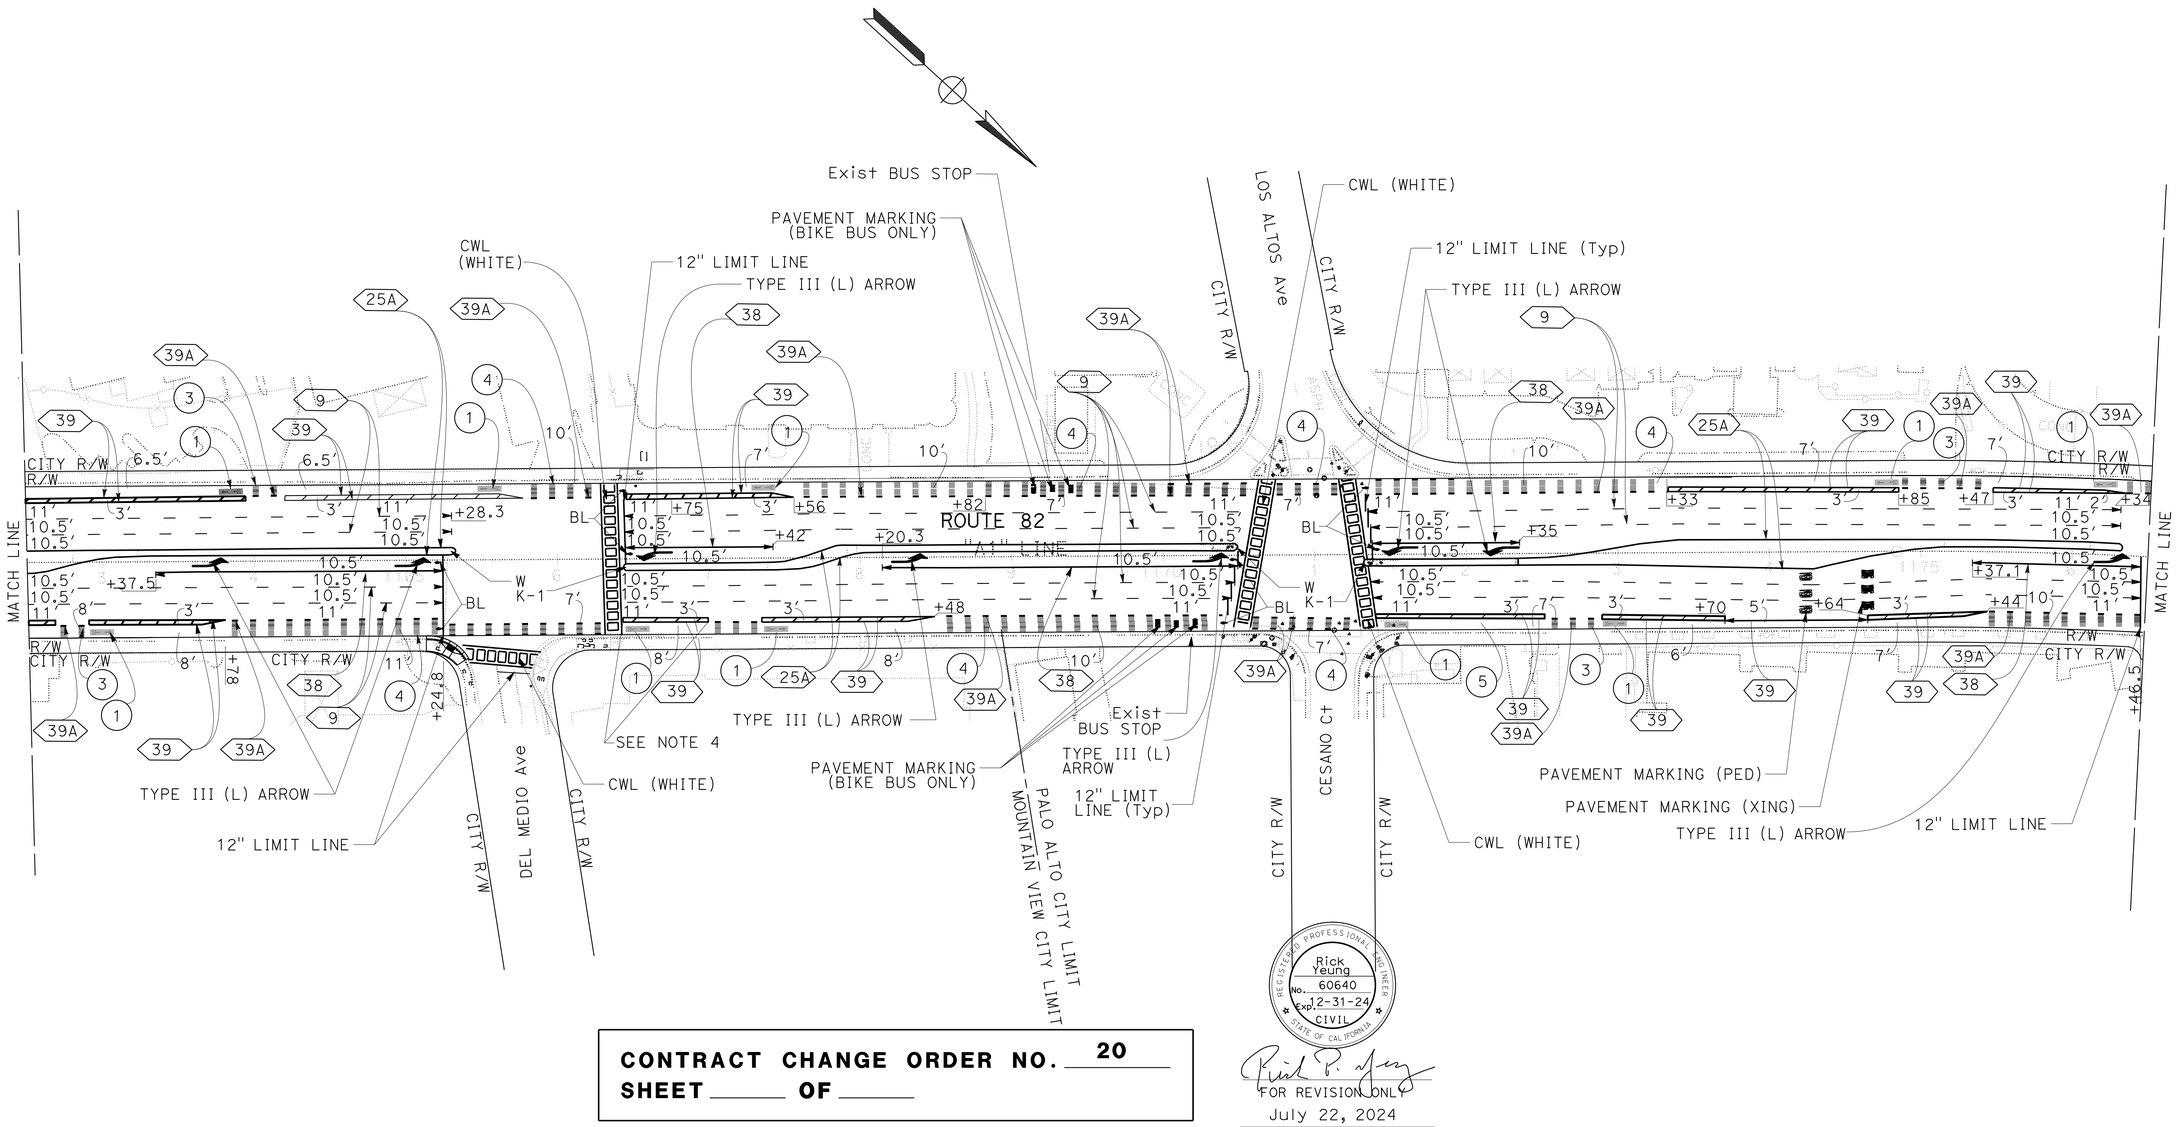

CONTRACT CHANGE ORDER NO. 20
SHEET _____ OF _____

Rick Yeung
No. 60640
Exp. 12-31-24
CIVIL
STATE OF CALIFORNIA

FOR REVISION ONLY
July 22, 2024

20 **REPLACED PER CONTRACT CHANGE ORDER No. 20 DATED**

PAVEMENT DELINEATION PLAN

SCALE: 1" = 50'

APPROVED FOR PAVEMENT DELINEATION WORK ONLY

FOR NOTES, ABBREVIATIONS AND LEGEND, SEE SHEET PD-1

PD-15A

CALCULATED-DESIGNED BY	CHECKED BY	REVISED BY	DATE REVISED
SON LY	RICK YEUNG	SL	11-18-22

FUNCTIONAL SUPERVISOR: LESTER LEE

STATE OF CALIFORNIA - DEPARTMENT OF TRANSPORTATION
TRAFFIC

Caltrans

LAST REVISION | DATE PLOTTED => 18-NOV-2024
09-15-22 | TIME PLOTTED => 15:11

BORDER LAST REVISED 7/2/2010 | USERNAME => s129144 | DGN FILE => 0419000140na015A.cco | RELATIVE BORDER SCALE IS IN INCHES 0 1 2 3 | UNIT 0712 | PROJECT NUMBER & PHASE 04190001401

Dist	COUNTY	ROUTE	POST MILES TOTAL PROJECT	SHEET No.	TOTAL SHEETS
04	SCI	82	18.2/26.4	233	466

20

AS-AWARDED CONTRACT PLANS
THIS STAMP PLACED IN LIEU OF ORIGINAL SIGNATURE

REGISTERED CIVIL ENGINEER DATE


PLANS APPROVAL DATE

REGISTERED PROFESSIONAL ENGINEER — No. Exp. CIVIL — STATE OF CALIFORNIA

THE STATE OF CALIFORNIA OR ITS OFFICERS OR AGENTS SHALL NOT BE RESPONSIBLE FOR THE ACCURACY OR COMPLETENESS OF SCANNED COPIES OF THIS PLAN SHEET.

NOTE:

FOR ACCURATE RIGHT OF WAY DATA, CONTACT
RIGHT OF WAY ENGINEERING AT THE DISTRICT OFFICE.

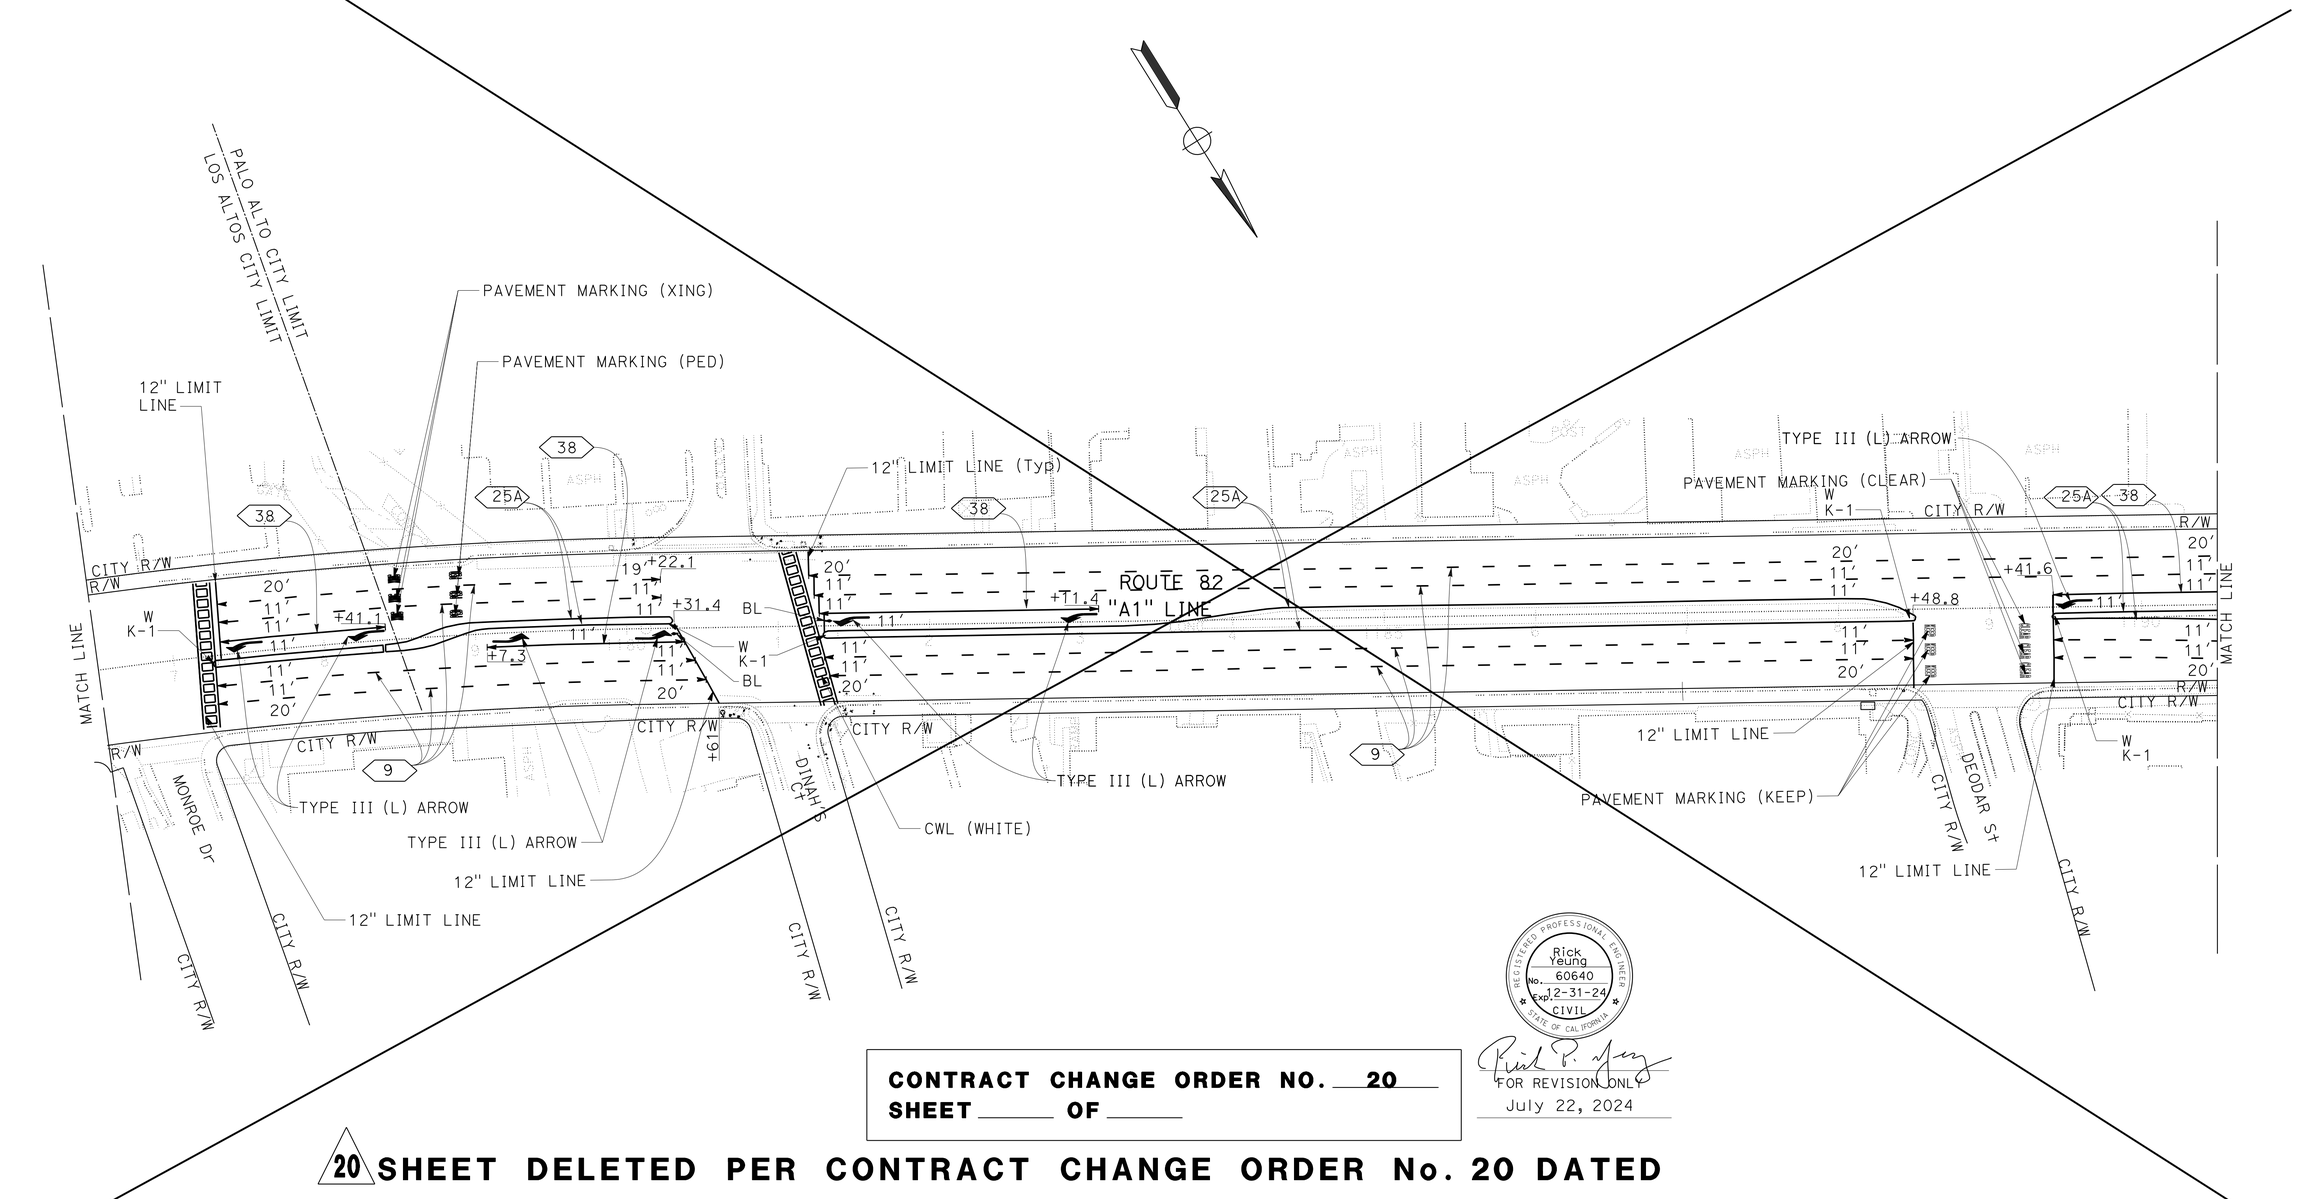

REGISTERED PROFESSIONAL ENGINEER — Rick Yeung — No. 60640 — Exp. 12-31-24 — CIVIL — STATE OF CALIFORNIA

FOR REVISION ONLY
July 22, 2024

CONTRACT CHANGE ORDER NO. 20
SHEET _____ OF _____

20 SHEET DELETED PER CONTRACT CHANGE ORDER No. 20 DATED

PAVEMENT DELINEATION PLAN

SCALE: 1" = 50'

APPROVED FOR PAVEMENT DELINEATION WORK ONLY

FOR NOTES, ABBREVIATIONS AND LEGEND, SEE SHEET PD-1

PD-16

CALCULATED-DESIGNED BY	RICK YEUNG	REVISED BY	SL
CHECKED BY	SON LY	DATE REVISED	11-18-22

FUNCTIONAL SUPERVISOR: LESTER LEE

STATE OF CALIFORNIA - DEPARTMENT OF TRANSPORTATION
Caltrans® TRAFFIC

LAST REVISION — DATE PLOTTED => 18-NOV-2024
09-15-22 — TIME PLOTTED => 15:11

BORDER LAST REVISED 7/2/2010 | USERNAME => s129144 | DGN FILE => 0419000140na016.cco | RELATIVE BORDER SCALE IS IN INCHES 0 1 2 3 | UNIT 0712 | PROJECT NUMBER & PHASE 04190001401

Dist	COUNTY	ROUTE	POST MILES TOTAL PROJECT	SHEET No.	TOTAL SHEETS
04	SCI	82	18.2/26.4	233	466

AS-AWARDED CONTRACT PLANS
THIS STAMP PLACED IN LIEU OF ORIGINAL SIGNATURE

REGISTERED CIVIL ENGINEER DATE

PLANS APPROVAL DATE


REGISTERED PROFESSIONAL ENGINEER — No. Exp. CIVIL — STATE OF CALIFORNIA

THE STATE OF CALIFORNIA OR ITS OFFICERS OR AGENTS SHALL NOT BE RESPONSIBLE FOR THE ACCURACY OR COMPLETENESS OF SCANNED COPIES OF THIS PLAN SHEET.

20

NOTE:

FOR ACCURATE RIGHT OF WAY DATA, CONTACT
RIGHT OF WAY ENGINEERING AT THE DISTRICT OFFICE.

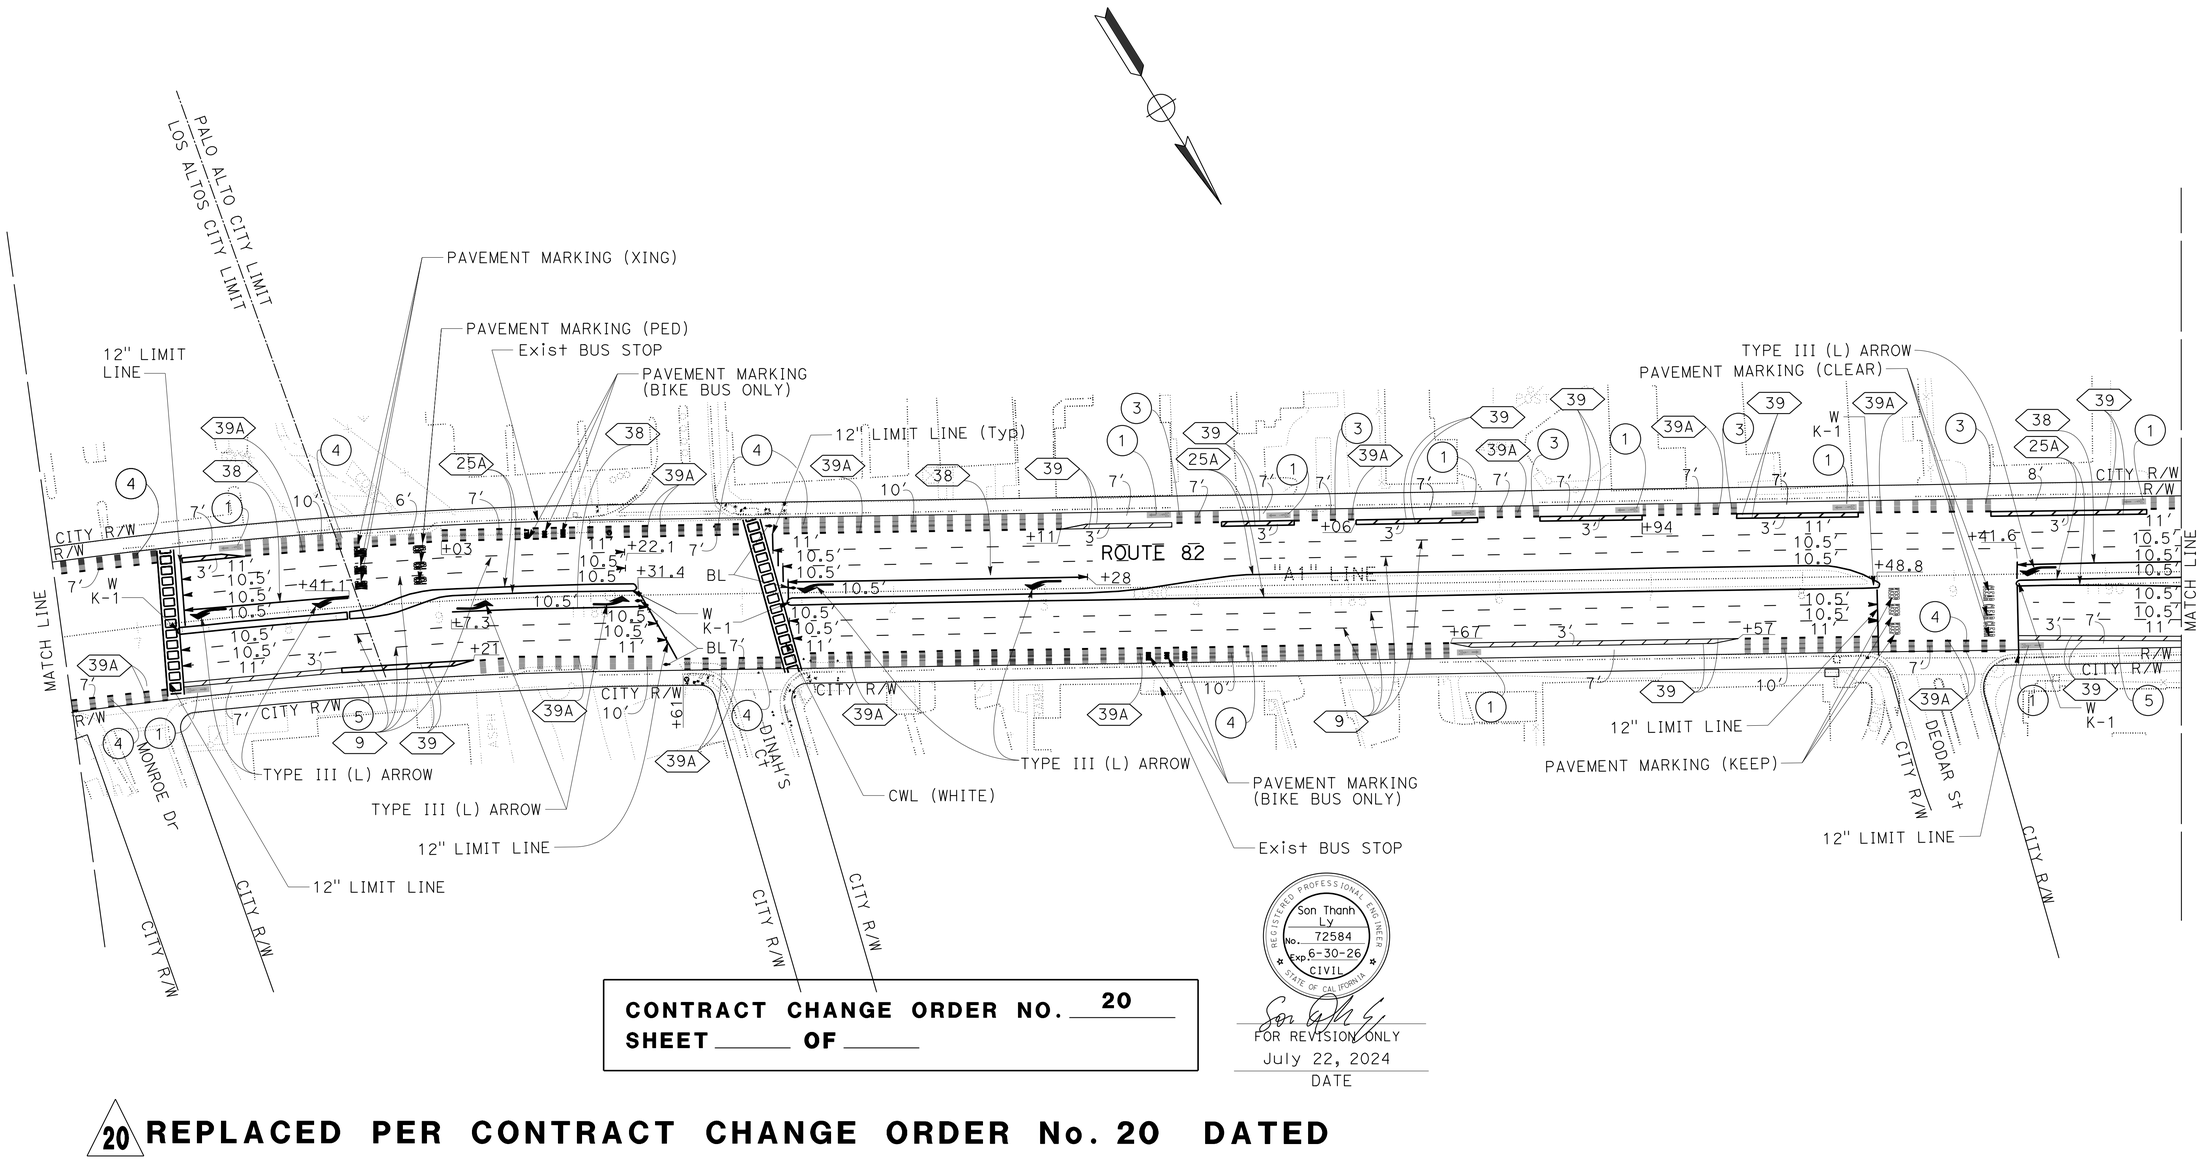

CONTRACT CHANGE ORDER NO. 20
SHEET _____ OF _____

REGISTERED PROFESSIONAL ENGINEER — Son Thanh Ly — No. 72584 — Exp. 6-30-26 — CIVIL — STATE OF CALIFORNIA

FOR REVISION ONLY
July 22, 2024
DATE

20 REPLACED PER CONTRACT CHANGE ORDER No. 20 DATED

PAVEMENT DELINEATION PLAN

SCALE: 1" = 50'

APPROVED FOR PAVEMENT DELINEATION WORK ONLY

FOR NOTES, ABBREVIATIONS AND LEGEND, SEE SHEET PD-1

PD-16A

CALCULATED-DESIGNED BY	SL	REVISED BY	
CHECKED BY	11-18-22	DATE REVISED	
SON LY	FUNCTIONAL SUPERVISOR		
RICK YEUNG	LESTER LEE		

STATE OF CALIFORNIA - DEPARTMENT OF TRANSPORTATION
Caltrans®
TRAFFIC

LAST REVISION DATE PLOTTED => 18-NOV-2024
09-15-22 TIME PLOTTED => 5:11

BORDER LAST REVISED 7/2/2010 | USERNAME => s129144 | DGN FILE => 0419000140na016A.cco | RELATIVE BORDER SCALE IS IN INCHES 0 1 2 3 | UNIT 0712 | PROJECT NUMBER & PHASE 04190001401

Dist	COUNTY	ROUTE	POST MILES TOTAL PROJECT	SHEET No.	TOTAL SHEETS
04	SCI	82	18.2/26.4	234	466

20

AS-AWARDED CONTRACT PLANS
THIS STAMP PLACED IN LIEU OF ORIGINAL SIGNATURE

REGISTERED CIVIL ENGINEER DATE


PLANS APPROVAL DATE

REGISTERED PROFESSIONAL ENGINEER — No. Exp. CIVIL — STATE OF CALIFORNIA

THE STATE OF CALIFORNIA OR ITS OFFICERS OR AGENTS SHALL NOT BE RESPONSIBLE FOR THE ACCURACY OR COMPLETENESS OF SCANNED COPIES OF THIS PLAN SHEET.

NOTE:

FOR ACCURATE RIGHT OF WAY DATA, CONTACT
RIGHT OF WAY ENGINEERING AT THE DISTRICT OFFICE.

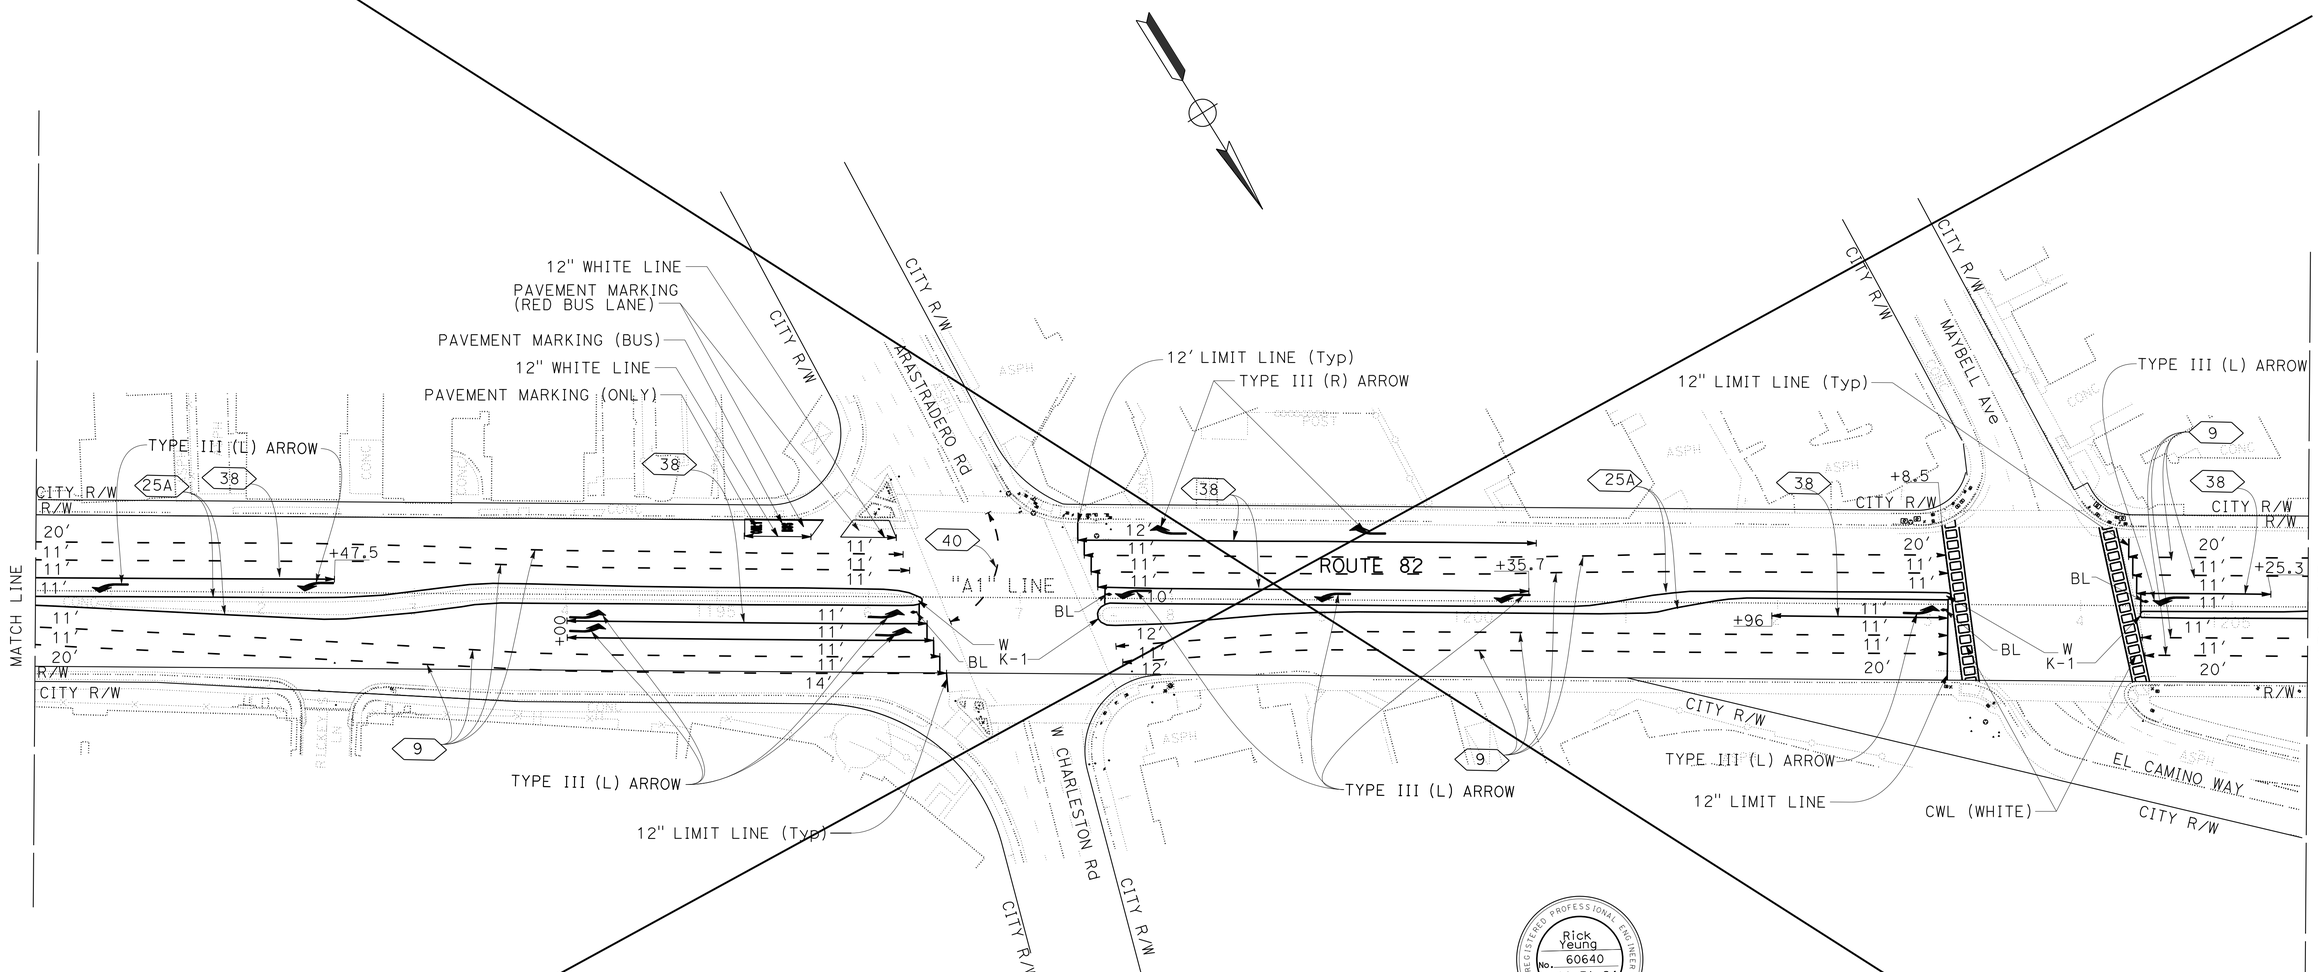

CONTRACT CHANGE ORDER NO. 20
SHEET ____ OF ____

REGISTERED PROFESSIONAL ENGINEER — Rick Yeung — No. 60640 — Exp. 12-31-24 — CIVIL — STATE OF CALIFORNIA

FOR REVISION ONLY
July 22, 2024

20 **SHEET DELETED PER CONTRACT CHANGE ORDER No. 20 DATED**

PAVEMENT DELINEATION PLAN

SCALE: 1" = 50'

APPROVED FOR PAVEMENT DELINEATION WORK ONLY

FOR NOTES, ABBREVIATIONS AND LEGEND, SEE SHEET PD-1

PD-17

CALCULATED-DESIGNED BY	CHECKED BY	REVISED BY	DATE REVISED
RICK YEUNG	SON LY	SL	11-18-22

FUNCTIONAL SUPERVISOR: LESTER LEE

STATE OF CALIFORNIA - DEPARTMENT OF TRANSPORTATION
Caltrans®
TRAFFIC

LAST REVISION: DATE PLOTTED => 18-NOV-2024 09-15-22 TIME PLOTTED => 15:12

BORDER LAST REVISED 7/2/2010 | USERNAME => s129144 | DGN FILE => 0419000140na017.cco | RELATIVE BORDER SCALE IS IN INCHES 0 1 2 3 | UNIT 0712 | PROJECT NUMBER & PHASE 04190001401

NOTE:

FOR ACCURATE RIGHT OF WAY DATA, CONTACT
RIGHT OF WAY ENGINEERING AT THE DISTRICT OFFICE.

20

Dist	COUNTY	ROUTE	POST MILES TOTAL PROJECT	SHEET No.	TOTAL SHEETS
04	SCl	82	18.2/26.4	234	466


AS-AWARDED CONTRACT PLANS
THIS STAMP PLACED IN LIEU OF ORIGINAL SIGNATURE

REGISTERED CIVIL ENGINEER DATE

PLANS APPROVAL DATE

REGISTERED PROFESSIONAL ENGINEER — No. Exp. CIVIL — STATE OF CALIFORNIA

THE STATE OF CALIFORNIA OR ITS OFFICERS OR AGENTS SHALL NOT BE RESPONSIBLE FOR THE ACCURACY OR COMPLETENESS OF SCANNED COPIES OF THIS PLAN SHEET.

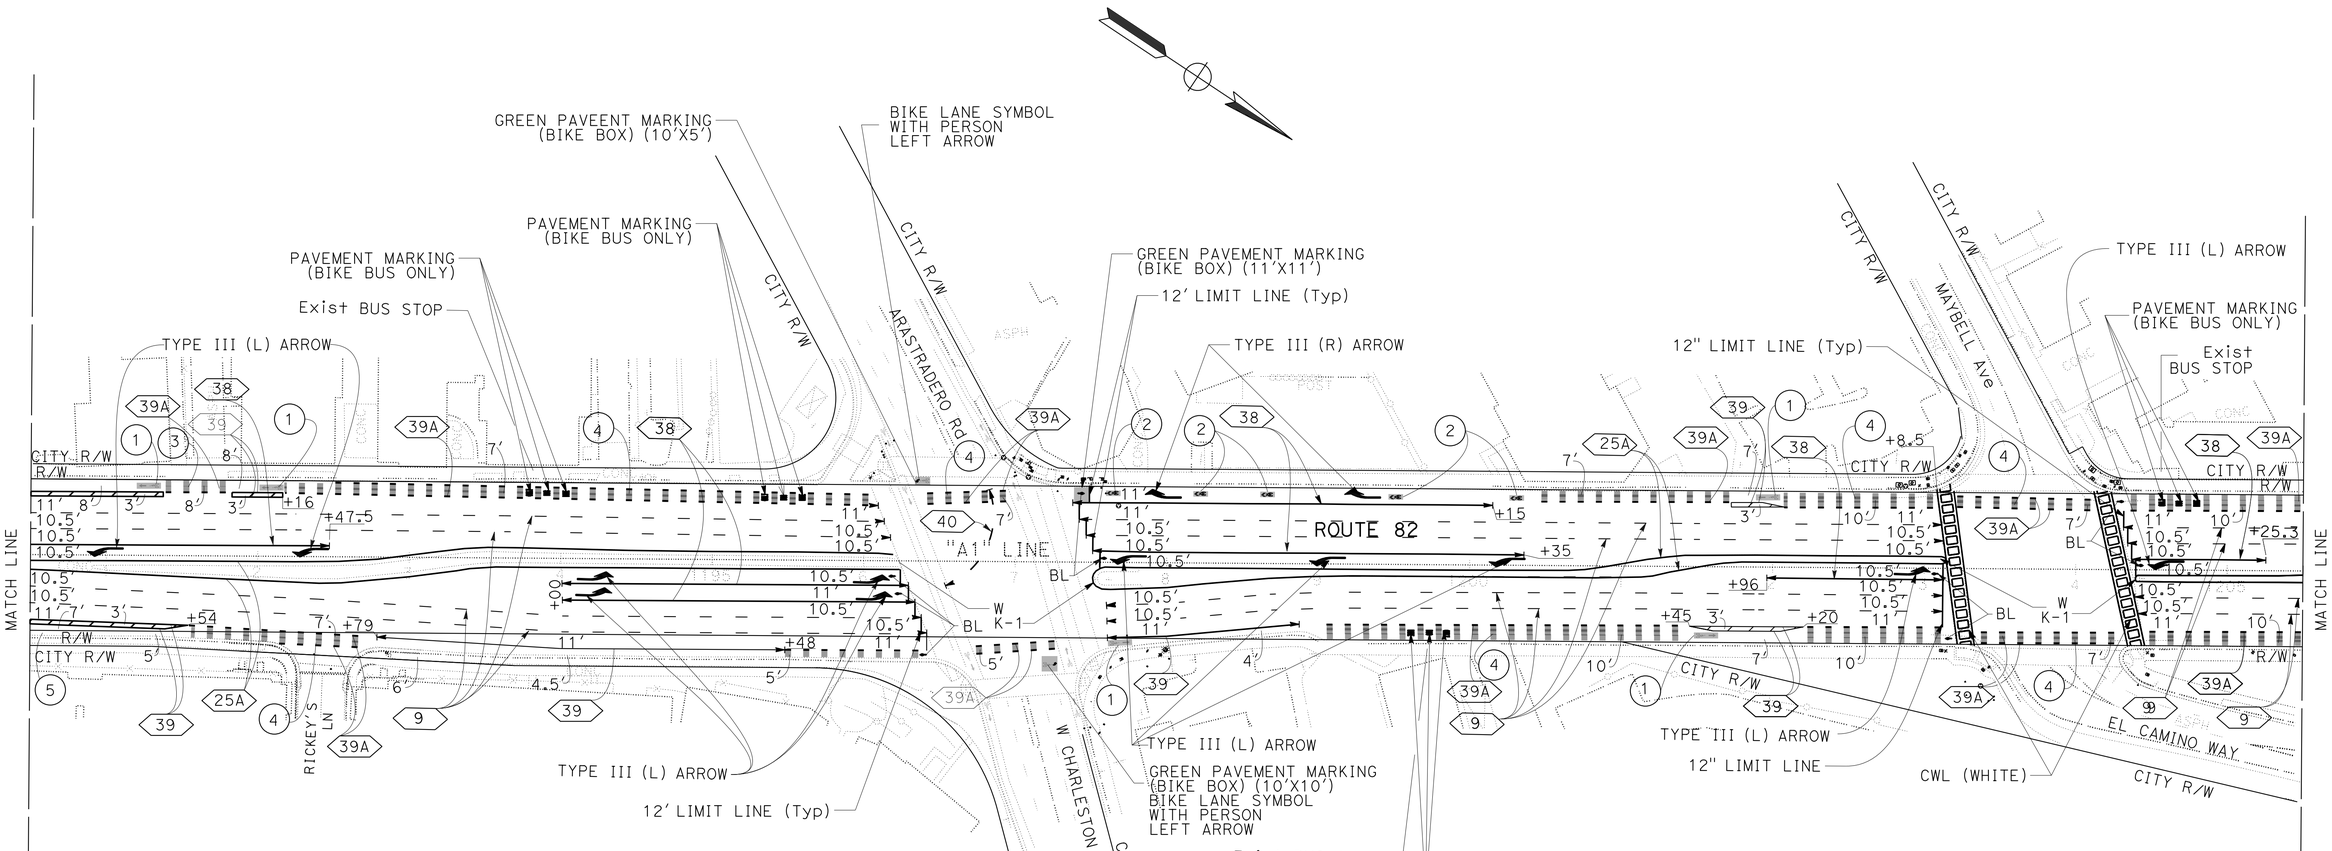

CONTRACT CHANGE ORDER NO. 20
SHEET _____ OF _____

REGISTERED PROFESSIONAL ENGINEER — Rick Yeung — No. 60640 — Exp. 12-31-24 — CIVIL — STATE OF CALIFORNIA

FOR REVISION ONLY
July 22, 2024

20 **REPLACED PER CONTRACT CHANGE ORDER No. 20 DATED**

APPROVED FOR PAVEMENT DELINEATION WORK ONLY

PAVEMENT DELINEATION PLAN

SCALE: 1" = 50'

FOR NOTES, ABBREVIATIONS AND LEGEND, SEE SHEET PD-1

PD-17A

REVISED BY	DATE REVISED
SL	11-18-22

CALCULATED-DESIGNED BY: SON LY
CHECKED BY: RICK YEUNG
FUNCTIONAL SUPERVISOR: LESTER LEE

STATE OF CALIFORNIA - DEPARTMENT OF TRANSPORTATION
Caltrans® TRAFFIC

LAST REVISION: DATE PLOTTED => 18-NOV-2024 TIME PLOTTED => 16:13
09-15-22

BORDER LAST REVISED 7/2/2010 | USERNAME => s129144 | DGN FILE => 0419000140na017A.cco | RELATIVE BORDER SCALE IS IN INCHES 0 1 2 3 | UNIT 0712 | PROJECT NUMBER & PHASE 04190001401

Dist	COUNTY	ROUTE	POST MILES TOTAL PROJECT	SHEET No.	TOTAL SHEETS
04	SCI	82	18.2/26.4	235	466

AS-AWARDED CONTRACT PLANS
THIS STAMP PLACED IN LIEU OF ORIGINAL SIGNATURE

REGISTERED CIVIL ENGINEER DATE

PLANS APPROVAL DATE


REGISTERED PROFESSIONAL ENGINEER — No. Exp. CIVIL — STATE OF CALIFORNIA

THE STATE OF CALIFORNIA OR ITS OFFICERS OR AGENTS SHALL NOT BE RESPONSIBLE FOR THE ACCURACY OR COMPLETENESS OF SCANNED COPIES OF THIS PLAN SHEET.

NOTE:

FOR ACCURATE RIGHT OF WAY DATA, CONTACT RIGHT OF WAY ENGINEERING AT THE DISTRICT OFFICE.

20

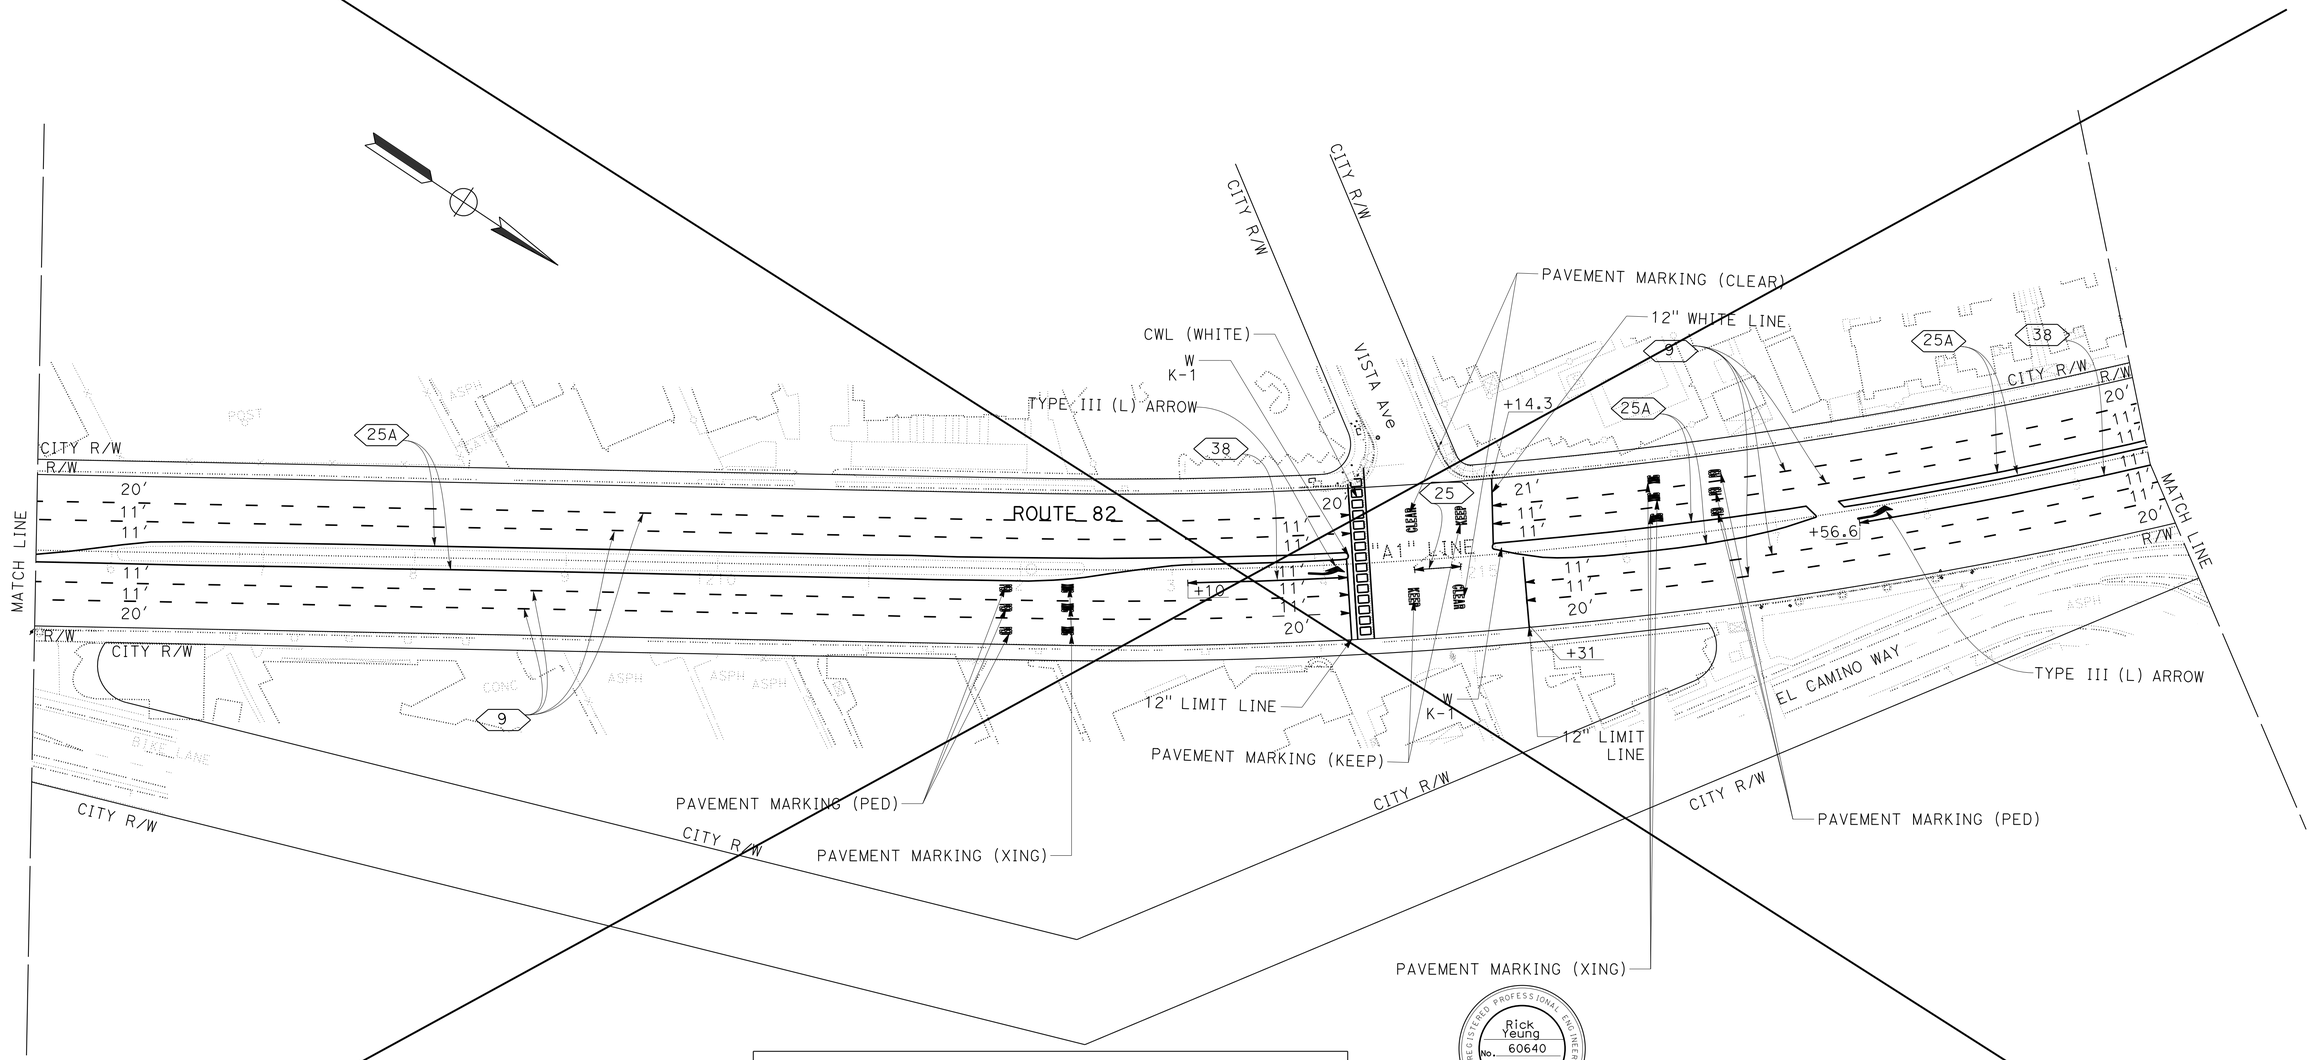

CONTRACT CHANGE ORDER NO. 20
SHEET _____ OF _____

REGISTERED PROFESSIONAL ENGINEER — Rick Yeung — No. 60640 — Exp. 12-31-24 — CIVIL — STATE OF CALIFORNIA

FOR REVISION ONLY
July 22, 2024

20 **SHEET DELETED PER CONTRACT CHANGE ORDER No. 20 DATED**

APPROVED FOR PAVEMENT DELINEATION WORK ONLY

PAVEMENT DELINEATION PLAN

SCALE: 1" = 50′

FOR NOTES, ABBREVIATIONS AND LEGEND, SEE SHEET PD-1

PD-18

CALCULATED-DESIGNED BY	REVISED BY	DATE REVISED
CHECKED BY	SL	11-18-22
RICK YEUNG		
SON LY		

FUNCTIONAL SUPERVISOR: LESTER LEE

STATE OF CALIFORNIA - DEPARTMENT OF TRANSPORTATION
Caltrans®
TRAFFIC

LAST REVISION: DATE PLOTTED => 18-NOV-2024
09-16-22 TIME PLOTTED => 15:12

Dist	COUNTY	ROUTE	POST MILES TOTAL PROJECT	SHEET No.	TOTAL SHEETS
04	SCI	82	18.2/26.4	235	466

AS-AWARDED CONTRACT PLANS
THIS STAMP PLACED IN LIEU OF ORIGINAL SIGNATURE

REGISTERED CIVIL ENGINEER DATE

PLANS APPROVAL DATE


REGISTERED PROFESSIONAL ENGINEER — No. Exp. CIVIL — STATE OF CALIFORNIA

THE STATE OF CALIFORNIA OR ITS OFFICERS OR AGENTS SHALL NOT BE RESPONSIBLE FOR THE ACCURACY OR COMPLETENESS OF SCANNED COPIES OF THIS PLAN SHEET.

20

NOTE:

FOR ACCURATE RIGHT OF WAY DATA, CONTACT
RIGHT OF WAY ENGINEERING AT THE DISTRICT OFFICE.

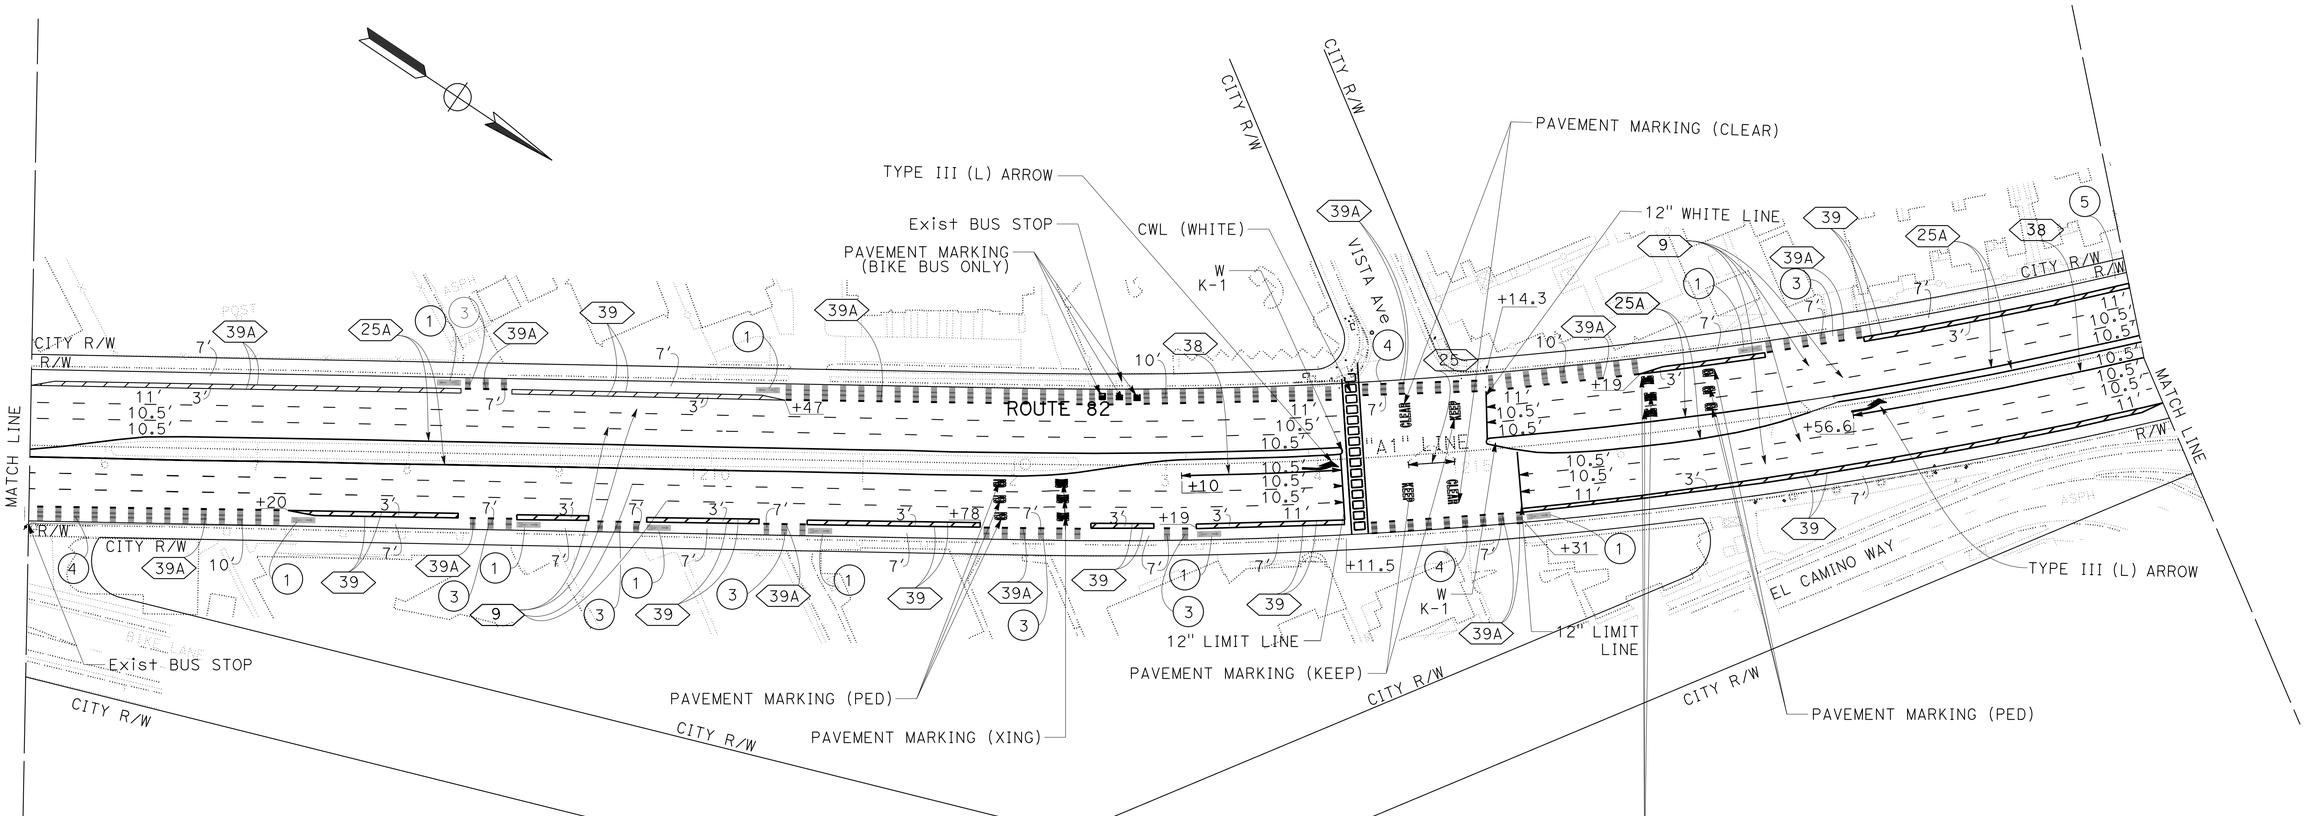

CONTRACT CHANGE ORDER NO. 20
SHEET _____ OF _____

REGISTERED PROFESSIONAL ENGINEER — Rick Yeung — No. 60640 — Exp. 12-31-24 — CIVIL — STATE OF CALIFORNIA

FOR REVISION ONLY
July 22, 2024

20 REPLACED PER CONTRACT CHANGE ORDER No. 20 DATED

APPROVED FOR PAVEMENT DELINEATION WORK ONLY

PAVEMENT DELINEATION PLAN

SCALE: 1" = 50'

FOR NOTES, ABBREVIATIONS AND LEGEND, SEE SHEET PD-1

PD-18A

REVISED BY	SL
DATE REVISED	11-18-22
CALCULATED-DESIGNED BY	SON LY
CHECKED BY	RICK YEUNG
FUNCTIONAL SUPERVISOR	LESTER LEE

STATE OF CALIFORNIA - DEPARTMENT OF TRANSPORTATION
Caltrans®
TRAFFIC

LAST REVISION DATE PLOTTED => 18-NOV-2024
09-16-22 TIME PLOTTED => 15:12

BORDER LAST REVISED 7/2/2010 | USERNAME => s129144 | DGN FILE => 0419000140na018A.cco | RELATIVE BORDER SCALE IS IN INCHES 0 1 2 3 | UNIT 0712 | PROJECT NUMBER & PHASE 04190001401

Dist	COUNTY	ROUTE	POST MILES TOTAL PROJECT	SHEET No.	TOTAL SHEETS
04	SCI	82	18.2/26.4	236	466

20

AS-AWARDED CONTRACT PLANS
THIS STAMP PLACED IN LIEU OF ORIGINAL SIGNATURE

REGISTERED CIVIL ENGINEER DATE


PLANS APPROVAL DATE

REGISTERED PROFESSIONAL ENGINEER — No. Exp. CIVIL — STATE OF CALIFORNIA

THE STATE OF CALIFORNIA OR ITS OFFICERS OR AGENTS SHALL NOT BE RESPONSIBLE FOR THE ACCURACY OR COMPLETENESS OF SCANNED COPIES OF THIS PLAN SHEET.

NOTE:

FOR ACCURATE RIGHT OF WAY DATA, CONTACT
RIGHT OF WAY ENGINEERING AT THE DISTRICT OFFICE.

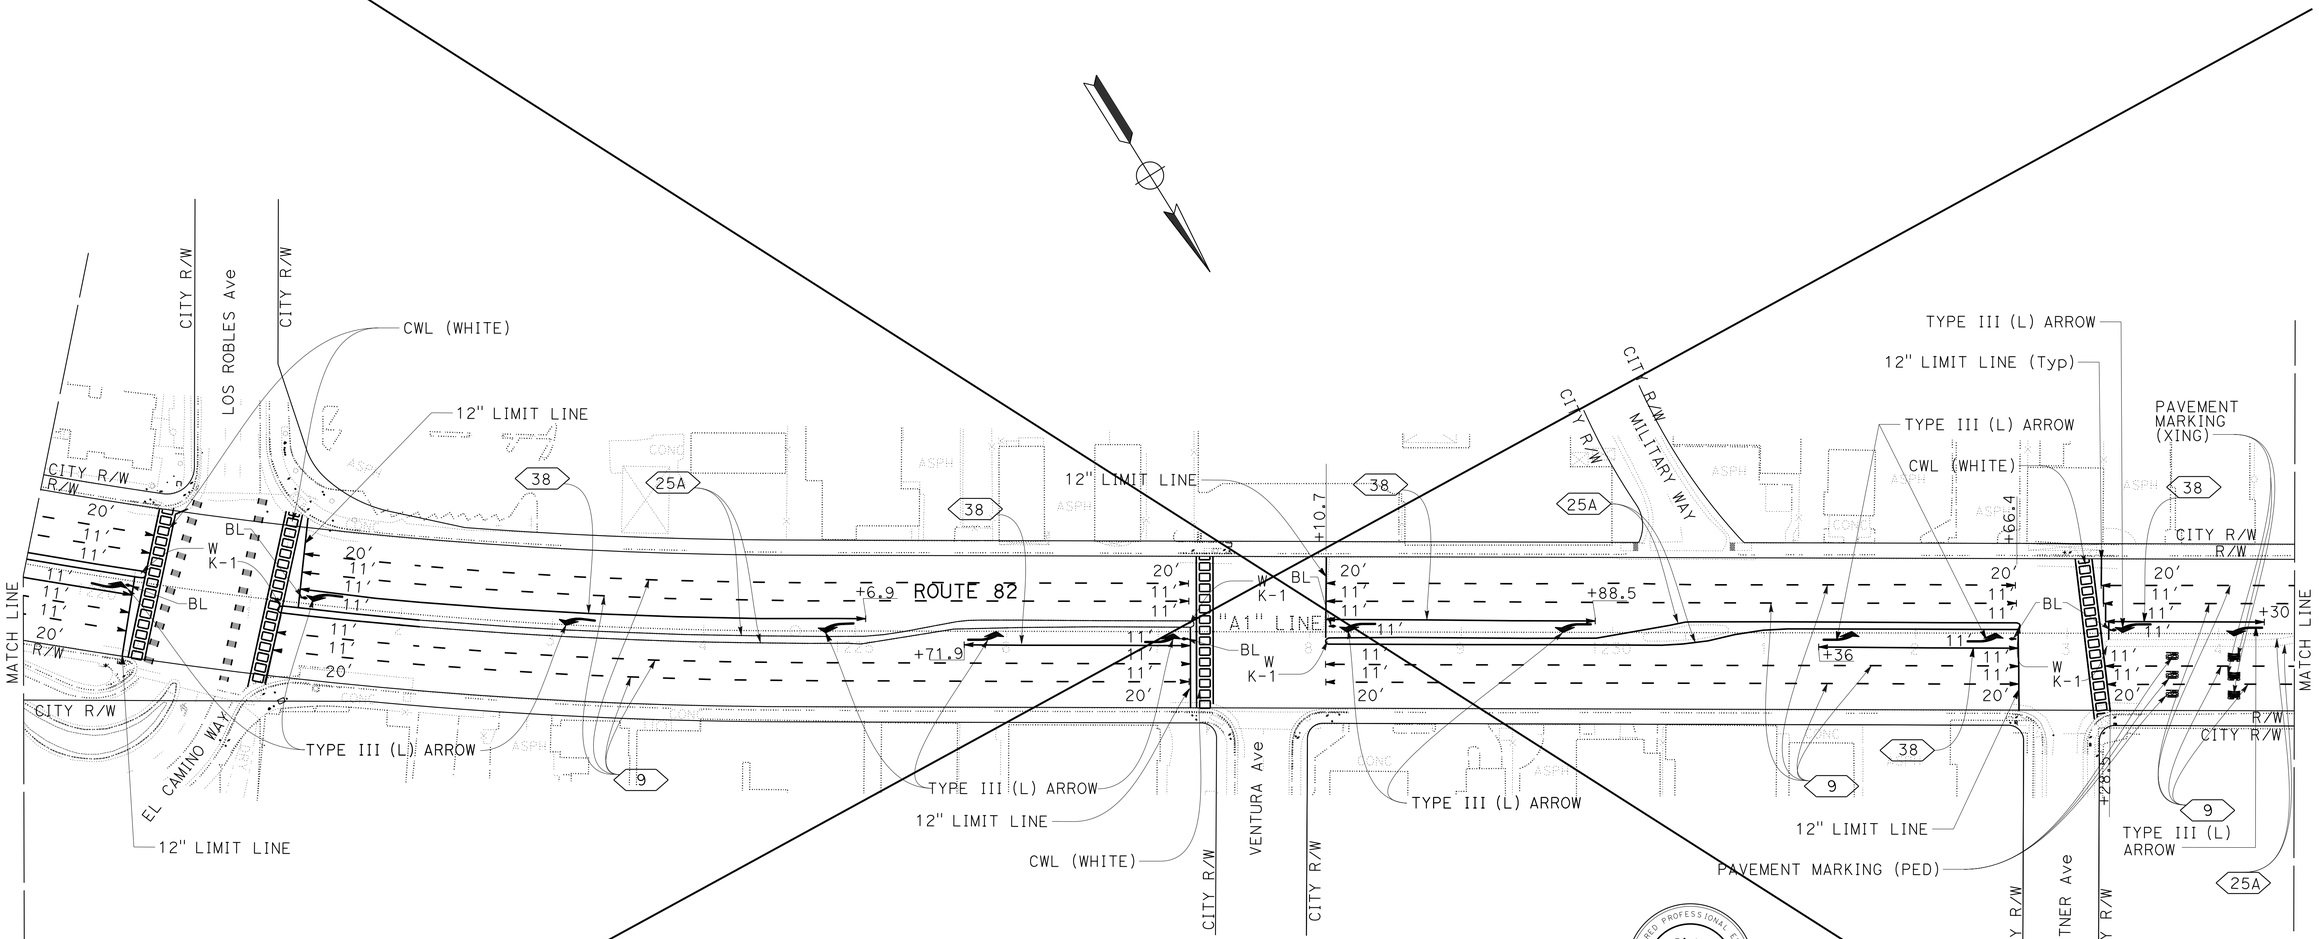

REGISTERED PROFESSIONAL ENGINEER — Rick Yeung — No. 60640 — Exp. 12-31-24 — CIVIL — STATE OF CALIFORNIA

FOR REVISION ONLY
July 22, 2024

CONTRACT CHANGE ORDER NO. 20
SHEET _____ OF _____

20 SHEET DELETED PER CONTRACT CHANGE ORDER No. 20 DATED

PAVEMENT DELINEATION PLAN

SCALE: 1" = 50'

APPROVED FOR PAVEMENT DELINEATION WORK ONLY

FOR NOTES, ABBREVIATIONS AND LEGEND, SEE SHEET PD-1

PD-19

CALCULATED-DESIGNED BY
CHECKED BY
REVISED BY: SL
DATE REVISED: 11-18-22
RICK YEUNG
SON LY
FUNCTIONAL SUPERVISOR
LESTER LEE

STATE OF CALIFORNIA - DEPARTMENT OF TRANSPORTATION
Caltrans®
TRAFFIC

LAST REVISION
DATE PLOTTED => 18-NOV-2024
TIME PLOTTED => 15:12
09-16-22

BORDER LAST REVISED 7/2/2010
USERNAME => s129144
DGN FILE => 0419000140na019.cco
RELATIVE BORDER SCALE IS IN INCHES 0 1 2 3
UNIT 0712
PROJECT NUMBER & PHASE 04190001401

NOTE:

FOR ACCURATE RIGHT OF WAY DATA, CONTACT
RIGHT OF WAY ENGINEERING AT THE DISTRICT OFFICE.

Dist	COUNTY	ROUTE	POST MILES TOTAL PROJECT	SHEET No.	TOTAL SHEETS
04	SCI	82	18.2/26.4	236	466

20


AS-AWARDED CONTRACT PLANS
THIS STAMP PLACED IN LIEU OF ORIGINAL SIGNATURE

REGISTERED CIVIL ENGINEER DATE

PLANS APPROVAL DATE

REGISTERED PROFESSIONAL ENGINEER — No. — Exp. — CIVIL — STATE OF CALIFORNIA

THE STATE OF CALIFORNIA OR ITS OFFICERS OR AGENTS SHALL NOT BE RESPONSIBLE FOR THE ACCURACY OR COMPLETENESS OF SCANNED COPIES OF THIS PLAN SHEET.

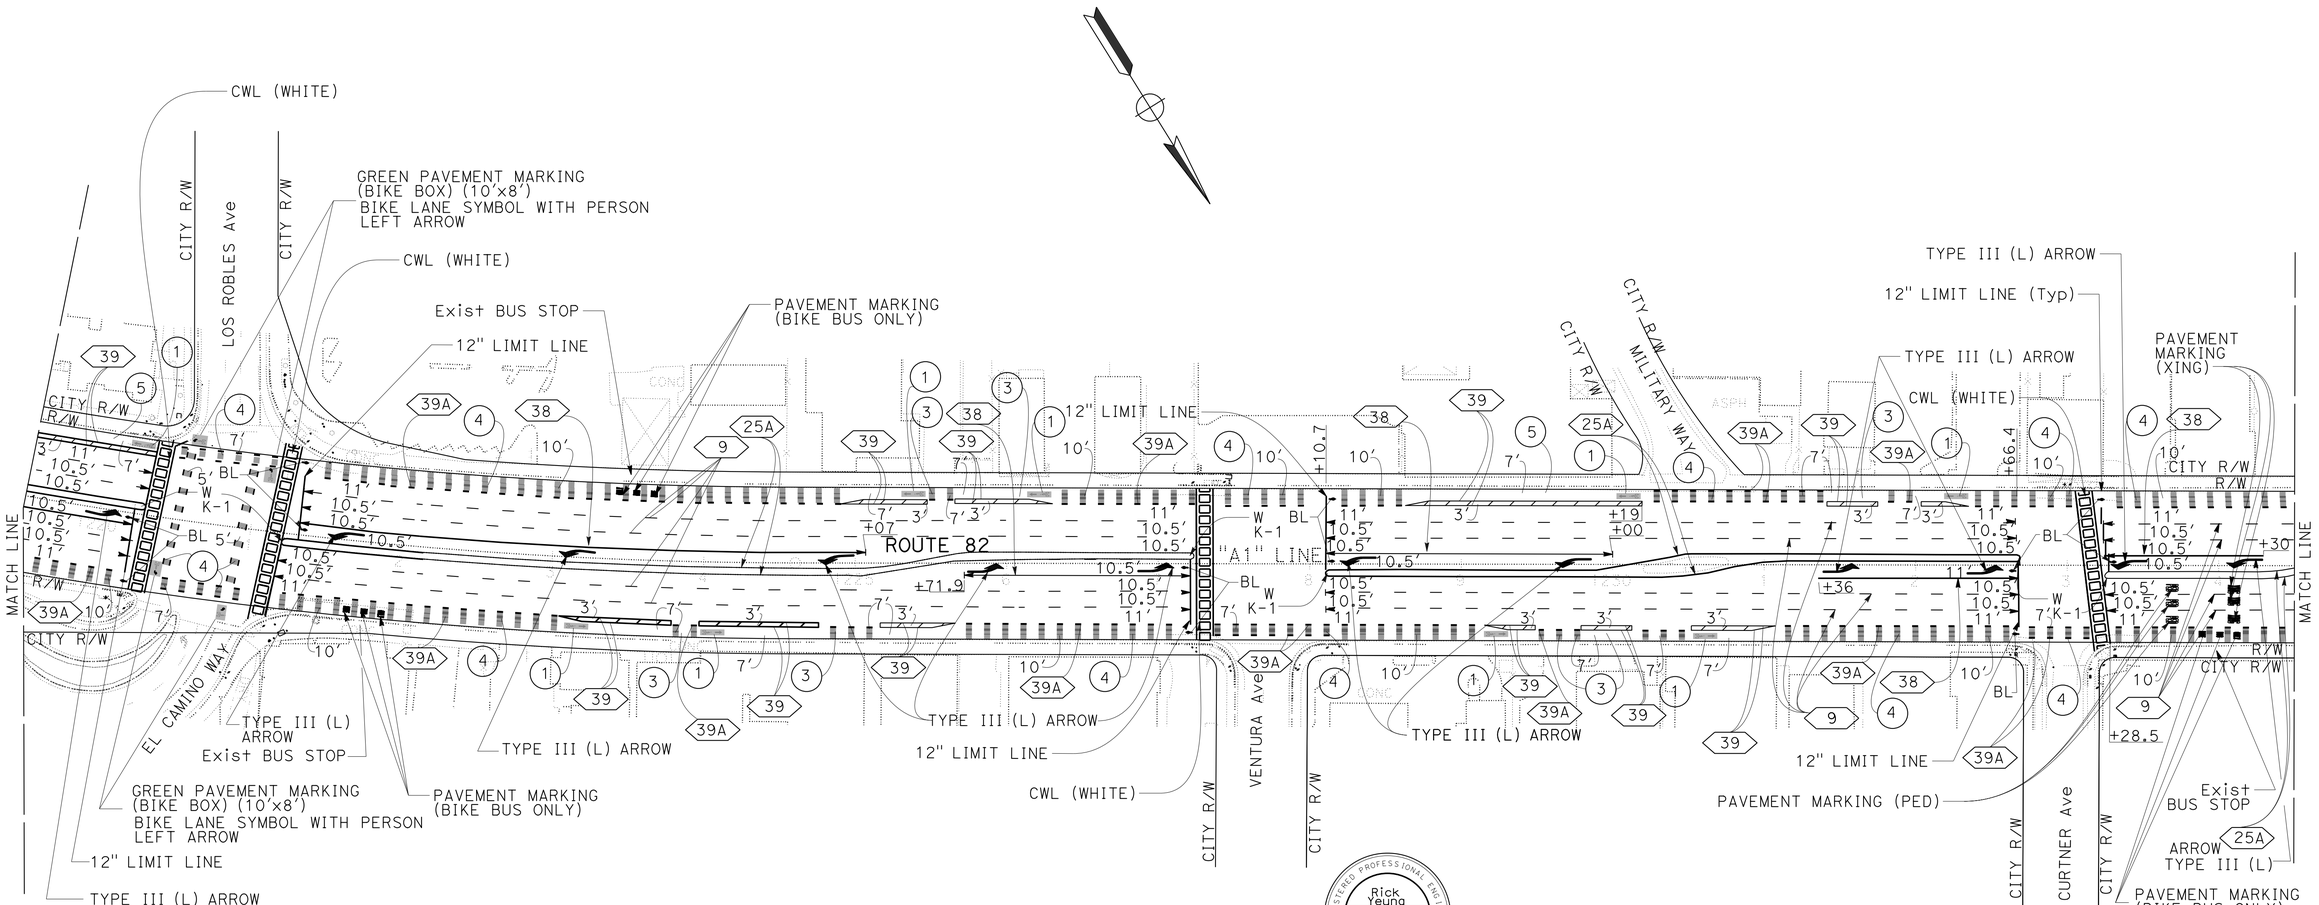

CONTRACT CHANGE ORDER NO. 20
SHEET _____ OF _____

Rick Yeung No. 60640 Exp. 12-31-24 CIVIL — REGISTERED PROFESSIONAL ENGINEER — STATE OF CALIFORNIA

FOR REVISION ONLY
July 22, 2024

20 **REPLACED PER CONTRACT CHANGE ORDER No. 20 DATED**

PAVEMENT DELINEATION PLAN

SCALE: 1" = 50'

APPROVED FOR PAVEMENT DELINEATION WORK ONLY

FOR NOTES, ABBREVIATIONS AND LEGEND, SEE SHEET PD-1

PD-19A

CALCULATED-DESIGNED BY	SL
CHECKED BY	RICK YEUNG
FUNCTIONAL SUPERVISOR	LESTER LEE
REVISED BY	SL
DATE REVISED	11-18-22

STATE OF CALIFORNIA - DEPARTMENT OF TRANSPORTATION
Caltrans®
TRAFFIC

LAST REVISION DATE PLOTTED => 18-NOV-2024
09-16-22 TIME PLOTTED => 15:12

BORDER LAST REVISED 7/2/2010 | USERNAME => s129144 | DGN FILE => 0419000140na019A.cco | RELATIVE BORDER SCALE IS IN INCHES 0 1 2 3 | UNIT 0712 | PROJECT NUMBER & PHASE 04190001401

NOTE:

FOR ACCURATE RIGHT OF WAY DATA, CONTACT
RIGHT OF WAY ENGINEERING AT THE DISTRICT OFFICE.

20

Dist	COUNTY	ROUTE	POST MILES TOTAL PROJECT	SHEET No.	TOTAL SHEETS
04	SCI	82	18.2/26.4	237	466


AS-AWARDED CONTRACT PLANS
THIS STAMP PLACED IN LIEU OF ORIGINAL SIGNATURE

REGISTERED CIVIL ENGINEER DATE

PLANS APPROVAL DATE

REGISTERED PROFESSIONAL ENGINEER — No. Exp. CIVIL — STATE OF CALIFORNIA

THE STATE OF CALIFORNIA OR ITS OFFICERS OR AGENTS SHALL NOT BE RESPONSIBLE FOR THE ACCURACY OR COMPLETENESS OF SCANNED COPIES OF THIS PLAN SHEET.

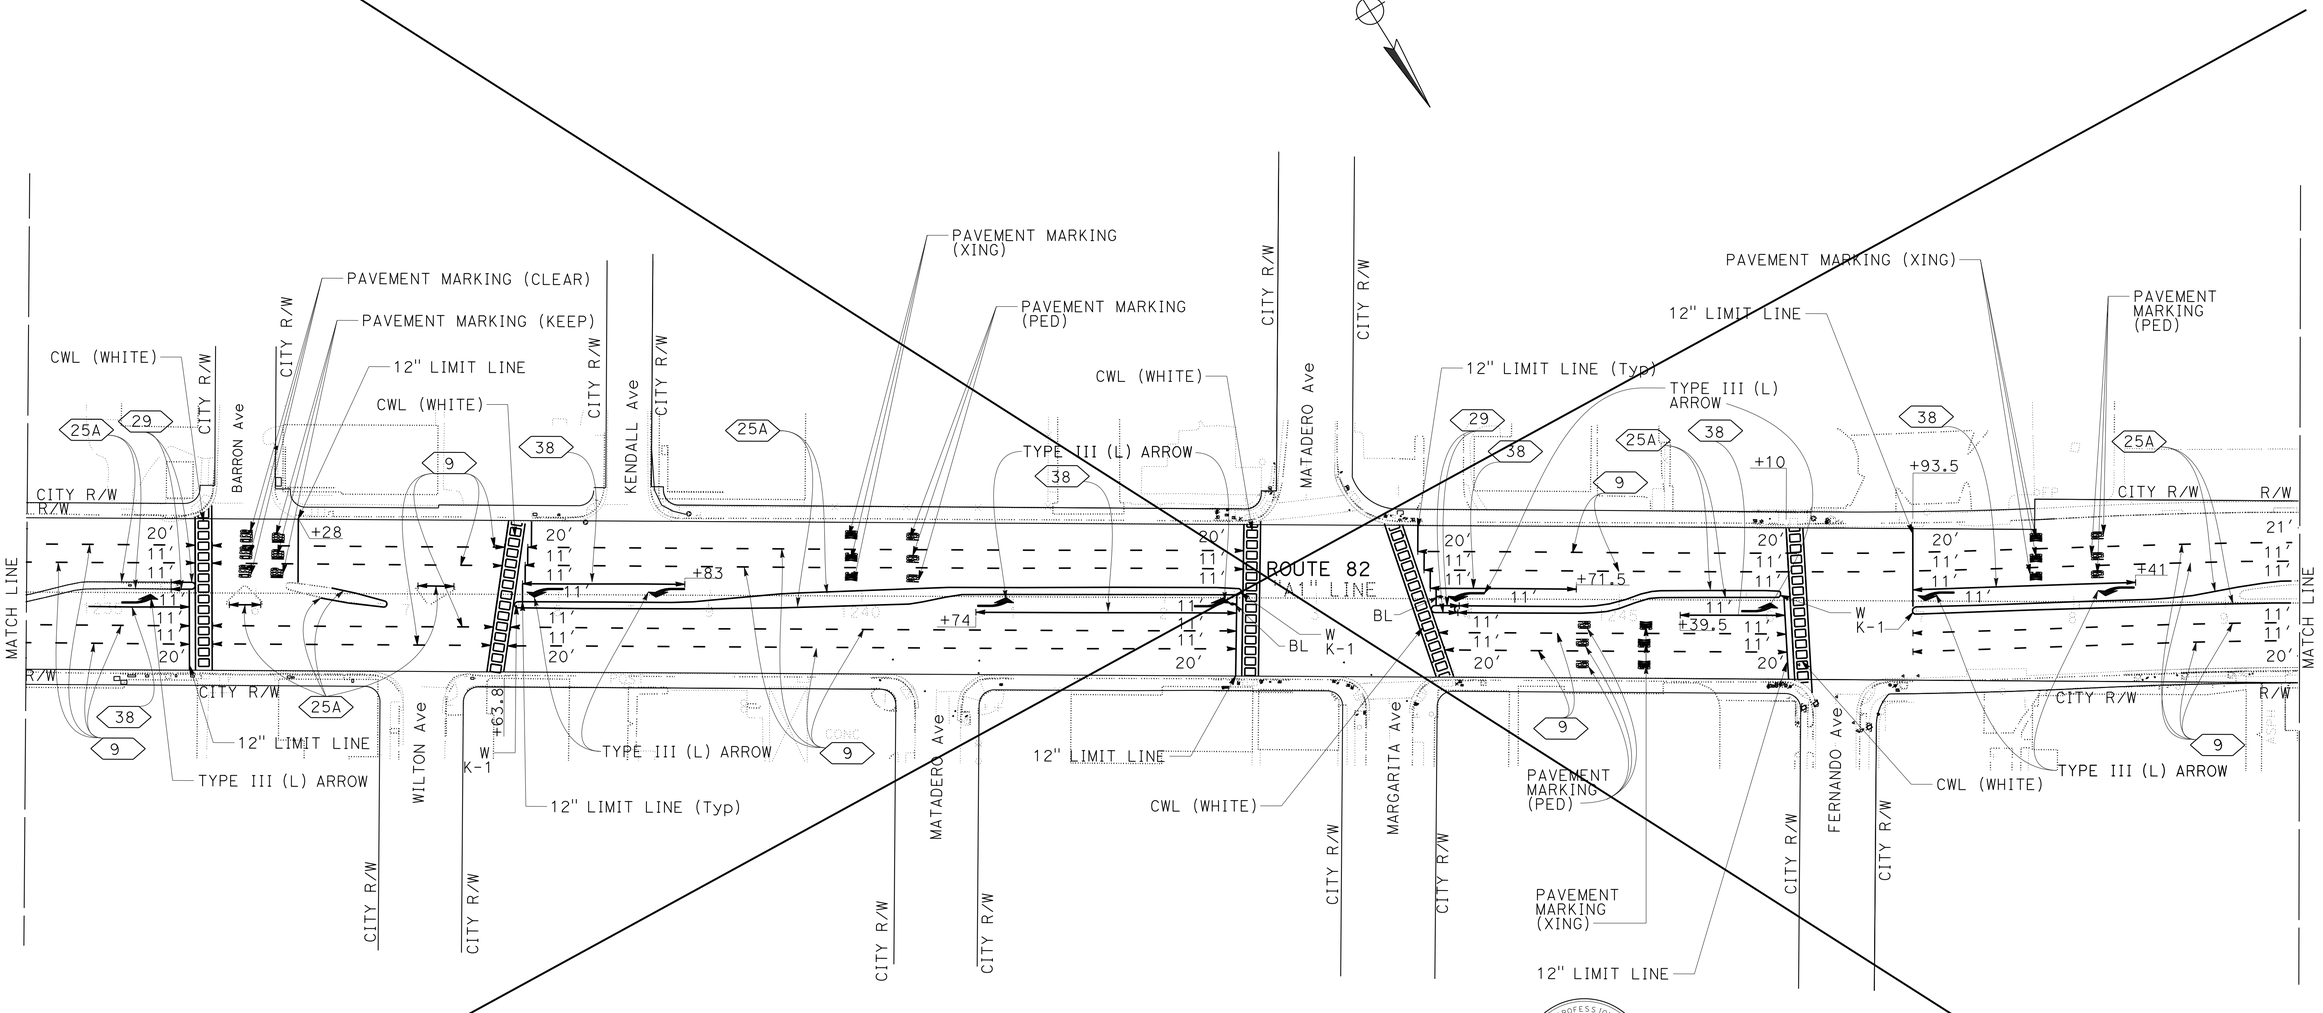

CONTRACT CHANGE ORDER NO. 20
SHEET _____ OF _____

REGISTERED PROFESSIONAL ENGINEER — Rick Yeung — No. 60640 — Exp. 12-31-24 — CIVIL — STATE OF CALIFORNIA

FOR REVISION ONLY
July 22, 2024

20 SHEET DELETED PER CONTRACT CHANGE ORDER No. 20 DATED

APPROVED FOR PAVEMENT DELINEATION WORK ONLY

PAVEMENT DELINEATION PLAN

SCALE: 1" = 50'

FOR NOTES, ABBREVIATIONS AND LEGEND, SEE SHEET PD-1

PD-20

CALCULATED-DESIGNED BY	RICK YEUNG	REVISED BY	SL
CHECKED BY	SON LY	DATE REVISED	11-18-22
FUNCTIONAL SUPERVISOR	LESTER LEE		

STATE OF CALIFORNIA - DEPARTMENT OF TRANSPORTATION
Caltrans®
TRAFFIC

LAST REVISION DATE PLOTTED => 18-NOV-2024
TIME PLOTTED => 15:12
09-16-22

BORDER LAST REVISED 7/2/2010 | USERNAME => s129144 | DGN FILE => 0419000140na020.cco | RELATIVE BORDER SCALE IS IN INCHES 0 1 2 3 | UNIT 0712 | PROJECT NUMBER & PHASE 04190001401

NOTE:

FOR ACCURATE RIGHT OF WAY DATA, CONTACT
RIGHT OF WAY ENGINEERING AT THE DISTRICT OFFICE.

Dist	COUNTY	ROUTE	POST MILES TOTAL PROJECT	SHEET No.	TOTAL SHEETS
04	SCI	82	18.2/26.4	237	466

20


AS-AWARDED CONTRACT PLANS
THIS STAMP PLACED IN LIEU OF ORIGINAL SIGNATURE

REGISTERED CIVIL ENGINEER DATE

PLANS APPROVAL DATE

REGISTERED PROFESSIONAL ENGINEER — No. Exp. CIVIL — STATE OF CALIFORNIA

THE STATE OF CALIFORNIA OR ITS OFFICERS OR AGENTS SHALL NOT BE RESPONSIBLE FOR THE ACCURACY OR COMPLETENESS OF SCANNED COPIES OF THIS PLAN SHEET.

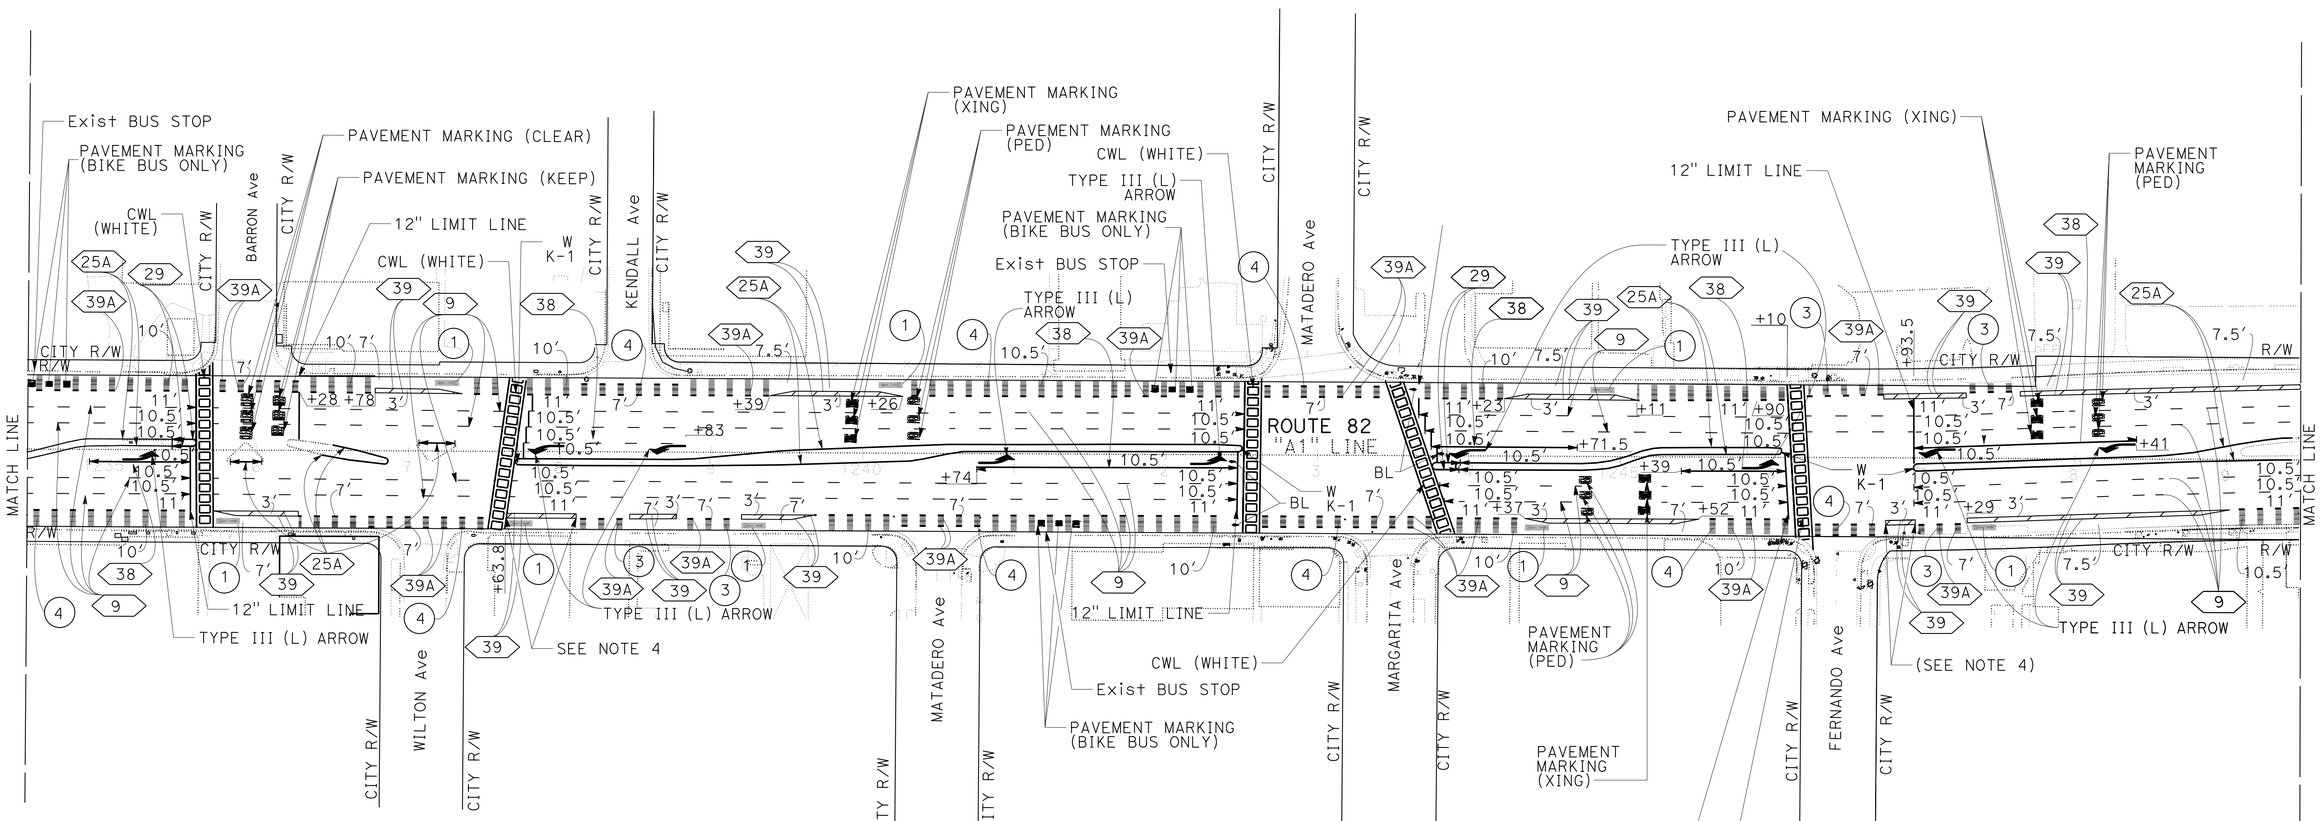

CONTRACT CHANGE ORDER NO. 20
SHEET _____ OF _____

REGISTERED PROFESSIONAL ENGINEER — Rick Yeung — No. 60640 — Exp. 12-31-24 — CIVIL — STATE OF CALIFORNIA

FOR REVISION ONLY
July 22, 2024

20 **REPLACED PER CONTRACT CHANGE ORDER No. 20 DATED**

APPROVED FOR PAVEMENT DELINEATION WORK ONLY

PAVEMENT DELINEATION PLAN

SCALE: 1" = 50'

FOR NOTES, ABBREVIATIONS AND LEGEND, SEE SHEET PD-1

PD-20A

CALCULATED-DESIGNED BY	SON LY	REVISED BY	SL
CHECKED BY	RICK YEUNG	DATE REVISED	11-18-22
FUNCTIONAL SUPERVISOR	LESTER LEE		

STATE OF CALIFORNIA - DEPARTMENT OF TRANSPORTATION
Caltrans® **TRAFFIC**

LAST REVISION — DATE PLOTTED => 18-NOV-2024 — TIME PLOTTED => 15:13
09-16-22

BORDER LAST REVISED 7/2/2010 | USERNAME => s129144 | DGN FILE => 0419000140na020A.cco | RELATIVE BORDER SCALE IS IN INCHES 0 1 2 3 | UNIT 0712 | PROJECT NUMBER & PHASE 04190001401

NOTE:

FOR ACCURATE RIGHT OF WAY DATA, CONTACT
RIGHT OF WAY ENGINEERING AT THE DISTRICT OFFICE.

20

Dist	COUNTY	ROUTE	POST MILES TOTAL PROJECT	SHEET No.	TOTAL SHEETS
04	SCI	82	18.2/26.4	238	466


AS-AWARDED CONTRACT PLANS
THIS STAMP PLACED IN LIEU OF ORIGINAL SIGNATURE

REGISTERED CIVIL ENGINEER DATE

PLANS APPROVAL DATE

REGISTERED PROFESSIONAL ENGINEER — No. Exp. CIVIL — STATE OF CALIFORNIA

THE STATE OF CALIFORNIA OR ITS OFFICERS OR AGENTS SHALL NOT BE RESPONSIBLE FOR THE ACCURACY OR COMPLETENESS OF SCANNED COPIES OF THIS PLAN SHEET.

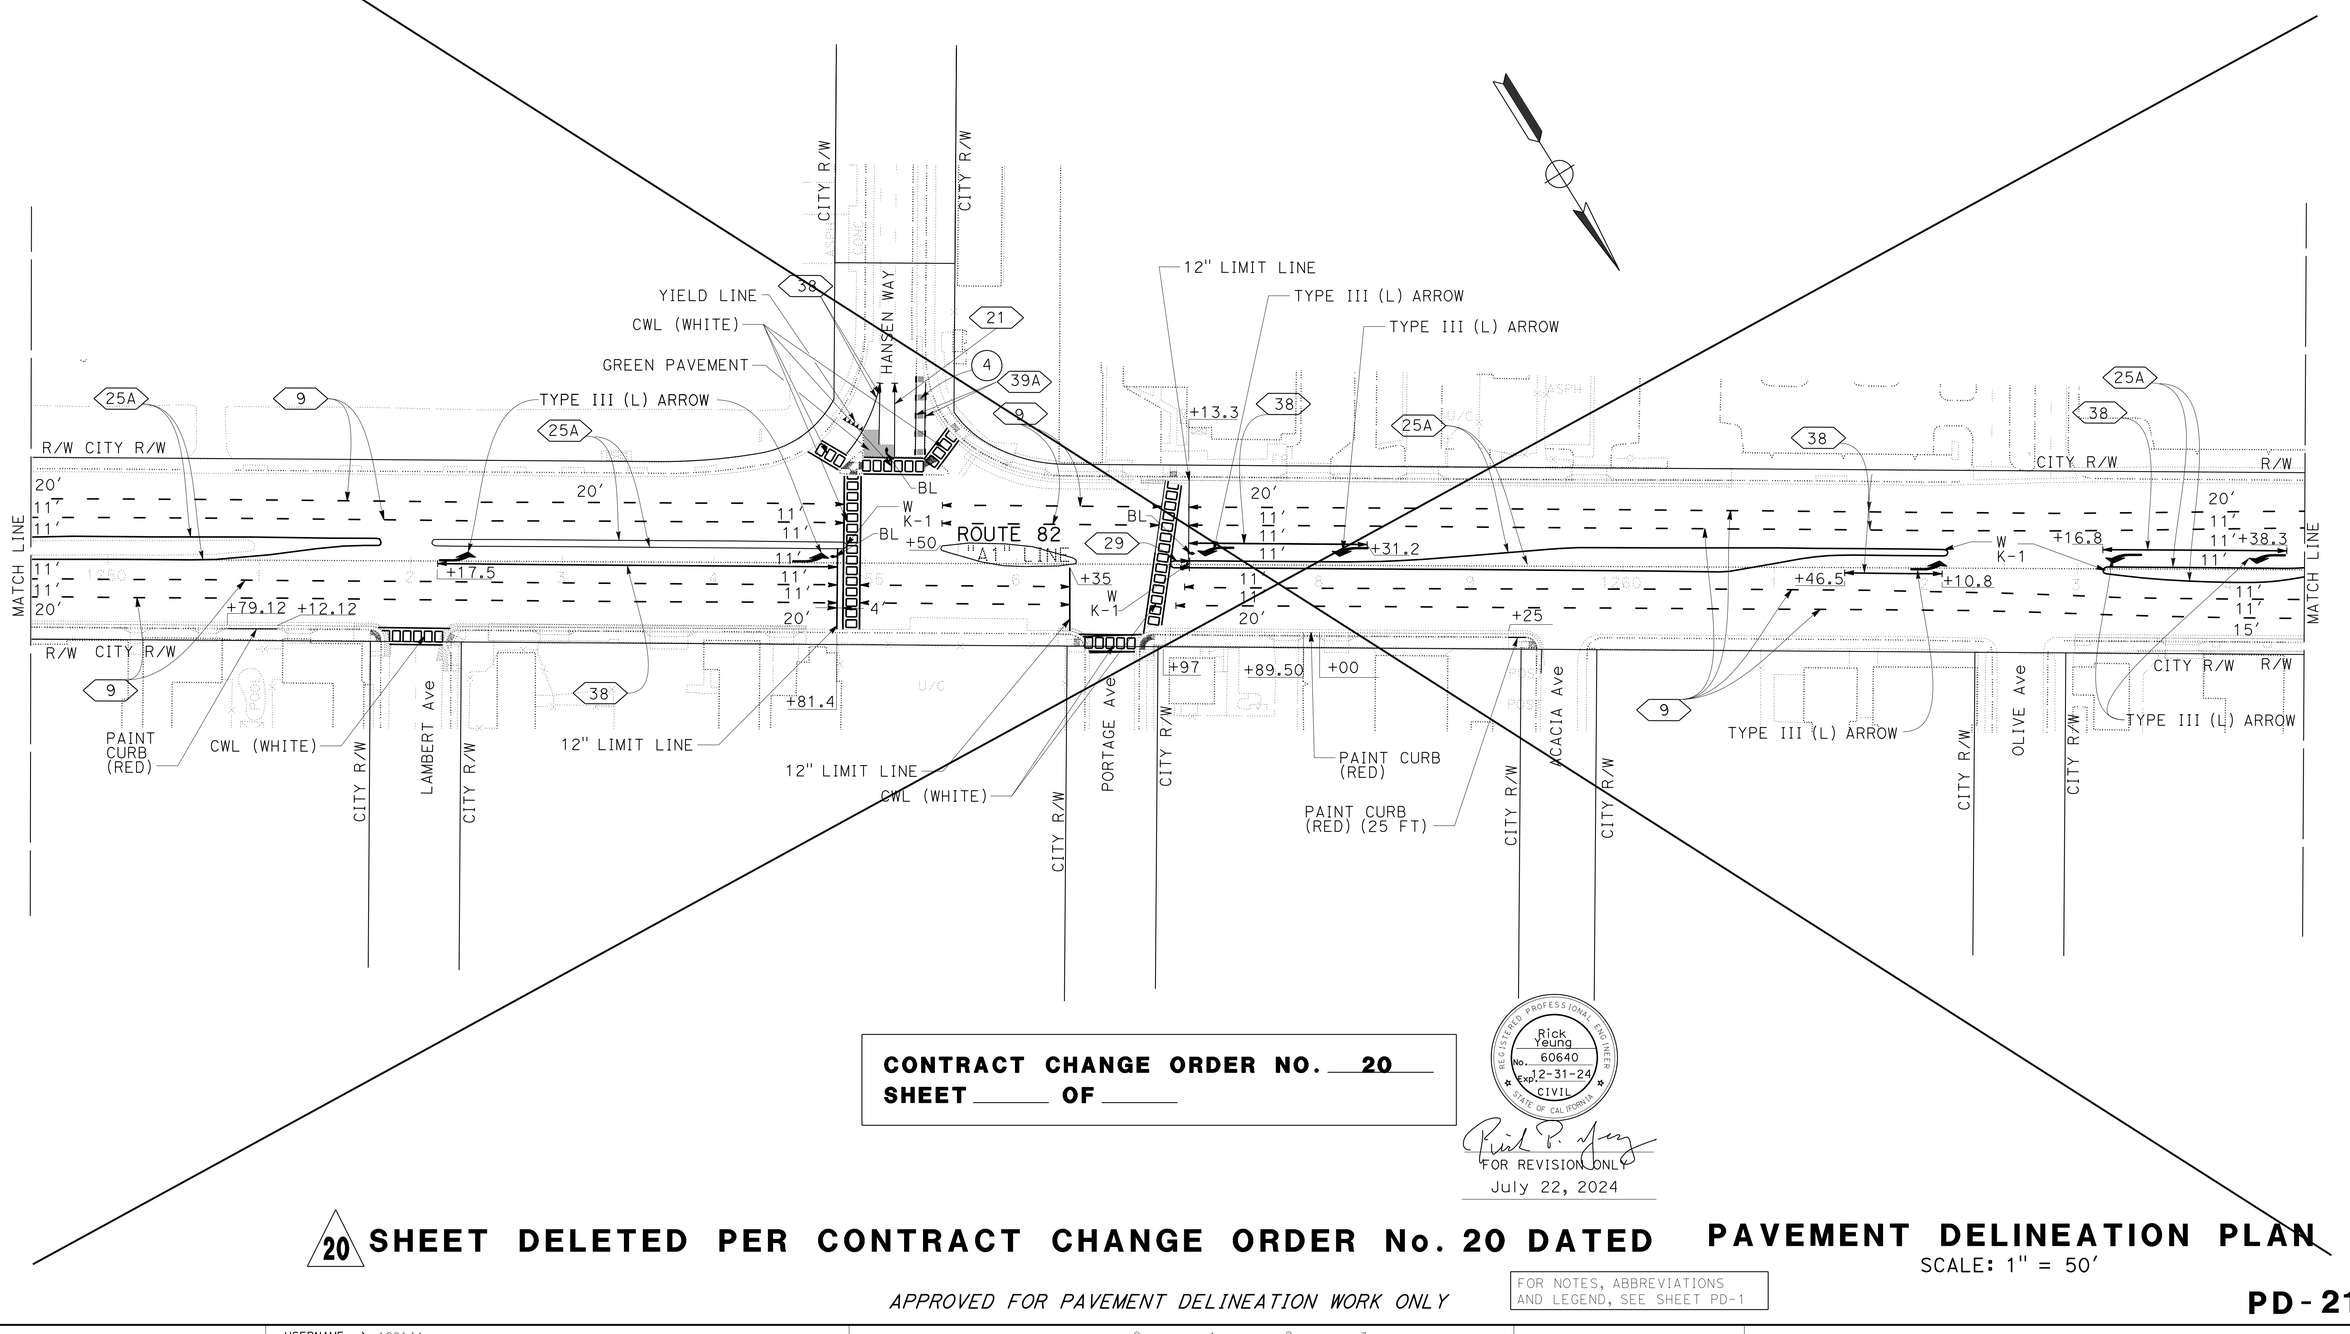

CONTRACT CHANGE ORDER NO. 20
SHEET _____ OF _____

REGISTERED PROFESSIONAL ENGINEER — Rick Yeung — No. 60640 — Exp. 12-31-24 — CIVIL — STATE OF CALIFORNIA

FOR REVISION ONLY
July 22, 2024

20 **SHEET DELETED PER CONTRACT CHANGE ORDER No. 20 DATED**

APPROVED FOR PAVEMENT DELINEATION WORK ONLY

PAVEMENT DELINEATION PLAN

SCALE: 1" = 50'

FOR NOTES, ABBREVIATIONS AND LEGEND, SEE SHEET PD-1

PD-21

CALCULATED-DESIGNED BY	CHECKED BY	REVISED BY	DATE REVISED
RICK YEUNG	SON LY	SL	11-18-22

FUNCTIONAL SUPERVISOR: LESTER LEE

STATE OF CALIFORNIA - DEPARTMENT OF TRANSPORTATION
Caltrans® TRAFFIC

LAST REVISION | DATE PLOTTED => 18-NOV-2024
09-16-22 | TIME PLOTTED => 15:13

BORDER LAST REVISED 7/2/2010 | USERNAME => s129144 | DGN FILE => 0419000140na021.cco | RELATIVE BORDER SCALE IS IN INCHES 0 1 2 3 | UNIT 0712 | PROJECT NUMBER & PHASE 04190001401

Dist	COUNTY	ROUTE	POST MILES TOTAL PROJECT	SHEET No.	TOTAL SHEETS
04	SCI	82	18.2/26.4	238	466

AS-AWARDED CONTRACT PLANS
THIS STAMP PLACED IN LIEU OF ORIGINAL SIGNATURE

REGISTERED CIVIL ENGINEER DATE

PLANS APPROVAL DATE


REGISTERED PROFESSIONAL ENGINEER No. Exp. CIVIL STATE OF CALIFORNIA

THE STATE OF CALIFORNIA OR ITS OFFICERS OR AGENTS SHALL NOT BE RESPONSIBLE FOR THE ACCURACY OR COMPLETENESS OF SCANNED COPIES OF THIS PLAN SHEET.

20

NOTE:

FOR ACCURATE RIGHT OF WAY DATA, CONTACT
RIGHT OF WAY ENGINEERING AT THE DISTRICT OFFICE.

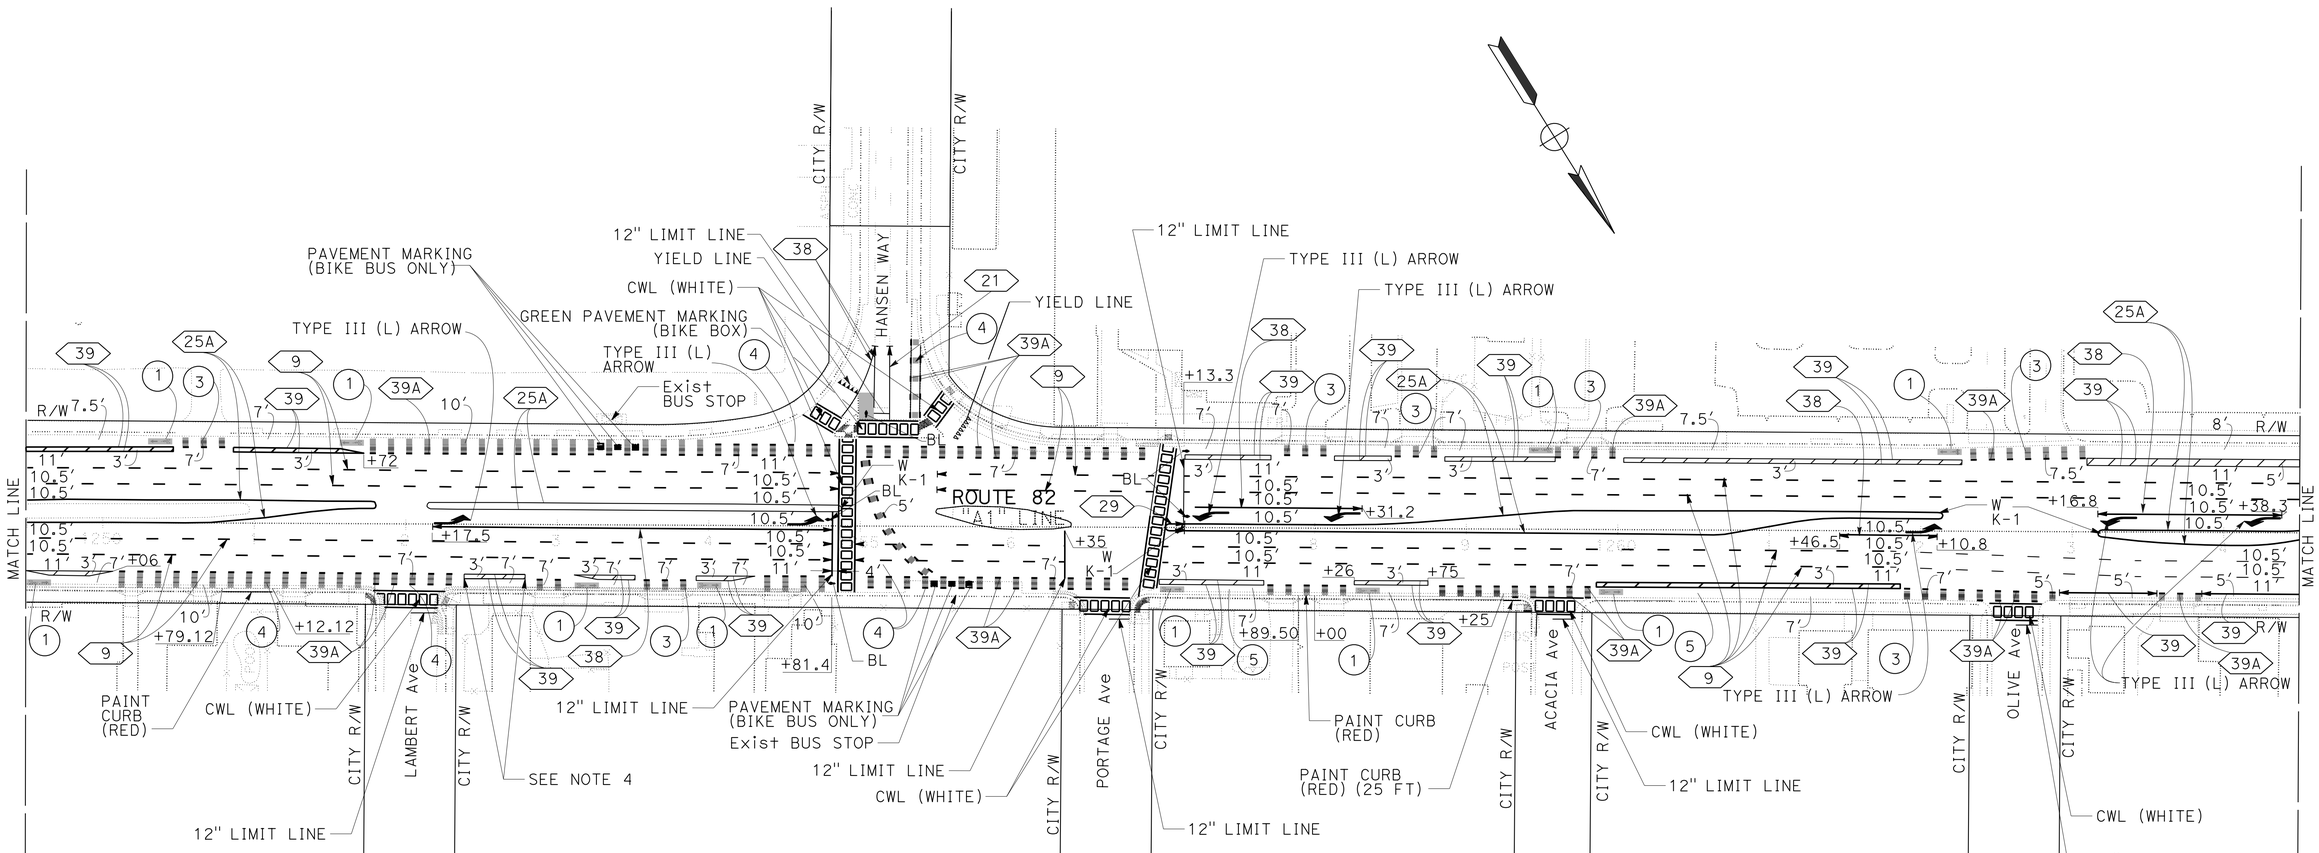

CONTRACT CHANGE ORDER NO. 20
SHEET _____ OF _____

REGISTERED PROFESSIONAL ENGINEER Rick Yeung No. 60640 Exp. 12-31-24 CIVIL STATE OF CALIFORNIA

FOR REVISION ONLY
July 22, 2024

20 REPLACED PER CONTRACT CHANGE ORDER No. 20 DATED

PAVEMENT DELINEATION PLAN

SCALE: 1" = 50'

APPROVED FOR PAVEMENT DELINEATION WORK ONLY

FOR NOTES, ABBREVIATIONS AND LEGEND, SEE SHEET PD-1

PD-21A

REVISED BY	SL
DATE REVISED	11-18-22
CALCULATED-DESIGNED BY	SON LY
CHECKED BY	RICK YEUNG
FUNCTIONAL SUPERVISOR	LESTER LEE

STATE OF CALIFORNIA - DEPARTMENT OF TRANSPORTATION
Caltrans®
TRAFFIC

LAST REVISION DATE PLOTTED => 18-NOV-2024
TIME PLOTTED => 15:13
09-16-22

BORDER LAST REVISED 7/2/2010 | USERNAME => s129144 | DGN FILE => 0419000140na021A.cco | RELATIVE BORDER SCALE IS IN INCHES 0 1 2 3 | UNIT 0712 | PROJECT NUMBER & PHASE 04190001401

Dist	COUNTY	ROUTE	POST MILES TOTAL PROJECT	SHEET No.	TOTAL SHEETS
04	SCl	82	18.2/26.4	239	466

20

AS-AWARDED CONTRACT PLANS
THIS STAMP PLACED IN LIEU OF ORIGINAL SIGNATURE

REGISTERED CIVIL ENGINEER DATE


PLANS APPROVAL DATE

REGISTERED PROFESSIONAL ENGINEER No. Exp. CIVIL STATE OF CALIFORNIA

THE STATE OF CALIFORNIA OR ITS OFFICERS OR AGENTS SHALL NOT BE RESPONSIBLE FOR THE ACCURACY OR COMPLETENESS OF SCANNED COPIES OF THIS PLAN SHEET.

NOTE:

FOR ACCURATE RIGHT OF WAY DATA, CONTACT
RIGHT OF WAY ENGINEERING AT THE DISTRICT OFFICE.

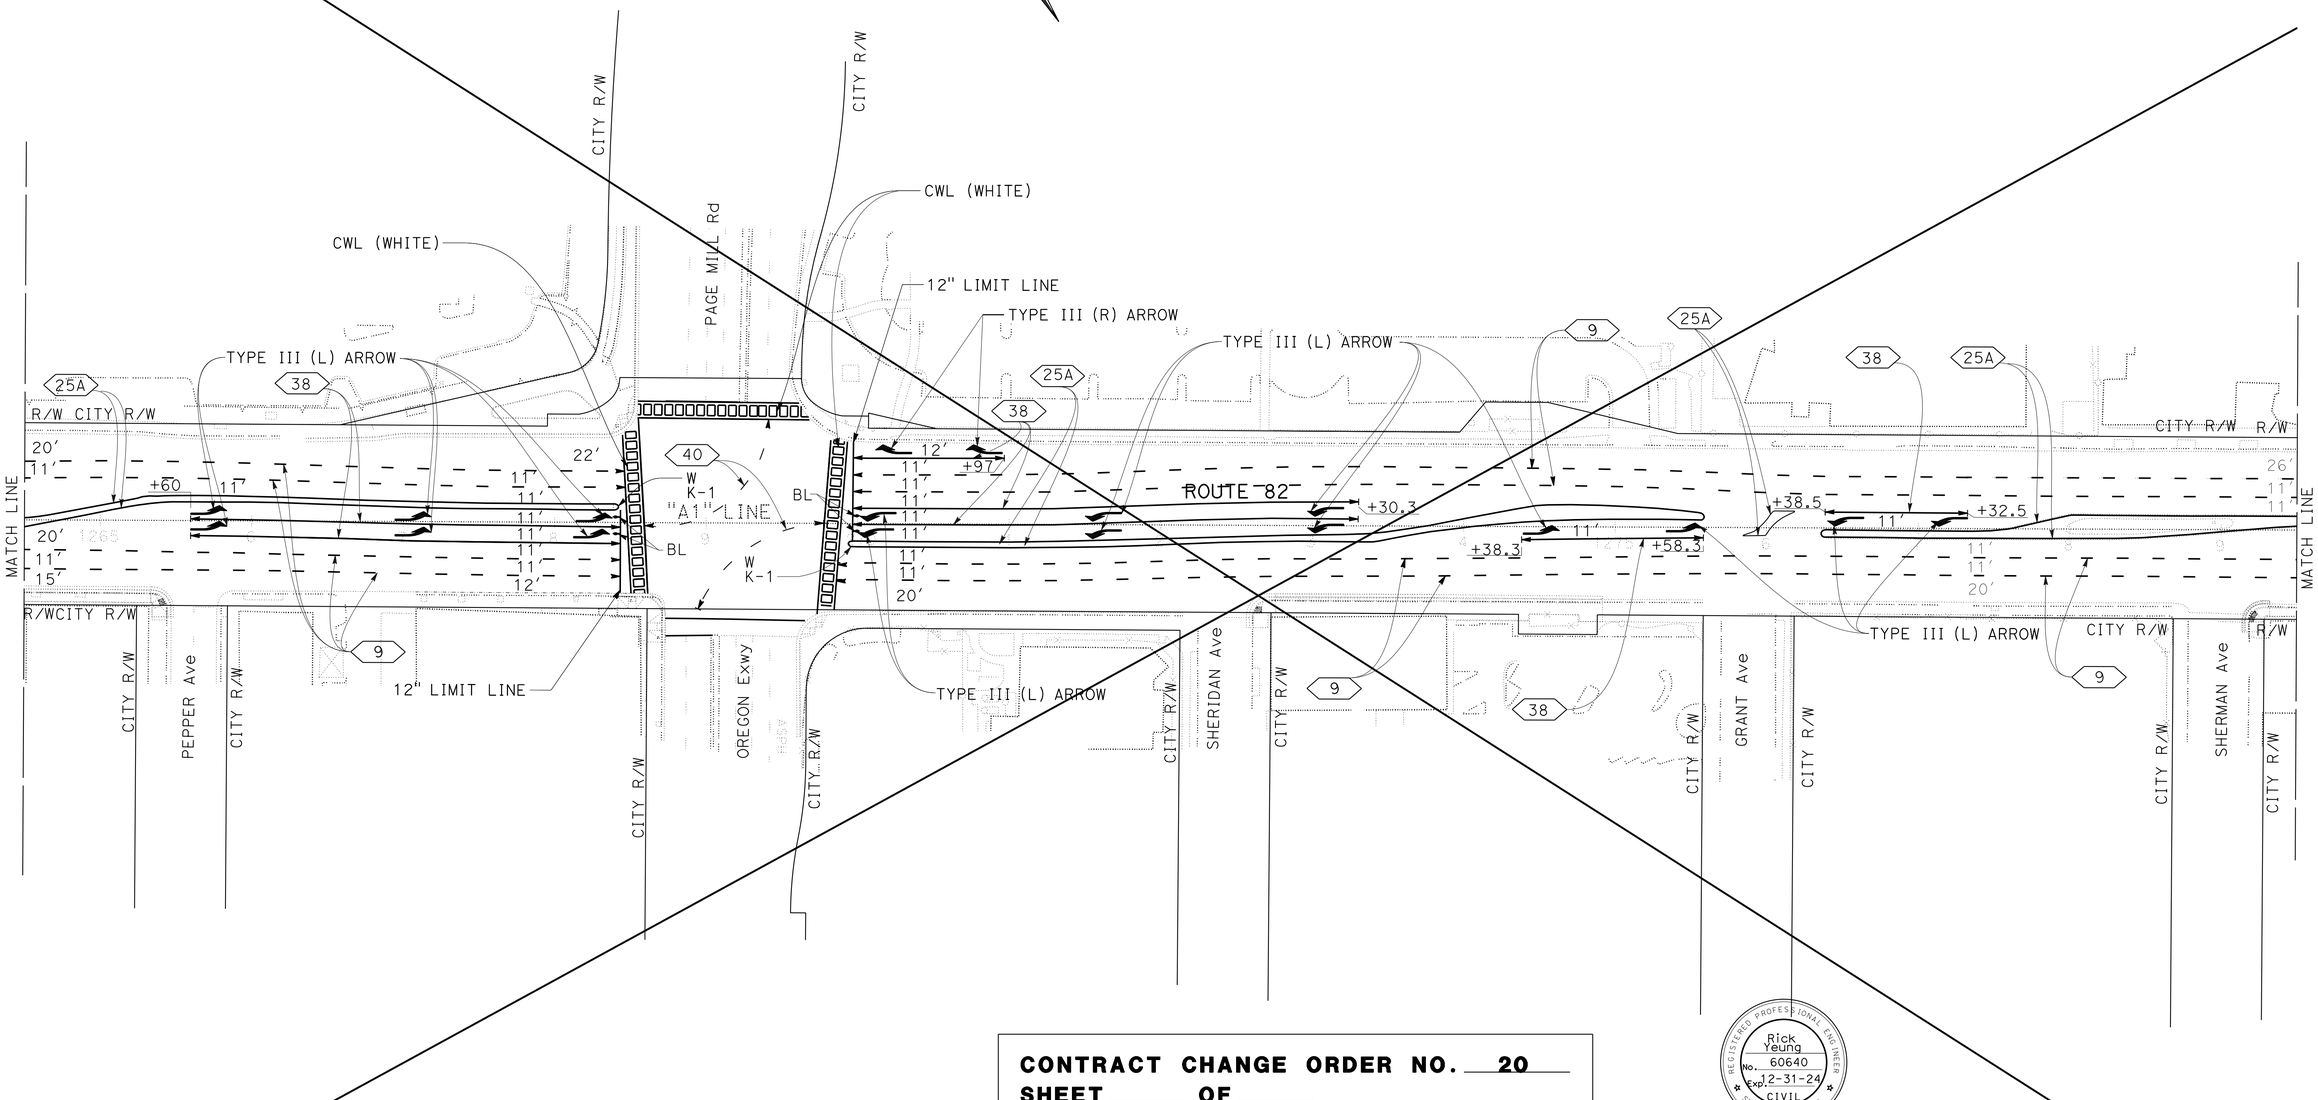

CONTRACT CHANGE ORDER NO. 20
SHEET _____ OF _____

REGISTERED PROFESSIONAL ENGINEER Rick Yeung No. 60640 Exp. 12-31-24 CIVIL STATE OF CALIFORNIA

FOR REVISION ONLY
July 22, 2024

20 **SHEET DELETED PER CONTRACT CHANGE ORDER No. 20 DATED**

PAVEMENT DELINEATION PLAN

SCALE: 1" = 50′

APPROVED FOR PAVEMENT DELINEATION WORK ONLY

FOR NOTES, ABBREVIATIONS AND LEGEND, SEE SHEET PD-1

PD-22

REVISED BY	DATE REVISED
SL	11-18-22

CALCULATED-DESIGNED BY: RICK YEUNG
CHECKED BY: SON LY

FUNCTIONAL SUPERVISOR: LESTER LEE

STATE OF CALIFORNIA - DEPARTMENT OF TRANSPORTATION
Caltrans®
TRAFFIC

LAST REVISION DATE PLOTTED => 18-NOV-2024
09-16-22 TIME PLOTTED => 15:13

BORDER LAST REVISED 7/2/2010

USERNAME => s129144
DGN FILE => 0419000140na022.cco

RELATIVE BORDER SCALE IS IN INCHES 0 1 2 3

UNIT 0712

PROJECT NUMBER & PHASE 04190001401

NOTE:

FOR ACCURATE RIGHT OF WAY DATA, CONTACT
RIGHT OF WAY ENGINEERING AT THE DISTRICT OFFICE.

Dist	COUNTY	ROUTE	POST MILES TOTAL PROJECT	SHEET No.	TOTAL SHEETS
04	SCl	82	18.2/26.4	239	466

20


AS-AWARDED CONTRACT PLANS
THIS STAMP PLACED IN LIEU OF ORIGINAL SIGNATURE

REGISTERED CIVIL ENGINEER DATE

PLANS APPROVAL DATE

REGISTERED PROFESSIONAL ENGINEER — No. — Exp. — CIVIL — STATE OF CALIFORNIA

THE STATE OF CALIFORNIA OR ITS OFFICERS OR AGENTS SHALL NOT BE RESPONSIBLE FOR THE ACCURACY OR COMPLETENESS OF SCANNED COPIES OF THIS PLAN SHEET.

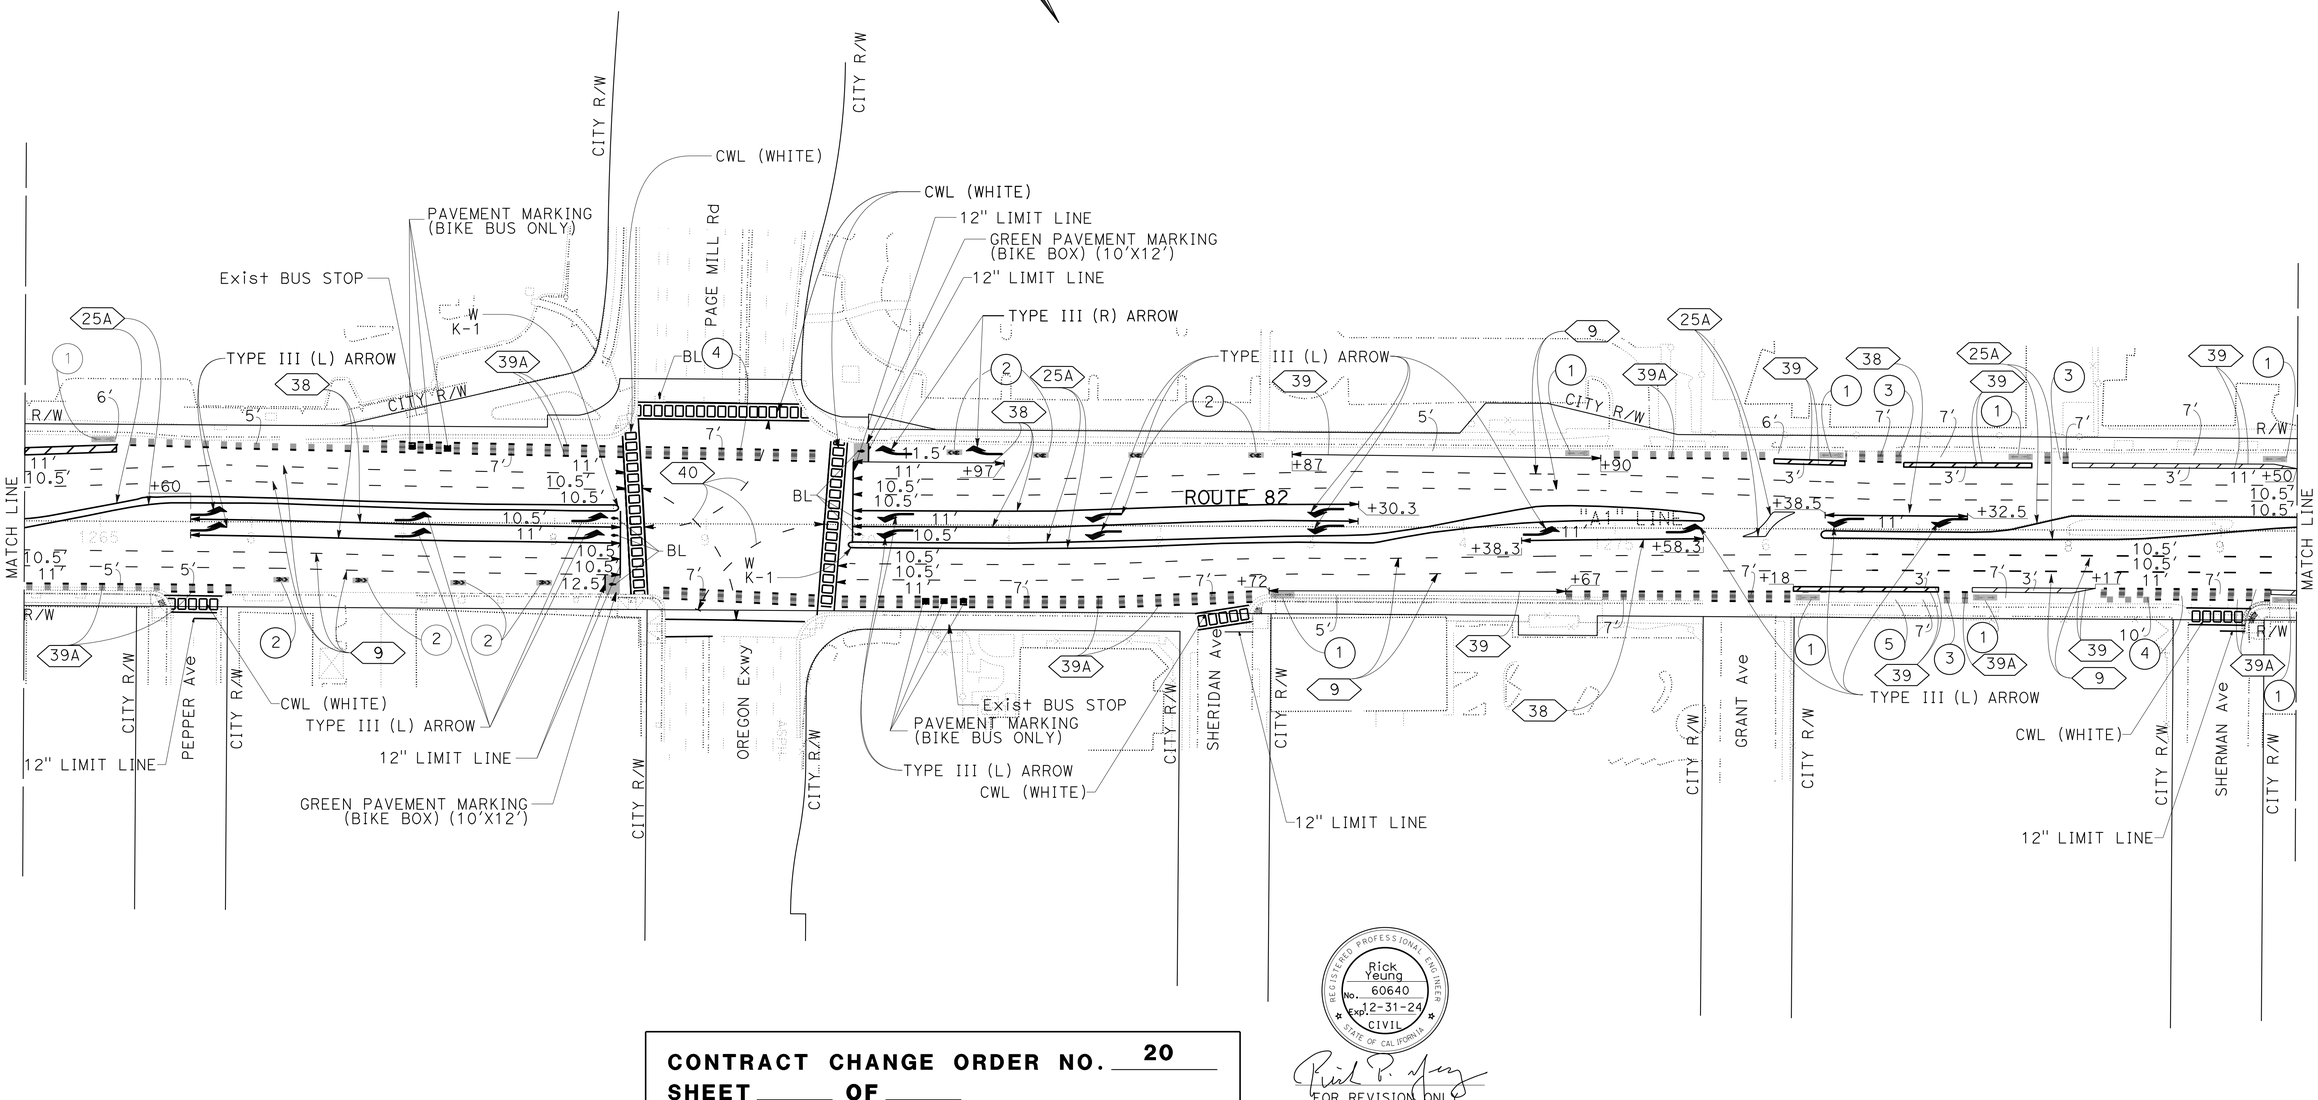

CONTRACT CHANGE ORDER NO. 20
SHEET _____ OF _____

REGISTERED PROFESSIONAL ENGINEER — Rick Yeung — No. 60640 — Exp. 12-31-24 — CIVIL — STATE OF CALIFORNIA

FOR REVISION ONLY
July 22, 2024

20 **REPLACED PER CONTRACT CHANGE ORDER No. 20 DATED**

PAVEMENT DELINEATION PLAN

SCALE: 1" = 50'

APPROVED FOR PAVEMENT DELINEATION WORK ONLY

FOR NOTES, ABBREVIATIONS AND LEGEND, SEE SHEET PD-1

PD-22A

CALCULATED-DESIGNED BY	CHECKED BY	REVISED BY	DATE REVISED
SON LY	RICK YEUNG	SL	11-18-22

FUNCTIONAL SUPERVISOR: LESTER LEE

STATE OF CALIFORNIA - DEPARTMENT OF TRANSPORTATION
Caltrans®
TRAFFIC

LAST REVISION: DATE PLOTTED => 18-NOV-2024 TIME PLOTTED => 15:13
09-16-22

BORDER LAST REVISED 7/2/2010

USERNAME => s129144
DGN FILE => 0419000140na022A.cco

RELATIVE BORDER SCALE IS IN INCHES 0 1 2 3

UNIT 0712

PROJECT NUMBER & PHASE 04190001401

Dist	COUNTY	ROUTE	POST MILES TOTAL PROJECT	SHEET No.	TOTAL SHEETS
04	SCI	82	18.2/26.4	240	466

AS-AWARDED CONTRACT PLANS
THIS STAMP PLACED IN LIEU OF ORIGINAL SIGNATURE

REGISTERED CIVIL ENGINEER DATE


PLANS APPROVAL DATE

REGISTERED PROFESSIONAL ENGINEER — No. Exp. CIVIL — STATE OF CALIFORNIA

THE STATE OF CALIFORNIA OR ITS OFFICERS OR AGENTS SHALL NOT BE RESPONSIBLE FOR THE ACCURACY OR COMPLETENESS OF SCANNED COPIES OF THIS PLAN SHEET.

NOTE:

FOR ACCURATE RIGHT OF WAY DATA, CONTACT
RIGHT OF WAY ENGINEERING AT THE DISTRICT OFFICE.

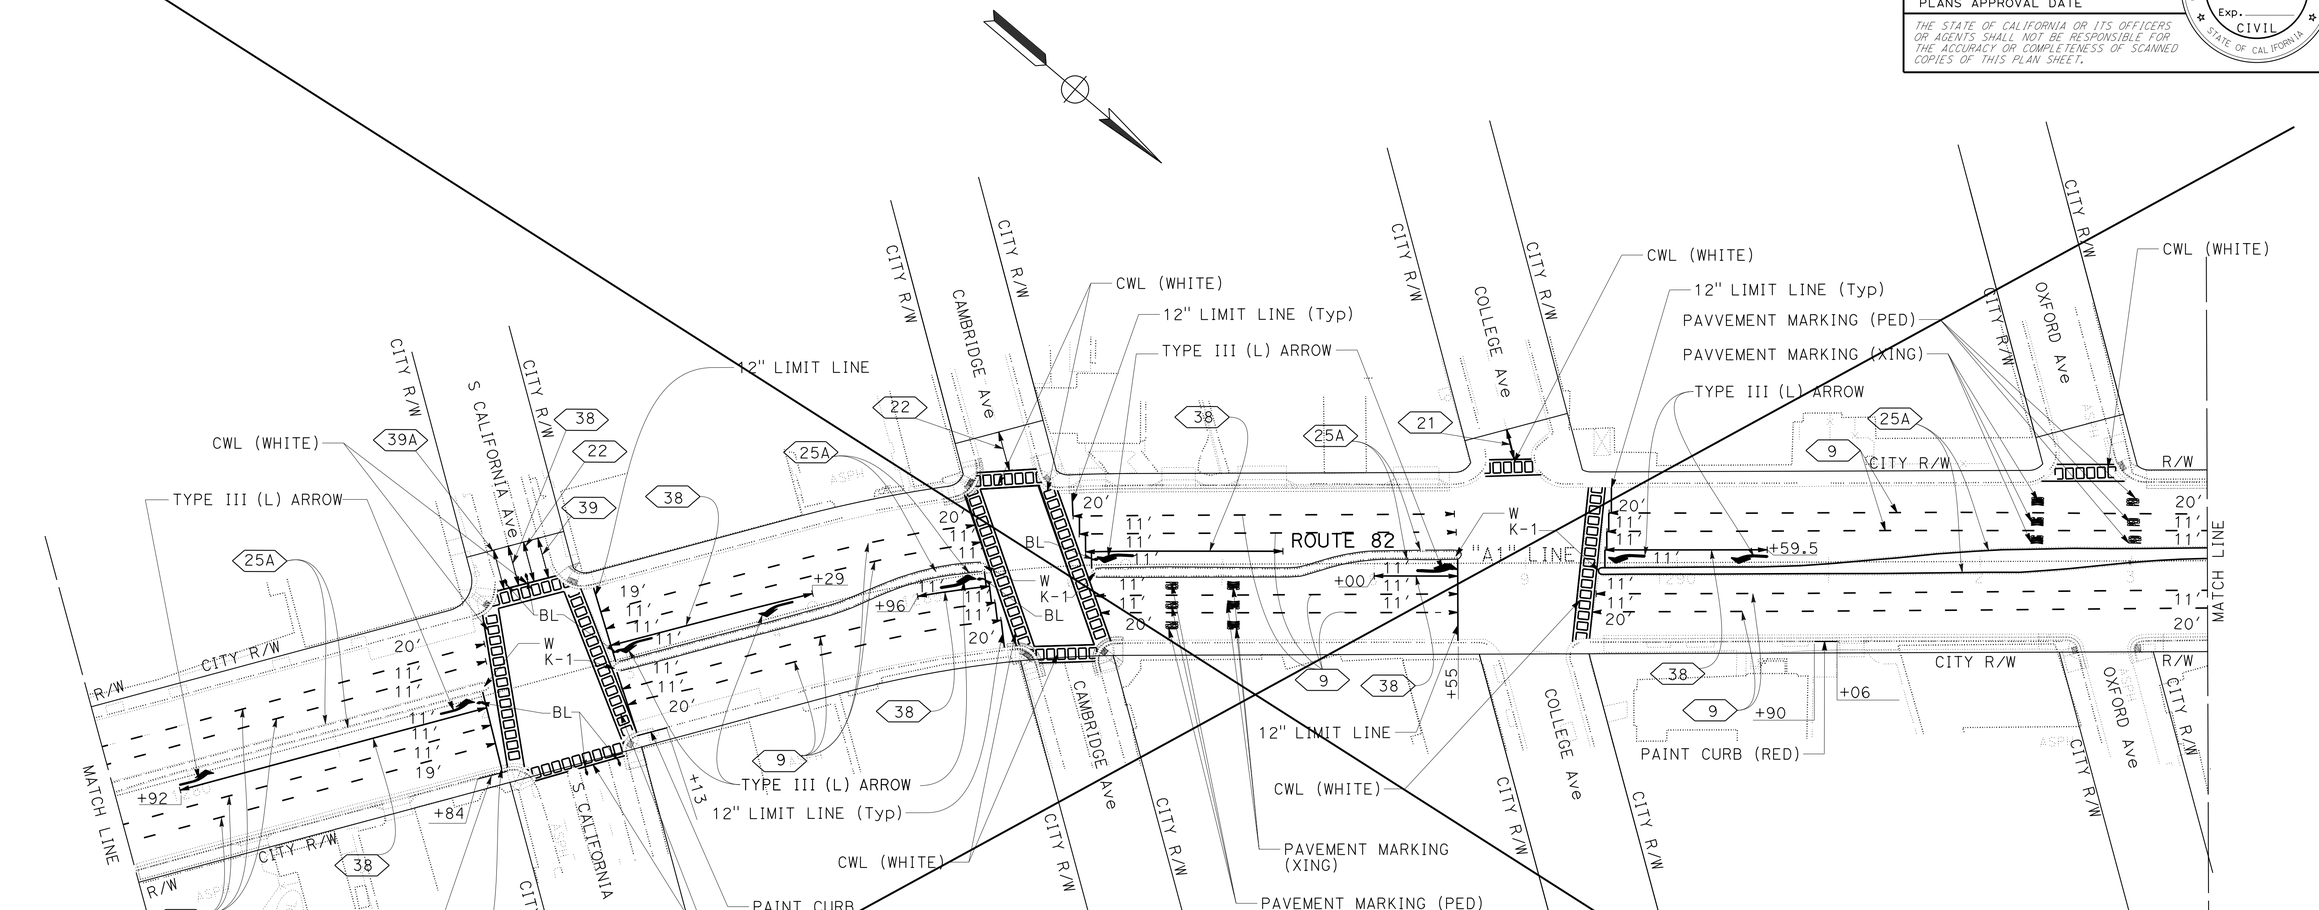

CONTRACT CHANGE ORDER NO. 20
SHEET _____ OF _____

Rick Yeung
No. 60640
Exp. 12-31-24
CIVIL
STATE OF CALIFORNIA

FOR REVISION ONLY
July 22, 2024

20 SHEET DELETED PER CONTRACT CHANGE ORDER No. 20 DATED

PAVEMENT DELINEATION PLAN

SCALE: 1" = 50'

APPROVED FOR PAVEMENT DELINEATION WORK ONLY

FOR NOTES, ABBREVIATIONS AND LEGEND, SEE SHEET PD-1

PD-23

STATE OF CALIFORNIA - DEPARTMENT OF TRANSPORTATION
Caltrans® TRAFFIC

FUNCTIONAL SUPERVISOR	CALCULATED-DESIGNED BY	CHECKED BY	REVISED BY	DATE REVISED
LESTER LEE	RICK YEUNG	SON LY	SL	11-18-22

LAST REVISION 09-16-22
DATE PLOTTED => 18-NOV-2024
TIME PLOTTED => 15:13

BORDER LAST REVISED 7/2/2010
USERNAME => s129144
DGN FILE => 04190000140na023.cco
RELATIVE BORDER SCALE IS IN INCHES 0 1 2 3
UNIT 0712
PROJECT NUMBER & PHASE 04190001401

Dist	COUNTY	ROUTE	POST MILES TOTAL PROJECT	SHEET No.	TOTAL SHEETS
04	SCI	82	18.2/26.4	240	466

REGISTERED CIVIL ENGINEER DATE


PLANS APPROVAL DATE

REGISTERED PROFESSIONAL ENGINEER No. Exp. CIVIL STATE OF CALIFORNIA

THE STATE OF CALIFORNIA OR ITS OFFICERS OR AGENTS SHALL NOT BE RESPONSIBLE FOR THE ACCURACY OR COMPLETENESS OF SCANNED COPIES OF THIS PLAN SHEET.

NOTE:

FOR ACCURATE RIGHT OF WAY DATA, CONTACT
RIGHT OF WAY ENGINEERING AT THE DISTRICT OFFICE.

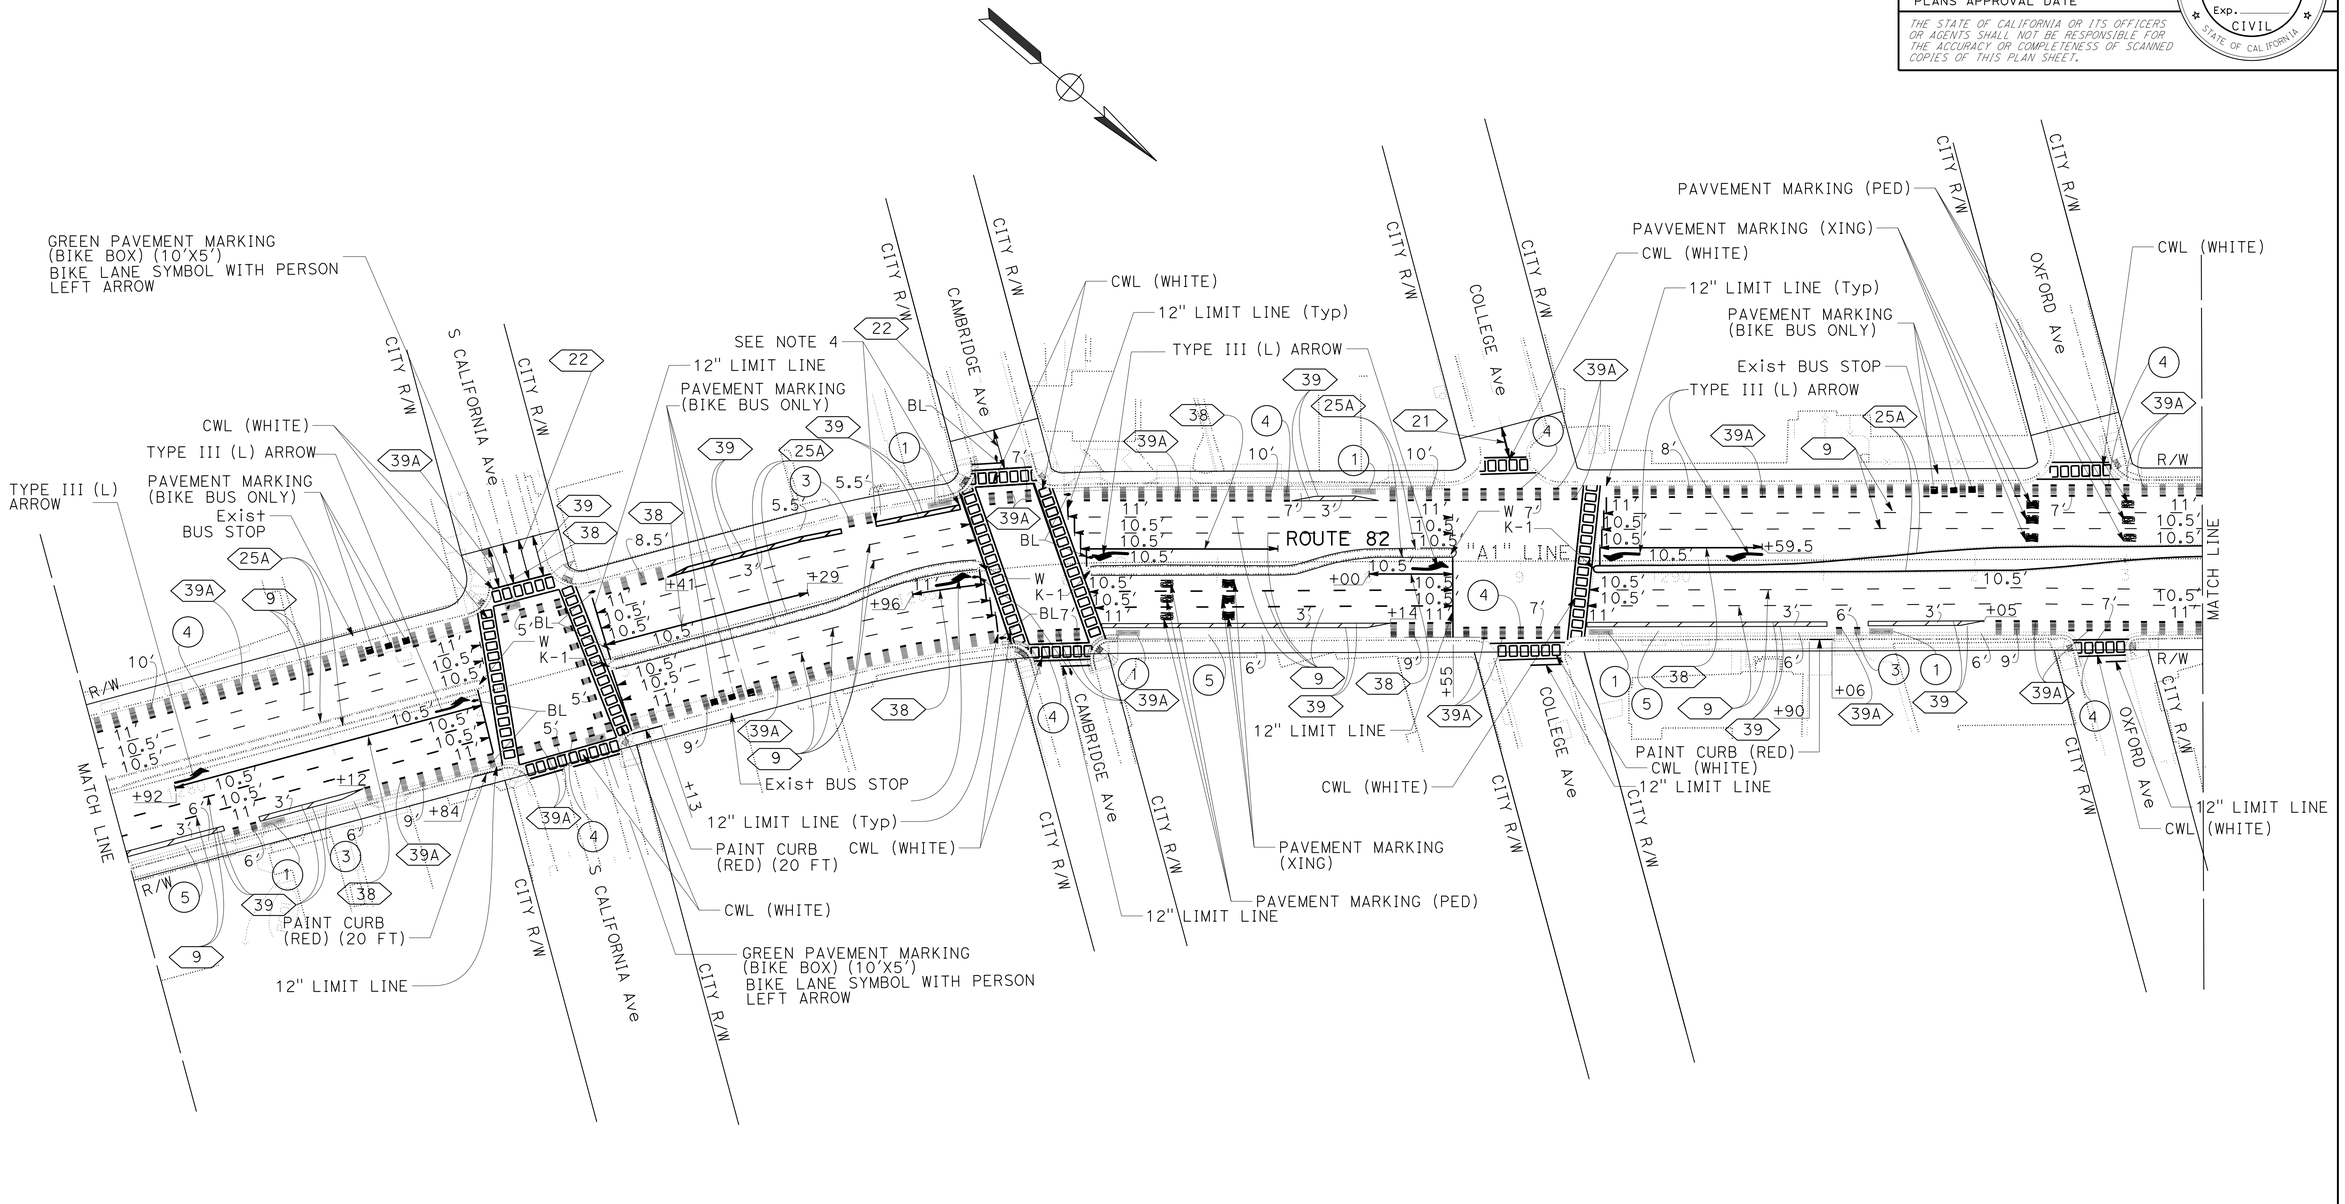

PAVEMENT DELINEATION PLAN

SCALE: 1" = 50'

APPROVED FOR PAVEMENT DELINEATION WORK ONLY

FOR NOTES, ABBREVIATIONS AND LEGEND, SEE SHEET PD-1

PD-23A

LAST REVISION: DATE PLOTTED => 18-NOV-2024
09-16-22 TIME PLOTTED => 15:13

STATE OF CALIFORNIA - DEPARTMENT OF TRANSPORTATION
TRAFFIC

REVISED BY	DATE REVISED
SL	11-18-22

CALCULATED-DESIGNED BY	CHECKED BY
SON LY	RICK YEUNG

FUNCTIONAL SUPERVISOR: LESTER LEE

BORDER LAST REVISED 7/2/2010

USERNAME => s129144
DGN FILE => 0419000140na023A.cco

RELATIVE BORDER SCALE IS IN INCHES 0 1 2 3

UNIT 0712

PROJECT NUMBER & PHASE 04190001401

Dist	COUNTY	ROUTE	POST MILES TOTAL PROJECT	SHEET No.	TOTAL SHEETS
04	SCI	82	18.2/26.4	241	466

AS-AWARDED CONTRACT PLANS
THIS STAMP PLACED IN LIEU OF ORIGINAL SIGNATURE

REGISTERED CIVIL ENGINEER DATE

PLANS APPROVAL DATE


REGISTERED PROFESSIONAL ENGINEER — No. Exp. CIVIL — STATE OF CALIFORNIA

THE STATE OF CALIFORNIA OR ITS OFFICERS OR AGENTS SHALL NOT BE RESPONSIBLE FOR THE ACCURACY OR COMPLETENESS OF SCANNED COPIES OF THIS PLAN SHEET.

20

NOTE:

FOR ACCURATE RIGHT OF WAY DATA, CONTACT
RIGHT OF WAY ENGINEERING AT THE DISTRICT OFFICE.

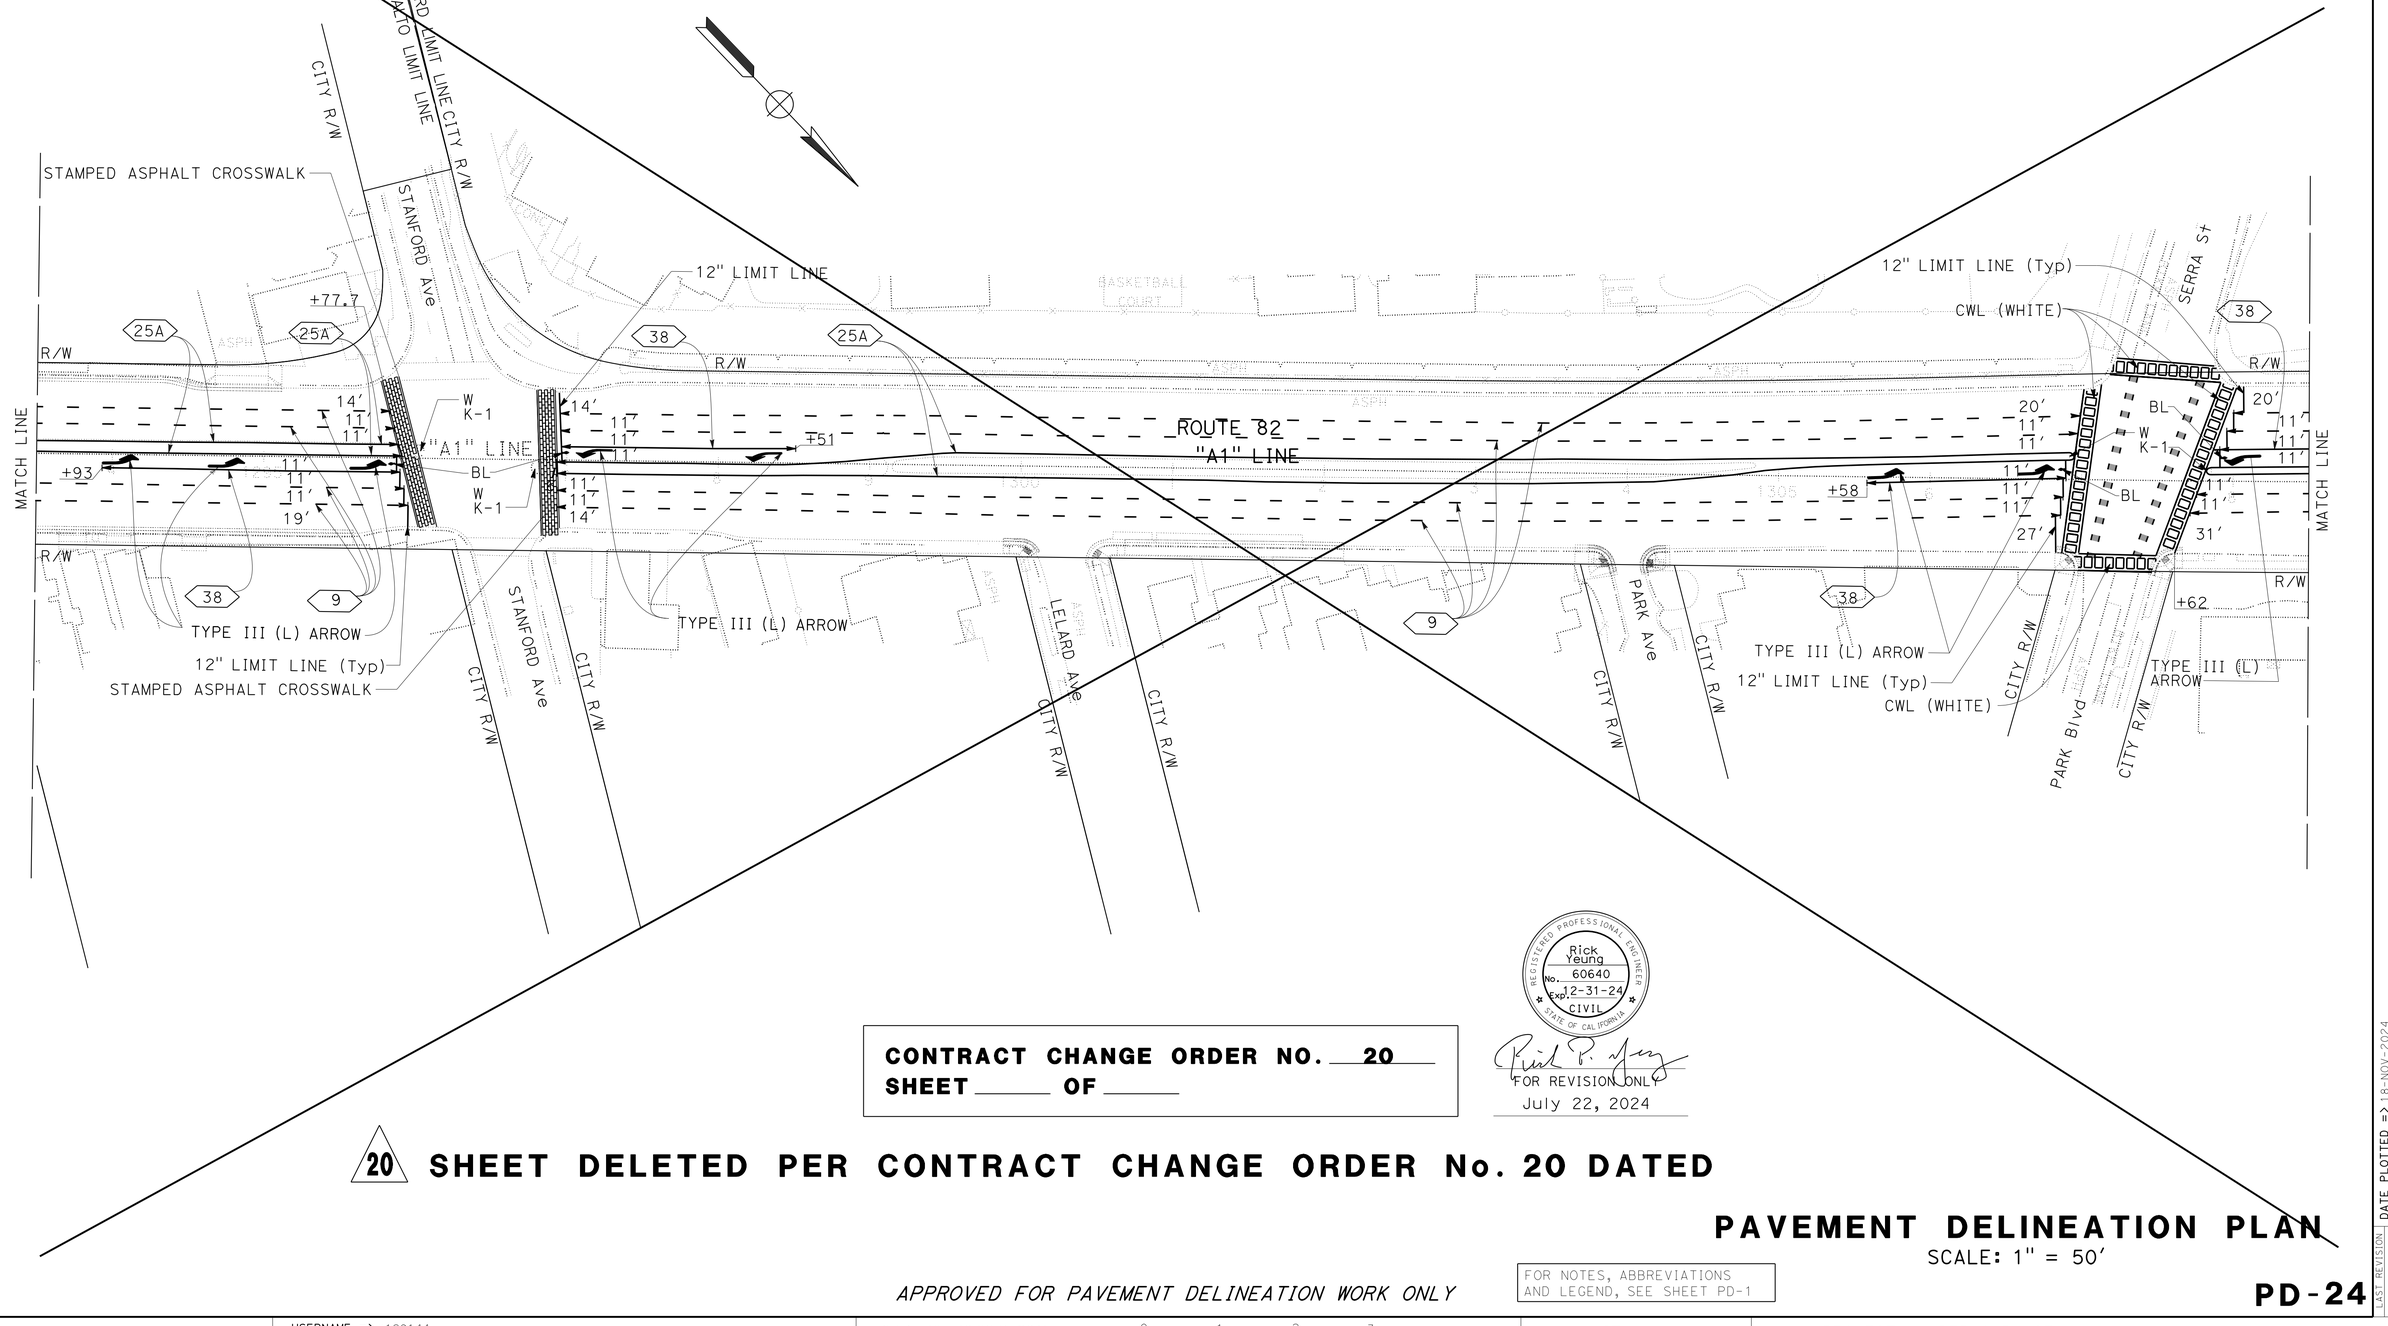

CONTRACT CHANGE ORDER NO. 20
SHEET _____ OF _____

Rick Yeung — No. 60640 — Exp. 12-31-24 — CIVIL — STATE OF CALIFORNIA
FOR REVISION ONLY
July 22, 2024

20 SHEET DELETED PER CONTRACT CHANGE ORDER No. 20 DATED

PAVEMENT DELINEATION PLAN

SCALE: 1" = 50'

APPROVED FOR PAVEMENT DELINEATION WORK ONLY

FOR NOTES, ABBREVIATIONS AND LEGEND, SEE SHEET PD-1

PD-24

REVISED BY	DATE REVISED
SL	11-18-22

CALCULATED-DESIGNED BY: RICK YEUNG
CHECKED BY: SON LY
FUNCTIONAL SUPERVISOR: LESTER LEE

STATE OF CALIFORNIA - DEPARTMENT OF TRANSPORTATION
TRAFFIC

LAST REVISION DATE PLOTTED => 18-NOV-2024
09-16-22 TIME PLOTTED => 15:14

BORDER LAST REVISED 7/2/2010 | USERNAME => s129144 | DGN FILE => 0419000140na024.cco | RELATIVE BORDER SCALE IS IN INCHES 0 1 2 3 | UNIT 0712 | PROJECT NUMBER & PHASE 04190001401

Dist	COUNTY	ROUTE	POST MILES TOTAL PROJECT	SHEET No.	TOTAL SHEETS
04	SCI	82	18.2/26.4	241	466

AS-AWARDED CONTRACT PLANS
THIS STAMP PLACED IN LIEU OF ORIGINAL SIGNATURE

REGISTERED CIVIL ENGINEER DATE

PLANS APPROVAL DATE

THE STATE OF CALIFORNIA OR ITS OFFICERS OR AGENTS SHALL NOT BE RESPONSIBLE FOR THE ACCURACY OR COMPLETENESS OF SCANNED COPIES OF THIS PLAN SHEET.


REGISTERED PROFESSIONAL ENGINEER — Rick Yeung — No. 60640 — Exp. 12-31-24 — CIVIL — STATE OF CALIFORNIA

20

FOR REVISION ONLY
July 22, 2024

NOTE:

FOR ACCURATE RIGHT OF WAY DATA, CONTACT
RIGHT OF WAY ENGINEERING AT THE DISTRICT OFFICE.

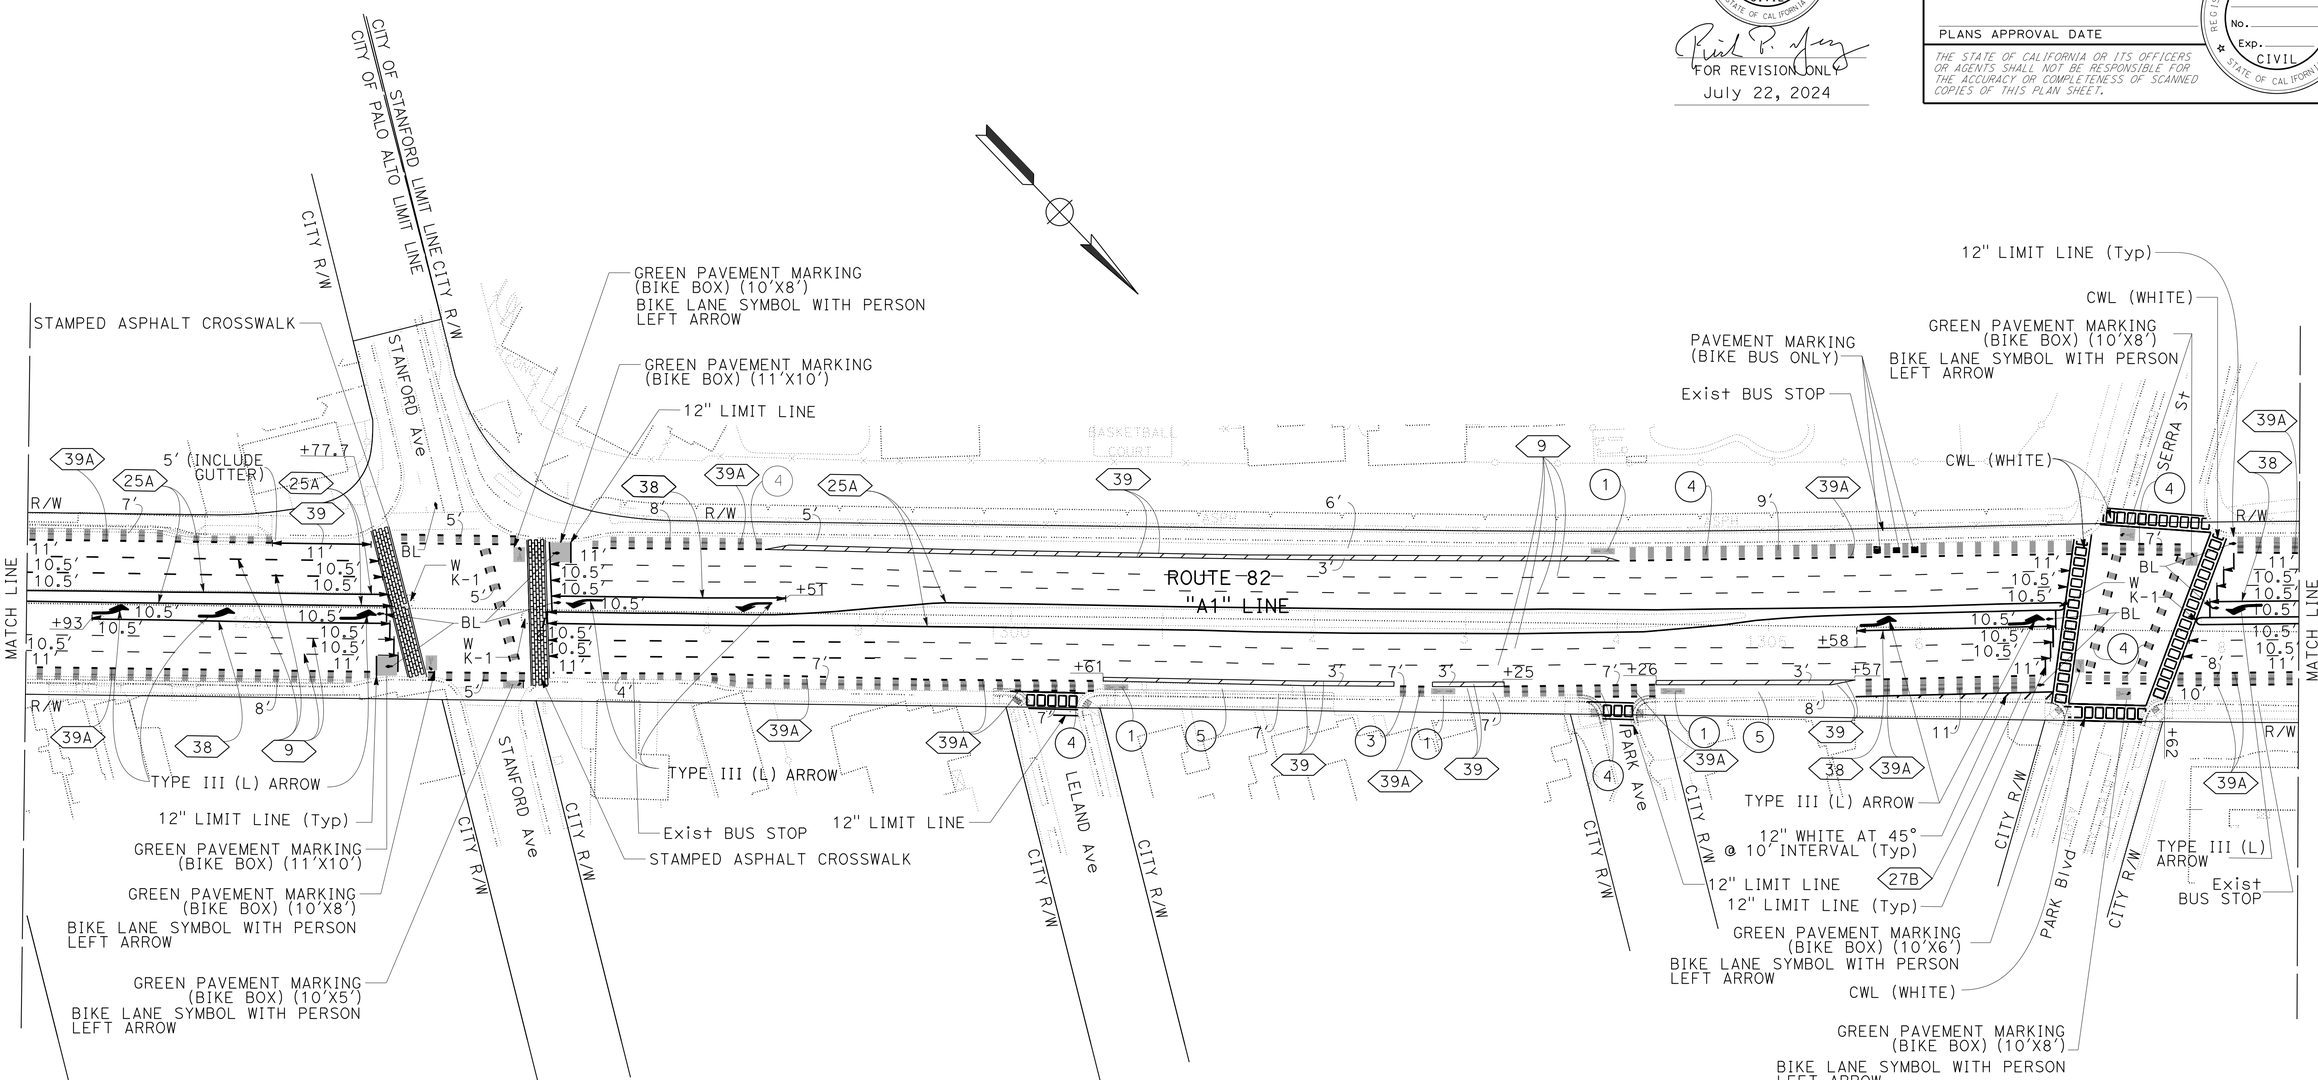

CONTRACT CHANGE ORDER NO. 20
SHEET _____ OF _____

20 REPLACED PER CONTRACT CHANGE ORDER No. 20 DATED

PAVEMENT DELINEATION PLAN

SCALE: 1" = 50'

APPROVED FOR PAVEMENT DELINEATION WORK ONLY

FOR NOTES, ABBREVIATIONS AND LEGEND, SEE SHEET PD-1

PD-24A

STATE OF CALIFORNIA - DEPARTMENT OF TRANSPORTATION
TRAFFIC
FUNCTIONAL SUPERVISOR: LESTER LEE
CALCULATED-DESIGNED BY: SON LY
CHECKED BY: RICK YEUNG
REVISED BY: SL
DATE REVISED: 11-18-22

LAST REVISION DATE PLOTTED => 18-NOV-2024
TIME PLOTTED => 15:14
09-16-22

BORDER LAST REVISED 7/2/2010
USERNAME => s129144
DGN FILE => 0419000140na024A.cco
RELATIVE BORDER SCALE IS IN INCHES 0 1 2 3
UNIT 0712
PROJECT NUMBER & PHASE 04190001401

Dist	COUNTY	ROUTE	POST MILES TOTAL PROJECT	SHEET No.	TOTAL SHEETS
04	SCI	82	18.2/26.4	242	466

AS-AWARDED CONTRACT PLANS
THIS STAMP PLACED IN LIEU OF ORIGINAL SIGNATURE

REGISTERED CIVIL ENGINEER DATE

PLANS APPROVAL DATE


REGISTERED PROFESSIONAL ENGINEER — No. Exp. CIVIL — STATE OF CALIFORNIA

THE STATE OF CALIFORNIA OR ITS OFFICERS OR AGENTS SHALL NOT BE RESPONSIBLE FOR THE ACCURACY OR COMPLETENESS OF SCANNED COPIES OF THIS PLAN SHEET.

20

NOTE:

FOR ACCURATE RIGHT OF WAY DATA, CONTACT
RIGHT OF WAY ENGINEERING AT THE DISTRICT OFFICE.

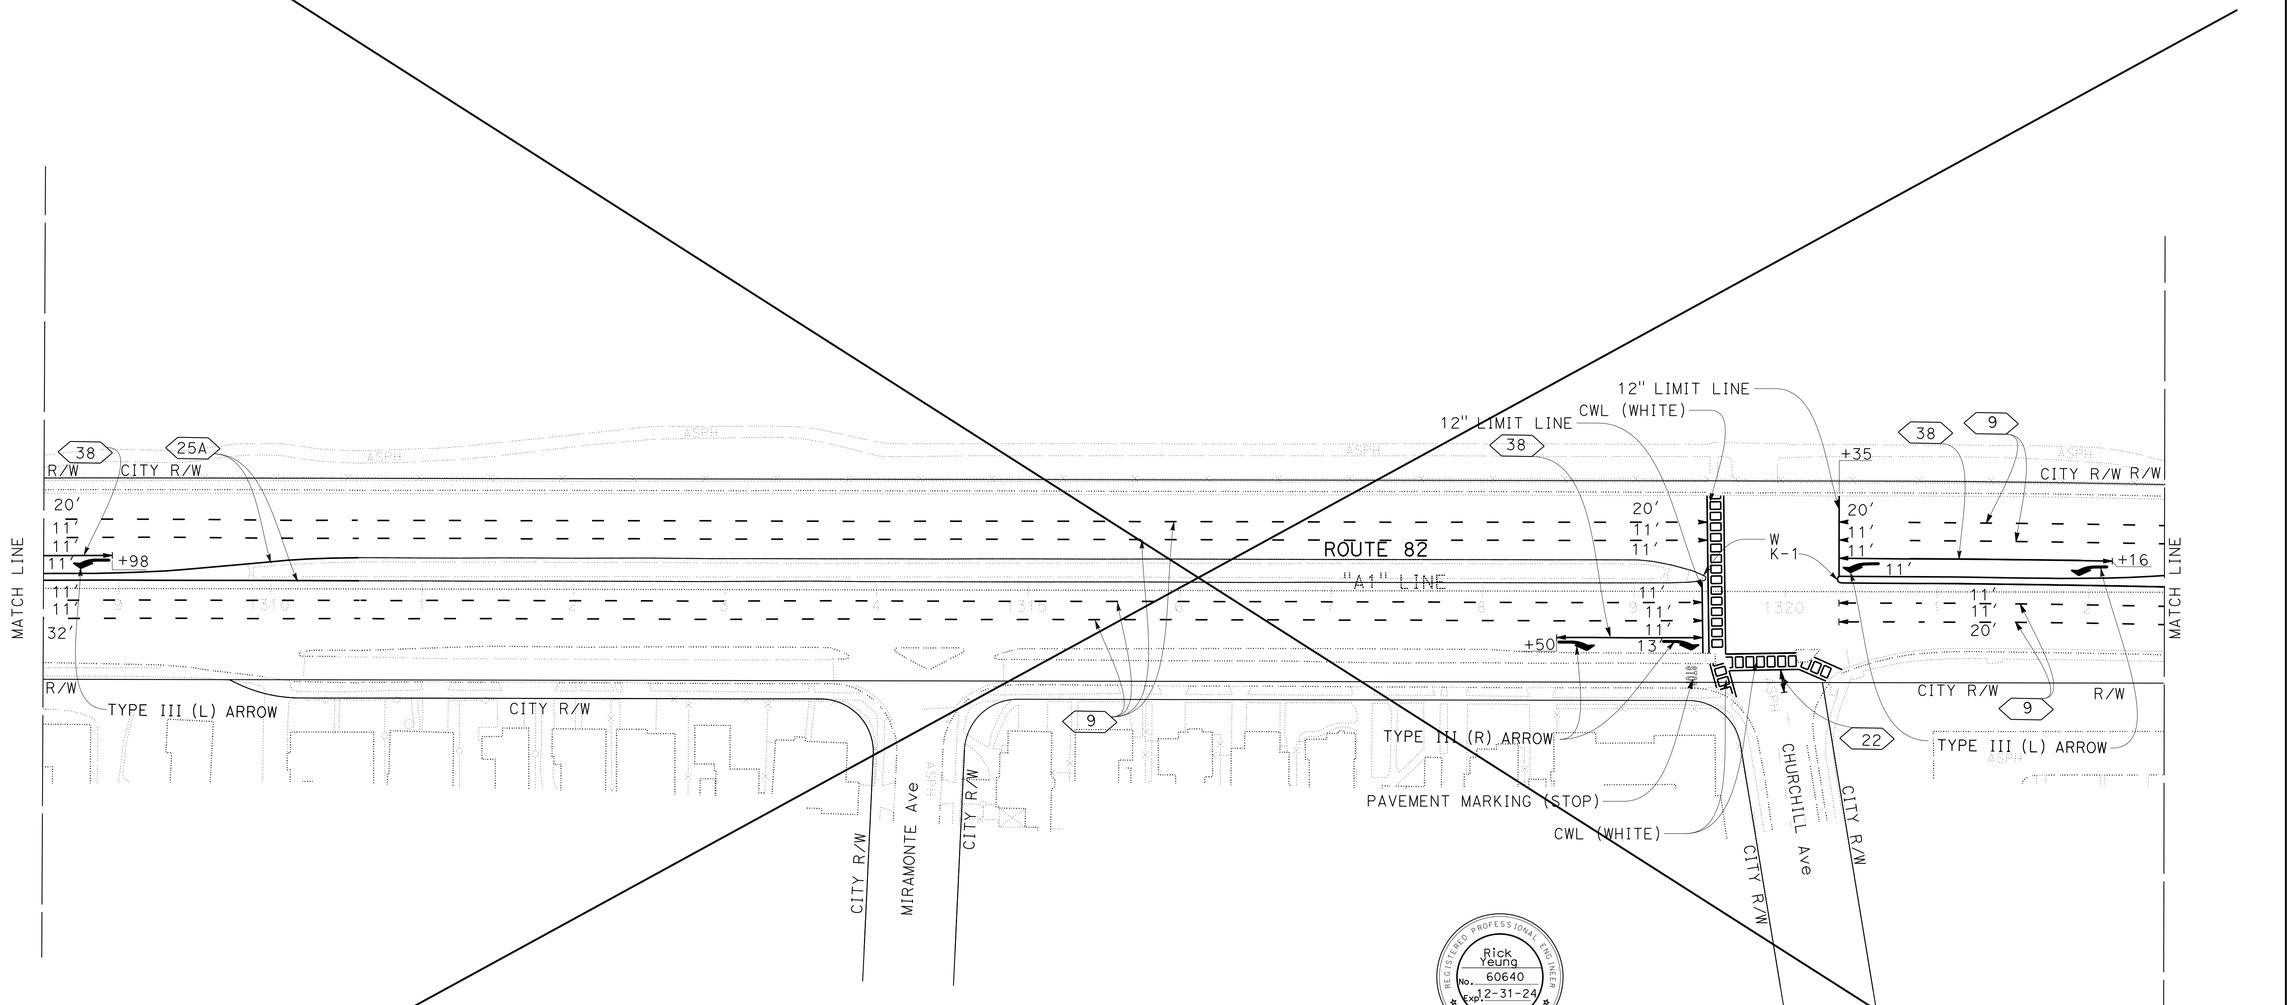

CONTRACT CHANGE ORDER NO. 20
SHEET _____ OF _____

REGISTERED PROFESSIONAL ENGINEER — Rick Yeung — No. 60640 — Exp. 12-31-24 — CIVIL — STATE OF CALIFORNIA

FOR REVISION ONLY
July 22, 2024

20 **SHEET DELETED PER CONTRACT CHANGE ORDER No. 20 DATED**

PAVEMENT DELINEATION PLAN

SCALE: 1" = 50′

APPROVED FOR PAVEMENT DELINEATION WORK ONLY

FOR NOTES, ABBREVIATIONS AND LEGEND, SEE SHEET PD-1

PD-25

CALCULATED-DESIGNED BY	CHECKED BY	REVISED BY	DATE REVISED
RICK YEUNG	SON LY	SL	11-18-22

FUNCTIONAL SUPERVISOR: LESTER LEE

STATE OF CALIFORNIA - DEPARTMENT OF TRANSPORTATION
TRAFFIC

Caltrans®

LAST REVISION: DATE PLOTTED => 18-NOV-2024
09-16-22 TIME PLOTTED => 15:14

BORDER LAST REVISED 7/2/2010 | USERNAME => s129144 | DGN FILE => 0419000140na025.cco | RELATIVE BORDER SCALE IS IN INCHES 0 1 2 3 | UNIT 0712 | PROJECT NUMBER & PHASE 04190001401

NOTE:

FOR ACCURATE RIGHT OF WAY DATA, CONTACT
RIGHT OF WAY ENGINEERING AT THE DISTRICT OFFICE.

Dist	COUNTY	ROUTE	POST MILES TOTAL PROJECT	SHEET No.	TOTAL SHEETS
04	SCI	82	18.2/26.4	242	466

20


AS-AWARDED CONTRACT PLANS
THIS STAMP PLACED IN LIEU OF ORIGINAL SIGNATURE

REGISTERED CIVIL ENGINEER DATE

PLANS APPROVAL DATE

REGISTERED PROFESSIONAL ENGINEER — No. Exp. CIVIL — STATE OF CALIFORNIA

THE STATE OF CALIFORNIA OR ITS OFFICERS OR AGENTS SHALL NOT BE RESPONSIBLE FOR THE ACCURACY OR COMPLETENESS OF SCANNED COPIES OF THIS PLAN SHEET.

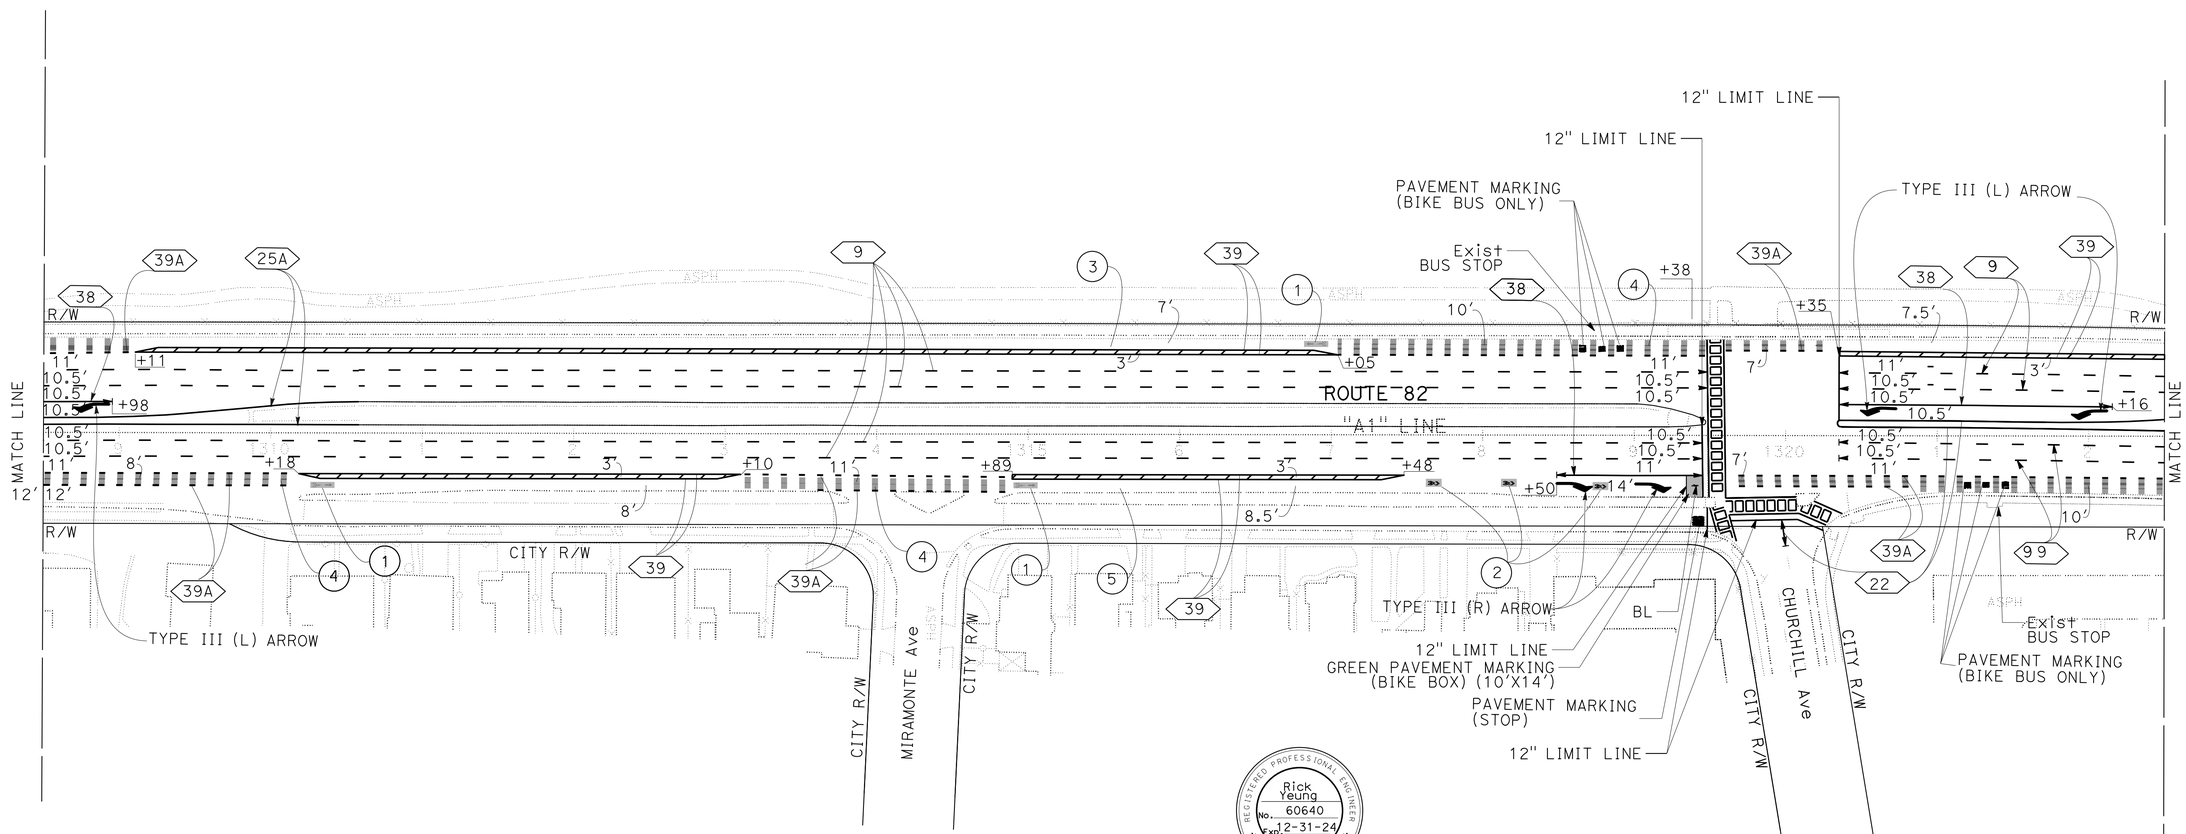

CONTRACT CHANGE ORDER NO. 20
SHEET _____ OF _____

REGISTERED PROFESSIONAL ENGINEER — Rick Yeung — No. 60640 — Exp. 12-31-24 — CIVIL — STATE OF CALIFORNIA

FOR REVISION ONLY
July 22, 2024

20 **REPLACED PER CONTRACT CHANGE ORDER No. 20 DATED**

PAVEMENT DELINEATION PLAN

SCALE: 1" = 50'

APPROVED FOR PAVEMENT DELINEATION WORK ONLY

FOR NOTES, ABBREVIATIONS AND LEGEND, SEE SHEET PD-1

PD-25A

CALCULATED-DESIGNED BY	
CHECKED BY	
REVISED BY	SL
DATE REVISED	11-18-22
FUNCTIONAL SUPERVISOR	LESTER LEE
	SON LY
	RICK YEUNG

STATE OF CALIFORNIA - DEPARTMENT OF TRANSPORTATION
TRAFFIC

LAST REVISION DATE PLOTTED => 18-NOV-2024
09-16-22 TIME PLOTTED => 15:14

BORDER LAST REVISED 7/2/2010 | USERNAME => s129144 | DGN FILE => 0419000140na025A.cco | RELATIVE BORDER SCALE IS IN INCHES 0 1 2 3 | UNIT 0712 | PROJECT NUMBER & PHASE 04190001401

NOTE:

FOR ACCURATE RIGHT OF WAY DATA, CONTACT
RIGHT OF WAY ENGINEERING AT THE DISTRICT OFFICE.

Dist	COUNTY	ROUTE	POST MILES TOTAL PROJECT	SHEET No.	TOTAL SHEETS
04	SCI	82	18.2/26.4	243	466

20


AS-AWARDED CONTRACT PLANS
THIS STAMP PLACED IN LIEU OF ORIGINAL SIGNATURE

REGISTERED CIVIL ENGINEER DATE

PLANS APPROVAL DATE

REGISTERED PROFESSIONAL ENGINEER — No. ____ Exp. ____ CIVIL — STATE OF CALIFORNIA

THE STATE OF CALIFORNIA OR ITS OFFICERS OR AGENTS SHALL NOT BE RESPONSIBLE FOR THE ACCURACY OR COMPLETENESS OF SCANNED COPIES OF THIS PLAN SHEET.

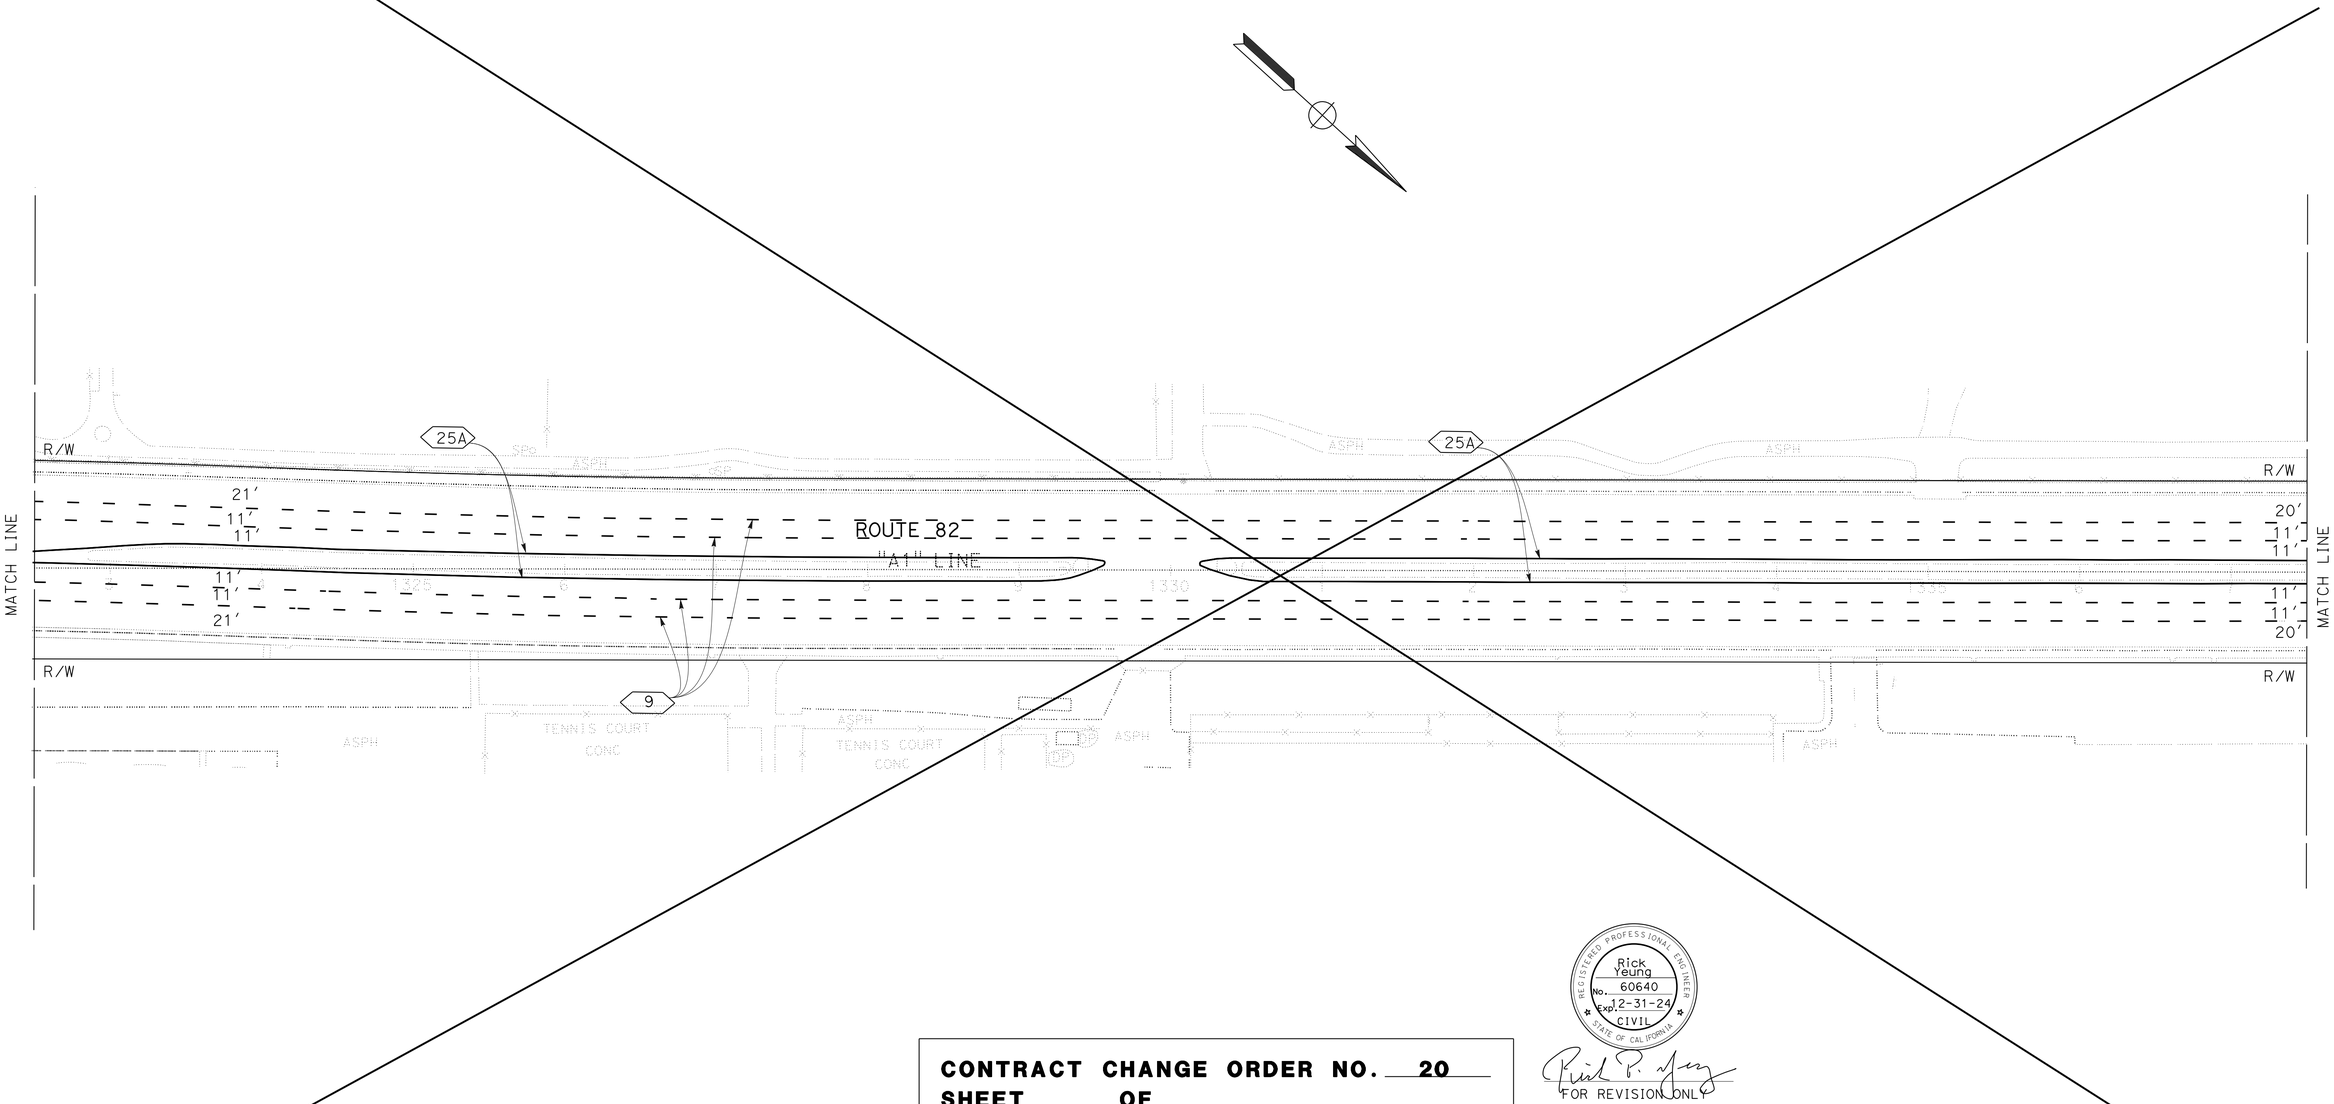

CONTRACT CHANGE ORDER NO. 20
SHEET ____ OF ____

REGISTERED PROFESSIONAL ENGINEER — Rick Yeung — No. 60640 — Exp. 12-31-24 — CIVIL — STATE OF CALIFORNIA

FOR REVISION ONLY
July 22, 2024

20 **SHEET DELETED PER CONTRACT CHANGE ORDER No. 20 DATED**

PAVEMENT DELINEATION PLAN

SCALE: 1" = 50′

APPROVED FOR PAVEMENT DELINEATION WORK ONLY

FOR NOTES, ABBREVIATIONS AND LEGEND, SEE SHEET PD-1

PD-26

CALCULATED-DESIGNED BY	CHECKED BY	REVISED BY	DATE REVISED
RICK YEUNG	SON LY	SL	11-18-22

FUNCTIONAL SUPERVISOR: LESTER LEE

STATE OF CALIFORNIA - DEPARTMENT OF TRANSPORTATION
Caltrans®
TRAFFIC

LAST REVISION DATE PLOTTED => 18-NOV-2024
09-19-22 TIME PLOTTED => 15:14

BORDER LAST REVISED 7/2/2010

USERNAME => s129144
DGN FILE => 0419000140na026.cco

RELATIVE BORDER SCALE IS IN INCHES 0 1 2 3

UNIT 0712

PROJECT NUMBER & PHASE 04190001401

NOTE:

FOR ACCURATE RIGHT OF WAY DATA, CONTACT
RIGHT OF WAY ENGINEERING AT THE DISTRICT OFFICE.

Dist	COUNTY	ROUTE	POST MILES TOTAL PROJECT	SHEET No.	TOTAL SHEETS
04	SCI	82	18.2/26.4	243A	466

20


AS-AWARDED CONTRACT PLANS
THIS STAMP PLACED IN LIEU OF ORIGINAL SIGNATURE

REGISTERED CIVIL ENGINEER DATE

PLANS APPROVAL DATE

REGISTERED PROFESSIONAL ENGINEER — No. Exp. CIVIL — STATE OF CALIFORNIA

THE STATE OF CALIFORNIA OR ITS OFFICERS OR AGENTS SHALL NOT BE RESPONSIBLE FOR THE ACCURACY OR COMPLETENESS OF SCANNED COPIES OF THIS PLAN SHEET.

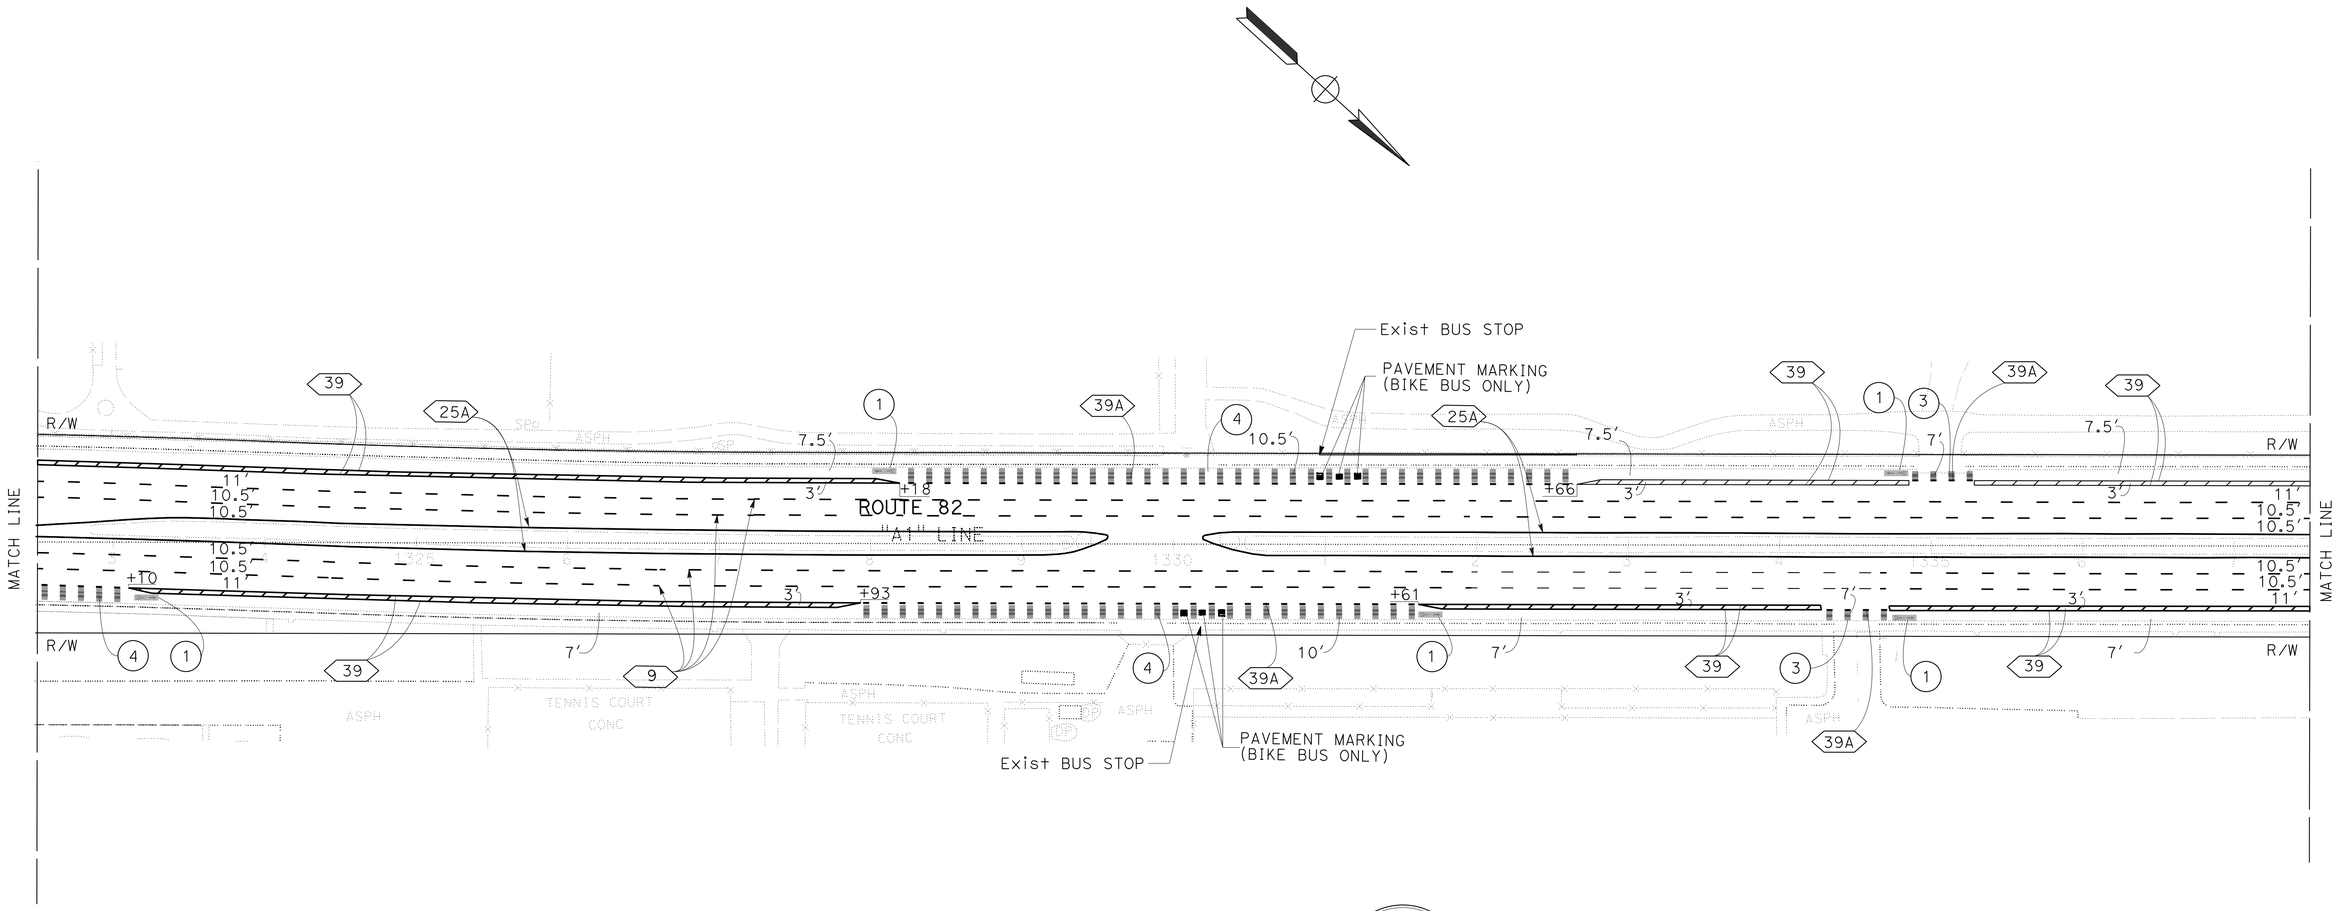

CONTRACT CHANGE ORDER NO. 20
SHEET _____ OF _____

REGISTERED PROFESSIONAL ENGINEER — Rick Yeung — No. 60640 — Exp. 12-31-24 — CIVIL — STATE OF CALIFORNIA

FOR REVISION ONLY
July 22, 2024

20 **REPLACED PER CONTRACT CHANGE ORDER No. 20 DATED**

PAVEMENT DELINEATION PLAN

SCALE: 1" = 50′

APPROVED FOR PAVEMENT DELINEATION WORK ONLY

FOR NOTES, ABBREVIATIONS AND LEGEND, SEE SHEET PD-1

PD-26A

CALCULATED-DESIGNED BY	SON LY	REVISED BY	SL
CHECKED BY	RICK YEUNG	DATE REVISED	11-18-22
FUNCTIONAL SUPERVISOR	LESTER LEE		

STATE OF CALIFORNIA - DEPARTMENT OF TRANSPORTATION
Caltrans®
TRAFFIC

LAST REVISION: DATE PLOTTED => 18-NOV-2024
09-19-22 TIME PLOTTED => 15:14

BORDER LAST REVISED 7/2/2010 | USERNAME => s129144 | DGN FILE => 04190000140na026A.cco | RELATIVE BORDER SCALE IS IN INCHES 0 1 2 3 | UNIT 0712 | PROJECT NUMBER & PHASE 04190001401

Dist	COUNTY	ROUTE	POST MILES TOTAL PROJECT	SHEET No.	TOTAL SHEETS
04	SCl	82	18.2/26.4	244	466

AS-AWARDED CONTRACT PLANS
THIS STAMP PLACED IN LIEU OF ORIGINAL SIGNATURE

REGISTERED CIVIL ENGINEER DATE

January 20, 2023
PLANS APPROVAL DATE


REGISTERED PROFESSIONAL ENGINEER No. Exp. CIVIL STATE OF CALIFORNIA

THE STATE OF CALIFORNIA OR ITS OFFICERS OR AGENTS SHALL NOT BE RESPONSIBLE FOR THE ACCURACY OR COMPLETENESS OF SCANNED COPIES OF THIS PLAN SHEET.

20

NOTE:

FOR ACCURATE RIGHT OF WAY DATA, CONTACT
RIGHT OF WAY ENGINEERING AT THE DISTRICT OFFICE.

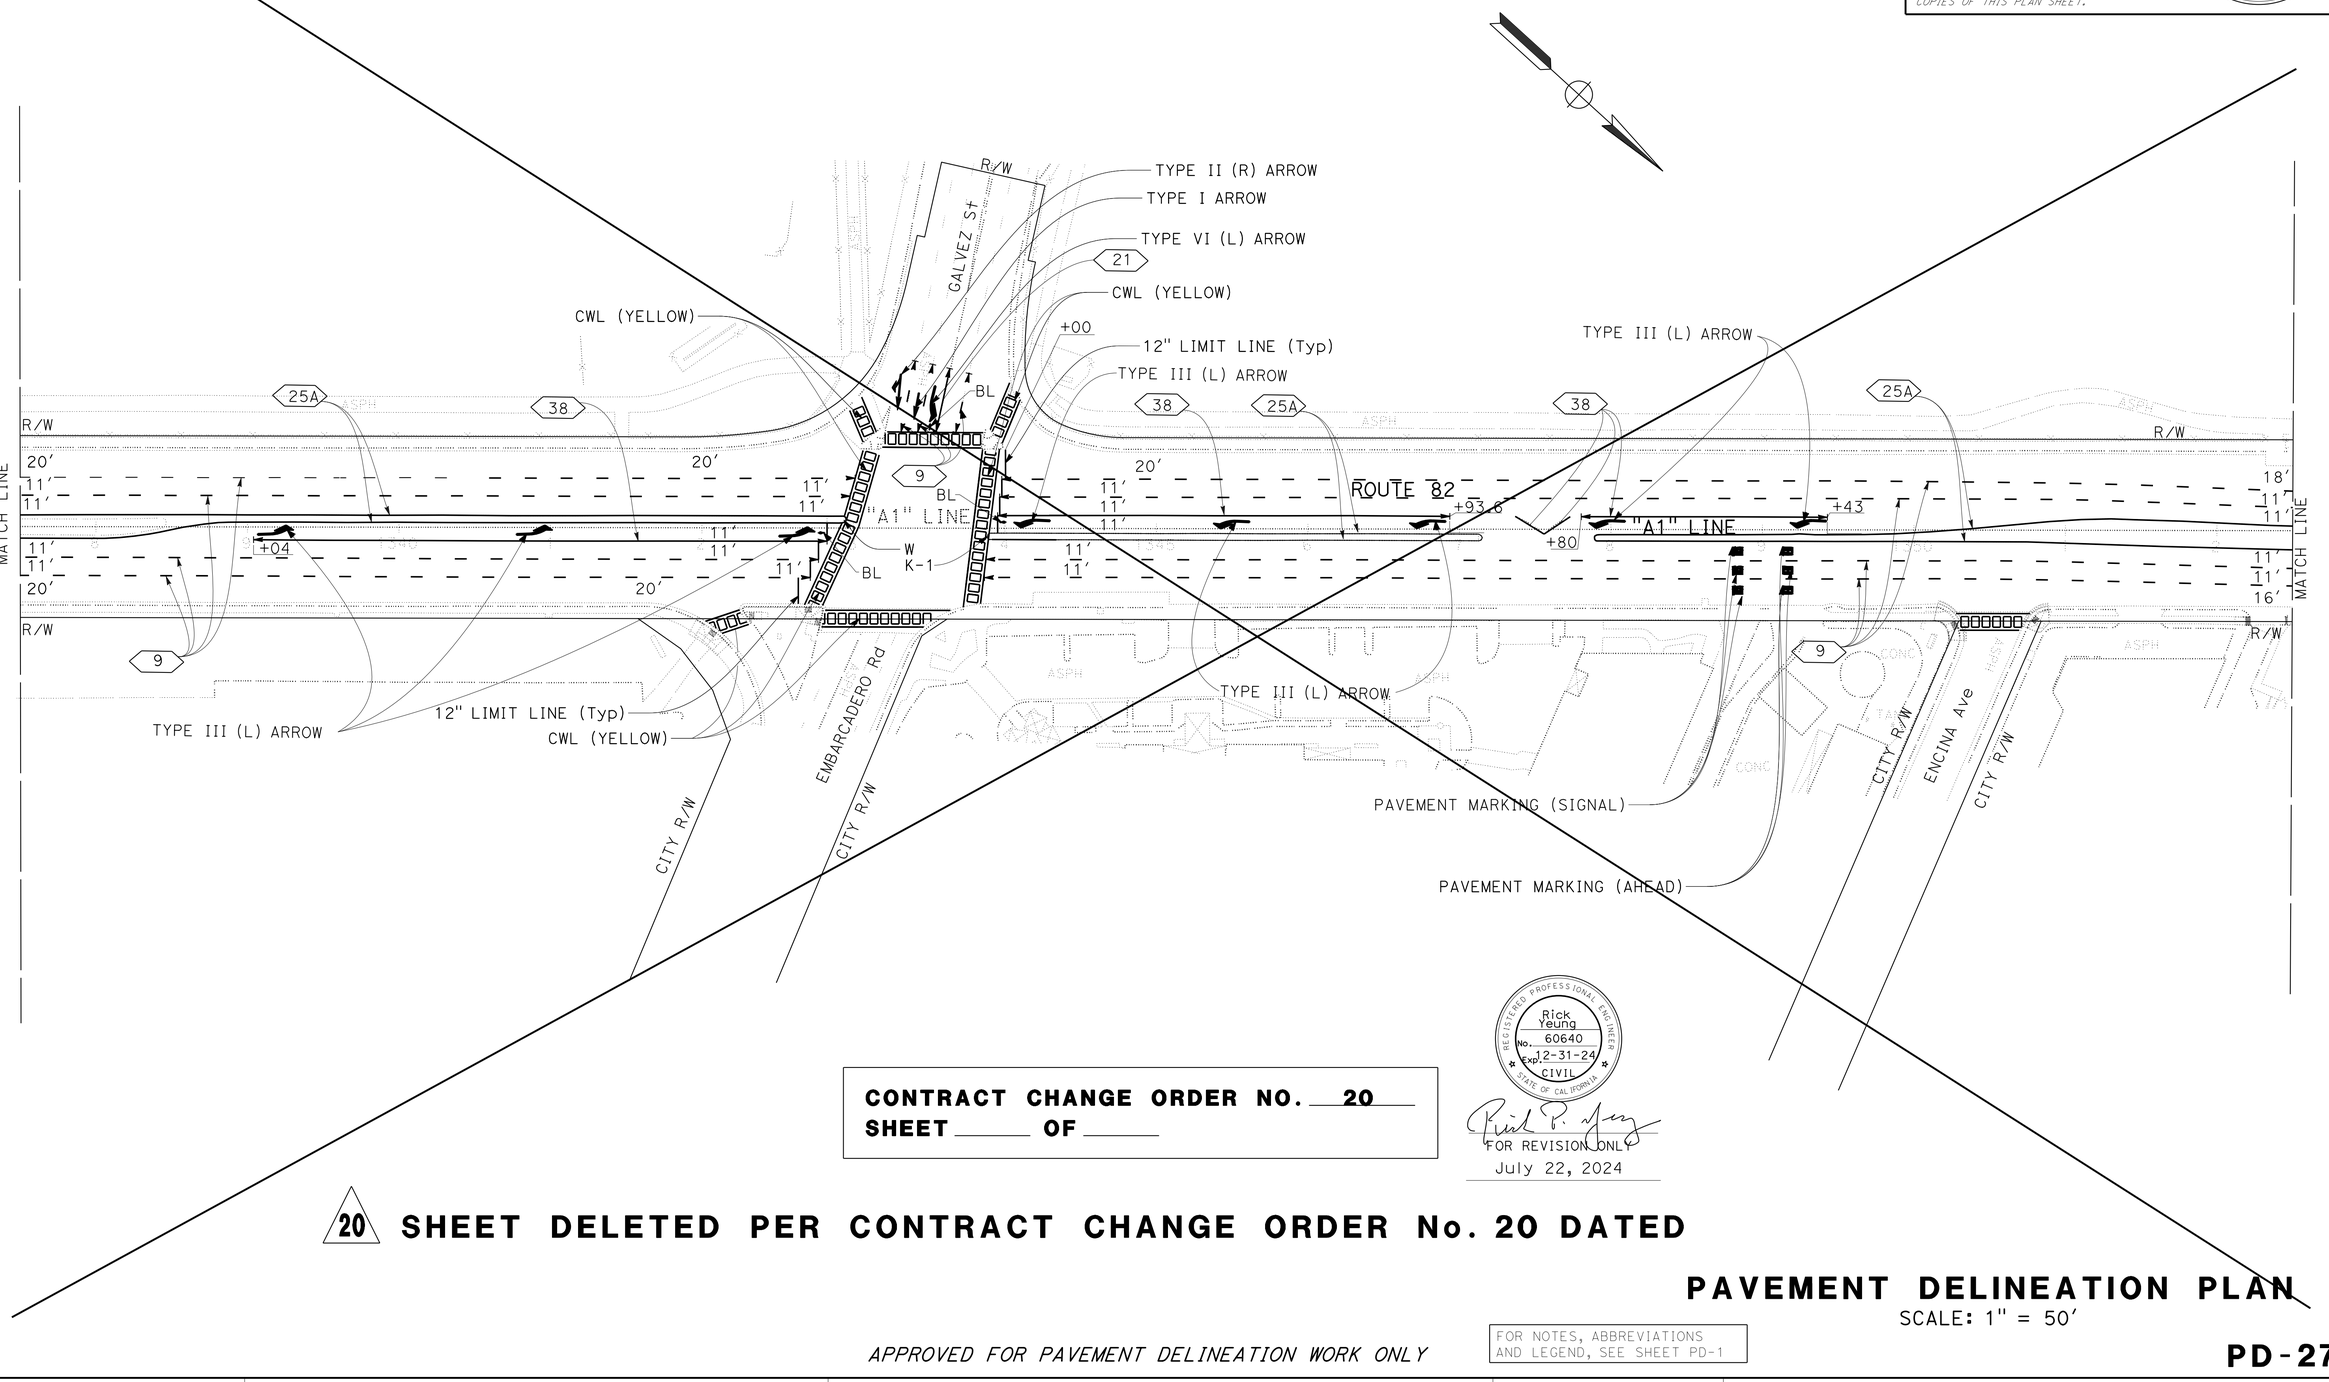

CONTRACT CHANGE ORDER NO. 20
SHEET _____ OF _____

REGISTERED PROFESSIONAL ENGINEER Rick Yeung 60640 No. Exp. 12-31-24 CIVIL STATE OF CALIFORNIA

FOR REVISION ONLY
July 22, 2024

20 **SHEET DELETED PER CONTRACT CHANGE ORDER No. 20 DATED**

PAVEMENT DELINEATION PLAN

SCALE: 1" = 50'

APPROVED FOR PAVEMENT DELINEATION WORK ONLY

FOR NOTES, ABBREVIATIONS AND LEGEND, SEE SHEET PD-1

PD-27

CALCULATED-DESIGNED BY	CHECKED BY	REVISED BY	DATE REVISED
RICK YEUNG	SON LY	SL	11-18-22

FUNCTIONAL SUPERVISOR: LESTER LEE

STATE OF CALIFORNIA - DEPARTMENT OF TRANSPORTATION
Caltrans®
TRAFFIC

LAST REVISION: DATE PLOTTED => 18-NOV-2024
TIME PLOTTED => 15:14
09-19-22

BORDER LAST REVISED 7/2/2010 | USERNAME => s129144 | DGN FILE => 0419000140na027.cco | RELATIVE BORDER SCALE IS IN INCHES 0 1 2 3 | UNIT 0712 | PROJECT NUMBER & PHASE 04190001401

NOTE:

FOR ACCURATE RIGHT OF WAY DATA, CONTACT
RIGHT OF WAY ENGINEERING AT THE DISTRICT OFFICE.

Dist	COUNTY	ROUTE	POST MILES TOTAL PROJECT	SHEET No.	TOTAL SHEETS
04	SCI	82	18.2/26.4	244	466

20


AS-AWARDED CONTRACT PLANS
THIS STAMP PLACED IN LIEU OF ORIGINAL SIGNATURE

REGISTERED CIVIL ENGINEER DATE

REGISTERED PROFESSIONAL ENGINEER No. Exp. CIVIL STATE OF CALIFORNIA

PLANS APPROVAL DATE

THE STATE OF CALIFORNIA OR ITS OFFICERS OR AGENTS SHALL NOT BE RESPONSIBLE FOR THE ACCURACY OR COMPLETENESS OF SCANNED COPIES OF THIS PLAN SHEET.

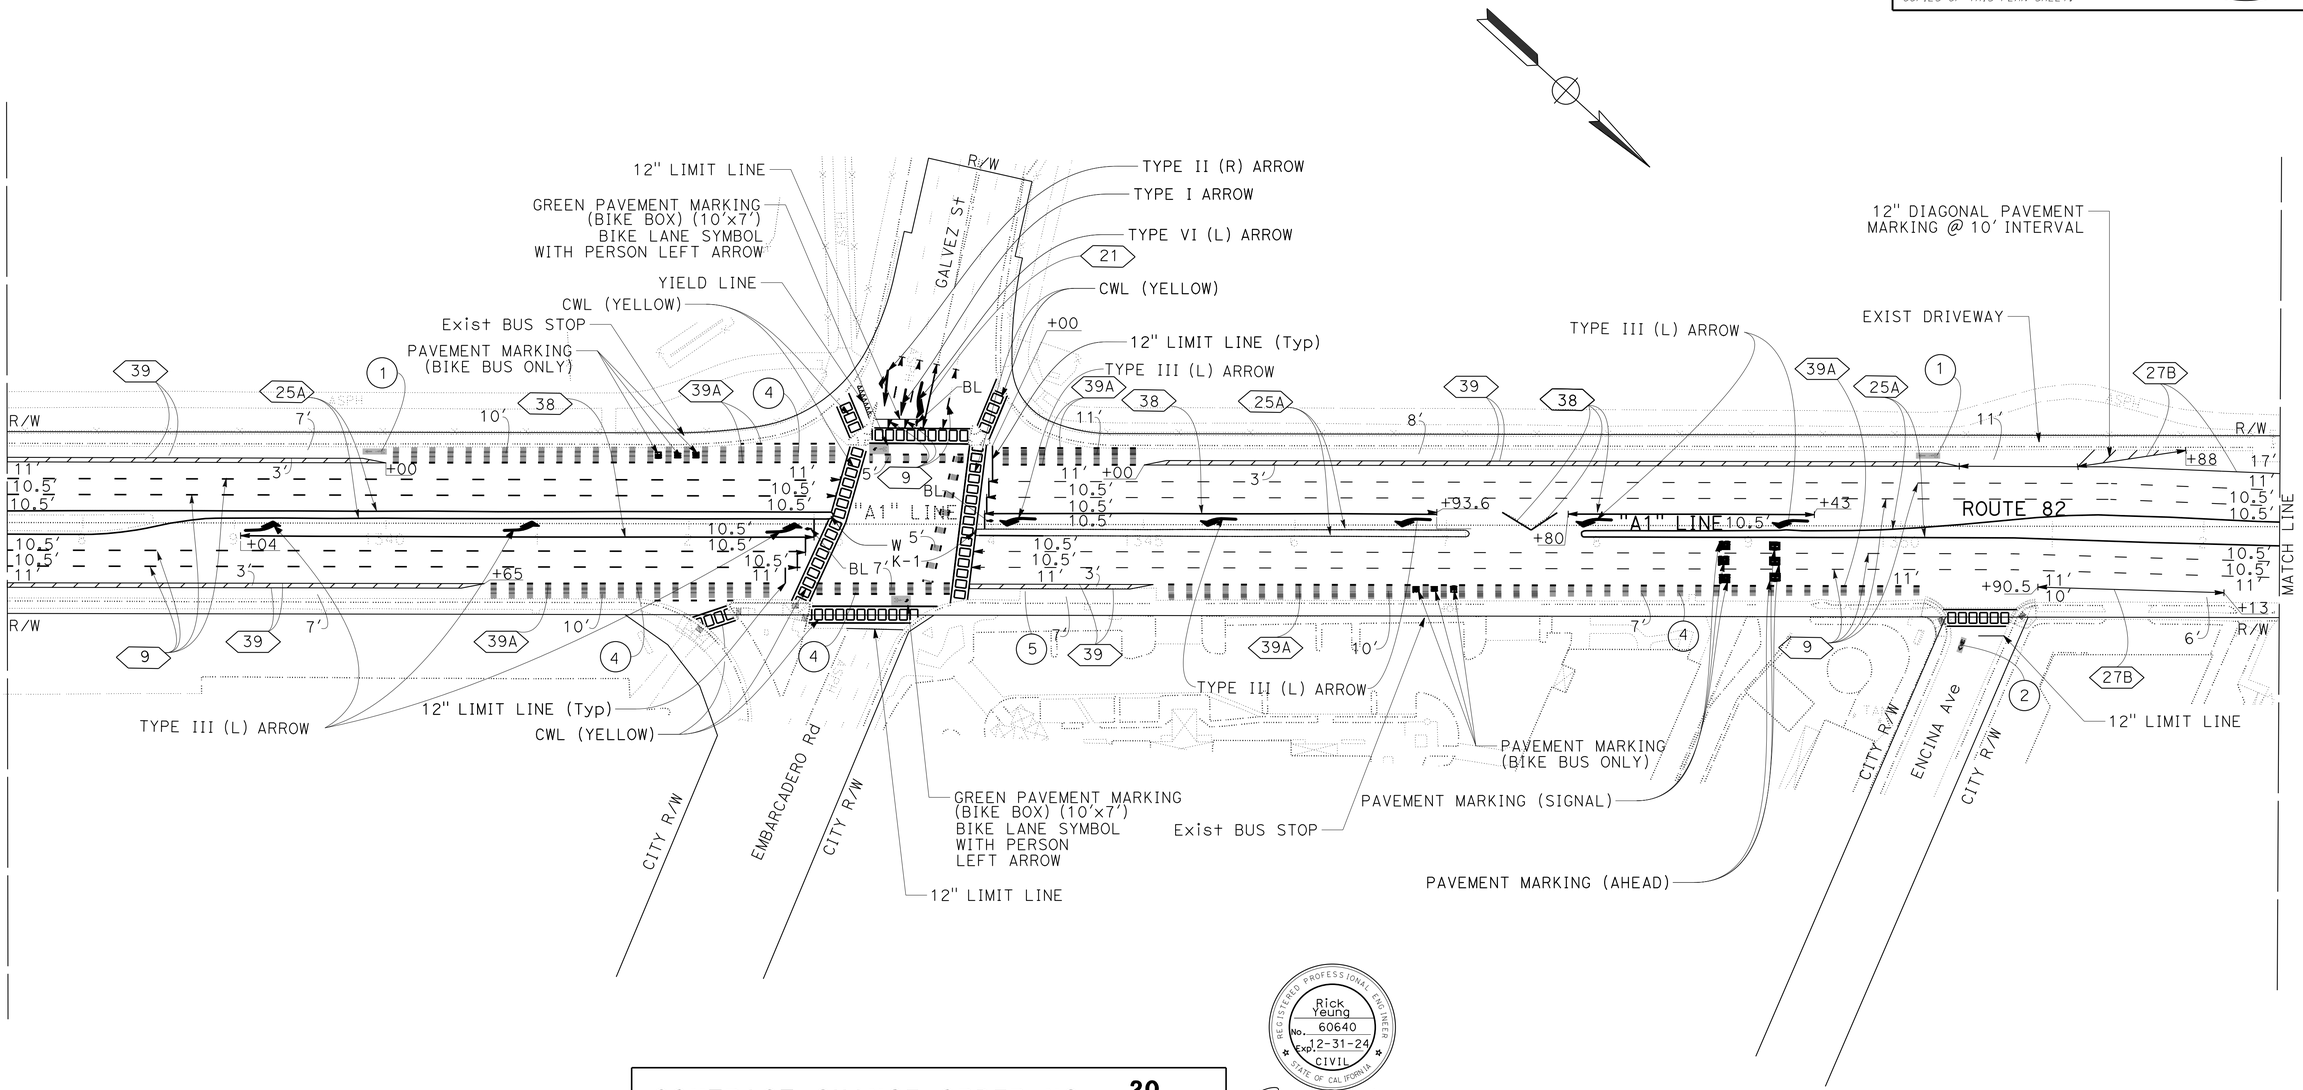

CONTRACT CHANGE ORDER NO. 20
SHEET _____ OF _____

REGISTERED PROFESSIONAL ENGINEER Rick Yeung No. 60640 Exp. 12-31-24 CIVIL STATE OF CALIFORNIA

FOR REVISION ONLY
July 22, 2024

20 REPLACED PER CONTRACT CHANGE ORDER No. 20 DATED

PAVEMENT DELINEATION PLAN

SCALE: 1" = 50'

APPROVED FOR PAVEMENT DELINEATION WORK ONLY

FOR NOTES, ABBREVIATIONS AND LEGEND, SEE SHEET PD-1

PD-27A

REVISED BY	SL	CALCULATED-DESIGNED BY	SON LY
DATE REVISED	11-18-22	CHECKED BY	RICK YEUNG
FUNCTIONAL SUPERVISOR	LESTER LEE		

STATE OF CALIFORNIA - DEPARTMENT OF TRANSPORTATION
TRAFFIC
Caltrans

LAST REVISION DATE PLOTTED => 18-NOV-2024
09-19-22 TIME PLOTTED => 15:15

BORDER LAST REVISED 7/2/2010 | USERNAME => s129144 | DGN FILE => 04190001401nda027A.cco | RELATIVE BORDER SCALE IS IN INCHES 0 1 2 3 | UNIT 0712 | PROJECT NUMBER & PHASE 04190001401

Dist	COUNTY	ROUTE	POST MILES TOTAL PROJECT	SHEET No.	TOTAL SHEETS
04	SCI	82	18.2/26.4	245	466

AS-AWARDED CONTRACT PLANS
THIS STAMP PLACED IN LIEU OF ORIGINAL SIGNATURE

REGISTERED CIVIL ENGINEER DATE


January 20, 2023
PLANS APPROVAL DATE

REGISTERED PROFESSIONAL ENGINEER — No. — Exp. — CIVIL — STATE OF CALIFORNIA

THE STATE OF CALIFORNIA OR ITS OFFICERS OR AGENTS SHALL NOT BE RESPONSIBLE FOR THE ACCURACY OR COMPLETENESS OF SCANNED COPIES OF THIS PLAN SHEET.

20

NOTE:
FOR ACCURATE RIGHT OF WAY DATA, CONTACT
RIGHT OF WAY ENGINEERING AT THE DISTRICT OFFICE.

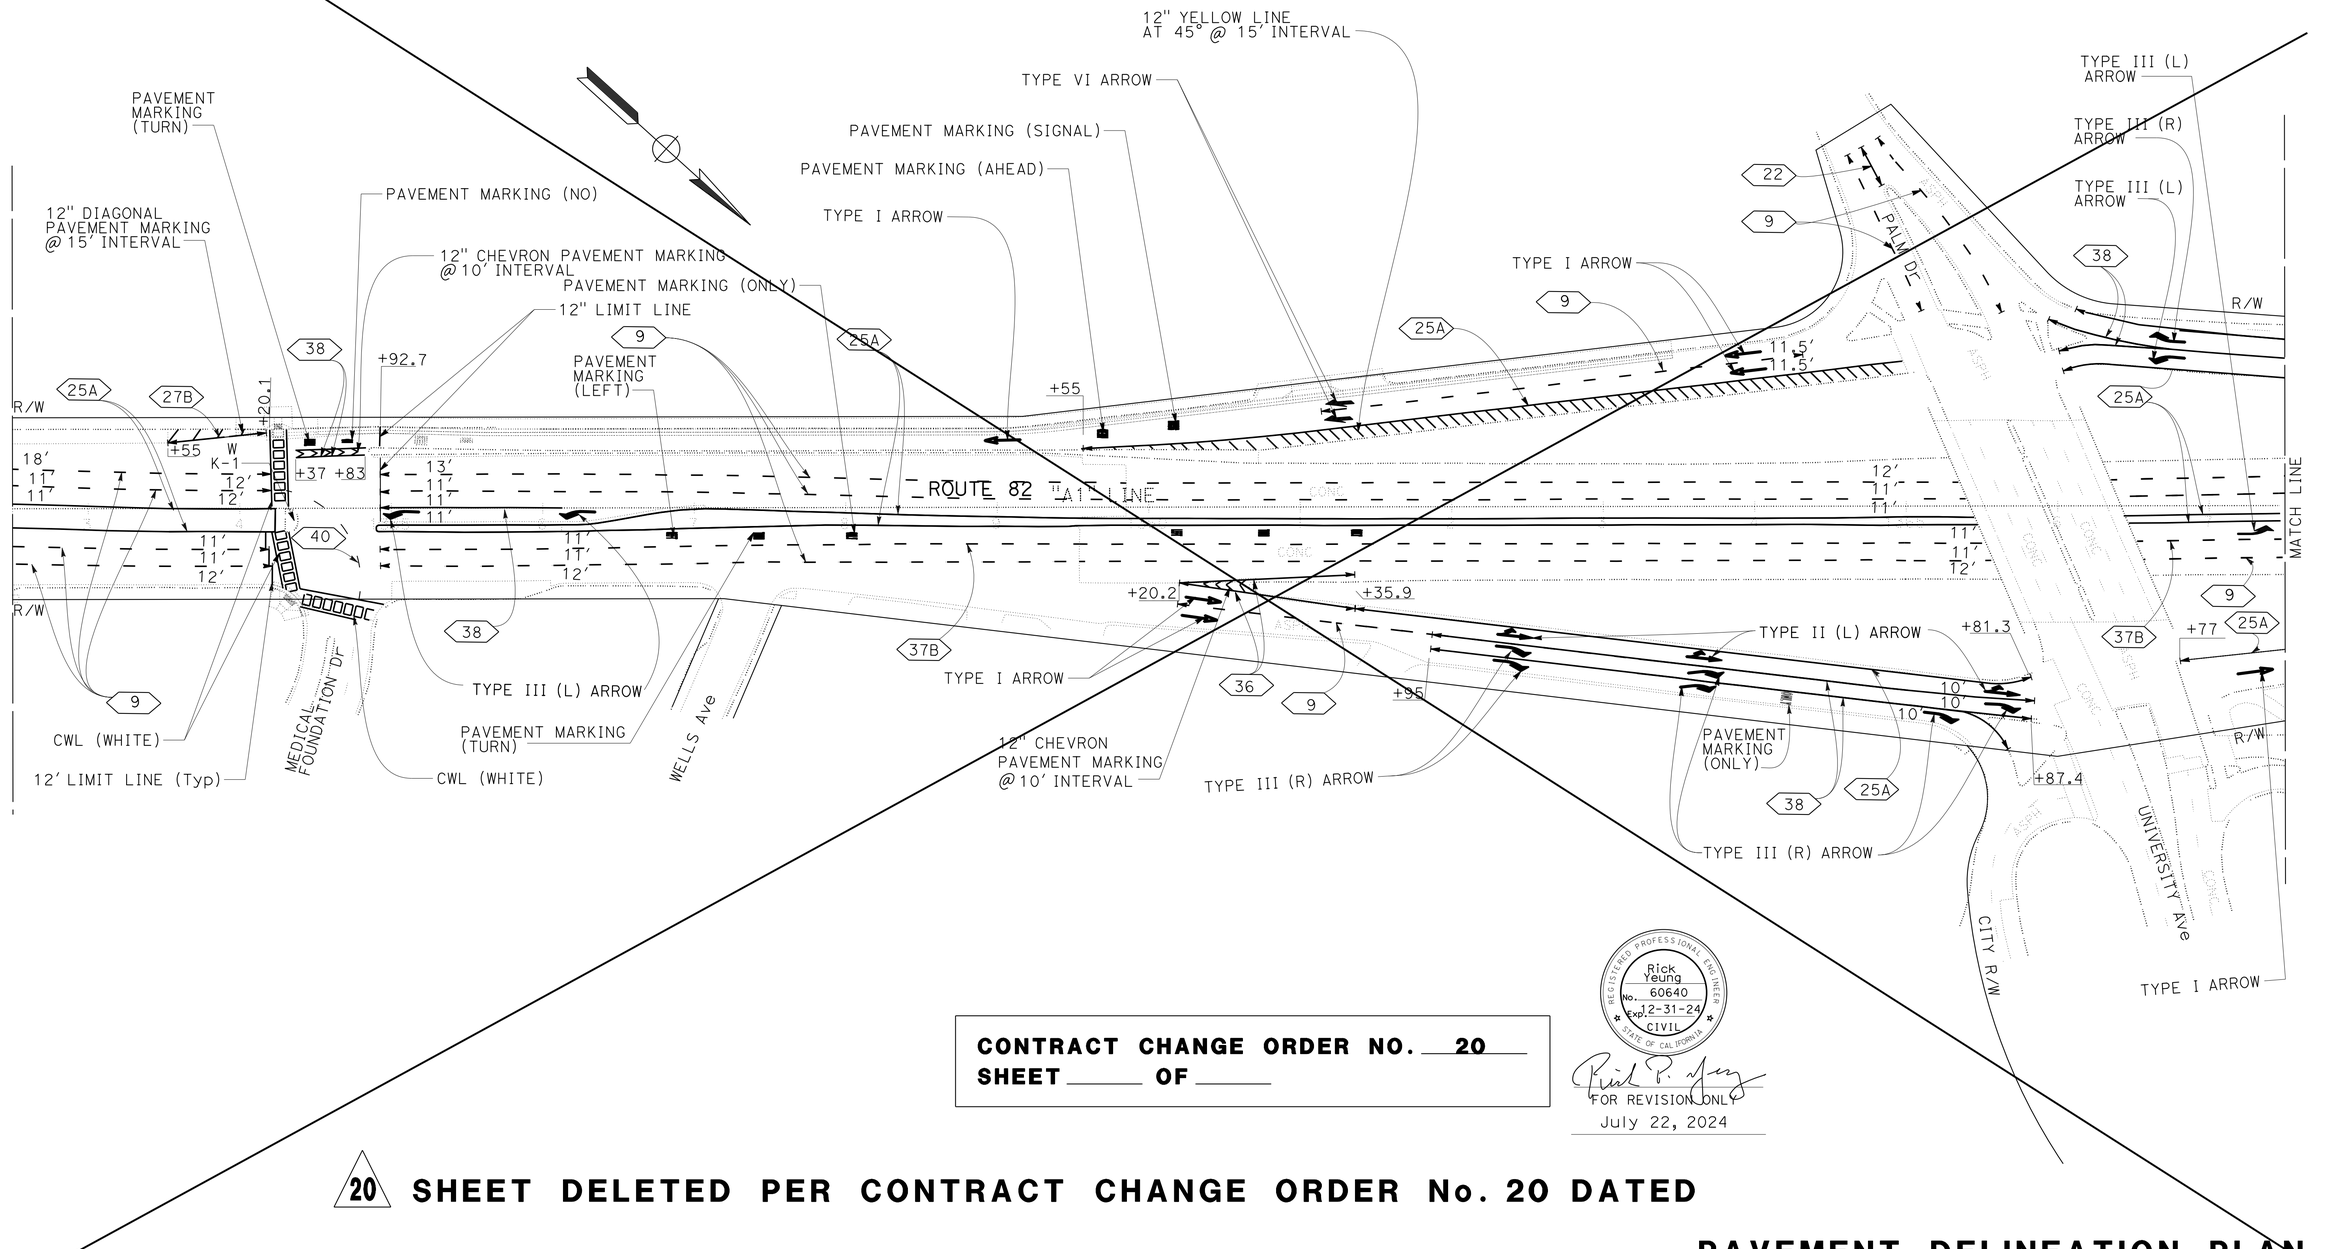

CONTRACT CHANGE ORDER NO. 20
SHEET _____ OF _____

Rick Yeung
No. 60640
Exp. 12-31-24
CIVIL
STATE OF CALIFORNIA

FOR REVISION ONLY
July 22, 2024

20 SHEET DELETED PER CONTRACT CHANGE ORDER No. 20 DATED

PAVEMENT DELINEATION PLAN

SCALE: 1" = 50'

APPROVED FOR PAVEMENT DELINEATION WORK ONLY

FOR NOTES, ABBREVIATIONS AND LEGEND, SEE SHEET PD-1

PD-28

REVISED BY	DATE REVISED
SL	11-18-22

CALCULATED-DESIGNED BY: RICK YEUNG
CHECKED BY: SON LY
FUNCTIONAL SUPERVISOR: LESTER LEE

STATE OF CALIFORNIA - DEPARTMENT OF TRANSPORTATION
Caltrans®
TRAFFIC

LAST REVISION: DATE PLOTTED => 18-NOV-2024
09-19-22 TIME PLOTTED => 15:15

BORDER LAST REVISED 7/2/2010 | USERNAME => s129144 | DGN FILE => 04190001401na028.cco | RELATIVE BORDER SCALE IS IN INCHES 0 1 2 3 | UNIT 0712 | PROJECT NUMBER & PHASE 04190001401

Dist	COUNTY	ROUTE	POST MILES TOTAL PROJECT	SHEET No.	TOTAL SHEETS
04	SCl	82	18.2/26.4	245	466

AS-AWARDED CONTRACT PLANS
THIS STAMP PLACED IN LIEU OF ORIGINAL SIGNATURE

REGISTERED CIVIL ENGINEER DATE

PLANS APPROVAL DATE


REGISTERED PROFESSIONAL ENGINEER — No. Exp. CIVIL — STATE OF CALIFORNIA

THE STATE OF CALIFORNIA OR ITS OFFICERS OR AGENTS SHALL NOT BE RESPONSIBLE FOR THE ACCURACY OR COMPLETENESS OF SCANNED COPIES OF THIS PLAN SHEET.

20

NOTE:

FOR ACCURATE RIGHT OF WAY DATA, CONTACT RIGHT OF WAY ENGINEERING AT THE DISTRICT OFFICE.

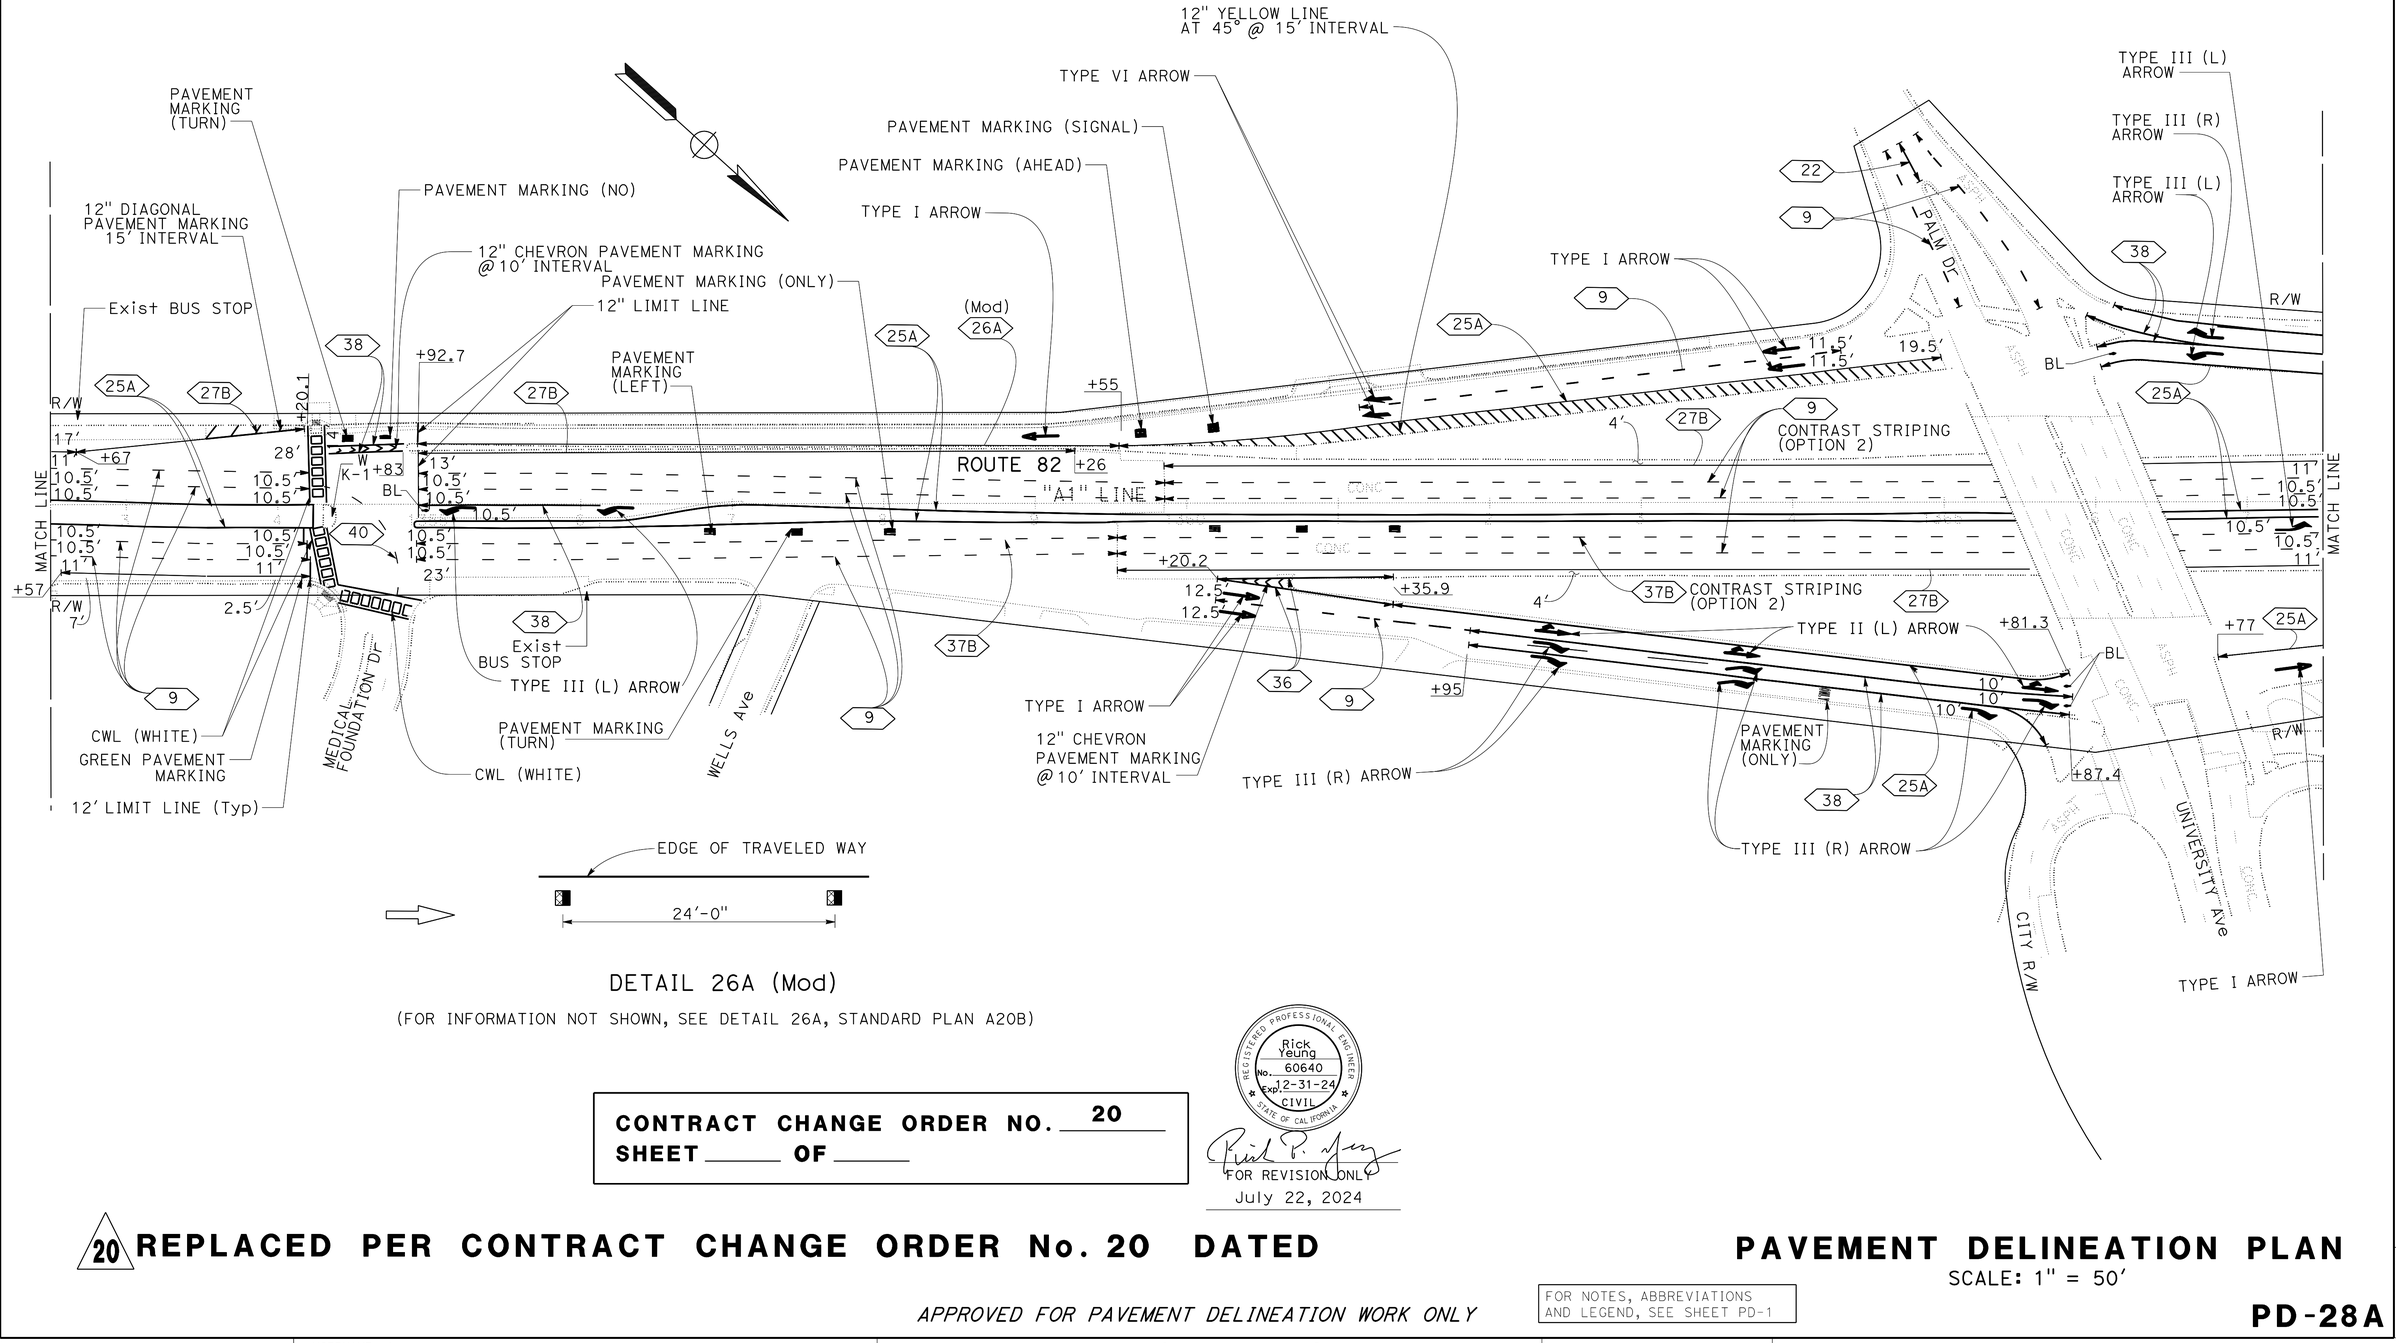

DETAIL 26A (Mod)

(FOR INFORMATION NOT SHOWN, SEE DETAIL 26A, STANDARD PLAN A20B)

CONTRACT CHANGE ORDER NO. 20
SHEET _____ OF _____

REGISTERED PROFESSIONAL ENGINEER — Rick Yeung — No. 60640 — Exp. 12-31-24 — CIVIL — STATE OF CALIFORNIA

FOR REVISION ONLY
July 22, 2024

20 REPLACED PER CONTRACT CHANGE ORDER No. 20 DATED

APPROVED FOR PAVEMENT DELINEATION WORK ONLY

PAVEMENT DELINEATION PLAN

SCALE: 1" = 50'

FOR NOTES, ABBREVIATIONS AND LEGEND, SEE SHEET PD-1

PD-28A

CALCULATED-DESIGNED BY	CHECKED BY	REVISED BY	DATE REVISED
SON LY	RICK YEUNG	SL	11-18-22

FUNCTIONAL SUPERVISOR: LESTER LEE

STATE OF CALIFORNIA - DEPARTMENT OF TRANSPORTATION — TRAFFIC

LAST REVISION: DATE PLOTTED => 18-NOV-2024 TIME PLOTTED => 15:15

BORDER LAST REVISED 7/2/2010 | USERNAME => s129144 | DGN FILE => 0419000140na028A.cco | RELATIVE BORDER SCALE IS IN INCHES 0 1 2 3 | UNIT 0712 | PROJECT NUMBER & PHASE 04190001401

NOTE:

FOR ACCURATE RIGHT OF WAY DATA, CONTACT
RIGHT OF WAY ENGINEERING AT THE DISTRICT OFFICE.

Dist	COUNTY	ROUTE	POST MILES TOTAL PROJECT	SHEET No.	TOTAL SHEETS
04	SCI	82	18.2/26.4	246	466

20


AS-AWARDED CONTRACT PLANS
THIS STAMP PLACED IN LIEU OF ORIGINAL SIGNATURE

REGISTERED CIVIL ENGINEER DATE

January 20, 2023
PLANS APPROVAL DATE

REGISTERED PROFESSIONAL ENGINEER — No. — Exp. — CIVIL — STATE OF CALIFORNIA

THE STATE OF CALIFORNIA OR ITS OFFICERS OR AGENTS SHALL NOT BE RESPONSIBLE FOR THE ACCURACY OR COMPLETENESS OF SCANNED COPIES OF THIS PLAN SHEET.

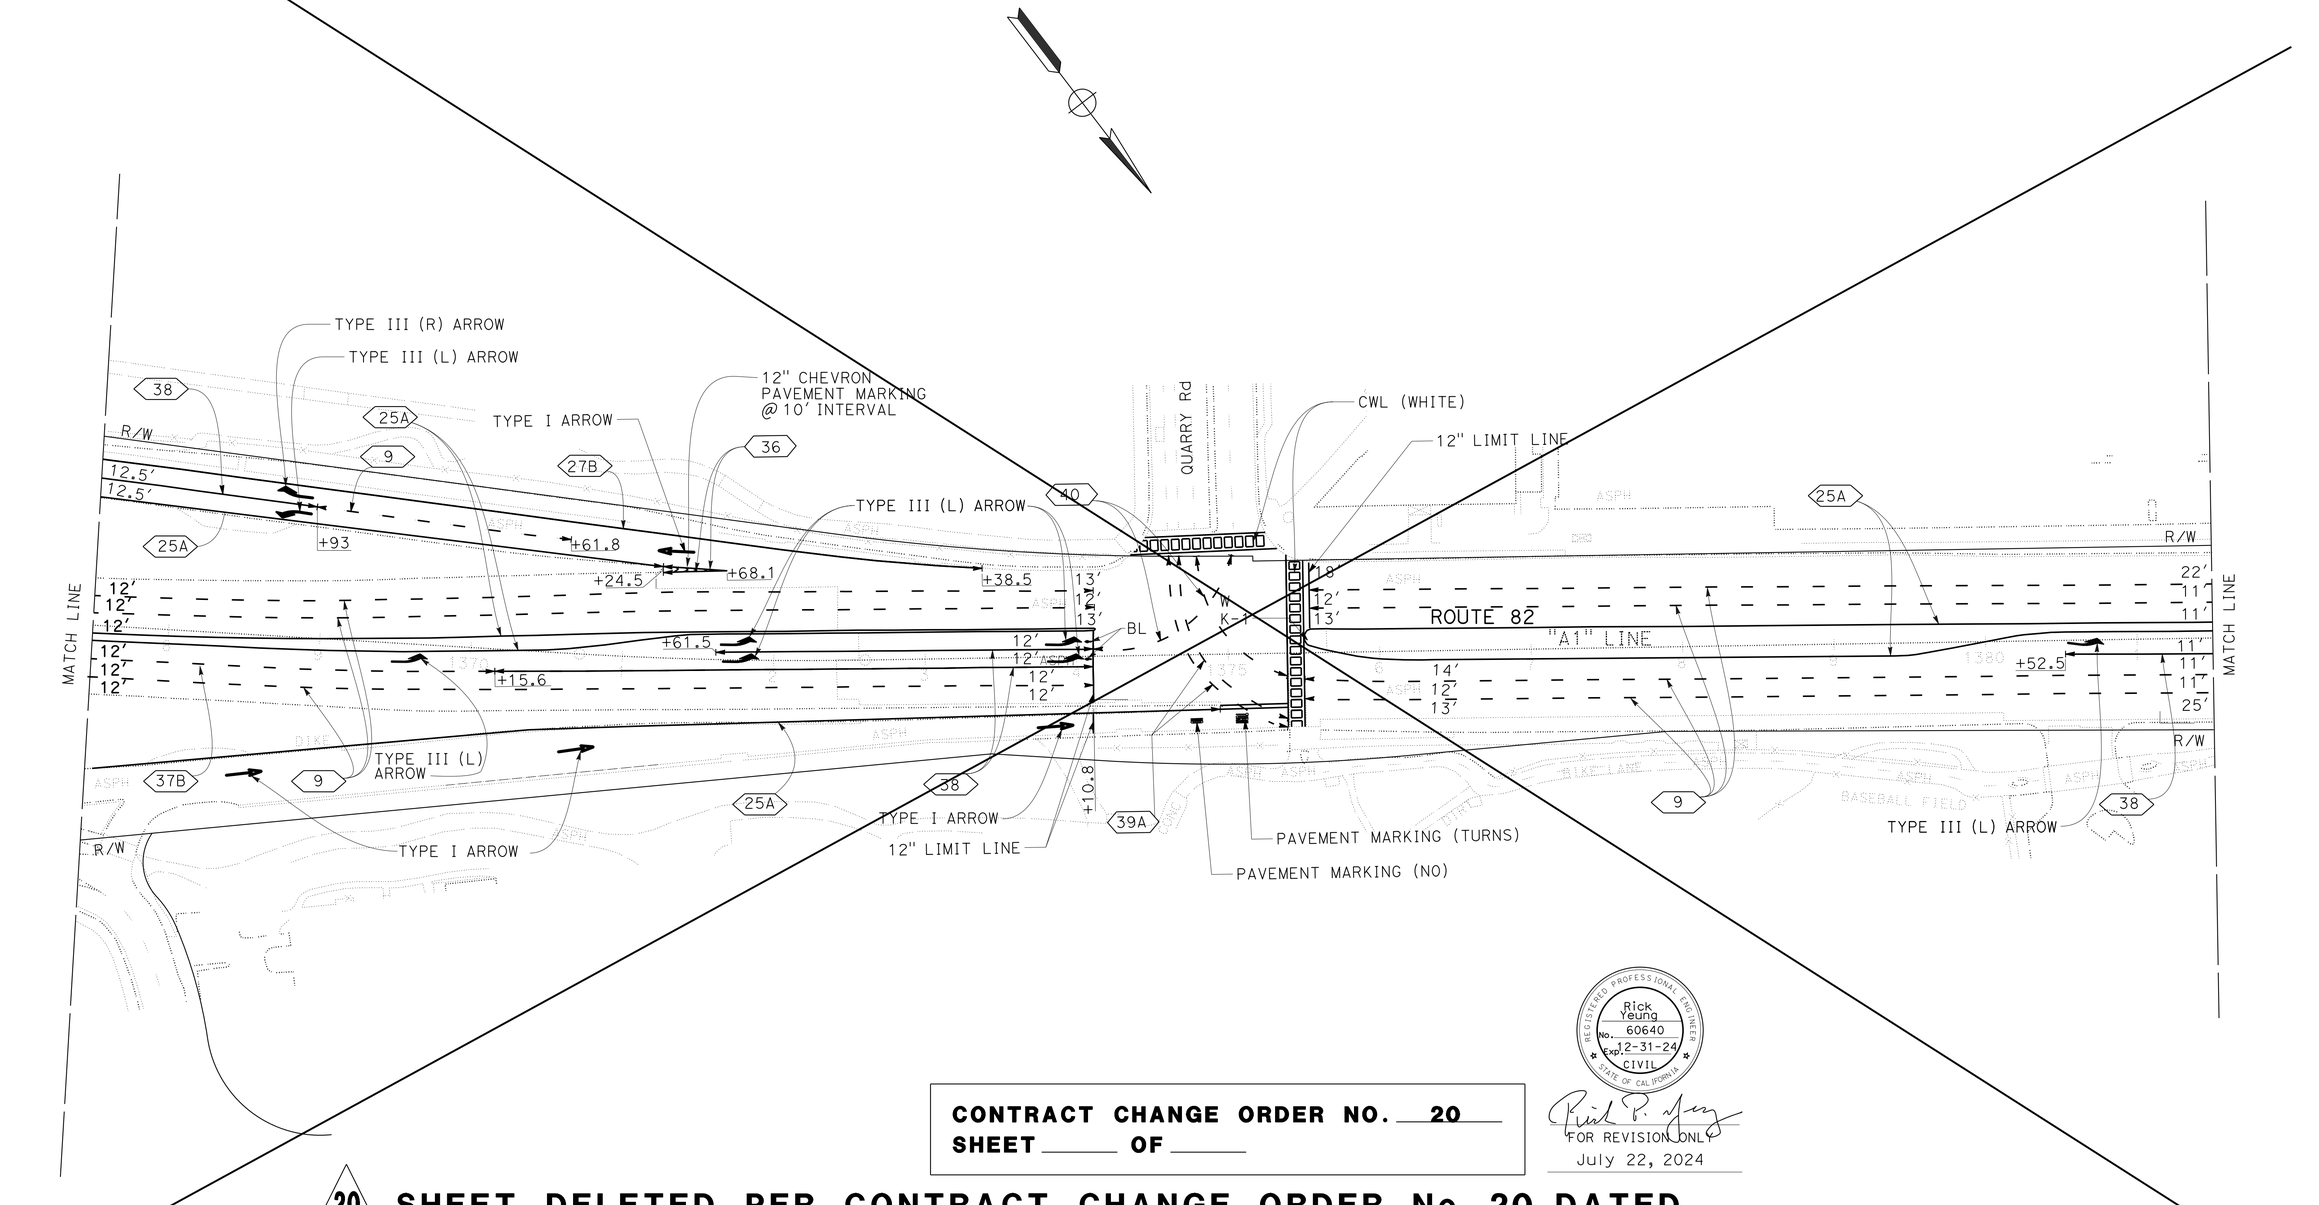

Rick Yeung
No. 60640
Exp. 12-31-24
CIVIL
REGISTERED PROFESSIONAL ENGINEER — STATE OF CALIFORNIA

FOR REVISION ONLY
July 22, 2024

CONTRACT CHANGE ORDER NO. 20
SHEET _____ OF _____

20 **SHEET DELETED PER CONTRACT CHANGE ORDER No. 20 DATED**

PAVEMENT DELINEATION PLAN

SCALE: 1" = 50'

APPROVED FOR PAVEMENT DELINEATION WORK ONLY

FOR NOTES, ABBREVIATIONS AND LEGEND, SEE SHEET PD-1

PD-29

STATE OF CALIFORNIA - DEPARTMENT OF TRANSPORTATION
Caltrans® TRAFFIC

CALCULATED-DESIGNED BY	CHECKED BY	REVISED BY	DATE REVISED	FUNCTIONAL SUPERVISOR
RICK YEUNG	SON LY	SL	11-18-22	LESTER LEE

LAST REVISION: DATE PLOTTED => 18-NOV-2024
09-19-22 TIME PLOTTED => 15:15

BORDER LAST REVISED 7/2/2010 | USERNAME => s129144 | DGN FILE => 0419000140na029.cco | RELATIVE BORDER SCALE IS IN INCHES 0 1 2 3 | UNIT 0712 | PROJECT NUMBER & PHASE 04190001401

NOTE:

FOR ACCURATE RIGHT OF WAY DATA, CONTACT
RIGHT OF WAY ENGINEERING AT THE DISTRICT OFFICE.

Dist	COUNTY	ROUTE	POST MILES TOTAL PROJECT	SHEET No.	TOTAL SHEETS
04	SCI	82	18.2/26.4	246	466

20


AS-AWARDED CONTRACT PLANS
THIS STAMP PLACED IN LIEU OF ORIGINAL SIGNATURE

REGISTERED CIVIL ENGINEER DATE

PLANS APPROVAL DATE

REGISTERED PROFESSIONAL ENGINEER
No.
Exp.
CIVIL
STATE OF CALIFORNIA

THE STATE OF CALIFORNIA OR ITS OFFICERS OR AGENTS SHALL NOT BE RESPONSIBLE FOR THE ACCURACY OR COMPLETENESS OF SCANNED COPIES OF THIS PLAN SHEET.

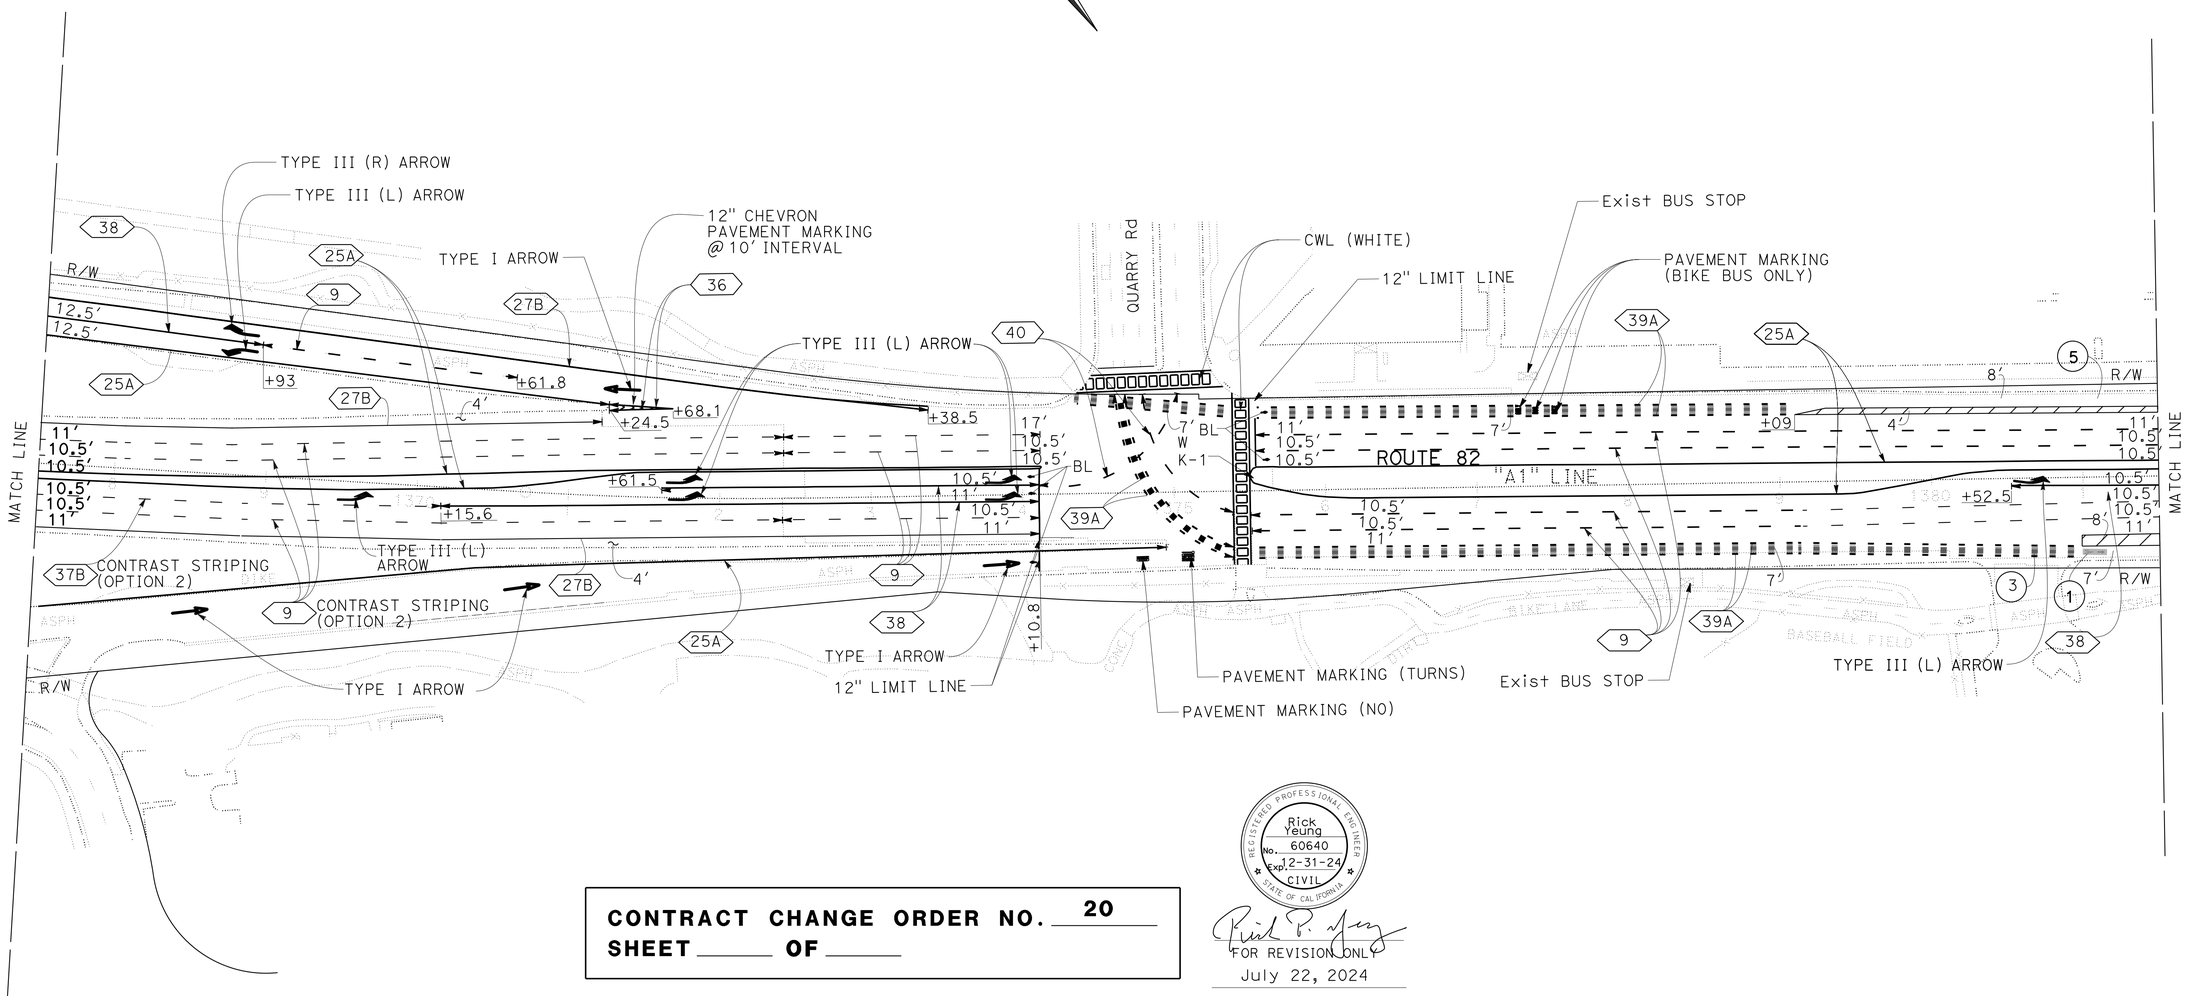

CONTRACT CHANGE ORDER NO. 20
SHEET _____ OF _____

REGISTERED PROFESSIONAL ENGINEER
Rick Yeung
No. 60640
Exp. 12-31-24
CIVIL
STATE OF CALIFORNIA

FOR REVISION ONLY
July 22, 2024

20 REPLACED PER CONTRACT CHANGE ORDER No. 20 DATED July 22, 2024

PAVEMENT DELINEATION PLAN

SCALE: 1" = 50'

APPROVED FOR PAVEMENT DELINEATION WORK ONLY

FOR NOTES, ABBREVIATIONS AND LEGEND, SEE SHEET PD-1

PD-29A

REVISED BY	DATE REVISED
SL	11-18-22

CALCULATED-DESIGNED BY
SON LY

CHECKED BY
RICK YEUNG

FUNCTIONAL SUPERVISOR
LESTER LEE

STATE OF CALIFORNIA - DEPARTMENT OF TRANSPORTATION
TRAFFIC

Caltrans

LAST REVISION
DATE PLOTTED => 18-NOV-2024
TIME PLOTTED => 15:15

BORDER LAST REVISED 7/2/2010

USERNAME => s129144
DGN FILE => 04190001401ng029A.cco

RELATIVE BORDER SCALE IS IN INCHES 0 1 2 3

UNIT 0712

PROJECT NUMBER & PHASE 04190001401

Dist	COUNTY	ROUTE	POST MILES TOTAL PROJECT	SHEET No.	TOTAL SHEETS
04	SCI	82	18.2/26.4	247	466

20

AS-AWARDED CONTRACT PLANS
THIS STAMP PLACED IN LIEU OF ORIGINAL SIGNATURE

REGISTERED CIVIL ENGINEER DATE


January 20, 2023
PLANS APPROVAL DATE

REGISTERED PROFESSIONAL ENGINEER — No. Exp. CIVIL — STATE OF CALIFORNIA

THE STATE OF CALIFORNIA OR ITS OFFICERS OR AGENTS SHALL NOT BE RESPONSIBLE FOR THE ACCURACY OR COMPLETENESS OF SCANNED COPIES OF THIS PLAN SHEET.

NOTE:

FOR ACCURATE RIGHT OF WAY DATA, CONTACT
RIGHT OF WAY ENGINEERING AT THE DISTRICT OFFICE.

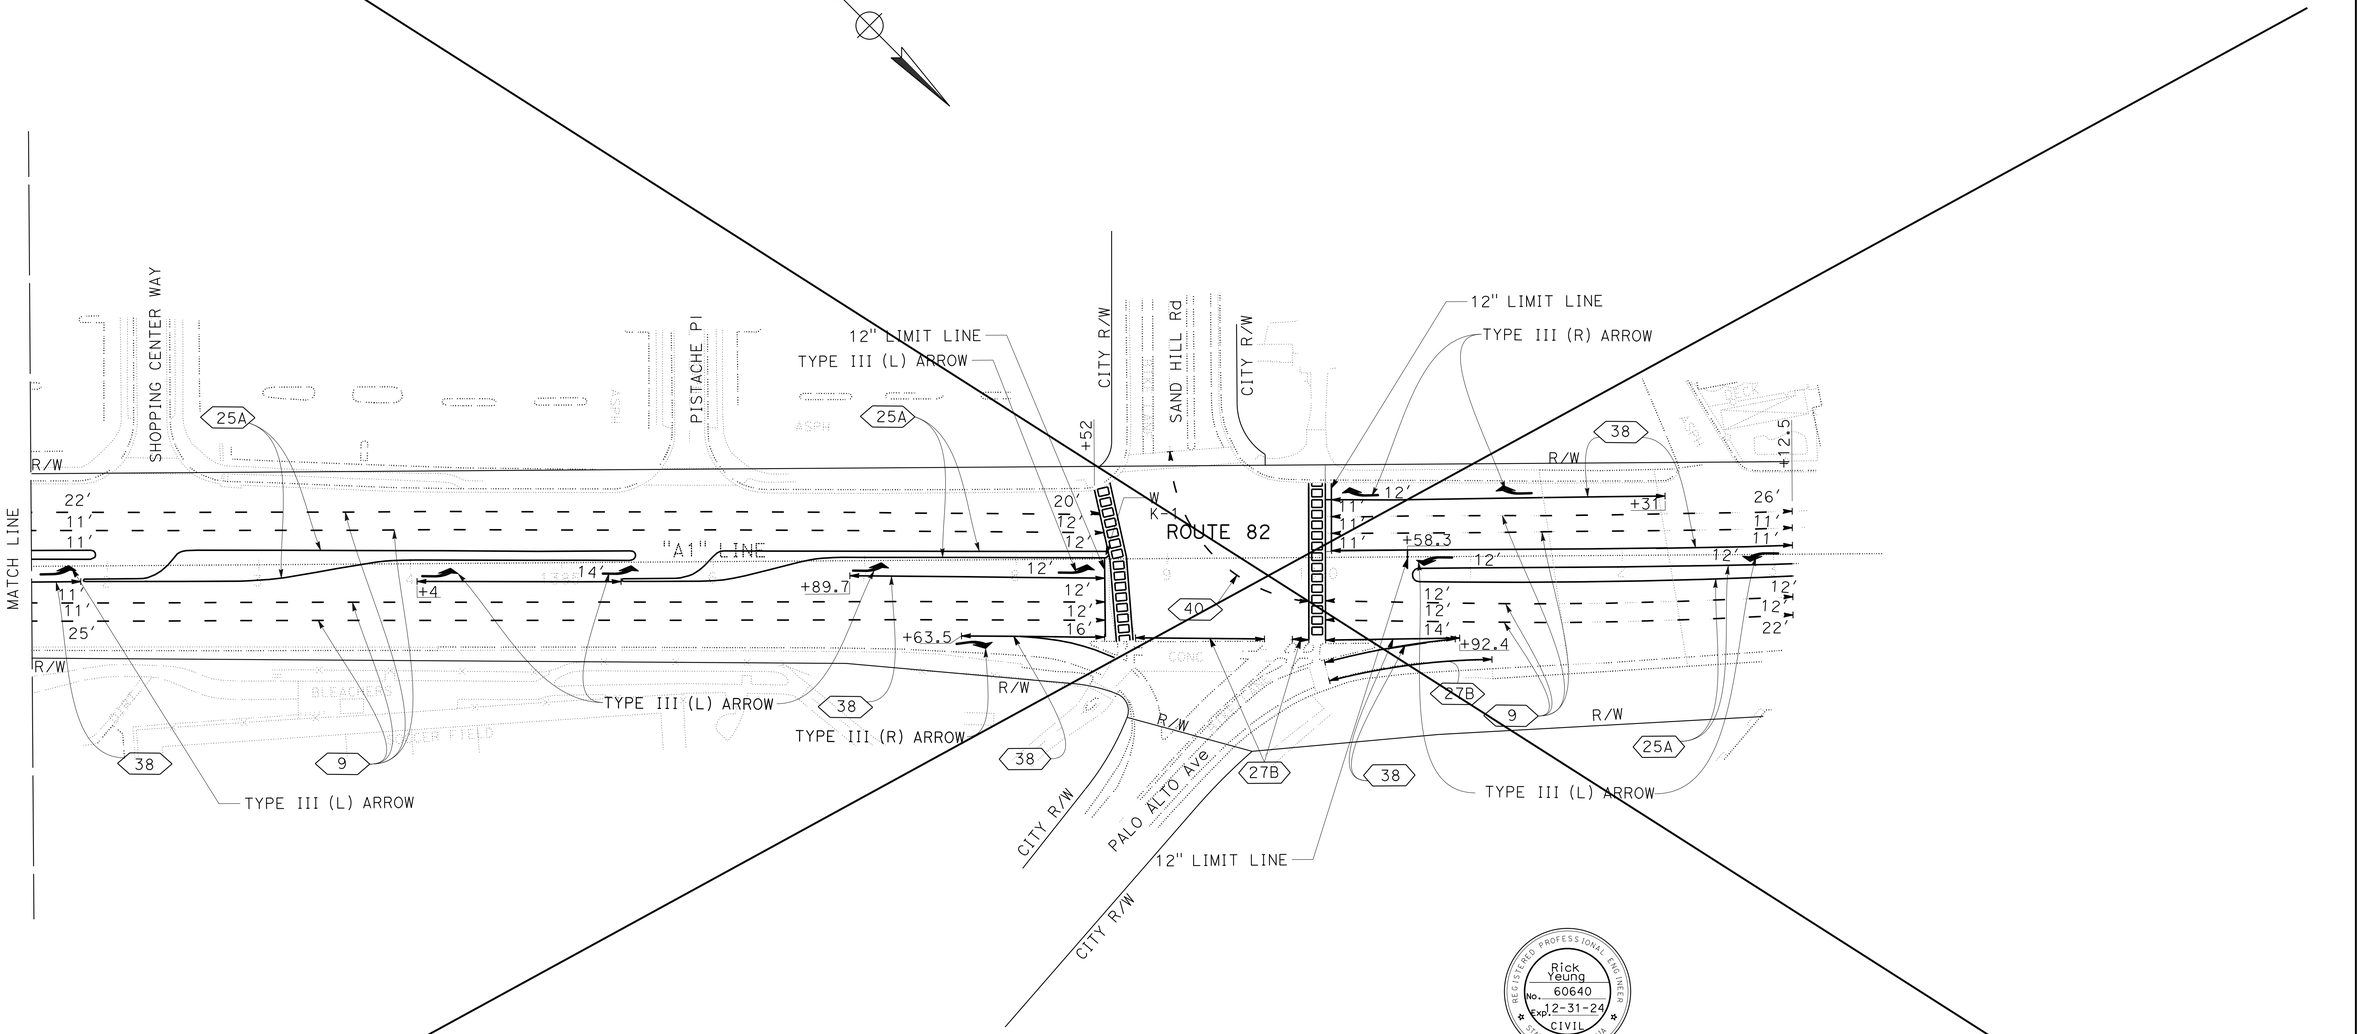

CONTRACT CHANGE ORDER NO. 20
SHEET _____ OF _____

REGISTERED PROFESSIONAL ENGINEER — Rick Yeung — No. 60640 — Exp. 2-31-24 — CIVIL — STATE OF CALIFORNIA

FOR REVISION ONLY
July 22, 2024

20 **SHEET DELETED PER CONTRACT CHANGE ORDER No. 20 DATED**

PAVEMENT DELINEATION PLAN

SCALE: 1" = 50′

APPROVED FOR PAVEMENT DELINEATION WORK ONLY

FOR NOTES, ABBREVIATIONS AND LEGEND, SEE SHEET PD-1

PD-30

CALCULATED-DESIGNED BY	CHECKED BY	REVISED BY	DATE REVISED
RICK YEUNG	SON LY	SL	11-18-22

FUNCTIONAL SUPERVISOR: LESTER LEE

STATE OF CALIFORNIA - DEPARTMENT OF TRANSPORTATION
Caltrans®
TRAFFIC

LAST REVISION DATE PLOTTED => 18-NOV-2024
TIME PLOTTED => 15:15
01-12-23

BORDER LAST REVISED 7/2/2010 | USERNAME => s129144 | DGN FILE => 0419000140na030.cco | RELATIVE BORDER SCALE IS IN INCHES 0 1 2 3 | UNIT 0712 | PROJECT NUMBER & PHASE 04190001401

Dist	COUNTY	ROUTE	POST MILES TOTAL PROJECT	SHEET No.	TOTAL SHEETS
04	SCI	82	18.2/26.4	247	466

AS-AWARDED CONTRACT PLANS
THIS STAMP PLACED IN LIEU OF ORIGINAL SIGNATURE

REGISTERED CIVIL ENGINEER DATE

PLANS APPROVAL DATE


REGISTERED PROFESSIONAL ENGINEER — No. Exp. CIVIL — STATE OF CALIFORNIA

THE STATE OF CALIFORNIA OR ITS OFFICERS OR AGENTS SHALL NOT BE RESPONSIBLE FOR THE ACCURACY OR COMPLETENESS OF SCANNED COPIES OF THIS PLAN SHEET.

20

NOTE:

FOR ACCURATE RIGHT OF WAY DATA, CONTACT
RIGHT OF WAY ENGINEERING AT THE DISTRICT OFFICE.

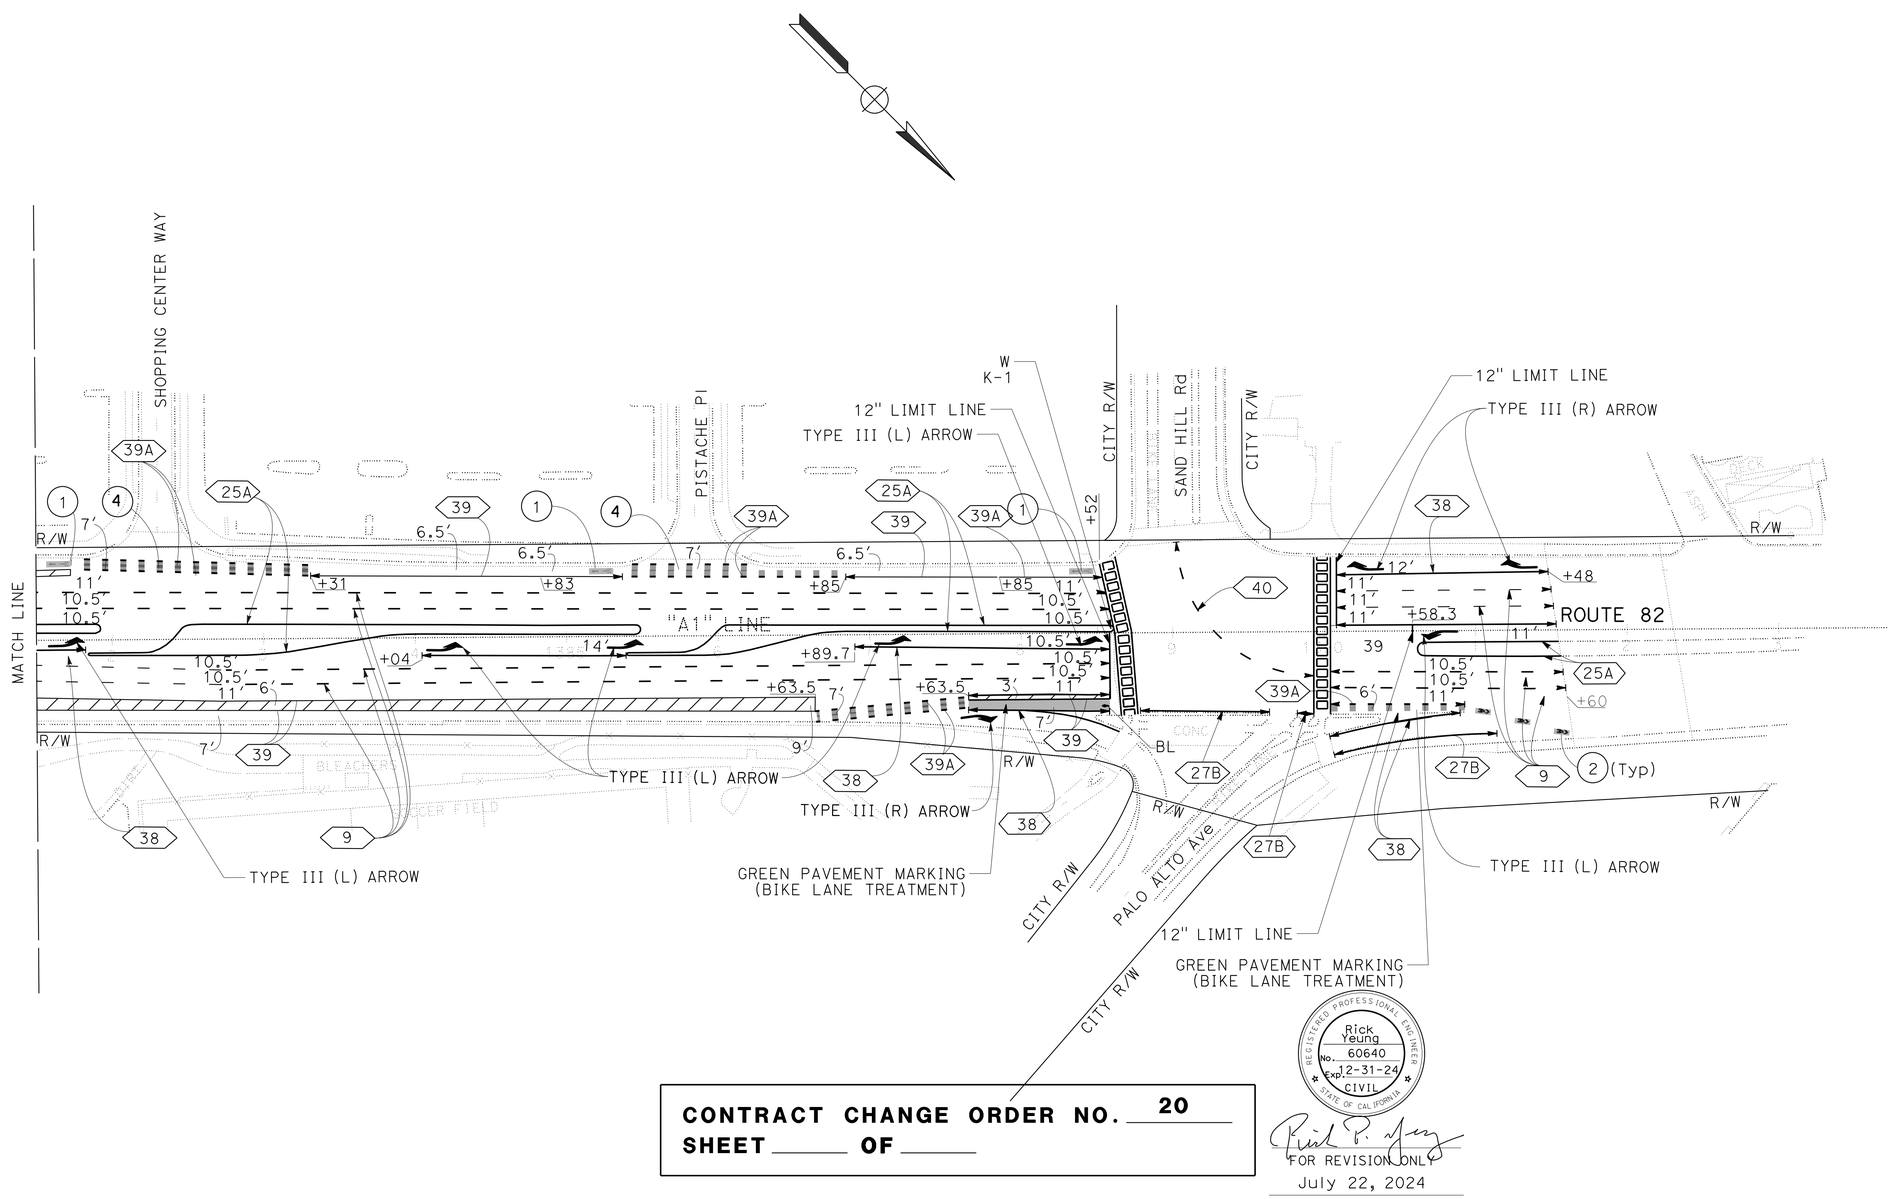

CONTRACT CHANGE ORDER NO. 20
SHEET _____ OF _____

REGISTERED PROFESSIONAL ENGINEER — Rick Yeung — No. 60640 — Exp. 12-31-24 — CIVIL — STATE OF CALIFORNIA

FOR REVISION ONLY
July 22, 2024

20 **REPLACED PER CONTRACT CHANGE ORDER No. 20 DATED**

PAVEMENT DELINEATION PLAN

SCALE: 1" = 50'

APPROVED FOR PAVEMENT DELINEATION WORK ONLY

FOR NOTES, ABBREVIATIONS AND LEGEND, SEE SHEET PD-1

PD-30A

LAST REVISION: DATE PLOTTED => 18-NOV-2024 TIME PLOTTED => 15:15
01-12-23

STATE OF CALIFORNIA - DEPARTMENT OF TRANSPORTATION
Caltrans®
TRAFFIC

CALCULATED-DESIGNED BY	CHECKED BY	REVISED BY	DATE REVISED
SON LY	RICK YEUNG	SL	11-18-22

FUNCTIONAL SUPERVISOR: LESTER LEE

BORDER LAST REVISED 7/2/2010 | USERNAME => s129144 | DGN FILE => 0419000140na030A.cco | RELATIVE BORDER SCALE IS IN INCHES 0 1 2 3 | UNIT 0712 | PROJECT NUMBER & PHASE 04190001401

Dist	COUNTY	ROUTE	POST MILES TOTAL PROJECT	SHEET No.	TOTAL SHEETS
04	SCI	82	18.2/26.4	248	466

AS-AWARDED CONTRACT PLANS
THIS STAMP PLACED IN LIEU OF ORIGINAL SIGNATURE

REGISTERED CIVIL ENGINEER DATE


PLANS APPROVAL DATE

THE STATE OF CALIFORNIA OR ITS OFFICERS OR AGENTS SHALL NOT BE RESPONSIBLE FOR THE ACCURACY OR COMPLETENESS OF SCANNED COPIES OF THIS PLAN SHEET.


REGISTERED PROFESSIONAL ENGINEER — Rick Yeung — No. 60640 — Exp. 12-31-24 — CIVIL — STATE OF CALIFORNIA

FOR REVISION ONLY
July 22, 2024


20

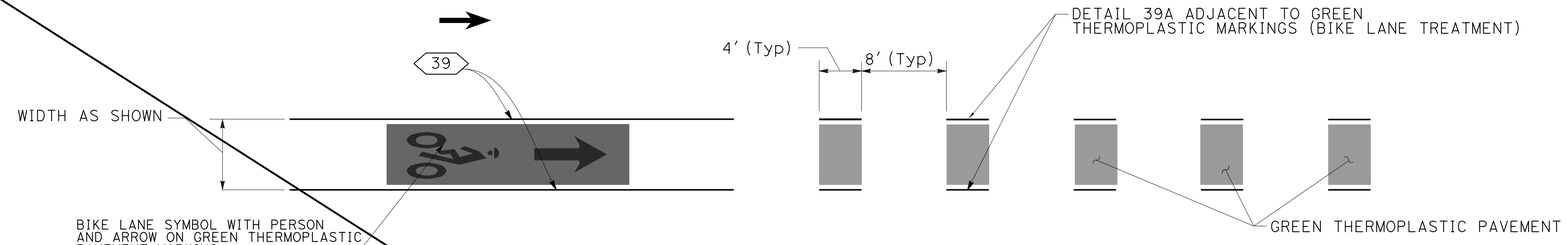


DETAIL A
DASHED BIKE LANE MARKINGS THROUGH CONFLICT ZONES/INTERSECTION

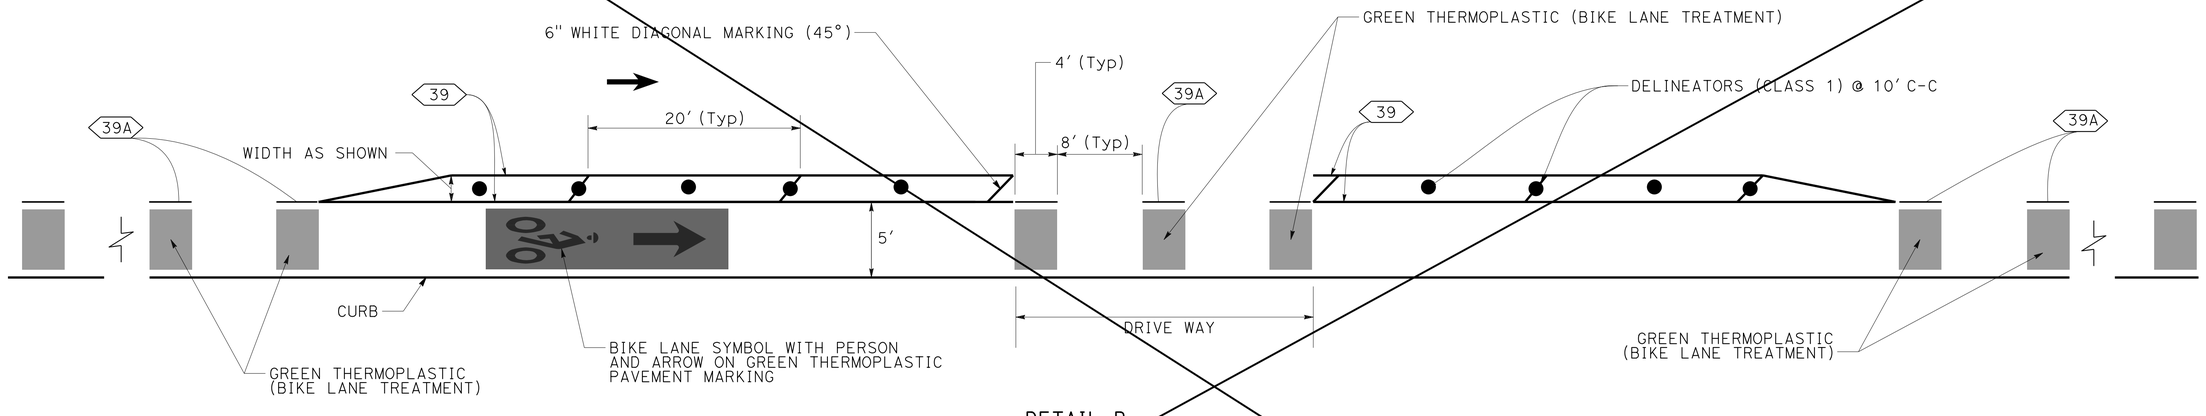

DETAIL B
BUFFER BETWEEN BIKE LANE AND ADJACENT TRAVEL LANE

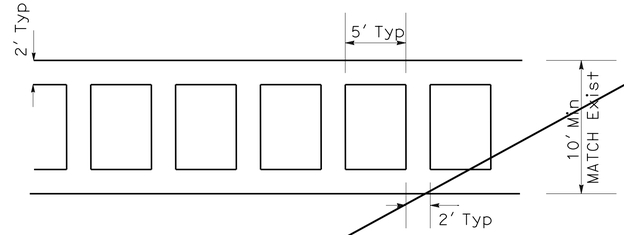

CROSSWALK MARKINGS (LADDER)

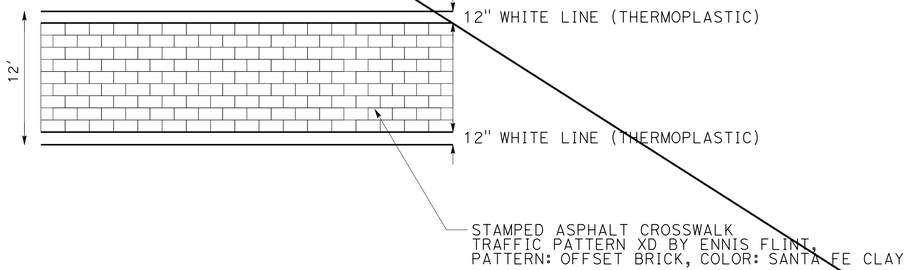

CONTRACT CHANGE ORDER NO. 20
SHEET _____ OF _____

STAMPED ASPHALT CROSSWALK (AT STANFORD Ave AND ROUTE 82)

20 **SHEET DELETED PER CONTRACT CHANGE ORDER No. 20 DATED**

PAVEMENT DELINEATION DETAILS
NO SCALE

PDD-1

REVISED BY	DATE REVISED
SL	11-18-22

CALCULATED-DESIGNED BY: RICK YEUNG
CHECKED BY: SON LY
FUNCTIONAL SUPERVISOR: LESTER LEE

STATE OF CALIFORNIA - DEPARTMENT OF TRANSPORTATION
Caltrans®
TRAFFIC

LAST REVISION DATE PLOTTED => 18-NOV-2024
11-28-22 TIME PLOTTED => 15:16

BORDER LAST REVISED 7/2/2010 | USERNAME => s129144 | DGN FILE => 0419000140nb001.cco | RELATIVE BORDER SCALE IS IN INCHES 0 1 2 3 | UNIT 0712 | PROJECT NUMBER & PHASE 04190001401

Dist	COUNTY	ROUTE	POST MILES TOTAL PROJECT	SHEET No.	TOTAL SHEETS
04	SCI	82	18.2/26.4	248A	466

AS-AWARDED CONTRACT PLANS
THIS STAMP PLACED IN LIEU OF ORIGINAL SIGNATURE

REGISTERED CIVIL ENGINEER DATE

PLANS APPROVAL DATE


REGISTERED PROFESSIONAL ENGINEER — No. Exp. CIVIL — STATE OF CALIFORNIA

THE STATE OF CALIFORNIA OR ITS OFFICERS OR AGENTS SHALL NOT BE RESPONSIBLE FOR THE ACCURACY OR COMPLETENESS OF SCANNED COPIES OF THIS PLAN SHEET.

20


NOTES:

1. INSTALL VERTICAL DELINEATOR DEVICE AT BEGINNING, EVERY THIRD CURB SECTION THEREAFTER, AND END OF EACH CONTINOUS QWICK KURB CHANNELIZING SYSTEM RUN.
2. INSTALL QWICK KURB CHANNELIZING SYSTEM FACE AT 1 FOOT FROM ETW.

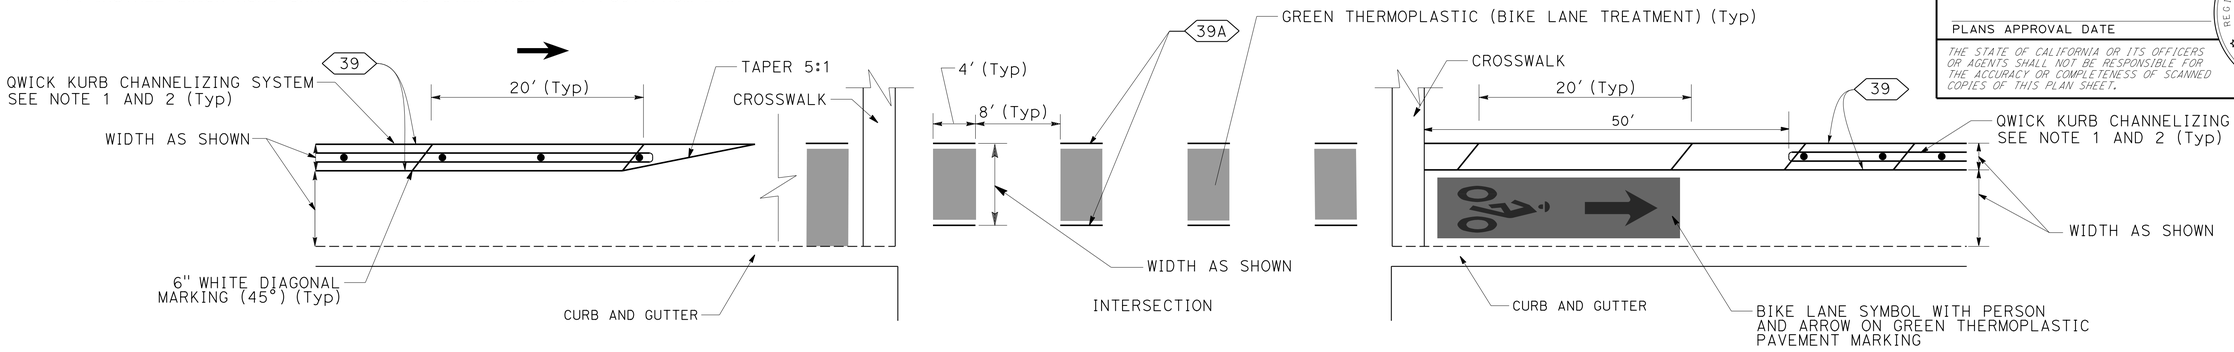


DETAIL C

BIKE LANE MARKINGS THROUGH INTERSECTION

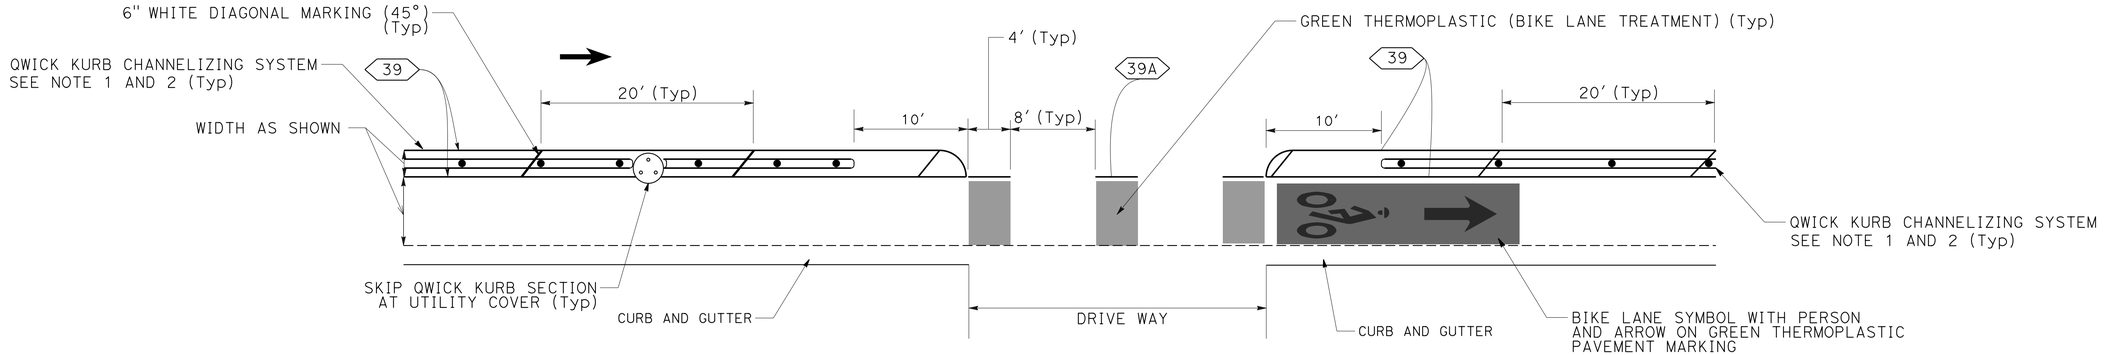

DETAIL B

BIKE LANE MARKINGS THROUGH DRIVEWAY

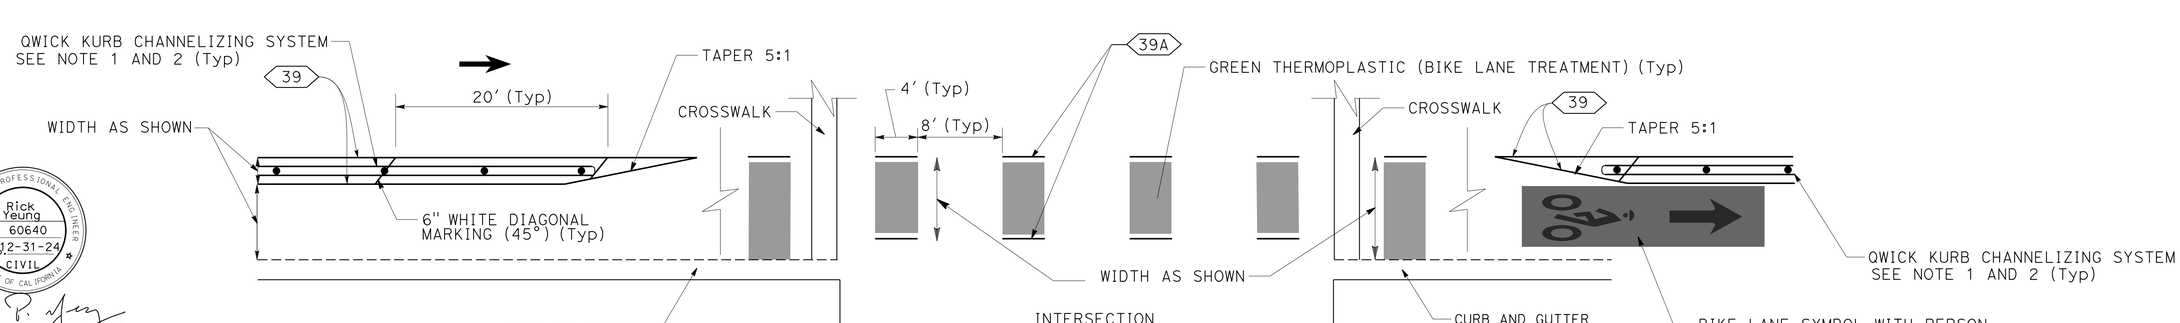

DETAIL A

BIKE LANE MARKINGS THROUGH CONFLICT ZONES/INTERSECTION

Rick Yeung 60640 Exp. 12-31-24 CIVIL — REGISTERED PROFESSIONAL ENGINEER — STATE OF CALIFORNIA

FOR REVISION ONLY

July 22, 2024

CONTRACT CHANGE ORDER NO. 20
SHEET _____ OF _____

PAVEMENT DELINEATION DETAILS

NO SCALE

PDD-1A

20 **REPLACED PER CONTRACT CHANGE ORDER No. 20 DATED**

STATE OF CALIFORNIA - DEPARTMENT OF TRANSPORTATION	TRAFFIC		
FUNCTIONAL SUPERVISOR	LESTER LEE		
CALCULATED-DESIGNED BY	SON LY		
CHECKED BY	RICK YEUNG		
REVISED BY	SL		
DATE REVISED	11-18-22		

LAST REVISION: DATE PLOTTED => 18-NOV-2024
TIME PLOTTED => 15:16

BORDER LAST REVISED 7/2/2010 | USERNAME => s129144 | DGN FILE => 0419000140nb001A.cco | RELATIVE BORDER SCALE IS IN INCHES 0 1 2 3 | UNIT 0712 | PROJECT NUMBER & PHASE 04190001401

Dist	COUNTY	ROUTE	POST MILES TOTAL PROJECT	SHEET No.	TOTAL SHEETS
04	SCl	82	18.2/26.4	248B	466

20


AS-AWARDED CONTRACT PLANS
THIS STAMP PLACED IN LIEU OF ORIGINAL SIGNATURE

REGISTERED CIVIL ENGINEER DATE


PLANS APPROVAL DATE

REGISTERED PROFESSIONAL ENGINEER — No. Exp. CIVIL — STATE OF CALIFORNIA


THE STATE OF CALIFORNIA OR ITS OFFICERS OR AGENTS SHALL NOT BE RESPONSIBLE FOR THE ACCURACY OR COMPLETENESS OF SCANNED COPIES OF THIS PLAN SHEET.

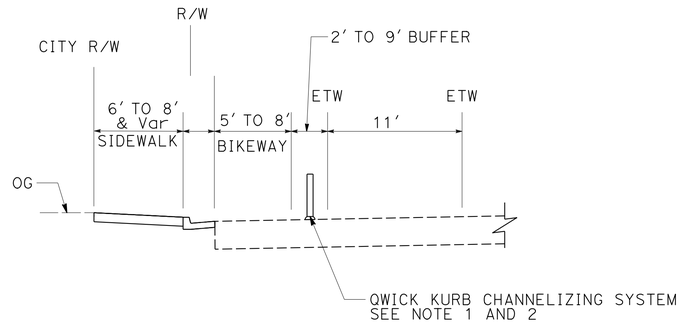


TYPICAL SEPARATED BIKEWAY

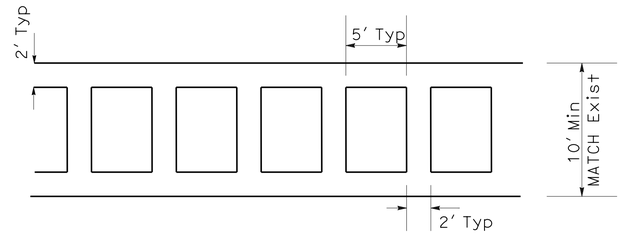

CROSSWALK MARKINGS (LADDER)

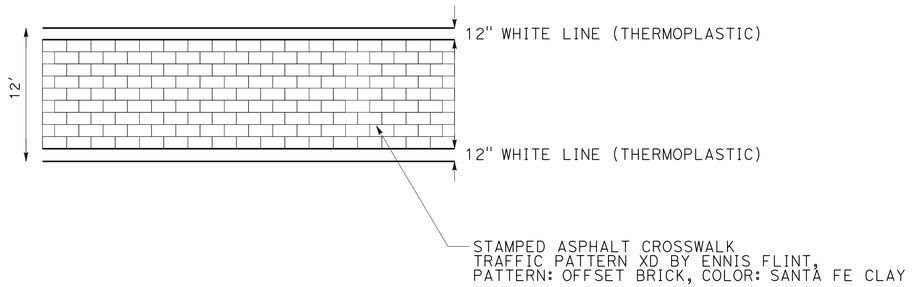


STAMPED ASPHALT CROSSWALK
(AT STANFORD Ave AND ROUTE 82)

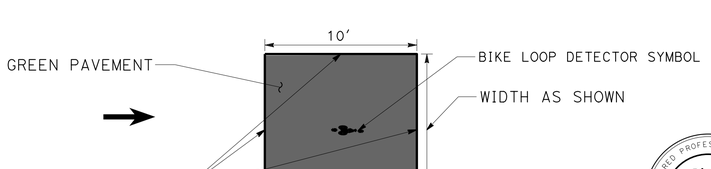

BIKE BOX DETAIL

REGISTERED PROFESSIONAL ENGINEER — Rick Yeung — No. 60640 — Exp. 12-31-24 — CIVIL — STATE OF CALIFORNIA

FOR REVISION ONLY
July 22, 2024

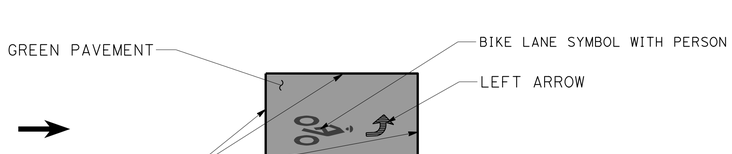

TWO STAGE BIKE BOX DETAIL
(DIMENTION AS SHOWN)

CONTRACT CHANGE ORDER NO. 20
SHEET _____ OF _____

20 ADDED PER CONTRACT CHANGE ORDER No. 20 DATED

NO SCALE

PDD-1B

CALCULATED-DESIGNED BY	REVISED BY	DATE REVISED
CHECKED BY	SL	11-18-22
SON LY		
RICK YEUNG		

FUNCTIONAL SUPERVISOR: LESTER LEE

STATE OF CALIFORNIA - DEPARTMENT OF TRANSPORTATION
Caltrans®
TRAFFIC

LAST REVISION: DATE PLOTTED => 18-NOV-2024
11-28-22 TIME PLOTTED => 15:16

20 **SHEET DELETED PER CONTRACT CHANGE ORDER No. 20 DATED**

REGISTERED PROFESSIONAL ENGINEER — Son Thanh Ly — No. 72584 — Exp. 6-30-24 — CIVIL — STATE OF CALIFORNIA

Son Thanh Ly

FOR REVISION ONLY

July 22, 2024

DATE

20

Dist	COUNTY	ROUTE	POST MILES TOTAL PROJECT	SHEET No.	TOTAL SHEETS
04	SCI	82	18.2/26.4	249	466

AS-AWARDED CONTRACT PLANS
THIS STAMP PLACED IN LIEU OF ORIGINAL SIGNATURE

REGISTERED CIVIL ENGINEER DATE

PLANS APPROVAL DATE

REGISTERED PROFESSIONAL ENGINEER — No. — Exp. — CIVIL — STATE OF CALIFORNIA

THE STATE OF CALIFORNIA OR ITS OFFICERS OR AGENTS SHALL NOT BE RESPONSIBLE FOR THE ACCURACY OR COMPLETENESS OF SCANNED COPIES OF THIS PLAN SHEET.

TRAFFIC STRIPES, PAVEMENT MARKINGS AND PAVEMENT MARKERS

SHEET No.	LOCATION/STATION	DIRECTION	DETAIL No.	THERMOPLASTIC TRAFFIC STRIPE (ENHANCED WET NIGHT VISIBILITY)		TRAFFIC STRIPE TAPE (WARRANTY)					THERMOPLASTIC PAVEMENT MARKING (BIKE LANE TREATMENT)	THERMOPLASTIC CROSSWALK AND PAVEMENT MARKING (ENHANCED WET NIGHT VISIBILITY)		PAVEMENT MARKERS (RETRO-REFLECTIVE)		DELINEATOR (CLASS 1)	DESCRIPTION/COMMENTS	REMOVE THERMOPLASTIC TRAFFIC STRIPE	REMOVE THERMOPLASTIC PAVEMENT MARKING	REMOVE MARKER
				6" WHITE	6" YELLOW	6" WHITE				8" WHITE										
				WHITE SOLID	YELLOW SOLID	BROKEN (17-7)	BROKEN (6-1)	SOLID	BROKEN (8-4)	WHITE SOLID	GREEN	WHITE	YELLOW	G	RY			LF	SQFT	EA
				LF							SQFT			EA						
PD-1	"A1" 964+38	NB										54					PED		54	
	"A1" 946+78	NB										84					XING		84	
	"A1" 964+62 TO 974+00	NB										126					TYPE III (L)		126	
	"A1" 968+49	SB										54					XING		54	
	"A1" 968+80	SB										84					PED		84	
	"A1" 968+48 TO 969+19	SB										84					TYPE III (L)		84	
	"A1" 966+21 TO 975+50	SB	25A		845										34			788		17
	"A1" 964+30 TO 975+50	NB	38							192				8				192		4
	"A1" 967+93 TO 969+45	SB	38							152				8				152		4
	"A1" 966+98 TO 967+09											475					LADDER CROSSWALK		123	
	"A1" 964+00 TO 975+50	NB	9			2300								48				3264		69
	"A1" 966+00 TO 975+50	SB	9			1900								40				2863	84	60
	"A1" 973+74 TO 976+10	NB										84					TYPE III (L)		84	
	"A1" 974+69 TO 980+33	NB	25A		950										40			564		12
	"A1" 975+65 TO 990+50	SB	9			2784								58						
	"A1" 975+65 TO 990+50	NB	9			2784								58						
	"A1" 977+93 TO 980+28	NB										210					TYPE III (L)			
	"A1" 981+66 TO 984+25	SB										126					TYPE III (L)			
	"A1" 981+70 TO 985+96	SB										126					TYPE III (R)			
	"A1" 977+35 TO 986+00	NB	38							547				24						
	"A1" 981+60 TO 983+65	SB	38A							200										
	"A1" 981+60 TO 985+97	SB	38							436				20						
	"A1" 981+51 TO 990+50	NB	39					951								48	2 STRIPES + 45 DEGREE STRIPES			
	"A1" 982+07 TO 990+50	NB	39A						133											
	"A1" 982+07 TO 990+50	NB									80						GREEN SKIP			
	"A1" 981+63 TO 990+50	SB									1110						GREEN SOLID			
PD-2	"A1" 981+63 TO 990+50	SB	39					464								23	2 STRIPES + 45 DEGREE STRIPES			
	"A1" 982+65 TO 990+50	SB	39A						61											
	"A1" 983+65 TO 990+50										1300						GREEN SOLID			
	"A1" 986+25 TO 990+50										160						GREEN SKIP			
	"A1" 980+24 TO 980+65											652					LADDER CROSSWALK			
	"A1" 981+38 TO 981+60											678					LADDER CROSSWALK			
	"A1" 980+31 TO 980+46											65					LIMIT LINE			
	"A1" 981+59 TO 981+65											60					LIMIT LINE			
	"A1" 980+54 TO 980+75		39A						83											
	"A1" 980+54 TO 990+50										220						GREEN SKIP			
	"A1" 981+08 TO 990+50		39A						86											
	"A1" 981+08 TO 990+50										220						GREEN SKIP			
	"A1" 981+73 TO 990+50	NB										53					BIKE LANE SYMBOL			
	"A1" 981+73 TO 990+50	NB									320						GREEN PAVEMENT			
	"A1" 980+50 TO 991+00		40				100													
	"A1" 987+10	SB										10					CHEVRON PAVEMENT			
SHEET TOTAL					1795	9768	100	1415	363	1527	3410	3025		264	74	71		7823	777	166

CONTRACT CHANGE ORDER NO. 20
SHEET _____ OF _____

PAVEMENT DELINEATION QUANTITIES

PDQ-1

STATE OF CALIFORNIA - DEPARTMENT OF TRANSPORTATION — DESIGN — Caltrans®

FUNCTIONAL SUPERVISOR: TAM LY

CALCULATED-DESIGNED BY: QUYNH NGUYEN

CHECKED BY: SON LY

REVISED BY: TG — DATE REVISED: 11-28-22

LAST REVISION: DATE PLOTTED => 18-NOV-2024 — 12-07-22 — TIME PLOTTED => 16:07

BORDER LAST REVISED 7/2/2010

USERNAME => s129144
DGN FILE => 0419000140nc001.cco

RELATIVE BORDER SCALE IS IN INCHES 0 1 2 3

UNIT 0712

PROJECT NUMBER & PHASE 04190001401

CONTRACT CHANGE ORDER NO. 20
SHEET _____ OF _____

20 REPLACED PER CONTRACT CHANGE ORDER No. 20 DATED

Son Thanh Ly
No. 72584
Exp. 6-30-26
CIVIL
STATE OF CALIFORNIA
FOR REVISION ONLY
July 22, 2024
DATE

20

Dist	COUNTY	ROUTE	POST MILES TOTAL PROJECT	SHEET No.	TOTAL SHEETS
04	SCI	82	18.2/26.4	249A	466

AS-AWARDED CONTRACT PLANS
THIS STAMP PLACED IN LIEU OF ORIGINAL SIGNATURE
REGISTERED CIVIL ENGINEER DATE
PLANS APPROVAL DATE
THE STATE OF CALIFORNIA OR ITS OFFICERS OR AGENTS SHALL NOT BE RESPONSIBLE FOR THE ACCURACY OR COMPLETENESS OF SCANNED COPIES OF THIS PLAN SHEET.
REGISTERED PROFESSIONAL ENGINEER No. Exp. CIVIL STATE OF CALIFORNIA

TRAFFIC STRIPES, PAVEMENT MARKINGS AND PAVEMENT MARKERS

SHEET No.	LOCATION/STATION	DIRECTION	DETAIL No.	THERMOPLASTIC TRAFFIC STRIPE (ENHANCED WET NIGHT VISIBILITY)		TRAFFIC STRIPE TAPE (WARRANTY)			THERMOPLASTIC CROSSWALK AND PAVEMENT MARKING (ENHANCED WET NIGHT VISIBILITY)		PAVEMENT MARKERS (RETRORE-FLECTIVE)		DESCRIPTION/COMMENTS	REMOVE THERMOPLASTIC TRAFFIC STRIPE	REMOVE THERMOPLASTIC PAVEMENT MARKING	REMOVE MARKER
				6" WHITE	6" YELLOW	6" WHITE		8" WHITE								
				WHITE SOLID	YELLOW SOLID	BROKEN (17-7)	BROKEN (6-1)	WHITE SOLID	WHITE	YELLOW	G	RY				
				LF					SQFT		EA			LF	SQFT	EA
PD-1	"A1" 964+38	NB							54				PED		54	
	"A1" 946+78	NB							84				XING		84	
	"A1" 964+62 TO 974+00	NB							126				TYPE III (L)		126	
	"A1" 968+49	SB							54				XING		54	
	"A1" 968+80	SB							84				PED		84	
	"A1" 968+48 TO 969+19	SB							84				TYPE III (L)		84	
	"A1" 966+21 TO 975+50	SB	25A		845							34		788		17
	"A1" 964+30 TO 975+50	NB	38					192			8			192		4
	"A1" 967+93 TO 969+45	SB	38					152			8			152		4
	"A1" 966+98 TO 967+09								475				LADDER CROSSWALK		123	
	"A1" 964+00 TO 975+50	NB	9			2300					48			3264		69
	"A1" 966+00 TO 975+50	SB	9			1900					40			2863	84	60
	"A1" 973+74 TO 976+10	NB							84				TYPE III (L)		84	
	"A1" 974+69 TO 980+33	NB	25A		950							40		564		12
PD-2	"A1" 975+65 TO 990+50	SB	9			2784					58					
	"A1" 975+65 TO 990+50	NB	9			2784					58					
	"A1" 977+93 TO 980+28	NB							210				TYPE III (L)			
	"A1" 981+66 TO 984+25	SB							126				TYPE III (L)			
	"A1" 981+70 TO 985+96	SB							126				TYPE III (R)			
	"A1" 977+35 TO 986+00	NB	38					547			24					
	"A1" 981+60 TO 983+65	SB	38A					200								
	"A1" 981+60 TO 985+97	SB	38					436			20					
	"A1" 980+24 TO 980+65								652				LADDER CROSSWALK			
	"A1" 981+38 TO 981+60								678				LADDER CROSSWALK			
	"A1" 980+31 TO 980+46								65				LIMIT LINE			
	"A1" 981+59 TO 981+65								60				LIMIT LINE			
	"A1" 980+50 TO 991+00		40				100									
	"A1" 987+10	SB							10				CHEVRON PAVEMENT			
SHEET TOTAL					1795	9768	100	1527	2972		264	74		7823	777	166

PAVEMENT DELINEATIO QUANTITIESN
PDQ-1A

REVISED BY: TG | DATE REVISED: 11-28-22
CALCULATED-DESIGNED BY: QUYNH NGUYEN | CHECKED BY: SON LY
FUNCTIONAL SUPERVISOR: TAM LY
STATE OF CALIFORNIA - DEPARTMENT OF TRANSPORTATION
Caltrans® DESIGN

LAST REVISION | DATE PLOTTED => 18-NOV-2024 | TIME PLOTTED => 16:07
12-07-22

BORDER LAST REVISED 7/2/2010
USERNAME => s129144
DGN FILE => 0419000140nc001A.cco
RELATIVE BORDER SCALE IS IN INCHES 0 1 2 3
UNIT 0712
PROJECT NUMBER & PHASE 04190001401

Dist	COUNTY	ROUTE	POST MILES TOTAL PROJECT	SHEET No.	TOTAL SHEETS
04	SCI	82	18.2/26.4	250	466

AS-AWARDED CONTRACT PLANS
THIS STAMP PLACED IN LIEU OF ORIGINAL SIGNATURE

REGISTERED CIVIL ENGINEER DATE

PLANS APPROVAL DATE

REGISTERED PROFESSIONAL ENGINEER — No. Exp. CIVIL — STATE OF CALIFORNIA

THE STATE OF CALIFORNIA OR ITS OFFICERS OR AGENTS SHALL NOT BE RESPONSIBLE FOR THE ACCURACY OR COMPLETENESS OF SCANNED COPIES OF THIS PLAN SHEET.

20 SHEET DELETED PER CONTRACT CHANGE ORDER No. 20 DATED

TRAFFIC STRIPES, PAVEMENT MARKINGS AND PAVEMENT MARKERS

SHEET No.	LOCATION/STATION	DIRECTION	DETAIL No.	THERMOPLASTIC TRAFFIC STRIPE (ENHANCED WET NIGHT VISIBILITY)		TRAFFIC STRIPE TAPE (WARRANTY)					THERMOPLASTIC PAVEMENT MARKING (BIKE LANE TREATMENT)	THERMOPLASTIC CROSSWALK AND PAVEMENT MARKING (ENHANCED WET NIGHT VISIBILITY)		PAVEMENT MARKERS (RETRO-REFLECTIVE)		DELINEATOR (CLASS 1)	DESCRIPTION/COMMENTS	REMOVE THERMOPLASTIC TRAFFIC STRIPE	REMOVE THERMOPLASTIC PAVEMENT MARKING	REMOVE MARKER
				6" WHITE	6" YELLOW	6" WHITE				8" WHITE										
				WHITE SOLID	YELLOW SOLID	BROKEN (17-7)	BROKEN (6-1)	SOLID	BROKEN (8-4)	WHITE SOLID	GREEN	WHITE	YELLOW	G	RY			LF	SQFT	EA
PD-2	"A1" 983+66 TO 990+50	SB										53					BIKE LANE SYMBOL			
	"A1" 983+66 TO 990+50	SB									320						GREEN PAVEMENT			
PD-3	"A1" 981+49 TO 1003+87	SB	25A		2238										94					
	"A1" 986+84 TO 991+11	SB	39					780								38	2 STRIPES + 45 DEGREE STRIPES			
	"A1" 964+00 TO 975+50	NB	9			2800								60						
	"A1" 966+00 TO 975+50	SB	9			2800								60						
	"A1" 990+50 TO 1004+50	SB										11					BIKE LANE SYMBOL			
	"A1" 990+50 TO 1004+50	SB									364						GREEN PAVEMENT			
	"A1" 995+03 TO 1004+50	SB										42					BIKE LANE SYMBOL			
	"A1" 995+03 TO 1004+50	SB									256						GREEN PAVEMENT			
	"A1" 992+96 TO 1004+50	NB	39A						487											
	"A1" 992+96 TO 1004+50	NB									1240						GREEN SKIP			
	"A1" 993+44 TO 1004+50	NB	39					750								38	2 STRIPES + 45 DEGREE STRIPES			
	"A1" 995+83 TO 1004+50	NB									2040						GREEN SOLID			
	"A1" 995+82 TO 997+53	SB	27B																	
	"A1" 1001+40 TO 1001+80											160					LADDER CROSSWALK		20	
	"A1" 1003+77 TO 1004+40	SB	25A		1570										66					
	"A1" 1004+15 TO 1004+40	NB	39					468								25	2 STRIPES + 45 DEGREE STRIPES			
	"A1" 1003+78 TO 1004+40	SB	39					1086								54	2 STRIPES + 45 DEGREE STRIPES			
	"A1" 1003+77 TO 1004+40	SB	25A		1570										66					
	"A1" 996+00	SB										10					CHEVRON MARKING			
PD-4	"A1" 1005+31 TO 1006+57	NB										84					TYPE III (L)			
	"A1" 1012+63 TO 1015+25	SB										210					TYPE III (L)			
	"A1" 1004+40 TO 1018+50	SB										105					BIKE LANE SYMBOL			
	"A1" 1004+40 TO 1018+50	NB									448						GREEN PAVEMENT			
	"A1" 1004+40 TO 1018+50	SB									320						GREEN PAVEMENT			
	"A1" 1004+40 TO 1018+50	NB									960						GREEN SKIP			
	"A1" 1004+40 TO 1018+50	NB	39A						221											
	"A1" 1004+40 TO 1018+50	NB	39					1349								68	2 STRIPES + 45 DEGREE STRIPES			
	"A1" 1004+40 TO 1018+50	SB	39					547								28	2 STRIPES + 45 DEGREE STRIPES			
	"A1" 1004+40 TO 1018+50	SB	39A						572											
	"A1" 1004+40 TO 1018+50	SB									1440						GREEN SKIP			
	"A1" 1012+56 TO 1014+11	SB	38							155				7						
	"A1" 1012+56 TO 1015+30	SB	38							274				12						
	"A1" 1013+96 TO 1014+91	SB									785						GREEN SOLID			
	"A1" 1011+00 TO 1012+50		40				400													
SHEET TOTAL					5378	5600	400	4980	1280	429	8173	675		139	226	251			20	

CONTRACT CHANGE ORDER NO. 20
SHEET _____ OF _____

REGISTERED PROFESSIONAL ENGINEER — Son Thanh Ly — No. 72584 — Exp. 6-30-26 — CIVIL — STATE OF CALIFORNIA

FOR REVISION ONLY
July 22, 2024
DATE

PAVEMENT DELINEATION QUANTITIES

PDQ-2

REVISED BY: TG — DATE REVISED: 11-28-22
CALCULATED-DESIGNED BY: QUYNH NGUYEN — CHECKED BY: SON LY
FUNCTIONAL SUPERVISOR: TAM LY
STATE OF CALIFORNIA - DEPARTMENT OF TRANSPORTATION — DESIGN — Caltrans

LAST REVISION | DATE PLOTTED => 18-NOV-2024 | TIME PLOTTED => 16:07
12-07-22

BORDER LAST REVISED 7/2/2010 | USERNAME => s129144 | DGN FILE => 0419000140nc002.cco | RELATIVE BORDER SCALE IS IN INCHES 0 1 2 3 | UNIT 0712 | PROJECT NUMBER & PHASE 04190001401

Dist	COUNTY	ROUTE	POST MILES TOTAL PROJECT	SHEET No.	TOTAL SHEETS
04	SCI	82	18.2/26.4	250A	466

AS-AWARDED CONTRACT PLANS
THIS STAMP PLACED IN LIEU OF ORIGINAL SIGNATURE

REGISTERED CIVIL ENGINEER DATE

PLANS APPROVAL DATE

REGISTERED PROFESSIONAL ENGINEER — No. ____ Exp. ____ CIVIL — STATE OF CALIFORNIA

THE STATE OF CALIFORNIA OR ITS OFFICERS OR AGENTS SHALL NOT BE RESPONSIBLE FOR THE ACCURACY OR COMPLETENESS OF SCANNED COPIES OF THIS PLAN SHEET.

REGISTERED PROFESSIONAL ENGINEER — Son Thanh Ly — No. 72584 — Exp. 6-30-26 — CIVIL — STATE OF CALIFORNIA

20

FOR REVISION ONLY
July 22, 2024
DATE

TRAFFIC STRIPES, PAVEMENT MARKINGS AND PAVEMENT MARKERS

SHEET No.	LOCATION/STATION	DIRECTION	DETAIL No.	THERMOPLASTIC TRAFFIC STRIPE (ENHANCED WET NIGHT VISIBILITY)		TRAFFIC STRIPE TAPE (WARRANTY)			THERMOPLASTIC CROSSWALK AND PAVEMENT MARKING (ENHANCED WET NIGHT VISIBILITY)		PAVEMENT MARKERS (RETRORE-FLECTIVE)		DESCRIPTION/COMMENTS	REMOVE THERMOPLASTIC TRAFFIC STRIPE	REMOVE THERMOPLASTIC PAVEMENT MARKING	REMOVE MARKER
				6" WHITE	6" YELLOW	6" WHITE		8" WHITE								
				WHITE SOLID	YELLOW SOLID	BROKEN (17-7)	BROKEN (6-1)	WHITE SOLID	WHITE	YELLOW	G	RY				
				LF					SQFT		EA			LF	SQFT	EA
PD-2	"A1" 983+66 TO 990+50	SB														
	"A1" 983+66 TO 990+50	SB														
PD-3	"A1" 981+49 TO 1003+87	SB	25A		2238							94				
	"A1" 964+00 TO 975+50	NB	9			2800					60					
	"A1" 966+00 TO 975+50	SB	9			2800					60					
	"A1" 995+82 TO 997+53	SB	27B						11							
	"A1" 1001+40 TO 1001+80												LADDER CROSSWALK		20	
	"A1" 1003+77 TO 1004+40	SB	25A		1570							66				
	"A1" 1003+77 TO 1004+40	SB	25A		1570							66				
	"A1" 996+00	SB											CHEVRON MARKING			
PD-4	"A1" 1005+31 TO 1006+57	NB							84				TYPE III (L)			
	"A1" 1012+63 TO 1015+25	SB							210				TYPE III (L)			
	"A1" 1012+56 TO 1014+11	SB	38					155			7					
	"A1" 1012+56 TO 1015+30	SB	38					274			12					
	"A1" 1011+00 TO 1012+50		40				400									
SHEET TOTAL					5378	5600	400	429	305		139	226			20	

CONTRACT CHANGE ORDER NO. 20
SHEET ____ OF ____

20 REPLACED PER CONTRACT CHANGE ORDER No. 20 DATED

PAVEMENT DELINEATION QUANTITIES
PDQ-2A

CALCULATED-DESIGNED BY: QUYNH NGUYEN
CHECKED BY: SON LY
REVISED BY: TG
DATE REVISED: 11-28-22
FUNCTIONAL SUPERVISOR: TAM LY
STATE OF CALIFORNIA - DEPARTMENT OF TRANSPORTATION
DESIGN

LAST REVISION DATE PLOTTED => 18-NOV-2024
TIME PLOTTED => 16:07

BORDER LAST REVISED 7/2/2010
USERNAME => s129144
DGN FILE => 0419000140nc002A.cco
RELATIVE BORDER SCALE IS IN INCHES 0 1 2 3
UNIT 0712
PROJECT NUMBER & PHASE 04190001401

CONTRACT CHANGE ORDER NO. 20
SHEET ____ OF ____

20 SHEET DELETED PER CONTRACT CHANGE ORDER No. 20 DATED

Son Thanh Ly
No. 72584
Exp. 6-30-26
CIVIL
STATE OF CALIFORNIA

20

FOR REVISION ONLY
July 22, 2024
DATE

Dist	COUNTY	ROUTE	POST MILES TOTAL PROJECT	SHEET No.	TOTAL SHEETS
04	SCI	82	18.2/26.4	251	466

AS-AWARDED CONTRACT PLANS
THIS STAMP PLACED IN LIEU OF ORIGINAL SIGNATURE
REGISTERED CIVIL ENGINEER DATE
January 20, 2023
PLANS APPROVAL DATE

No. ____ Exp. ____ CIVIL

THE STATE OF CALIFORNIA OR ITS OFFICERS OR AGENTS SHALL NOT BE RESPONSIBLE FOR THE ACCURACY OR COMPLETENESS OF SCANNED COPIES OF THIS PLAN SHEET.

TRAFFIC STRIPES, PAVEMENT MARKINGS AND PAVEMENT MARKERS

SHEET No.	LOCATION/STATION	DIRECTION	DETAIL No.	THERMOPLASTIC TRAFFIC STRIPE (ENHANCED WET NIGHT VISIBILITY)		TRAFFIC STRIPE TAPE (WARRANTY)					THERMOPLASTIC PAVEMENT MARKING (BIKE LANE TREATMENT)	THERMOPLASTIC CROSSWALK AND PAVEMENT MARKING (ENHANCED WET NIGHT VISIBILITY)		PAVEMENT MARKERS (RETRO-REFLECTIVE)		DELINEATOR (CLASS 1)	DESCRIPTION/COMMENTS	REMOVE THERMOPLASTIC TRAFFIC STRIPE	REMOVE THERMOPLASTIC PAVEMENT MARKING	REMOVE MARKER
				6" WHITE	6" YELLOW	6" WHITE				8" WHITE										
				WHITE SOLID	YELLOW SOLID	BROKEN (17-7)	BROKEN (6-1)	SOLID	BROKEN (8-4)	WHITE SOLID	GREEN	WHITE	YELLOW	G	RY					
				LF							SQFT			EA				LF	SQFT	EA
PD-4	"A1" 1010+93 TO 1011+17											1,466					LADDER CROSSWALK			
	"A1" 1011+17 TO 1012+38											950					CROSSWALK			
	"A1" 1011+13 TO 1012+39											950					CROSSWALK			
	"A1" 1012+38 TO 1012+53											1,466					LADDER CROSSWALK			
	"A1" 1010+90 TO 1010+95											60					LIMIT LINE			
	"A1" 1012+55 TO 1012+56											50					LIMIT LINE			
	"A1" 1006+80 TO 1007+60											444					LADDER CROSSWALK		20	
	"A1" 1017+45 TO 1017+80											560					LADDER CROSSWALK		20	
	"A1" 1004+40 TO 1018+50	NB	9			2500								53						
	"A1" 1004+40 TO 1018+50	SB	9			2500								53						
PD-5	"A1" 1016+59 TO 1019+20	SB									440						GREEN SKIP			
	"A1" 1024+98 TO 1026+86	NB										84					TYPE III (L)			
	"A1" 1028+37 TO 1030+68	SB										84					TYPE III (L)			
	"A1" 1019+21 TO 1019+21	NB										63					BIKE LANE SYMBOL			
	"A1" 1019+21 TO 1019+21	NB									384						GREEN PAVEMENT			
	"A1" 1019+54 TO 1019+54	SB										63					BIKE LANE SYMBOL			
	"A1" 1019+54 TO 1019+54	SB									384						GREEN PAVEMENT			
	"A1" 1018+50 TO 1033+50	SB	25A		1420										60					
	"A1" 1018+50 TO 1033+50	NB	25A		1420										60					
	"A1" 1018+50 TO 1033+50	NB	39					1527								77	2 STRIPES + 45 DEGREE STRIPES			
	"A1" 1018+50 TO 1033+50	NB	39A						184											
	"A1" 1018+50 TO 1033+50	NB									1100						GREEN SKIP			
	"A1" 1018+50 TO 1033+50	SB	39					1356								68	2 STRIPES + 45 DEGREE STRIPES			
	"A1" 1018+50 TO 1033+50	SB	39A						372											
	"A1" 1018+50 TO 1033+50	SB									1340						GREEN SKIP			
	"A1" 1027+00 TO 1027+28											1,248					LADDER CROSSWALK			
	"A1" 1027+14 TO 1028+14											814					LADDER CROSSWALK			
	"A1" 1027+28 TO 1028+06											814					LADDER CROSSWALK			
	"A1" 1028+06 TO 1028+25											1,248					LADDER CROSSWALK			
	"A1" 1027+28 TO 1028+06											450					LADDER CROSSWALK		20	
	"A1" 1027+03 TO 1027+10											50					LIMIT LINE			
	"A1" 1027+14 TO 1027+28		39A						79											
	"A1" 1027+14 TO 1027+28										200						GREEN SKIP			
	"A1" 1027+97 TO 1028+01		39A						79											
	"A1" 1027+97 TO 1028+01										200						GREEN SKIP			
	"A1" 1028+26 TO 1028+29											50					LIMIT LINE			
	"A1" 1024+85 TO 1027+04	NB	38							219				10						
	"A1" 1028+32 TO 1030+70	SB	38							238				12						
	SHEET TOTAL				2840	5000		2883	714	457	4048	10,914		128	120	145			60	

PAVEMENT DELINEATION QUANTITIES

PDQ-3

CALCULATED-DESIGNED BY: QUYNH NGUYEN
CHECKED BY: SON LY
REVISED BY: TG
DATE REVISED: 11-28-22
FUNCTIONAL SUPERVISOR: TAM LY

STATE OF CALIFORNIA - DEPARTMENT OF TRANSPORTATION
Caltrans® DESIGN

LAST REVISION DATE PLOTTED => 18-NOV-2024
TIME PLOTTED => 16:07
12-07-22

BORDER LAST REVISED 7/2/2010
USERNAME => s129144
DGN FILE => 0419000140nc003.cco
RELATIVE BORDER SCALE IS IN INCHES 0 1 2 3
UNIT 0712
PROJECT NUMBER & PHASE 04190001401

CONTRACT CHANGE ORDER NO. 20
SHEET _____ OF _____

20 **REPLACE PER CONTRACT CHANGE ORDER No. 20 DATED**

REGISTERED PROFESSIONAL ENGINEER — Son Thanh Ly — No. 72584 — Exp. 6-30-26 — CIVIL — STATE OF CALIFORNIA

20

FOR REVISION ONLY
July 22, 2024
DATE

Dist	COUNTY	ROUTE	POST MILES TOTAL PROJECT	SHEET No.	TOTAL SHEETS
04	SCI	82	18.2/26.4	251A	466

AS-AWARDED CONTRACT PLANS
THIS STAMP PLACED IN LIEU OF ORIGINAL SIGNATURE

REGISTERED CIVIL ENGINEER DATE

PLANS APPROVAL DATE

REGISTERED PROFESSIONAL ENGINEER — No. _____ — Exp. _____ — CIVIL — STATE OF CALIFORNIA

THE STATE OF CALIFORNIA OR ITS OFFICERS OR AGENTS SHALL NOT BE RESPONSIBLE FOR THE ACCURACY OR COMPLETENESS OF SCANNED COPIES OF THIS PLAN SHEET.

TRAFFIC STRIPES, PAVEMENT MARKINGS AND PAVEMENT MARKERS

SHEET No.	LOCATION/STATION	DIRECTION	DETAIL No.	THERMOPLASTIC TRAFFIC STRIPE (ENHANCED WET NIGHT VISIBILITY) 6" WHITE	THERMOPLASTIC TRAFFIC STRIPE (ENHANCED WET NIGHT VISIBILITY) 6" YELLOW	TRAFFIC STRIPE TAPE (WARRANTY) 6" WHITE BROKEN (17-7)	TRAFFIC STRIPE TAPE (WARRANTY) 6" WHITE BROKEN (6-1)	TRAFFIC STRIPE TAPE (WARRANTY) 8" WHITE	THERMOPLASTIC CROSSWALK AND PAVEMENT MARKING (ENHANCED WET NIGHT VISIBILITY) WHITE	THERMOPLASTIC CROSSWALK AND PAVEMENT MARKING (ENHANCED WET NIGHT VISIBILITY) YELLOW	PAVEMENT MARKERS (RETRORE-FLECTIVE) G	PAVEMENT MARKERS (RETRORE-FLECTIVE) RY	DESCRIPTION/COMMENTS	REMOVE THERMOPLASTIC TRAFFIC STRIPE	REMOVE THERMOPLASTIC PAVEMENT MARKING	REMOVE MARKER
				WHITE SOLID	YELLOW SOLID	BROKEN (17-7)	BROKEN (6-1)	WHITE SOLID	WHITE	YELLOW	G	RY		LF	SQFT	EA
				LF					SQFT		EA					
PD-4	"A1" 1010+93 TO 1011+17								1,466				LADDER CROSSWALK			
	"A1" 1011+17 TO 1012+38								950				CROSSWALK			
	"A1" 1011+13 TO 1012+39								950				CROSSWALK			
	"A1" 1012+38 TO 1012+53								1,466				LADDER CROSSWALK			
	"A1" 1010+90 TO 1010+95								60				LIMIT LINE			
	"A1" 1012+55 TO 1012+56								50				LIMIT LINE			
	"A1" 1006+80 TO 1007+60								444				LADDER CROSSWALK		20	
	"A1" 1017+45 TO 1017+80								560				LADDER CROSSWALK		20	
	"A1" 1004+40 TO 1018+50	NB	9			2500					53					
	"A1" 1004+40 TO 1018+50	SB	9			2500					53					
PD-5	"A1" 1024+98 TO 1026+86	NB							84				TYPE III (L)			
	"A1" 1028+37 TO 1030+68	SB							84				TYPE III (L)			
	"A1" 1018+50 TO 1033+50	SB	25A		1420							60				
	"A1" 1018+50 TO 1033+50	NB	25A		1420							60				
	"A1" 1027+00 TO 1027+28								1,248				LADDER CROSSWALK			
	"A1" 1027+14 TO 1028+14								814				LADDER CROSSWALK			
	"A1" 1027+28 TO 1028+06								814				LADDER CROSSWALK			
	"A1" 1028+06 TO 1028+25								1,248				LADDER CROSSWALK			
	"A1" 1027+28 TO 1028+06								450				LADDER CROSSWALK		20	
	"A1" 1027+03 TO 1027+10								50				LIMIT LINE			
	"A1" 1028+26 TO 1028+29								50				LIMIT LINE			
	"A1" 1024+85 TO 1027+04	NB	38					219			10					
	"A1" 1028+32 TO 1030+70	SB	38					238			12					
SHEET TOTAL					2840	5000		457	10,788		128	120			60	

PAVEMENT DELINEATION QUANTITIES

PDQ-3A

REVISED BY: TG | DATE REVISED: 11-28-22
CALCULATED-DESIGNED BY: QUYNH NGUYEN | CHECKED BY: SON LY
FUNCTIONAL SUPERVISOR: TAM LY
STATE OF CALIFORNIA - DEPARTMENT OF TRANSPORTATION
Caltrans® DESIGN

LAST REVISION | DATE PLOTTED => 18-NOV-2024 | 12-07-22 | TIME PLOTTED => 16:07

BORDER LAST REVISED 7/2/2010
USERNAME => s129144
DGN FILE => 0419000140nc003A.cco
RELATIVE BORDER SCALE IS IN INCHES 0 1 2 3
UNIT 0712
PROJECT NUMBER & PHASE 04190001401

CONTRACT CHANGE ORDER NO. 20
SHEET ____ OF ____

20 SHEET DELETED PER CONTRACT CHANGE ORDER No. 20 DATED

TRAFFIC STRIPES, PAVEMENT MARKINGS AND PAVEMENT MARKERS

Son Thanh Ly No. 72584 Exp. 6-30-26 CIVIL — REGISTERED PROFESSIONAL ENGINEER — STATE OF CALIFORNIA

20

FOR REVISION ONLY
July 22, 2024
DATE

Dist	COUNTY	ROUTE	POST MILES TOTAL PROJECT	SHEET No.	TOTAL SHEETS
04	SCI	82	18.2/26.4	252	466

AS-AWARDED CONTRACT PLANS
THIS STAMP PLACED IN LIEU OF ORIGINAL SIGNATURE
REGISTERED CIVIL ENGINEER DATE

January 20, 2023
PLANS APPROVAL DATE

REGISTERED PROFESSIONAL ENGINEER — No. ____ Exp. ____ CIVIL — STATE OF CALIFORNIA

THE STATE OF CALIFORNIA OR ITS OFFICERS OR AGENTS SHALL NOT BE RESPONSIBLE FOR THE ACCURACY OR COMPLETENESS OF SCANNED COPIES OF THIS PLAN SHEET.

SHEET No.	LOCATION/STATION	DIRECTION	DETAIL No.	THERMOPLASTIC TRAFFIC STRIPE (ENHANCED WET NIGHT VISIBILITY)		TRAFFIC STRIPE TAPE (WARRANTY)					THERMOPLASTIC PAVEMENT MARKING (BIKE LANE TREATMENT)	THERMOPLASTIC CROSSWALK AND PAVEMENT MARKING (ENHANCED WET NIGHT VISIBILITY)		PAVEMENT MARKERS (RETRORE-FLECTIVE)		DELINEATOR (CLASS 1)	DESCRIPTION/COMMENTS	REMOVE THERMOPLASTIC TRAFFIC STRIPE	REMOVE THERMOPLASTIC PAVEMENT MARKING	REMOVE MARKER
				6" WHITE	6" YELLOW	6" WHITE				8" WHITE										
				WHITE SOLID	YELLOW SOLID	BROKEN (17-7)	BROKEN (6-1)	SOLID	BROKEN (8-4)	WHITE SOLID	GREEN	WHITE	YELLOW	G	RY			LF	SQFT	EA
				LF							SQFT			EA						
	"A1" 1033+50 TO 1048+20	SB	39					820								41	2 STRIPES + 45 DEGREE STRIPES			
	"A1" 1033+50 TO 1035+80	NB	38							263				15			2 STRIPES + 45 DEGREE STRIPES			
	"A1" 1033+50 TO 1048+20	NB	9			2,820								58						
	"A1" 1033+50 TO 1048+20	SB	9			2,930								62						
	"A1" 1037+28 TO 1038+44	SB										84					TYPE III (L)			
	"A1" 1045+32 TO 1048+43	NB										126					TYPE III (L)			
	"A1" 1033+50 TO 1048+20	NB										53					BIKE LANE SYMBOL			
	"A1" 1033+50 TO 1048+20	NB									320						GREEN PAVEMENT			
	"A1" 1033+50 TO 1048+20	SB										53					BIKE LANE SYMBOL			
	"A1" 1033+50 TO 1048+20	SB									320						GREEN PAVEMENT			
	"A1" 1033+50 TO 1048+20	NB	39A						964											
	"A1" 1033+50 TO 1048+20	NB									1900						GREEN SKIP			
	"A1" 1033+50 TO 1048+20	SB									1320						GREEN SKIP			
	"A1" 1033+50 TO 1038+32	SB	39					1100								55				
PD-6	"A1" 1033+50 TO 1038+56	SB	39A						840											
	"A1" 1036+90 TO 1037+05											542					LADDER CROSSWALK			
	"A1" 1038+50 TO 1040+10											280					LADDER CROSSWALK		20	
	"A1" 1038+00 TO 1038+20											280					LADDER CROSSWALK		20	
	"A1" 1041+80 TO 1042+20											290					LADDER CROSSWALK		20	
	"A1" 1042+55 TO 1043+10											285					LADDER CROSSWALK		20	
	"A1" 1045+85 TO 1046+30											280					LADDER CROSSWALK		20	
	"A1" 1036+88 TO 1038+46	SB	38							158				7						
	"A1" 1035+20	SB										54					PED			
	"A1" 1035+60	SB										84					XING			
	"A1" 1036+18.50	SB										36					12" LIMIT LINE			
												72					KEEP			
												81					CLEAR			
	"A1" 1038+00	NB										54					PED			
	"A1" 1038+40	NB										84					XING			
	"A1" 1048+20 TO 1048+20	NB	25A		1155										50					
	"A1" 1036+95 TO 1048+20	SB	25A		1150										50					
	"A1" 1045+26 TO 1048+20	NB	38							322				15						
	"A1" 1048+20 TO 1063+12	NB	9			2,714								57						
	"A1" 1048+20 TO 1063+12	SB	9			2,710								57						
	"A1" 1049+58 TO 1052+72	SB										126					TYPE III (L)			
	"A1" 1061+17 TO 1063+06	NB										84					TYPE III (L)			
PD-7	"A1" 1049+87 TO 1049+87	NB										42					BIKE LANE SYMBOL			
	"A1" 1048+20 TO 1063+12	NB									512						GREEN PAVEMENT			
	"A1" 1048+00 TO 1063+12	SB										84					BIKE LANE SYMBOL			
	"A1" 1048+00 TO 1063+12	SB									512						GREEN PAVEMENT			
	"A1" 1048+00 TO 1063+12	SB	25A		1850										80					
	"A1" 1048+60 TO 1049+10		40				100													
	SHEET TOTAL				4155	11,174	100	1920	1804	743	4884	3074		271	180	55			100	

PAVEMENT DELINEATION QUANTITIES

PDQ-4

CALCULATED-DESIGNED BY	QUYNH NGUYEN
CHECKED BY	SON LY
REVISED BY	TG
DATE REVISED	11-28-22
FUNCTIONAL SUPERVISOR	TAM LY

STATE OF CALIFORNIA - DEPARTMENT OF TRANSPORTATION
DESIGN

LAST REVISION | DATE PLOTTED => 18-NOV-2024
12-07-22 | TIME PLOTTED => 16:08

BORDER LAST REVISED 7/2/2010 | USERNAME => s129144 | DGN FILE => 0419000140nc004.cco | RELATIVE BORDER SCALE IS IN INCHES 0 1 2 3 | UNIT 0712 | PROJECT NUMBER & PHASE 04190001401

CONTRACT CHANGE ORDER NO. 20
SHEET ____ OF ____

20 REPLACED PER CONTRACT CHANGE ORDER No. 20 DATED

REGISTERED PROFESSIONAL ENGINEER
Son Thanh Ly
No. 72584
Exp. 6-30-26
CIVIL
STATE OF CALIFORNIA

20

FOR REVISION ONLY
July 22, 2024
DATE

Dist	COUNTY	ROUTE	POST MILES TOTAL PROJECT	SHEET No.	TOTAL SHEETS
04	SCI	82	18.2/26.4	252A	466

AS-AWARDED CONTRACT PLANS
THIS STAMP PLACED IN LIEU OF ORIGINAL SIGNATURE
REGISTERED CIVIL ENGINEER DATE
PLANS APPROVAL DATE

REGISTERED PROFESSIONAL ENGINEER
No. ____
Exp. ____
CIVIL
STATE OF CALIFORNIA

THE STATE OF CALIFORNIA OR ITS OFFICERS OR AGENTS SHALL NOT BE RESPONSIBLE FOR THE ACCURACY OR COMPLETENESS OF SCANNED COPIES OF THIS PLAN SHEET.

TRAFFIC STRIPES, PAVEMENT MARKINGS AND PAVEMENT MARKERS

SHEET No.	LOCATION/STATION	DIRECTION	DETAIL No.	THERMOPLASTIC TRAFFIC STRIPE (ENHANCED WET NIGHT VISIBILITY)		TRAFFIC STRIPE TAPE (WARRANTY)			THERMOPLASTIC CROSSWALK AND PAVEMENT MARKING (ENHANCED WET NIGHT VISIBILITY)		PAVEMENT MARKERS (RETRORE-FLECTIVE)		DESCRIPTION/COMMENTS	REMOVE THERMOPLASTIC TRAFFIC STRIPE	REMOVE THERMOPLASTIC PAVEMENT MARKING	REMOVE MARKER
				6" WHITE	6" YELLOW	6" WHITE		8" WHITE								
				WHITE SOLID	YELLOW SOLID	BROKEN (17-7)	BROKEN (6-1)	WHITE SOLID	WHITE	YELLOW	G	RY				
				LF					SQFT		EA			LF	SQFT	EA
	"A1" 1033+50 TO 1048+20	NB	9			2,820					58					
	"A1" 1033+50 TO 1048+20	SB	9			2,930					62					
	"A1" 1037+28 TO 1038+44	SB							84				TYPE III (L)			
	"A1" 1045+32 TO 1048+43	NB							126				TYPE III (L)			
	"A1" 1036+90 TO 1037+05	NB							542				LADDER CROSSWALK			
	"A1" 1038+50 TO 1040+10								280				LADDER CROSSWALK		20	
	"A1" 1038+00 TO 1038+20								280				LADDER CROSSWALK		20	
	"A1" 1041+80 TO 1042+20								290				LADDER CROSSWALK		20	
	"A1" 1042+55 TO 1043+10								285				LADDER CROSSWALK		20	
	"A1" 1045+85 TO 1046+30								280				LADDER CROSSWALK		20	
PD-6	"A1" 1036+88 TO 1038+46	SB	38					158			7					
	"A1" 1035+20	SB							54				PED			
	"A1" 1035+60	SB							84				XING			
	"A1" 1036+18.50	SB							36				12" LIMIT LINE			
	"A1" 1038+00	NB							54				PED			
	"A1" 1038+40	NB							84				XING			
	"A1" 1048+20 TO 1048+20	NB	25A		1155							50				
	"A1" 1036+95 TO 1048+20	SB	25A		1150							50				
	"A1" 1045+26 TO 1048+20	NB	38					322			15					
	"A1" 1048+20 TO 1063+12	NB	9			2,714					57					
	"A1" 1048+20 TO 1063+12	SB	9			2,710					57					
PD-7	"A1" 1049+58 TO 1052+72	SB							126				TYPE III (L)			
	"A1" 1061+17 TO 1063+06	NB							84				TYPE III (L)			
	"A1" 1048+00 TO 1063+12	SB	25A		1850							80				
	"A1" 1048+60 TO 1049+10		40				100									
SHEET TOTAL					4155	11,174	100	743	2689		271	180			100	

REVISED BY: TG | DATE REVISED: 11-28-22
CALCULATED-DESIGNED BY: QUYNH NGUYEN | CHECKED BY: SON LY
FUNCTIONAL SUPERVISOR: TAM LY
STATE OF CALIFORNIA - DEPARTMENT OF TRANSPORTATION
Caltrans DESIGN

PAVEMENT DELINEATION QUANTITIES

PDQ-4A

LAST REVISION | DATE PLOTTED => 18-NOV-2024
12-07-22 | TIME PLOTTED => 16:08

CONTRACT CHANGE ORDER NO. 20
SHEET _____ OF _____

20 **SHEET DELETED PER CONTRACT CHANGE ORDER No. 20 DATED**

REGISTERED PROFESSIONAL ENGINEER — Son Thanh Ly — No. 72584 — Exp. 6-30-26 — CIVIL — STATE OF CALIFORNIA

20

FOR REVISION ONLY
July 22, 2024
DATE

Dist	COUNTY	ROUTE	POST MILES TOTAL PROJECT	SHEET No.	TOTAL SHEETS
04	SCI	82	18.2/26.4	253	466

AS-AWARDED CONTRACT PLANS
THIS STAMP PLACED IN LIEU OF ORIGINAL SIGNATURE
REGISTERED CIVIL ENGINEER DATE
PLANS APPROVAL DATE

REGISTERED PROFESSIONAL ENGINEER — No. _____ — Exp. _____ — CIVIL — STATE OF CALIFORNIA

THE STATE OF CALIFORNIA OR ITS OFFICERS OR AGENTS SHALL NOT BE RESPONSIBLE FOR THE ACCURACY OR COMPLETENESS OF SCANNED COPIES OF THIS PLAN SHEET.

TRAFFIC STRIPES, PAVEMENT MARKINGS AND PAVEMENT MARKERS

SHEET No.	LOCATION/STATION	DIRECTION	DETAIL No.	THERMOPLASTIC TRAFFIC STRIPE (ENHANCED WET NIGHT VISIBILITY)		TRAFFIC STRIPE TAPE (WARRANTY)					THERMOPLASTIC PAVEMENT MARKING (BIKE LANE TREATMENT)	THERMOPLASTIC CROSSWALK AND PAVEMENT MARKING (ENHANCED WET NIGHT VISIBILITY)		PAVEMENT MARKERS (RETRO-REFLECTIVE)		DELINEATOR (CLASS 1)	DESCRIPTION/COMMENTS	REMOVE THERMOPLASTIC TRAFFIC STRIPE	REMOVE THERMOPLASTIC PAVEMENT MARKING	REMOVE MARKER
				6" WHITE	6" YELLOW	6" WHITE				8" WHITE										
				WHITE SOLID	YELLOW SOLID	BROKEN (17-7)	BROKEN (6-1)	SOLID	BROKEN (8-4)	WHITE SOLID	GREEN	WHITE	YELLOW	G	RY			LF	SQFT	EA
				LF							SQFT			EA						
	"A1" 1048+00 TO 1063+12	NB	39					1468								74				
	"A1" 1048+00 TO 1063+12	NB	39A						162											
	"A1" 1048+00 TO 1063+12	NB									520						GREEN SKIP			
	"A1" 1048+00 TO 1063+12	SB	39A						158											
	"A1" 1048+00 TO 1063+12	SB	39	1279							280					64	GREEN SKIP			
	"A1" 1048+00 TO 1048+56	N/A										110					LIMIT LINE			
	"A1" 1049+58 TO 1063+12	SB										126					TYPE III (L)			
	"A1" 1061+17 TO 1063+12	NB										126					TYPE III (L)			
	"A1" 1048+00 TO 1063+12	NB	25A		1365										70					
	"A1" 1048+43 TO 1048+56	N/A										110					LIMIT LINE			
PD-7	"A1" 1048+20 TO 1048+49	NB	38							30				7						
	"A1" 1061+15 TO 1063+15	NB	38							197				9						
	"A1" 1049+56 TO 1063+20	SB	25A		1365										58					
	"A1" 1049+56 TO 1052+80	SB	38							313				13						
	"A1" 1048+33 TO 1048+74											706					LADDER CROSSWALK			
	"A1" 1048+33 TO 1049+37											750					LADDER CROSSWALK			
	"A1" 1048+74 TO 1049+59											710					LADDER CROSSWALK			
	"A1" 1049+37 TO 1049+59											650					LADDER CROSSWALK			
	"A1" 1063+17 TO 1063+21											520					LADDER CROSSWALK			
	"A1" 1059+80 TO 1060+10											420					LADDER CROSSWALK		20	
	"A1" 1064+36 TO 1066+16	SB										168					TYPE III (L)			
	"A1" 1075+25 TO 1076+22	NB										84					TYPE III (L)			
	"A1" 1076+80 TO 1077+85	SB										84					TYPE III (L)			
	"A1" 1065+30 TO 1078+50	NB										42					BIKE LANE SYMBOL			
	"A1" 1065+30 TO 1078+50	NB									256						GREEN PAVEMENT			
	"A1" 1064+40 TO 1078+50	NB	25A		1206										52					
	"A1" 1064+40 TO 1078+50	NB	39A						355											
	"A1" 1064+40 TO 1078+50	NB									2160						GREEN SKIP			
PD-8	"A1" 1065+30 TO 1078+50	NB	39					859								43				
	"A1" 1065+30 TO 1078+50	SB									775						GREEN SOLID			
	"A1" 1065+30 TO 1078+50	SB	39					1139								56				
	"A1" 1064+40 TO 1078+50	SB	39A						370											
	"A1" 1064+40 TO 1078+50	SB									2015						GREEN SKIP			
	"A1" 1063+00 TO 1064+50											1,100					LADDER CROSSWALK			
	"A1" 1063+00 TO 1064+50											1,100					LADDER CROSSWALK			
	"A1" 1063+00 TO 1064+50											1,200					LADDER CROSSWALK			
	"A1" 1063+00 TO 1064+50											1,200					LADDER CROSSWALK			
	"A1" 1067+10 TO 1067+40											880					LADDER CROSSWALK		40	
	"A1" 1063+77 TO 1064+23		40				100													
	SHEET TOTAL			1279	3936		100	3466	1045	540	6006	10,086		29	180	237			60	

PAVEMENT DELINEATION QUANTITIES

PDQ-5

STATE OF CALIFORNIA - DEPARTMENT OF TRANSPORTATION
Caltrans®
DESIGN

FUNCTIONAL SUPERVISOR: TAM LY
CALCULATED-DESIGNED BY: QUYNH NGUYEN
CHECKED BY: SON LY
REVISED BY: TG
DATE REVISED: 11-28-22

LAST REVISION: DATE PLOTTED => 18-NOV-2024
12-07-22 TIME PLOTTED => 16:08

BORDER LAST REVISED 7/2/2010
USERNAME => s129144
DGN FILE => 0419000140nc005.cco
RELATIVE BORDER SCALE IS IN INCHES 0 1 2 3
UNIT 0712
PROJECT NUMBER & PHASE 04190001401

CONTRACT CHANGE ORDER NO. 20
SHEET _____ OF _____

20 **REPLACED PER CONTRACT CHANGE ORDER No. 20 DATED**

REGISTERED PROFESSIONAL ENGINEER — Son Thanh Ly — No. 72584 — Exp. 6-30-26 — CIVIL — STATE OF CALIFORNIA

20

FOR REVISION ONLY
July 22, 2024
DATE

Dist	COUNTY	ROUTE	POST MILES TOTAL PROJECT	SHEET No.	TOTAL SHEETS
04	SCI	82	18.2/26.4	253A	466

AS-AWARDED CONTRACT PLANS
THIS STAMP PLACED IN LIEU OF ORIGINAL SIGNATURE

REGISTERED CIVIL ENGINEER DATE

PLANS APPROVAL DATE

REGISTERED PROFESSIONAL ENGINEER — No. _____ — Exp. _____ — CIVIL — STATE OF CALIFORNIA

THE STATE OF CALIFORNIA OR ITS OFFICERS OR AGENTS SHALL NOT BE RESPONSIBLE FOR THE ACCURACY OR COMPLETENESS OF SCANNED COPIES OF THIS PLAN SHEET.

TRAFFIC STRIPES, PAVEMENT MARKINGS AND PAVEMENT MARKERS

SHEET No.	LOCATION/STATION	DIRECTION	DETAIL No.	THERMOPLASTIC TRAFFIC STRIPE (ENHANCED WET NIGHT VISIBILITY)		TRAFFIC STRIPE TAPE (WARRANTY)			THERMOPLASTIC CROSSWALK AND PAVEMENT MARKING (ENHANCED WET NIGHT VISIBILITY)		PAVEMENT MARKERS (RETRORE-FLECTIVE)		DESCRIPTION/COMMENTS	REMOVE THERMOPLASTIC TRAFFIC STRIPE	REMOVE THERMOPLASTIC PAVEMENT MARKING	REMOVE MARKER
				6" WHITE	6" YELLOW	6" WHITE		8" WHITE								
				WHITE SOLID	YELLOW SOLID	BROKEN (17-7)	BROKEN (6-1)	WHITE SOLID	WHITE	YELLOW	G	RY				
				LF					SQFT		EA			LF	SQFT	EA
PD-7	"A1" 1048+00 TO 1048+56	N/A							110				LIMIT LINE			
	"A1" 1049+58 TO 1063+12	SB							126				TYPE III (L)			
	"A1" 1061+17 TO 1063+12	NB							126				TYPE III (L)			
	"A1" 1048+00 TO 1063+12	NB	25A		1365							70				
	"A1" 1048+43 TO 1048+56	N/A							110				LIMIT LINE			
	"A1" 1048+20 TO 1048+49	NB	38					30			7					
	"A1" 1061+15 TO 1063+15	NB	38					197			9					
	"A1" 1049+56 TO 1063+20	SB	25A		1365							58				
	"A1" 1049+56 TO 1052+80	SB	38					313			13					
	"A1" 1048+33 TO 1048+74								706				LADDER CROSSWALK			
	"A1" 1048+33 TO 1049+37								750				LADDER CROSSWALK			
	"A1" 1048+74 TO 1049+59								710				LADDER CROSSWALK			
	"A1" 1049+37 TO 1049+59								650				LADDER CROSSWALK			
	"A1" 1063+17 TO 1063+21								520				LADDER CROSSWALK			
	"A1" 1059+80 TO 1060+10								420				LADDER CROSSWALK		20	
PD-8	"A1" 1064+36 TO 1066+16	SB							168				TYPE III (L)			
	"A1" 1075+25 TO 1076+22	NB							84				TYPE III (L)			
	"A1" 1076+80 TO 1077+85	SB							84				BIKE LANE SYMBOL			
	"A1" 1065+30 TO 1078+50	NB											GREEN PAVEMENT			
	"A1" 1064+40 TO 1078+50	NB	25A		1206							52				
	"A1" 1063+00 TO 1064+50								1,100				LADDER CROSSWALK			
	"A1" 1063+00 TO 1064+50								1,100				LADDER CROSSWALK			
	"A1" 1063+00 TO 1064+50								1,200				LADDER CROSSWALK			
	"A1" 1063+00 TO 1064+50								1,200				LADDER CROSSWALK			
	"A1" 1067+10 TO 1067+40								880				LADDER CROSSWALK		40	
	"A1" 1063+77 TO 1064+23		40				100									
SHEET TOTAL				1279	3936		100	540	10,044		29	180			60	

CALCULATED-DESIGNED BY: QUYNH NGUYEN
CHECKED BY: SON LY
FUNCTIONAL SUPERVISOR: TAM LY
REVISED BY: TG — DATE REVISED: 11-28-22

STATE OF CALIFORNIA - DEPARTMENT OF TRANSPORTATION
DESIGN

PAVEMENT DELINEATION QUANTITIES

PDQ-5A

LAST REVISION | DATE PLOTTED => 18-NOV-2024
12-07-22 | TIME PLOTTED => 16:08

BORDER LAST REVISED 7/2/2010

USERNAME => s129144
DGN FILE => 041900014onc005A.cco

RELATIVE BORDER SCALE IS IN INCHES 0 1 2 3

UNIT 0712 | PROJECT NUMBER & PHASE 04190001401

CONTRACT CHANGE ORDER NO. 20
SHEET _____ OF _____

20 **SHEET DELETED PER CONTRACT CHANGE ORDER No. 20**

Son Thanh Ly
No. 72584
Exp. 6-30-26
CIVIL
STATE OF CALIFORNIA
REGISTERED PROFESSIONAL ENGINEER

20

FOR REVISION ONLY
July 22, 2024
DATE

Dist	COUNTY	ROUTE	POST MILES TOTAL PROJECT	SHEET No.	TOTAL SHEETS
04	SCI	82	18.2/26.4	254	466

AS-AWARDED CONTRACT PLANS
THIS STAMP PLACED IN LIEU OF ORIGINAL SIGNATURE
REGISTERED CIVIL ENGINEER DATE

January 20, 2023
PLANS APPROVAL DATE

THE STATE OF CALIFORNIA OR ITS OFFICERS OR AGENTS SHALL NOT BE RESPONSIBLE FOR THE ACCURACY OR COMPLETENESS OF SCANNED COPIES OF THIS PLAN SHEET.

REGISTERED PROFESSIONAL ENGINEER No. Exp. CIVIL STATE OF CALIFORNIA

TRAFFIC STRIPES, PAVEMENT MARKINGS AND PAVEMENT MARKERS

SHEET No.	LOCATION/STATION	DIRECTION	DETAIL No.	THERMOPLASTIC TRAFFIC STRIPE (ENHANCED WET NIGHT VISIBILITY)		TRAFFIC STRIPE TAPE (WARRANTY)					THERMOPLASTIC PAVEMENT MARKING (BIKE LANE TREATMENT)	THERMOPLASTIC CROSSWALK AND PAVEMENT MARKING (ENHANCED WET NIGHT VISIBILITY)		PAVEMENT MARKERS (RETRO-REFLECTIVE)		DELINEATOR (CLASS 1)	DESCRIPTION/COMMENTS	REMOVE THERMOPLASTIC TRAFFIC STRIPE	REMOVE THERMOPLASTIC PAVEMENT MARKING	REMOVE MARKER
				6" WHITE	6" YELLOW	6" WHITE				8" WHITE										
				WHITE SOLID	YELLOW SOLID	BROKEN (17-7)	BROKEN (6-1)	SOLID	BROKEN (8-4)	WHITE SOLID	GREEN	WHITE	YELLOW	G	RY			LF	SQFT	EA
				LF								SQFT		EA						
	"A1" 1070+70 TO 1071+15											420					LADDER CROSSWALK		40	
	"A1" 1074+00 TO 1074+50											1900					LADDER CROSSWALK		20	
	"A1" 1064+37 TO 1066+21	SB	38							304				13						
PD-8	"A1" 1075+26 TO 1076+31	NB	38							104				5						
	"A1" 1064+46 TO 1088+58	NB	9			2640								55						
	"A1" 1064+22 TO 1088+52	SB	9			2640								55						
	"A1" 1076+79 TO 1088+49	SB	25A		1170										50					
	"A1" 1086+08 TO 1088+47	NB										252					TYPE III (L)			
	"A1" 1091+20 TO 1092+30	NB										84					TYPE III (R)			
	"A1" 1078+50 TO 1092+50	NB										63					BIKE LANE SYMBOL			
	"A1" 1078+50 TO 1092+50	NB									384						GREEN PAVEMENT			
	"A1" 1078+50 TO 1092+50	SB										63					BIKE LANE SYMBOL			
	"A1" 1078+50 TO 1092+50	SB									384						GREEN PAVEMENT			
	"A1" 1078+50 TO 1092+50	NB	39					1726								86				
	"A1" 1078+50 TO 1092+50	NB	39A						198											
	"A1" 1078+50 TO 1092+50	NB									860						GREEN SKIP			
	"A1" 1078+50 TO 1092+50	SB									120						GREEN SKIP			
	"A1" 1078+50 TO 1092+50	SB	39					1597								80				
	"A1" 1078+50 TO 1092+50	SB	39A						187											
	"A1" 1078+50 TO 1092+50	SB									800						GREEN SKIP			
PD-9	"A1" 1088+49 TO 1088+60	N/A										600					LADDER CROSSWALK			
	"A1" 1088+60 TO 1089+39	N/A										420					LADDER CROSSWALK			
	"A1" 1088+43 TO 1088+44	N/A										55					LIMIT LINE			
	"A1" 1078+50 TO 1092+50	N/A	39A						63											
	"A1" 1078+50 TO 1092+50	N/A									160						GREEN SKIP			
	"A1" 1089+53 TO 1089+54	N/A										60					LIMIT LINE			
	"A1" 1078+50 TO 1092+50	NB	38							691				30						
	"A1" 1078+50 TO 1092+50	SB	38							100				5						
	"A1" 1079+50 TO 1080+50	SB										45		5			NO U TURN			
	"A1" 1079+50											25					U ARROW			
	"A1" 1091+00 TO 1092+10	SB	38							110										
	"A1" 1078+50 TO 1092+50	NB	9			890								19						
	"A1" 1078+50 TO 1092+50	SB	9			890								19						
	"A1" 1078+50 TO 1092+50	NB	25A		1200										50					
	"A1" 1078+50 TO 1092+50	SB	25A		1200										50					
	"A1" 1088+50 TO 1089+40		40				200													
	SHEET TOTAL			3570	7060	200	3323	448	1309		2708	3987		206	150	166			60	

PAVEMENT DELINEATION QUANTITIES

PDQ-6

STATE OF CALIFORNIA - DEPARTMENT OF TRANSPORTATION
DESIGN
FUNCTIONAL SUPERVISOR: TAM LY
CALCULATED-DESIGNED BY: QUYNH NGUYEN
CHECKED BY: SON LY
REVISED BY: TG
DATE REVISED: 11-28-22

LAST REVISION
DATE PLOTTED => 18-NOV-2024
TIME PLOTTED => 16:08
12-07-22

BORDER LAST REVISED 7/2/2010
USERNAME => s129144
DGN FILE => 0419000140nc006.cco
RELATIVE BORDER SCALE IS IN INCHES 0 1 2 3
UNIT 0712
PROJECT NUMBER & PHASE 04190001401

Dist	COUNTY	ROUTE	POST MILES TOTAL PROJECT	SHEET No.	TOTAL SHEETS
04	SCI	82	18.2/26.4	254A	466

AS-AWARDED CONTRACT PLANS
THIS STAMP PLACED IN LIEU OF ORIGINAL SIGNATURE

REGISTERED CIVIL ENGINEER DATE

PLANS APPROVAL DATE

THE STATE OF CALIFORNIA OR ITS OFFICERS OR AGENTS SHALL NOT BE RESPONSIBLE FOR THE ACCURACY OR COMPLETENESS OF SCANNED COPIES OF THIS PLAN SHEET.

REGISTERED PROFESSIONAL ENGINEER — Son Thanh Ly — No. 72584 — Exp. 6-30-26 — CIVIL — STATE OF CALIFORNIA

20

FOR REVISION ONLY
July 22, 2024
DATE

CONTRACT CHANGE ORDER NO. 20
SHEET _____ OF _____

20 **REPLACED PER CONTRACT CHANGE ORDER No. 20 DATED**

TRAFFIC STRIPES, PAVEMENT MARKINGS AND PAVEMENT MARKERS

SHEET No.	LOCATION/STATION	DIRECTION	DETAIL No.	THERMOPLASTIC TRAFFIC STRIPE (ENHANCED WET NIGHT VISIBILITY)		TRAFFIC STRIPE TAPE (WARRANTY)			THERMOPLASTIC CROSSWALK AND PAVEMENT MARKING (ENHANCED WET NIGHT VISIBILITY)		PAVEMENT MARKERS (RETRO-REFLECTIVE)		DESCRIPTION/COMMENTS	REMOVE THERMOPLASTIC TRAFFIC STRIPE	REMOVE THERMOPLASTIC PAVEMENT MARKING	REMOVE MARKER
				6" WHITE	6" YELLOW	6" WHITE		8" WHITE								
				WHITE SOLID	YELLOW SOLID	BROKEN (17-7)	BROKEN (6-1)	WHITE SOLID	WHITE	YELLOW	G	RY				
				LF					SQFT		EA			LF	SQFT	EA
	"A1" 1070+70 TO 1071+15								420				LADDER CROSSWALK		40	
	"A1" 1074+00 TO 1074+50								1900				LADDER CROSSWALK		20	
	"A1" 1064+37 TO 1066+21	SB	38					304			13					
PD-8	"A1" 1075+26 TO 1076+31	NB	38					104			5					
	"A1" 1064+46 TO 1088+58	NB	9			2640					55					
	"A1" 1064+22 TO 1088+52	SB	9			2640					55					
	"A1" 1076+79 TO 1088+49	SB	25A		1170							50				
	"A1" 1086+08 TO 1088+47	NB							252				TYPE III (L)			
	"A1" 1091+20 TO 1092+30	NB							84				TYPE III (R)			
	"A1" 1088+49 TO 1088+60	N/A							600				LADDER CROSSWALK			
	"A1" 1088+60 TO 1089+39	N/A							420				LADDER CROSSWALK			
	"A1" 1088+43 TO 1088+44	N/A							55				LIMIT LINE			
	"A1" 1078+50 TO 1092+50	N/A	39A													
	"A1" 1089+53 TO 1089+54	N/A							60				LIMIT LINE			
PD-9	"A1" 1078+50 TO 1092+50	NB	38					691			30					
	"A1" 1078+50 TO 1092+50	SB	38					100			5					
	"A1" 1079+50 TO 1080+50	SB							45		5		NO U TURN			
	"A1" 1079+50								25				U ARROW			
	"A1" 1091+00 TO 1092+10	SB	38					110								
	"A1" 1078+50 TO 1092+50	NB	9			890					19					
	"A1" 1078+50 TO 1092+50	SB	9			890					19					
	"A1" 1078+50 TO 1092+50	NB	25A		1200							50				
	"A1" 1078+50 TO 1092+50	SB	25A		1200							50				
	"A1" 1088+50 TO 1089+40		40				200									
SHEET TOTAL					3570	7060	200	1309	3861		206	150			60	

PAVEMENT DELINEATION QUANTITIES

PDQ-6A

CALCULATED-DESIGNED BY: QUYNH NGUYEN
CHECKED BY: SON LY
REVISED BY: TG
DATE REVISED: 11-28-22
FUNCTIONAL SUPERVISOR: TAM LY

STATE OF CALIFORNIA - DEPARTMENT OF TRANSPORTATION
DESIGN

LAST REVISION: DATE PLOTTED => 18-NOV-2024
12-07-22 TIME PLOTTED => 16:08

BORDER LAST REVISED 7/2/2010
USERNAME => s129144
DGN FILE => 0419000140nc006A.cco
RELATIVE BORDER SCALE IS IN INCHES 0 1 2 3
UNIT 0712
PROJECT NUMBER & PHASE 04190001401

CONTRACT CHANGE ORDER NO. 20
SHEET _____ OF _____

20 **SHEET DELETED PER CONTRACT CHANGE ORDER No. 20 DATED**

REGISTERED PROFESSIONAL ENGINEER — Son Thanh Ly — No. 72584 — Exp. 6-30-26 — CIVIL — STATE OF CALIFORNIA

FOR REVISION ONLY
July 22, 2024
DATE

20

Dist	COUNTY	ROUTE	POST MILES TOTAL PROJECT	SHEET No.	TOTAL SHEETS
04	SCI	82	18.2/26.4	255	466

AS-AWARDED CONTRACT PLANS
THIS STAMP PLACED IN LIEU OF ORIGINAL SIGNATURE
REGISTERED CIVIL ENGINEER DATE
PLANS APPROVAL DATE

REGISTERED PROFESSIONAL ENGINEER — No. _____ — Exp. _____ — CIVIL — STATE OF CALIFORNIA

THE STATE OF CALIFORNIA OR ITS OFFICERS OR AGENTS SHALL NOT BE RESPONSIBLE FOR THE ACCURACY OR COMPLETENESS OF SCANNED COPIES OF THIS PLAN SHEET.

TRAFFIC STRIPES, PAVEMENT MARKINGS AND PAVEMENT MARKERS

SHEET No.	LOCATION/STATION	DIRECTION	DETAIL No.	THERMOPLASTIC TRAFFIC STRIPE (ENHANCED WET NIGHT VISIBILITY)		TRAFFIC STRIPE TAPE (WARRANTY)					THERMOPLASTIC PAVEMENT MARKING (BIKE LANE TREATMENT)	THERMOPLASTIC CROSSWALK AND PAVEMENT MARKING (ENHANCED WET NIGHT VISIBILITY)		PAVEMENT MARKERS (RETRO-REFLECTIVE)		DELINEATOR (CLASS 1)	DESCRIPTION/COMMENTS	REMOVE THERMOPLASTIC TRAFFIC STRIPE	REMOVE THERMOPLASTIC PAVEMENT MARKING	REMOVE MARKER
				6" WHITE	6" YELLOW	6" WHITE				8" WHITE										
				WHITE SOLID	YELLOW SOLID	BROKEN (17-7)	BROKEN (6-1)	SOLID	BROKEN (8-4)	WHITE SOLID	GREEN	WHITE	YELLOW	G	RY			LF	SQFT	EA
				LF							SQFT			EA						
	"A1" 1092+50 TO 1106+40	NB	9			1168								25						
	"A1" 1092+50 TO 1106+40	SB	9			1168								25						
	"A1" 1092+48 TO 1093+86	NB										84					TYPE III (L)			
	"A1" 1095+28 TO 1097+46	SB										126					TYPE III (L)			
	"A1" 1098+53 TO 1100+22	NB										84					TYPE III (L)			
	"A1" 1101+55 TO 1102+88	SB										84					TYPE III (L)			
	"A1" 1095+40 TO 1106+30	NB										63					6 BIKE LANE SYMBOL			
	"A1" 1095+40 TO 1106+30	NB										384					6 GREEN PAVEMENT			
	"A1" 1093+80 TO 1105+65	SB										53					5 BIKE LANE SYMBOL			
	"A1" 1093+80 TO 1105+65	SB										320					5 GREEN PAVEMENT			
	"A1" 1095+22 TO 1100+31		25A		1350										60					
	"A1" 1093+05 TO 1095+28	NB	39A						372											
	"A1" 1093+05 TO 1097+48	NB									1760						GREEN SKIP			
PD-10	"A1" 1100+80 TO 1101+10											180					LADDER CROSSWALK			
	"A1" 1097+48 TO 1098+89	NB	39					1157								58				
	"A1" 1093+99 TO 1095+15	SB									1200						GREEN SKIP			
	"A1" 1093+99 TO 1095+15	SB	39A						224											
	"A1" 1094+03 TO 1094+10											570					LADDER CROSSWALK			
	"A1" 1095+14 TO 1095+15											598					LADDER CROSSWALK			
	"A1" 1094+14 TO 1095+14											210					LADDER CROSSWALK			
	"A1" 1100+18 TO 1100+50											598					LADDER CROSSWALK			
	"A1" 1093+96 TO 1093+98											60					LIMIT LINE			
	"A1" 1095+20 TO 1095+25											50					LIMIT LINE			
	"A1" 1100+15 TO 1100+23											50					LIMIT LINE			
	"A1" 1101+36 TO 1101+37											50					LIMIT LINE			
	"A1" 1092+47 TO 1093+98	NB	38							356				8						
	"A1" 1095+23 TO 1097+47	SB	38							377				10						
	"A1" 1094+50											15					TYPE IV (R)			
	"A1" 1094+50											54					TYPE VII (L)			
	"A1" 1094+50		22		100									4						
	"A1" 1101+40 TO 1112+94	NB	9			1154								25						
PD-10	"A1" 1101+39 TO 1112+98	SB	9			1159								25						
TO	"A1" 1101+36 TO 1112+96		25A		1160										50					
PD-11	"A1" 1103+20 TO 1106+48	NB	39					720								36				
	"A1" 1106+12 TO 1108+40	SB	39					500								25				
	"A1" 1114+00 TO 1117+23	NB	9			645								14						
	"A1" 1114+05 TO 1117+28	SB	9			645								14						
	"A1" 1111+44 TO 1112+92	NB										84					TYPE III (L)			
PD-11	"A1" 1114+04 TO 1115+25	SB										168					TYPE III (L)			
	"A1" 1116+03 TO 1117+13	NB										84					TYPE III (L)			
	"A1" 1118+30 TO 1118+30	SB										42					TYPE III (L)			
SHEET TOTAL					2610	5939		2377	596	733	2960	4011		150	110	119				

PAVEMENT DELINEATION QUANTITIES

PDQ-7

STATE OF CALIFORNIA - DEPARTMENT OF TRANSPORTATION
DESIGN
FUNCTIONAL SUPERVISOR: TAM LY
CALCULATED-DESIGNED BY: QUYNH NGUYEN
CHECKED BY: SON LY
REVISED BY: TG
DATE REVISED: 11-28-22

LAST REVISION DATE PLOTTED => 18-NOV-2024
TIME PLOTTED => 16:08
12-07-22

BORDER LAST REVISED 7/2/2010
USERNAME => s129144
DGN FILE => 0419000140nc007.cco
RELATIVE BORDER SCALE IS IN INCHES 0 1 2 3
UNIT 0712
PROJECT NUMBER & PHASE 04190001401

CONTRACT CHANGE ORDER NO. 20
SHEET ____ OF ____

20 REPLACED PER CONTRACT CHANGE ORDER No. 20

REGISTERED PROFESSIONAL ENGINEER
Son Thanh Ly
No. 72584
Exp. 6-30-26
CIVIL
STATE OF CALIFORNIA

Son Thanh Ly
FOR REVISION ONLY
July 22, 2024
DATE

20

Dist	COUNTY	ROUTE	POST MILES TOTAL PROJECT	SHEET No.	TOTAL SHEETS
04	SCI	82	18.2/26.4	255A	466

AS-AWARDED CONTRACT PLANS
THIS STAMP PLACED IN LIEU OF ORIGINAL SIGNATURE
REGISTERED CIVIL ENGINEER DATE
PLANS APPROVAL DATE

REGISTERED PROFESSIONAL ENGINEER
No. ____
Exp. ____
CIVIL
STATE OF CALIFORNIA

THE STATE OF CALIFORNIA OR ITS OFFICERS OR AGENTS SHALL NOT BE RESPONSIBLE FOR THE ACCURACY OR COMPLETENESS OF SCANNED COPIES OF THIS PLAN SHEET.

TRAFFIC STRIPES, PAVEMENT MARKINGS AND PAVEMENT MARKERS

SHEET No.	LOCATION/STATION	DIRECTION	DETAIL No.	THERMOPLASTIC TRAFFIC STRIPE (ENHANCED WET NIGHT VISIBILITY)		TRAFFIC STRIPE TAPE (WARRANTY)			THERMOPLASTIC CROSSWALK AND PAVEMENT MARKING (ENHANCED WET NIGHT VISIBILITY)		PAVEMENT MARKERS (RETRORE-FLECTIVE)		DESCRIPTION/COMMENTS	REMOVE THERMOPLASTIC TRAFFIC STRIPE	REMOVE THERMOPLASTIC PAVEMENT MARKING	REMOVE MARKER
				6" WHITE	6" YELLOW	6" WHITE		8" WHITE	WHITE	YELLOW	G	RY				
				WHITE SOLID	YELLOW SOLID	BROKEN (17-7)	BROKEN (6-1)	WHITE SOLID								
				LF					SQFT		EA			LF	SQFT	EA
	"A1" 1092+50 TO 1106+40	NB	9			1168					25					
	"A1" 1092+50 TO 1106+40	SB	9			1168					25					
	"A1" 1092+48 TO 1093+86	NB							84				TYPE III (L)			
	"A1" 1095+28 TO 1097+46	SB							126				TYPE III (L)			
	"A1" 1098+53 TO 1100+22	NB							84				TYPE III (L)			
	"A1" 1101+55 TO 1102+88	SB							84				TYPE III (L)			
	"A1" 1095+22 TO 1100+31		25A		1350							60				
	"A1" 1093+05 TO 1095+28	NB	39A													
	"A1" 1100+80 TO 1101+10								180				LADDER CROSSWALK			
	"A1" 1094+03 TO 1094+10								570				LADDER CROSSWALK			
PD-10	"A1" 1095+14 TO 1095+15								598				LADDER CROSSWALK			
	"A1" 1094+14 TO 1095+14								210				LADDER CROSSWALK			
	"A1" 1100+18 TO 1100+50								598				LADDER CROSSWALK			
	"A1" 1093+96 TO 1093+98								60				LIMIT LINE			
	"A1" 1095+20 TO 1095+25								50				LIMIT LINE			
	"A1" 1100+15 TO 1100+23								50				LIMIT LINE			
	"A1" 1101+36 TO 1101+37								50				LIMIT LINE			
	"A1" 1092+47 TO 1093+98	NB	38					356			8					
	"A1" 1095+23 TO 1097+47	SB	38					377			10					
	"A1" 1094+50								15				TYPE IV (R)			
	"A1" 1094+50								54				TYPE VII (L)			
	"A1" 1094+50		22		100						4					
PD-10	"A1" 1101+40 TO 1112+94	NB	9			1154					25					
TO	"A1" 1101+39 TO 1112+98	SB	9			1159					25					
PD-11	"A1" 1101+36 TO 1112+96		25A		1160							50				
	"A1" 1114+00 TO 1117+23	NB	9			645					14					
	"A1" 1114+05 TO 1117+28	SB	9			645					14					
	"A1" 1111+44 TO 1112+92	NB							84				TYPE III (L)			
PD-11	"A1" 1114+04 TO 1115+25	SB							168				TYPE III (L)			
	"A1" 1116+03 TO 1117+13	NB							84				TYPE III (L)			
	"A1" 1118+30 TO 1118+30	SB							42				TYPE III (L)			
SHEET TOTAL					2610	5939		733	3191		150	110				

PAVEMENT DELINEATION QUANTITIES

PDQ-7A

CALCULATED-DESIGNED BY: QUYNH NGUYEN
CHECKED BY: SON LY
REVISED BY: TG
DATE REVISED: 11-28-22
FUNCTIONAL SUPERVISOR: TAM LY

STATE OF CALIFORNIA - DEPARTMENT OF TRANSPORTATION
DESIGN

LAST REVISION DATE PLOTTED => 18-NOV-2024
12-07-22 TIME PLOTTED => 16:08

BORDER LAST REVISED 7/2/2010
USERNAME => s129144
DGN FILE => 0419000140nc007A.cco
RELATIVE BORDER SCALE IS IN INCHES 0 1 2 3
UNIT 0712
PROJECT NUMBER & PHASE 04190001401

CONTRACT CHANGE ORDER NO. 20
SHEET _____ OF _____

20 SHEET DELETED PER CONTRACT CHANGE ORDER No. 20 DATED

TRAFFIC STRIPES, PAVEMENT MARKINGS AND PAVEMENT MARKERS

Son Thanh Ly
No. 72584
Exp. 6-30-26
CIVIL
STATE OF CALIFORNIA
REGISTERED PROFESSIONAL ENGINEER

20

FOR REVISION ONLY
July 22, 2024
DATE

Dist	COUNTY	ROUTE	POST MILES TOTAL PROJECT	SHEET No.	TOTAL SHEETS
04	SCI	82	18.2/26.4	256	466

AS-AWARDED CONTRACT PLANS
THIS STAMP PLACED IN LIEU OF ORIGINAL SIGNATURE
REGISTERED CIVIL ENGINEER DATE
January 20, 2023
PLANS APPROVAL DATE

THE STATE OF CALIFORNIA OR ITS OFFICERS OR AGENTS SHALL NOT BE RESPONSIBLE FOR THE ACCURACY OR COMPLETENESS OF SCANNED COPIES OF THIS PLAN SHEET.

REGISTERED PROFESSIONAL ENGINEER No. Exp. CIVIL STATE OF CALIFORNIA

SHEET No.	LOCATION/STATION	DIRECTION	DETAIL No.	THERMOPLASTIC TRAFFIC STRIPE (ENHANCED WET NIGHT VISIBILITY)		TRAFFIC STRIPE TAPE (WARRANTY)					THERMOPLASTIC PAVEMENT MARKING (BIKE LANE TREATMENT)	THERMOPLASTIC CROSSWALK AND PAVEMENT MARKING (ENHANCED WET NIGHT VISIBILITY)		PAVEMENT MARKERS (RETRORE-FLECTIVE)		DELINEATOR (CLASS 1)	DESCRIPTION/COMMENTS	REMOVE THERMOPLASTIC TRAFFIC STRIPE	REMOVE THERMOPLASTIC PAVEMENT MARKING	REMOVE MARKER
				6" WHITE	6" YELLOW	6" WHITE				8" WHITE										
				WHITE SOLID	YELLOW SOLID	BROKEN (17-7)	BROKEN (6-1)	SOLID	BROKEN (8-4)	WHITE SOLID	GREEN	WHITE	YELLOW	G	RY			LF	SQFT	EA
				LF							SQFT			EA						
	"A1" 1108+42 TO 1119+41	NB										52.5					5 BIKE LANE SYMBOL			
	"A1" 1108+42 TO 1119+41	NB										320					5 GREEN PAVEMENT			
	"A1" 1108+15 TO 1119+72	SB										52.5					5 BIKE LANE SYMBOL			
	"A1" 1108+15 TO 1119+72	SB										320					5 GREEN PAVEMENT			
	"A1" 1113+92 TO 1117+28		25A		680										32					
	"A1" 1106+48 TO 1106+83	NB										1080					GREEN SKIP			
	"A1" 1106+48 TO 1106+83	NB	39A						210											
	"A1" 1106+83 TO 1107+85	NB	39					1412								70				
	"A1" 1117+55 TO 1118+00	N/A										300					LADDER CROSSWALK			
	"A1" 1117+31 TO 1118+16	NB										422					GREEN SOLID			
	"A1" 1108+40 TO 1108+68	SB									1260						GREEN SKIP			
PD-11	"A1" 1108+40 TO 1108+68	SB	39A						240											
	"A1" 1108+68 TO 1110+01	SB	39					1186								60				
	"A1" 1112+90 TO 1113+93											180					CROSSWALK			
	"A1" 1113+82 TO 1113+99											624					LADDER CROSSWALK			
	"A1" 1117+20 TO 1117+38											570					LADDER CROSSWALK			
	"A1" 1118+10 TO 1118+16											570					LADDER CROSSWALK			
	"A1" 1112+90 TO 1112+94											60					LIMIT LINE			
	"A1" 1113+82 TO 1113+99											60					LIMIT LINE			
	"A1" 1117+15 TO 1117+18											50					LIMIT LINE			
	"A1" 1118+23 TO 1118+25											50					LIMIT LINE			
	"A1" 1111+42 TO 1112+93	NB	38							266				11						
	"A1" 1113+98 TO 1115+27	SB	38							352				11						
	"A1" 1118+18 TO 1122+87	NB	9			938								20						
	"A1" 1118+28 TO 1122+87	SB	9			918								20						
PD-11 TO PD-12	"A1" 1118+16 TO 1122+86		25A		940										40					
	"A1" 1120+10 TO 1120+56	NB									80						GREEN SKIP			
	"A1" 1120+10 TO 1120+56	NB	39A						15											
	"A1" 1120+22 TO 1121+89	SB	39					366								18				
	"A1" 1123+87 TO 1127+62	NB	9			750								16			"SHARROW" TEXT (2X)			
	"A1" 1123+87 TO 1127+65	SB	9			757								16			BIKE LANE SYMBOL (8X)			
	"A1" 1128+53 TO 1133+73	NB	9			1042								22						
	"A1" 1128+53 TO 1133+80	SB	9			1056								22						
PD-12	"A1" 1121+10 TO 1122+84	NB										84					TYPE III (L)			
	"A1" 1124+05 TO 1124+05	SB										42					TYPE III (L)			
	"A1" 1126+56 TO 1127+59	NB										84					TYPE III (L)			
	"A1" 1128+60 TO 1130+14	SB										84					TYPE III (L)			
	"A1" 1132+08 TO 1133+76	NB										84					TYPE III (L)			
	"A1" 1113+00 TO 1113+40		40				100													
SHEET TOTAL					1620	5461	100	2964	465	618	1340	5089		138	72	148				

QUYNH NGUYEN | CALCULATED-DESIGNED BY
SON LY | CHECKED BY
TG | REVISED BY
11-28-22 | DATE REVISED
FUNCTIONAL SUPERVISOR
TAM LY
STATE OF CALIFORNIA - DEPARTMENT OF TRANSPORTATION
DESIGN
Caltrans

PAVEMENT DELINEATION QUANTITIES

PDQ-8

LAST REVISION | DATE PLOTTED => 18-NOV-2024
12-07-22 | TIME PLOTTED => 16:09

BORDER LAST REVISED 7/2/2010 | USERNAME => s129144 | DGN FILE => 0419000140nc008.cco | RELATIVE BORDER SCALE IS IN INCHES 0 1 2 3 | UNIT 0712 | PROJECT NUMBER & PHASE 04190001401

CONTRACT CHANGE ORDER NO. 20
SHEET _____ OF _____

20 REPLACED PER CONTRACT CHANGE ORDER No. 20 DATED

Son Thanh Ly
No. 72584
Exp. 6-30-26
CIVIL
STATE OF CALIFORNIA
FOR REVISION ONLY
July 22, 2024
DATE

20

Dist	COUNTY	ROUTE	POST MILES TOTAL PROJECT	SHEET No.	TOTAL SHEETS
04	SCI	82	18.2/26.4	256A	466

AS-AWARDED CONTRACT PLANS
THIS STAMP PLACED IN LIEU OF ORIGINAL SIGNATURE
REGISTERED CIVIL ENGINEER DATE
PLANS APPROVAL DATE
REGISTERED PROFESSIONAL ENGINEER No. Exp. CIVIL STATE OF CALIFORNIA
THE STATE OF CALIFORNIA OR ITS OFFICERS OR AGENTS SHALL NOT BE RESPONSIBLE FOR THE ACCURACY OR COMPLETENESS OF SCANNED COPIES OF THIS PLAN SHEET.

TRAFFIC STRIPES, PAVEMENT MARKINGS AND PAVEMENT MARKERS

SHEET No.	LOCATION/STATION	DIRECTION	DETAIL No.	THERMOPLASTIC TRAFFIC STRIPE (ENHANCED WET NIGHT VISIBILITY)		TRAFFIC STRIPE TAPE (WARRANTY)			THERMOPLASTIC CROSSWALK AND PAVEMENT MARKING (ENHANCED WET NIGHT VISIBILITY)		PAVEMENT MARKERS (RETRO-REFLECTIVE)		DESCRIPTION/COMMENTS	REMOVE THERMOPLASTIC TRAFFIC STRIPE	REMOVE THERMOPLASTIC PAVEMENT MARKING	REMOVE MARKER
				6" WHITE	6" YELLOW	6" WHITE		8" WHITE								
				WHITE SOLID	YELLOW SOLID	BROKEN (17-7)	BROKEN (6-1)	WHITE SOLID	WHITE	YELLOW	G	RY				
				LF					SQFT		EA			LF	SQFT	EA
	"A1" 1113+92 TO 1117+28		25A		680							32				
	"A1" 1117+55 TO 1118+00	N/A							300				LADDER CROSSWALK			
	"A1" 1117+31 TO 1118+16	NB							422				GREEN SOLID			
	"A1" 1108+40 TO 1108+68	SB											GREEN SKIP			
	"A1" 1112+90 TO 1113+93								180				CROSSWALK			
	"A1" 1113+82 TO 1113+99								624				LADDER CROSSWALK			
	"A1" 1117+20 TO 1117+38								570				LADDER CROSSWALK			
PD-11	"A1" 1118+10 TO 1118+16								570				LADDER CROSSWALK			
	"A1" 1112+90 TO 1112+94								60				LIMIT LINE			
	"A1" 1113+82 TO 1113+99								60				LIMIT LINE			
	"A1" 1117+15 TO 1117+18								50				LIMIT LINE			
	"A1" 1118+23 TO 1118+25								50				LIMIT LINE			
	"A1" 1111+42 TO 1112+93	NB	38					266			11					
	"A1" 1113+98 TO 1115+27	SB	38					352			11					
PD-11	"A1" 1118+18 TO 1122+87	NB	9			938					20					
TO	"A1" 1118+28 TO 1122+87	SB	9			918					20					
PD-12	"A1" 1118+16 TO 1122+86		25A		940							40				
	"A1" 1123+87 TO 1127+62	NB	9			750					16					
	"A1" 1123+87 TO 1127+65	SB	9			757					16					
	"A1" 1128+53 TO 1133+73	NB	9			1042					22					
	"A1" 1128+53 TO 1133+80	SB	9			1056					22					
PD-12	"A1" 1121+10 TO 1122+84	NB							84				TYPE III (L)			
	"A1" 1124+05 TO 1124+05	SB							42				TYPE III (L)			
	"A1" 1126+56 TO 1127+59	NB							84				TYPE III (L)			
	"A1" 1128+60 TO 1130+14	SB							84				TYPE III (L)			
	"A1" 1132+08 TO 1133+76	NB							84				TYPE III (L)			
	"A1" 1113+00 TO 1113+40		40				100									
SHEET TOTAL					1620	5461	100	618	3264		138	72				

PAVEMENT DELINEATION QUANTITIES

PDQ-8A

STATE OF CALIFORNIA - DEPARTMENT OF TRANSPORTATION
Caltrans® DESIGN
FUNCTIONAL SUPERVISOR: TAM LY
CALCULATED-DESIGNED BY: QUYNH NGUYEN
CHECKED BY: SON LY
REVISED BY: TG
DATE REVISED: 11-28-22

LAST REVISION DATE PLOTTED => 18-NOV-2024
12-07-22 TIME PLOTTED => 16:09

BORDER LAST REVISED 7/2/2010
USERNAME => s129144
DGN FILE => 0419000140nc008A.cco
RELATIVE BORDER SCALE IS IN INCHES 0 1 2 3
UNIT 0712
PROJECT NUMBER & PHASE 04190001401

CONTRACT CHANGE ORDER NO. 20
SHEET _____ OF _____

20 SHEET DELETED PER CONTRACT CHANGE ORDER No. 20 DATED

TRAFFIC STRIPES, PAVEMENT MARKINGS AND PAVEMENT MARKERS

SHEET No.	LOCATION/STATION	DIRECTION	DETAIL No.	THERMOPLASTIC TRAFFIC STRIPE (ENHANCED WET NIGHT VISIBILITY) 6" WHITE WHITE SOLID	THERMOPLASTIC TRAFFIC STRIPE (ENHANCED WET NIGHT VISIBILITY) 6" YELLOW YELLOW SOLID	TRAFFIC STRIPE TAPE (WARRANTY) 6" WHITE BROKEN (17-7)	TRAFFIC STRIPE TAPE (WARRANTY) 6" WHITE BROKEN (6-1)	TRAFFIC STRIPE TAPE (WARRANTY) 6" WHITE SOLID	TRAFFIC STRIPE TAPE (WARRANTY) 6" WHITE BROKEN (8-4)	TRAFFIC STRIPE TAPE (WARRANTY) 8" WHITE WHITE SOLID	THERMOPLASTIC PAVEMENT MARKING (BIKE LANE TREATMENT) GREEN	THERMOPLASTIC CROSSWALK AND PAVEMENT MARKING (ENHANCED WET NIGHT VISIBILITY) WHITE	THERMOPLASTIC CROSSWALK AND PAVEMENT MARKING (ENHANCED WET NIGHT VISIBILITY) YELLOW	PAVEMENT MARKERS (RETRORE-FLECTIVE) G	PAVEMENT MARKERS (RETRORE-FLECTIVE) RY	DELINEATOR (CLASS 1)	DESCRIPTION/COMMENTS	REMOVE THERMOPLASTIC TRAFFIC STRIPE	REMOVE THERMOPLASTIC PAVEMENT MARKING	REMOVE MARKER
				LF							SQFT			EA				LF	SQFT	EA
	"A1" 1120+62 TO 1133+52	NB										63					6 BIKE LANE SYMBOL			
	"A1" 1120+62 TO 1133+52	NB									384						6 GREEN PAVEMENT			
	"A1" 1121+70 TO 1132+96	SB										63					6 BIKE LANE SYMBOL			
	"A1" 1120+62 TO 1133+52	SB									384						6 GREEN PAVEMENT			
	"A1" 1123+96 TO 1127+62		25A		730										32					
	"A1" 1123+25 TO 1123+65											240					LADDER CROSSWALK			
	"A1" 1128+47 TO 1133+82		25A		1070										48					
	"A1" 1120+56 TO 1134+50	NB	39					1562								78				
	"A1" 1122+85 TO 1134+50	NB									1200						GREEN SKIP			
	"A1" 1122+85 TO 1134+50	NB	39A						259											
	"A1" 1121+89 TO 1134+50	SB									1120						GREEN SKIP			
	"A1" 1121+89 TO 1124+00	SB	39A						282											
	"A1" 1125+77 TO 1126+65	SB	39					1064								50				
PD-12	"A1" 1117+20 TO 1117+38											570					LADDER CROSSWALK			
	"A1" 1123+96 TO 1124+07											570					LADDER CROSSWALK			
	"A1" 1123+08 TO 1123+81											140					LADDER CROSSWALK		20	
	"A1" 1123+81 TO 1124+07											542					LADDER CROSSWALK			
	"A1" 1128+40 TO 1128+51											570					LADDER CROSSWALK			
	"A1" 1133+75 TO 1133+90											542					LADDER CROSSWALK			
	"A1" 1122+85											50					LIMIT LINE			
	"A1" 1124+12											50					LIMIT LINE			
	"A1" 1125+10											55					XING			
	"A1" 1125+50											50					PED			
	"A1" 1128+56 TO 1128+56											50					LIMIT LINE			
	"A1" 1133+70 TO 1133+72											50					LIMIT LINE			
	"A1" 1121+09 TO 1117+15	NB	38							448				20						
	"A1" 1124+01 TO 1119+15	SB	38							280				12						
PD-12 TO PD-13	"A1" 1133+75 TO 1134+77	NB									180						GREEN SKIP			
	"A1" 1133+75 TO 1134+77	NB	39A						35											
	"A1" 1133+13 TO 1135+89	SB									460						GREEN SKIP			
	"A1" 1133+13 TO 1135+89	SB	39A						91											
	"A1" 1134+79 TO 1139+57	NB	9			955					20						GREEN PAVEMENT			
	"A1" 1134+84 TO 1139+58	SB	9			949					20									
	"A1" 1134+87 TO 1135+75	SB										84					TYPE III (L)			
PD-13	"A1" 1139+29 TO 1139+29	NB										42					TYPE III (L)			
	"A1" 1140+63 TO 1143+45	SB										126					TYPE III (L)			
	"A1" 1134+80 TO 1145+57	NB										63					6 BIKE LANE SYMBOL			
	"A1" 1134+80 TO 1145+57	NB									384						6 GREEN PAVEMENT			
	"A1" 1139+60 TO 1140+20		40				100													
	SHEET TOTAL				1800	1904	100	2626	667	728	4152	3920		32	80	128			20	

Son Thanh Ly
No. 72584
Exp. 6-30-26
CIVIL
STATE OF CALIFORNIA
REGISTERED PROFESSIONAL ENGINEER

FOR REVISION ONLY
July 22, 2024
DATE

20

Dist	COUNTY	ROUTE	POST MILES TOTAL PROJECT	SHEET No.	TOTAL SHEETS
04	SCI	82	18.2/26.4	257	466

AS-AWARDED CONTRACT PLANS
THIS STAMP PLACED IN LIEU OF ORIGINAL SIGNATURE
REGISTERED CIVIL ENGINEER DATE

January 20, 2023
PLANS APPROVAL DATE

REGISTERED PROFESSIONAL ENGINEER No. Exp. CIVIL STATE OF CALIFORNIA

THE STATE OF CALIFORNIA OR ITS OFFICERS OR AGENTS SHALL NOT BE RESPONSIBLE FOR THE ACCURACY OR COMPLETENESS OF SCANNED COPIES OF THIS PLAN SHEET.

PAVEMENT DELINEATION QUANTITIES

PDQ-9

REVISED BY TG | DATE REVISED 11-28-22
CALCULATED-DESIGNED BY QUYNH NGUYEN | CHECKED BY SON LY
FUNCTIONAL SUPERVISOR TAM LY
STATE OF CALIFORNIA - DEPARTMENT OF TRANSPORTATION DESIGN

LAST REVISION DATE PLOTTED => 18-NOV-2024 | 12-07-22 TIME PLOTTED => 16:09

BORDER LAST REVISED 7/2/2010 | USERNAME => s129144 | DGN FILE => 0419000140nc009.cco | RELATIVE BORDER SCALE IS IN INCHES 0 1 2 3 | UNIT 0712 | PROJECT NUMBER & PHASE 04190001401

CONTRACT CHANGE ORDER NO. 20
SHEET _____ OF _____

20 REPLACED PER CONTRACT CHANGE ORDER No. 20 DATED

REGISTERED PROFESSIONAL ENGINEER
Son Thanh Ly
No. 72584
Exp. 6-30-26
CIVIL
STATE OF CALIFORNIA

FOR REVISION ONLY
July 22, 2024
DATE

20

Dist	COUNTY	ROUTE	POST MILES TOTAL PROJECT	SHEET No.	TOTAL SHEETS
04	SCI	82	18.2/26.4	257A	466

AS-AWARDED CONTRACT PLANS
THIS STAMP PLACED IN LIEU OF ORIGINAL SIGNATURE
REGISTERED CIVIL ENGINEER DATE

January 20, 2023
PLANS APPROVAL DATE

REGISTERED PROFESSIONAL ENGINEER No. Exp. CIVIL STATE OF CALIFORNIA

THE STATE OF CALIFORNIA OR ITS OFFICERS OR AGENTS SHALL NOT BE RESPONSIBLE FOR THE ACCURACY OR COMPLETENESS OF SCANNED COPIES OF THIS PLAN SHEET.

TRAFFIC STRIPES, PAVEMENT MARKINGS AND PAVEMENT MARKERS

SHEET No.	LOCATION/STATION	DIRECTION	DETAIL No.	THERMOPLASTIC TRAFFIC STRIPE (ENHANCED WET NIGHT VISIBILITY)		TRAFFIC STRIPE TAPE (WARRANTY)			THERMOPLASTIC CROSSWALK AND PAVEMENT MARKING (ENHANCED WET NIGHT VISIBILITY)		PAVEMENT MARKERS (RETROREFLECTIVE)		DESCRIPTION/COMMENTS	REMOVE THERMOPLASTIC TRAFFIC STRIPE	REMOVE THERMOPLASTIC PAVEMENT MARKING	REMOVE MARKER
				6" WHITE	6" YELLOW	6" WHITE		8" WHITE								
				WHITE SOLID	YELLOW SOLID	BROKEN (17-7)	BROKEN (6-1)	WHITE SOLID	WHITE	YELLOW	G	RY		LF	SQFT	EA
				LF					SQFT		EA					
	"A1" 1123+96 TO 1127+62		25A		730							32				
	"A1" 1123+25 TO 1123+65								240				LADDER CROSSWALK			
	"A1" 1128+47 TO 1133+82		25A		1070							48				
	"A1" 1117+20 TO 1117+38								570				LADDER CROSSWALK			
	"A1" 1123+96 TO 1124+07								570				LADDER CROSSWALK			
	"A1" 1123+08 TO 1123+81								140				LADDER CROSSWALK		20	
	"A1" 1123+81 TO 1124+07								542				LADDER CROSSWALK			
PD-12	"A1" 1128+40 TO 1128+51								570				LADDER CROSSWALK			
	"A1" 1133+75 TO 1133+90								542				LADDER CROSSWALK			
	"A1" 1122+85								50				LIMIT LINE			
	"A1" 1124+12								50				LIMIT LINE			
	"A1" 1125+10								55				XING			
	"A1" 1125+50								50				PED			
	"A1" 1128+56 TO 1128+56								50				LIMIT LINE			
	"A1" 1133+70 TO 1133+72								50				LIMIT LINE			
	"A1" 1121+09 TO 1117+15	NB	38					448			20					
	"A1" 1124+01 TO 1119+15	SB	38					280			12					
	"A1" 1134+79 TO 1139+57	NB	9			955							GREEN PAVEMENT			
	"A1" 1134+84 TO 1139+58	SB	9			949										
PD-13	"A1" 1134+87 TO 1135+75	SB							84				TYPE III (L)			
	"A1" 1139+29 TO 1139+29	NB							42				TYPE III (L)			
	"A1" 1140+63 TO 1143+45	SB							126				GREEN PAVEMENT			
	"A1" 1139+60 TO 1140+20		40				100		63				6 BIKE LANE SYMBOL			
SHEET TOTAL					1800	1904	100	728	3794		32	80			20	

PAVEMENT DELINEATION QUANTITIES

PDQ-9A

CALCULATED-DESIGNED BY	QUYNH NGUYEN	REVISED BY	TG
CHECKED BY	SON LY	DATE REVISED	11-28-22
FUNCTIONAL SUPERVISOR	TAM LY		

STATE OF CALIFORNIA - DEPARTMENT OF TRANSPORTATION
DESIGN

LAST REVISION DATE PLOTTED => 18-NOV-2024
TIME PLOTTED => 16:09
12-07-22

BORDER LAST REVISED 7/2/2010
USERNAME => s129144
DGN FILE => 0419000140nc009A.cco
RELATIVE BORDER SCALE IS IN INCHES 0 1 2 3
UNIT 0712
PROJECT NUMBER & PHASE 04190001401

CONTRACT CHANGE ORDER NO. 20
SHEET ____ OF ____

20 **SHEET DELETED PER CONTRACT CHANGE ORDER No. 20**

Son Thanh Ly
No. 72584
Exp. 6-30-26
CIVIL
STATE OF CALIFORNIA

FOR REVISION ONLY
July 22, 2024
DATE

20

Dist	COUNTY	ROUTE	POST MILES TOTAL PROJECT	SHEET No.	TOTAL SHEETS
04	SCI	82	18.2/26.4	258	466

AS-AWARDED CONTRACT PLANS
THIS STAMP PLACED IN LIEU OF ORIGINAL SIGNATURE
REGISTERED CIVIL ENGINEER DATE

January 20, 2023
PLANS APPROVAL DATE

THE STATE OF CALIFORNIA OR ITS OFFICERS OR AGENTS SHALL NOT BE RESPONSIBLE FOR THE ACCURACY OR COMPLETENESS OF SCANNED COPIES OF THIS PLAN SHEET.

REGISTERED PROFESSIONAL ENGINEER
No.
Exp.
CIVIL
STATE OF CALIFORNIA

TRAFFIC STRIPES, PAVEMENT MARKINGS AND PAVEMENT MARKERS

SHEET No.	LOCATION/STATION	DIRECTION	DETAIL No.	THERMOPLASTIC TRAFFIC STRIPE (ENHANCED WET NIGHT VISIBILITY)		TRAFFIC STRIPE TAPE (WARRANTY)					THERMOPLASTIC PAVEMENT MARKING (BIKE LANE TREATMENT)	THERMOPLASTIC CROSSWALK AND PAVEMENT MARKING (ENHANCED WET NIGHT VISIBILITY)		PAVEMENT MARKERS (RETRORE-FLECTIVE)		DELINEATOR (CLASS 1)	DESCRIPTION/COMMENTS	REMOVE THERMOPLASTIC TRAFFIC STRIPE	REMOVE THERMOPLASTIC PAVEMENT MARKING	REMOVE MARKER
				6" WHITE	6" YELLOW	6" WHITE				8" WHITE										
				WHITE SOLID	YELLOW SOLID	BROKEN (17-7)	BROKEN (6-1)	SOLID	BROKEN (8-4)	WHITE SOLID	GREEN	WHITE	YELLOW	G	RY			LF	SQFT	EA
				LF							SQFT			EA						
	"A1" 1137+08 TO 1137+31	SB										21					2 BIKE LANE SYMBOL			
	"A1" 1137+08 TO 1137+08	SB									64						GREEN PAVEMENT			
	"A1" 1147+40 TO 1147+80											240					LADDER CROSSWALK			
	"A1" 1138+31 TO 1146+97	SB									256						4 GREEN PAVEMENT			
	"A1" 1141+45 TO 1146+97	SB										32					3 BIKE LANE SYMBOL			
	"A1" 1134+76 TO 1139+57		25A		962										44					
	"A1" 1134+77 TO 1135+34	NB	39					126								6				
	"A1" 1135+34 TO 1148+34	NB									1521						GREEN SKIP			
	"A1" 1135+34 TO 1148+34	NB	39A						185											
PD-13	"A1" 1135+89 TO 1148+34	SB	39					1458								73				
	"A1" 1137+26 TO 1137+83	SB									820						GREEN SKIP			
	"A1" 1137+26 TO 1137+83	SB	39A						250											
	"A1" 1134+65 TO 1134+76											542					LADDER CROSSWALK			
	"A1" 1139+61 TO 1140+49											110					CROSSWALK			
	"A1" 1140+49 TO 1140+60											598					LADDER CROSSWALK			
	"A1" 1134+81 TO 1134+81											50					LIMIT LINE			
	"A1" 1139+55 TO 1139+55											50					LIMIT LINE			
	"A1" 1140+65 TO 1140+65											50					LIMIT LINE			
	"A1" 1134+83 TO 1135+77	SB	38							380				16						
	"A1" 1138+64 TO 1139+55	NB	38							91				4						
	"A1" 1140+61 TO 1152+07	NB	9			2291								48						
	"A1" 1140+64 TO 1152+09	SB	9			2289					48						GREEN PAVEMENT			
	"A1" 1147+61 TO 1152+02	NB										252					TYPE III (L)			
	"A1" 1140+58 TO 1152+07		25A		2296										96					
PD-13 TO PD-14	"A1" 1148+34 TO 1150+16	NB									913						GREEN SOLID			
	"A1" 1148+34 TO 1150+16	NB	39					401								20				
	"A1" 1147+16 TO 1149+02	SB									320						GREEN SKIP			
	"A1" 1147+16 TO 1149+02	SB	39A						123											
	"A1" 1147+56 TO 1152+04	NB	38							448				19						
	"A1" 1147+56 TO 1152+04	NB	38							448				19						
	"A1" 1153+53 TO 1158+09	SB										252					TYPE III (L)			
	"A1" 1157+10 TO 1149+04	NB										32					3 BIKE LANE SYMBOL			
	"A1" 1157+10 TO 1149+04	NB									192						3 GREEN PAVEMENT			
	"A1" 1157+64 TO 1160+86	SB										53					5 BIKE LANE SYMBOL			
PD-14	"A1" 1157+64 TO 1160+86	SB									320						5 GREEN PAVEMENT			
	"A1" 1150+16 TO 1152+03	NB									2085						GREEN SKIP			
	"A1" 1150+16 TO 1152+03	NB	39A						303											
	"A1" 1152+03 TO 1153+49	NB	39A						96											
	"A1" 1152+00 TO 1153+40		40				300													
	SHEET TOTAL				3258	4580	300	1985	957	1367	6539	2282		106	140	99				

PAVEMENT DELINEATION QUANTITIES

PDQ-10

REVISED BY	DATE REVISED
TG	11-28-22

CALCULATED-DESIGNED BY: QUYNH NGUYEN
CHECKED BY: SON LY
FUNCTIONAL SUPERVISOR: TAM LY

STATE OF CALIFORNIA - DEPARTMENT OF TRANSPORTATION
DESIGN

LAST REVISION: DATE PLOTTED => 18-NOV-2024
12-07-22 TIME PLOTTED => 16:09

BORDER LAST REVISED 7/2/2010 | USERNAME => s129144 | DGN FILE => 0419000140nc010.cco | RELATIVE BORDER SCALE IS IN INCHES 0 1 2 3 | UNIT 0712 | PROJECT NUMBER & PHASE 04190001401

CONTRACT CHANGE ORDER NO. 20
SHEET ____ OF ____

20 REPLACED PER CONTRACT CHANGE ORDER No. 20 DATED

REGISTERED PROFESSIONAL ENGINEER
Son Thanh Ly
No. 72584
Exp. 6-30-26
CIVIL
STATE OF CALIFORNIA

20

FOR REVISION ONLY
July 22, 2024
DATE

Dist	COUNTY	ROUTE	POST MILES TOTAL PROJECT	SHEET No.	TOTAL SHEETS
04	SCI	82	18.2/26.4	258A	466

AS-AWARDED CONTRACT PLANS
THIS STAMP PLACED IN LIEU OF ORIGINAL SIGNATURE

REGISTERED CIVIL ENGINEER DATE

PLANS APPROVAL DATE

REGISTERED PROFESSIONAL ENGINEER
No. ____
Exp. ____
CIVIL
STATE OF CALIFORNIA

THE STATE OF CALIFORNIA OR ITS OFFICERS OR AGENTS SHALL NOT BE RESPONSIBLE FOR THE ACCURACY OR COMPLETENESS OF SCANNED COPIES OF THIS PLAN SHEET.

TRAFFIC STRIPES, PAVEMENT MARKINGS AND PAVEMENT MARKERS

SHEET No.	LOCATION/STATION	DIRECTION	DETAIL No.	THERMOPLASTIC TRAFFIC STRIPE (ENHANCED WET NIGHT VISIBILITY)		TRAFFIC STRIPE TAPE (WARRANTY)			THERMOPLASTIC CROSSWALK AND PAVEMENT MARKING (ENHANCED WET NIGHT VISIBILITY)		PAVEMENT MARKERS (RETRORE-FLECTIVE)		DESCRIPTION/COMMENTS	REMOVE THERMOPLASTIC TRAFFIC STRIPE	REMOVE THERMOPLASTIC PAVEMENT MARKING	REMOVE MARKER
				6" WHITE	6" YELLOW	6" WHITE		8" WHITE								
				WHITE SOLID	YELLOW SOLID	BROKEN (17-7)	BROKEN (6-1)	WHITE SOLID	WHITE	YELLOW	G	RY		LF	SQFT	EA
				LF					SQFT		EA					
PD-13	"A1" 1147+40 TO 1147+80								240				LADDER CROSSWALK			
	"A1" 1134+76 TO 1139+57		25A		962							44				
	"A1" 1134+65 TO 1134+76								542				LADDER CROSSWALK			
	"A1" 1139+61 TO 1140+49								110				CROSSWALK			
	"A1" 1140+49 TO 1140+60								598				LADDER CROSSWALK			
	"A1" 1134+81 TO 1134+81								50				LIMIT LINE			
	"A1" 1139+55 TO 1139+55								50				LIMIT LINE			
	"A1" 1140+65 TO 1140+65								50				LIMIT LINE			
PD-13 TO PD-14	"A1" 1140+61 TO 1152+07	NB	9			2291					48					
	"A1" 1140+64 TO 1152+09	SB	9			2289							GREEN PAVEMENT			
	"A1" 1147+61 TO 1152+02	NB							252				TYPE III (L)			
	"A1" 1140+58 TO 1152+07		25A		2296							96				
	"A1" 1148+34 TO 1150+16	NB											GREEN SOLID			
PD-14	"A1" 1153+53 TO 1158+09	SB							252				TYPE III (L)			
	"A1" 1152+00 TO 1153+40		40				300									
SHEET TOTAL					3258	4580	300	1367	2144		106	140				

REVISED BY: TG | DATE REVISED: 11-28-22
CALCULATED-DESIGNED BY: QUYNH NGUYEN | CHECKED BY: SON LY
FUNCTIONAL SUPERVISOR: TAM LY

STATE OF CALIFORNIA - DEPARTMENT OF TRANSPORTATION
DESIGN

PAVEMENT DELINEATION QUANTITIES

PDQ-10A

LAST REVISION | DATE PLOTTED => 18-NOV-2024
12-07-22 | TIME PLOTTED => 16:09

BORDER LAST REVISED 7/2/2010
USERNAME => s129144
DGN FILE => 0419000140nc010A.cco
RELATIVE BORDER SCALE IS IN INCHES 0 1 2 3
UNIT 0712
PROJECT NUMBER & PHASE 04190001401

CONTRACT CHANGE ORDER NO. 20
SHEET ____ OF ____

20 SHEET DELETED PER CONTRACT CHANGE ORDER No. 20

TRAFFIC STRIPES, PAVEMENT MARKINGS AND PAVEMENT MARKERS

Son Thanh Ly
No. 72584
Exp. 6-30-26
CIVIL
STATE OF CALIFORNIA
REGISTERED PROFESSIONAL ENGINEER

FOR REVISION ONLY
July 22, 2024
DATE

20

Dist	COUNTY	ROUTE	POST MILES TOTAL PROJECT	SHEET No.	TOTAL SHEETS
04	SCI	82	18.2/26.4	259	466

AS-AWARDED CONTRACT PLANS
THIS STAMP PLACED IN LIEU OF ORIGINAL SIGNATURE
REGISTERED CIVIL ENGINEER DATE
January 20, 2023
PLANS APPROVAL DATE

REGISTERED PROFESSIONAL ENGINEER No. Exp. CIVIL STATE OF CALIFORNIA

THE STATE OF CALIFORNIA OR ITS OFFICERS OR AGENTS SHALL NOT BE RESPONSIBLE FOR THE ACCURACY OR COMPLETENESS OF SCANNED COPIES OF THIS PLAN SHEET.

SHEET No.	LOCATION/STATION	DIRECTION	DETAIL No.	THERMOPLASTIC TRAFFIC STRIPE (ENHANCED WET NIGHT VISIBILITY)		TRAFFIC STRIPE TAPE (WARRANTY)					THERMOPLASTIC PAVEMENT MARKING (BIKE LANE TREATMENT)	THERMOPLASTIC CROSSWALK AND PAVEMENT MARKING (ENHANCED WET NIGHT VISIBILITY)		PAVEMENT MARKERS (RETRORE-FLECTIVE)		DELINEATOR (CLASS 1)	DESCRIPTION/COMMENTS	REMOVE THERMOPLASTIC TRAFFIC STRIPE	REMOVE THERMOPLASTIC PAVEMENT MARKING	REMOVE MARKER
				6" WHITE	6" YELLOW	6" WHITE				8" WHITE										
				WHITE SOLID	YELLOW SOLID	BROKEN (17-7)	BROKEN (6-1)	SOLID	BROKEN (8-4)	WHITE SOLID	GREEN	WHITE	YELLOW	G	RY			LF	SQFT	EA
				LF							SQFT			EA						
	"A1" 1153+49 TO 1155+17	NB									840						GREEN SOLID			
	"A1" 1149+02 TO 1150+68	SB	39					1383								65				
	"A1" 1150+68 TO 1152+02	SB									1000						GREEN SKIP			
	"A1" 1150+68 TO 1152+02	SB	39A						228											
	"A1" 1152+04 TO 1152+25	N/A										678					LADDER CROSSWALK			
	"A1" 1152+21 TO 1153+26	N/A										210					CROSSWALK			
	"A1" 1152+25 TO 1153+35	N/A										210					CROSSWALK			
PD-14	"A1" 1153+35 TO 1153+41	N/A										678					LADDER CROSSWALK			
	"A1" 1152+03 TO 1152+08	N/A										50					LIMIT LINE			
	"A1" 1152+32 TO 1152+37	N/A	39A						43											
	"A1" 1152+32 TO 1152+37	N/A									220						GREEN SKIP			
	"A1" 1153+13 TO 1153+20	N/A	39A																	
	"A1" 1153+46 TO 1153+48	N/A										50					LIMIT LINE			
	"A1" 1153+51 TO 1158+14	SB	38							926				39						
	"A1" 1153+55 TO 1165+28	NB	9			2345					49						GREEN PAVEMENT			
	"A1" 1153+47 TO 1165+34	SB	9			2347								50						
PD-14 TO PD-15	"A1" 1153+42 TO 1165+33		25A		2382										100					
	"A1" 1159+80 TO 1162+68	NB	39					634								32				
	"A1" 1160+72 TO 1163+94	SB	39					708								35				
	"A1" 1166+23 TO 1170+49	NB	9			852								18						
	"A1" 1166+44 TO 1170+64	SB	9			839								18						
	"A1" 1171+43 TO 1176+45	NB	9			1005								21						
	"A1" 1171+36 TO 1176+28	SB	9			984								21						
	"A1" 1163+37 TO 1165+23	NB										84					TYPE III (L)			
	"A1" 1166+43 TO 1166+43	SB										42					TYPE III (L)			
	"A1" 1168+20 TO 1170+43	NB										84					TYPE III (L)			
	"A1" 1171+46 TO 1172+35	SB										84					TYPE III (L)			
	"A1" 1176+15 TO 1176+15	NB										42					TYPE III (L)			
	"A1" 1162+92 TO 1166+24	NB										21					2 BIKE LANE SYMBOL			
PD-15	"A1" 1162+92 TO 1166+24	NB									128						2 GREEN PAVEMENT			
	"A1" 1169+17 TO 1175+16	NB										42					4 BIKE LANE SYMBOL			
	"A1" 1169+17 TO 1175+16	NB									256						4 GREEN PAVEMENT			
	"A1" 1163+77 TO 1170+04	SB										42					4 BIKE LANE SYMBOL			
	"A1" 1163+77 TO 1170+04	SB									256						4 GREEN PAVEMENT			
	"A1" 1172+57 TO 1176+28	SB										32					3 BIKE LANE SYMBOL			
	"A1" 1172+57 TO 1176+28	SB									192						3 GREEN PAVEMENT			
	"A1" 1166+24 TO 1170+49	NB			850										36					
	"A1" 1171+32 TO 1176+33	NB			1002										44					
	SHEET TOTAL				4234	8372		2725	271	926	2941	2349		167	180	132				

PAVEMENT DELINEATION QUANTITIES

PDQ-11

CALCULATED-DESIGNED BY: TG
CHECKED BY: 11-28-22
REVISED BY: QUYNH NGUYEN
DATE REVISED: SON LY
FUNCTIONAL SUPERVISOR: TAM LY
STATE OF CALIFORNIA - DEPARTMENT OF TRANSPORTATION
DESIGN

LAST REVISION | DATE PLOTTED => 18-NOV-2024
12-07-22 | TIME PLOTTED => 16:09

BORDER LAST REVISED 7/2/2010 | USERNAME => s129144 | DGN FILE => 0419000140nc011.cco | RELATIVE BORDER SCALE IS IN INCHES 0 1 2 3 | UNIT 0712 | PROJECT NUMBER & PHASE 04190001401

CONTRACT CHANGE ORDER NO. 20
SHEET ____ OF ____

20 REPLACED PER CONTRACT CHANGE ORDER No. 20 DATED

Son Thanh Ly
No. 72584
Exp. 6-30-26
CIVIL
STATE OF CALIFORNIA
REGISTERED PROFESSIONAL ENGINEER

20

FOR REVISION ONLY
July 22, 2024
DATE

Dist	COUNTY	ROUTE	POST MILES TOTAL PROJECT	SHEET No.	TOTAL SHEETS
04	SCI	82	18.2/26.4	259A	466

AS-AWARDED CONTRACT PLANS
THIS STAMP PLACED IN LIEU OF ORIGINAL SIGNATURE

REGISTERED CIVIL ENGINEER DATE

PLANS APPROVAL DATE

REGISTERED PROFESSIONAL ENGINEER
No. ____
Exp. ____
CIVIL
STATE OF CALIFORNIA

THE STATE OF CALIFORNIA OR ITS OFFICERS OR AGENTS SHALL NOT BE RESPONSIBLE FOR THE ACCURACY OR COMPLETENESS OF SCANNED COPIES OF THIS PLAN SHEET.

TRAFFIC STRIPES, PAVEMENT MARKINGS AND PAVEMENT MARKERS

SHEET No.	LOCATION/STATION	DIRECTION	DETAIL No.	THERMOPLASTIC TRAFFIC STRIPE (ENHANCED WET NIGHT VISIBILITY)		TRAFFIC STRIPE TAPE (WARRANTY)			THERMOPLASTIC CROSSWALK AND PAVEMENT MARKING (ENHANCED WET NIGHT VISIBILITY)		PAVEMENT MARKERS (RETRO-REFLECTIVE)		DESCRIPTION/COMMENTS	REMOVE THERMOPLASTIC TRAFFIC STRIPE	REMOVE THERMOPLASTIC PAVEMENT MARKING	REMOVE MARKER
				6" WHITE	6" YELLOW	6" WHITE		8" WHITE								
				WHITE SOLID	YELLOW SOLID	BROKEN (17-7)	BROKEN (6-1)	WHITE SOLID	WHITE	YELLOW	G	RY				
				LF					SQFT		EA			LF	SQFT	EA
PD-14	"A1" 1152+04 TO 1152+25	N/A							678				LADDER CROSSWALK			
	"A1" 1152+21 TO 1153+26	N/A							210				CROSSWALK			
	"A1" 1152+25 TO 1153+35	N/A							210				CROSSWALK			
	"A1" 1153+35 TO 1153+41	N/A							678				LADDER CROSSWALK			
	"A1" 1152+03 TO 1152+08	N/A							50				LIMIT LINE			
	"A1" 1152+32 TO 1152+37	N/A	39A													
	"A1" 1153+13 TO 1153+20	N/A	39A													
	"A1" 1153+46 TO 1153+48	N/A							50				LIMIT LINE			
	"A1" 1153+51 TO 1158+14	SB	38					926			39					
PD-14 TO PD-15	"A1" 1153+55 TO 1165+28	NB	9			2345							GREEN PAVEMENT			
	"A1" 1153+47 TO 1165+34	SB	9			2347					50					
	"A1" 1153+42 TO 1165+33		25A		2382							100				
	"A1" 1159+80 TO 1162+68	NB	39													
	"A1" 1160+72 TO 1163+94	SB	39													
	"A1" 1166+23 TO 1170+49	NB	9			852					18					
PD-15	"A1" 1166+44 TO 1170+64	SB	9			839					18					
	"A1" 1171+43 TO 1176+45	NB	9			1005					21					
	"A1" 1171+36 TO 1176+28	SB	9			984					21					
	"A1" 1163+37 TO 1165+23	NB							84				TYPE III (L)			
	"A1" 1166+43 TO 1166+43	SB							42				TYPE III (L)			
	"A1" 1168+20 TO 1170+43	NB							84				TYPE III (L)			
	"A1" 1171+46 TO 1172+35	SB							84				TYPE III (L)			
	"A1" 1176+15 TO 1176+15	NB							42				TYPE III (L)			
	"A1" 1166+24 TO 1170+49	NB			850							36				
	"A1" 1171+32 TO 1176+33	NB			1002							44				
SHEET TOTAL					4234	8372		926	2212		167	180				

PAVEMENT DELINEATION QUANTITIES

PDQ-11A

LAST REVISION 12-07-22
DATE PLOTTED => 18-NOV-2024
TIME PLOTTED => 16:09

STATE OF CALIFORNIA - DEPARTMENT OF TRANSPORTATION
DESIGN
FUNCTIONAL SUPERVISOR: TAM LY
CALCULATED-DESIGNED BY: QUYNH NGUYEN
CHECKED: SON LY
REVISED BY: TG
DATE REVISED: 11-28-22

BORDER LAST REVISED 7/2/2010
USERNAME => s129144
DGN FILE => 0419000140nc011A.cco
RELATIVE BORDER SCALE IS IN INCHES 0 1 2 3
UNIT 0712
PROJECT NUMBER & PHASE 04190001401

CONTRACT CHANGE ORDER NO. 20
SHEET ____ OF ____

20 SHEET DELETED PER CONTRACT CHANGE ORDER No. 20

TRAFFIC STRIPES, PAVEMENT MARKINGS AND PAVEMENT MARKERS

Dist	COUNTY	ROUTE	POST MILES TOTAL PROJECT	SHEET No.	TOTAL SHEETS
04	SCI	82	18.2/26.4	260	466

AS-AWARDED CONTRACT PLANS
THIS STAMP PLACED IN LIEU OF ORIGINAL SIGNATURE
REGISTERED CIVIL ENGINEER DATE

January 20, 2023
PLANS APPROVAL DATE

Son Thanh Ly No. 72584 Exp. 6-30-26 CIVIL STATE OF CALIFORNIA

20 FOR REVISION ONLY
July 22, 2024
DATE

THE STATE OF CALIFORNIA OR ITS OFFICERS OR AGENTS SHALL NOT BE RESPONSIBLE FOR THE ACCURACY OR COMPLETENESS OF SCANNED COPIES OF THIS PLAN SHEET.

SHEET No.	LOCATION/STATION	DIRECTION	DETAIL No.	THERMOPLASTIC TRAFFIC STRIPE (ENHANCED WET NIGHT VISIBILITY)		TRAFFIC STRIPE TAPE (WARRANTY)					THERMOPLASTIC PAVEMENT MARKING (BIKE LANE TREATMENT)	THERMOPLASTIC CROSSWALK AND PAVEMENT MARKING (ENHANCED WET NIGHT VISIBILITY)		PAVEMENT MARKERS (RETRORE-FLECTIVE)		DELINEATOR (CLASS 1)	DESCRIPTION/COMMENTS	REMOVE THERMOPLASTIC TRAFFIC STRIPE	REMOVE THERMOPLASTIC PAVEMENT MARKING	REMOVE MARKER
				6" WHITE	6" YELLOW	6" WHITE				8" WHITE										
				WHITE SOLID	YELLOW SOLID	BROKEN (17-7)	BROKEN (6-1)	SOLID	BROKEN (8-4)	WHITE SOLID	GREEN	WHITE	YELLOW	G	RY			LF	SQFT	EA
				LF							SQFT			EA						
	"A1" 1162+68 TO 1162+90	NB									40						GREEN SKIP			
	"A1" 1162+68 TO 1162+90	NB	39A						130											
	"A1" 1162+90 TO 1163+80	NB	39					834								43				
	"A1" 1163+80 TO 1166+12	NB										680					GREEN SKIP			
	"A1" 1163+94 TO 1164+22	SB									160						GREEN SKIP			
	"A1" 1163+94 TO 1164+22	SB	39A						26											
	"A1" 1165+40 TO 1165+80	N/A										240					LADDER CROSSWALK			
	"A1" 1166+35 TO 1167+91	SB	39					481												
	"A1" 1167+91 TO 1168+19	SB									380						GREEN SKIP			
	"A1" 1167+91 TO 1168+19	SB	39A						129											
PD-15	"A1" 1165+30 TO 1165+86	N/A										120					CROSSWALK			
	"A1" 1166+00 TO 1166+36	N/A										570					LADDER CROSSWALK			
	"A1" 1170+46 TO 1170+75	N/A										570					LADDER CROSSWALK			
	"A1" 1171+16 TO 1171+42	N/A										624					LADDER CROSSWALK			
	"A1" 1165+25 TO 1165+27	N/A										50					LIMIT LINE			
	"A1" 1166+28 TO 1166+40	N/A										50					LIMIT LINE			
	"A1" 1170+41 TO 1170+50	N/A										55					LIMIT LINE			
	"A1" 1171+32 TO 1171+40	N/A										55					LIMIT LINE			
	"A1" 1163+35 TO 1165+27	NB	38							540				22						
	"A1" 1166+42 TO 1167+18	SB	38							179				8						
	"A1" 1176+33 TO 1176+45	N/A										60					LIMIT LINE			
	"A1" 1176+62 TO 1177+14	N/A										60					CROSSWALK			
	"A1" 1177+32 TO 1177+34	N/A										55					LIMIT LINE			
	"A1" 1177+26 TO 1190+50	NB	9			2127								45						
	"A1" 1177+29 TO 1190+50	SB	9			2432								13						
	"A1" 1177+28 TO 1178+40	SB										84					TYPE III (L)			
	"A1" 1179+11 TO 1180+30	NB										84					TYPE III (L)			
	"A1" 1181+27 TO 1183+11	SB										84					TYPE III (L)			
	"A1" 1177+26 TO 1188+51		25A		2050							84			96					
	"A1" 1176+62 TO 1177+15	N/A										100					CROSSWALK			
PD-16	"A1" 1177+15 TO 1177+29	N/A										542					LADDER CROSSWALK			
	"A1" 1177+27 TO 1178+41	SB	38							114				5						
	"A1" 1179+07 TO 1180+38	NB	38							131				5						
	"A1" 1181+22 TO 1183+12	SB	38							189				6						
	"A1" 1177+14 TO 1177+29	N/A										570					LADDER CROSSWALK			
	"A1" 1181+01 TO 1181+39	N/A										570					LADDER CROSSWALK			
	"A1" 1180+30 TO 1180+60	N/A										65					LIMIT LINE			
	"A1" 1181+18 TO 1181+32	N/A										65					LIMIT LINE			
	"A1" 1178+90											54					PED			
	"A1" 1178+50											63					XING			
	SHEET TOTAL				2050	4559		1315	285	1153	580	5554		104	96	43				

PAVEMENT DELINEATION QUANTITIES

PDQ-12

REVISED BY	TG	CALCULATED-DESIGNED BY	QUYNH NGUYEN
DATE REVISED	11-28-22	CHECKED BY	SON LY
FUNCTIONAL SUPERVISOR	TAM LY		
STATE OF CALIFORNIA - DEPARTMENT OF TRANSPORTATION	DESIGN		

Caltrans

LAST REVISION DATE PLOTTED => 18-NOV-2024
TIME PLOTTED => 16:10
12-07-22

BORDER LAST REVISED 7/2/2010 | USERNAME => s129144 | DGN FILE => 0419000140nc012.cco | RELATIVE BORDER SCALE IS IN INCHES 0 1 2 3 | UNIT 0712 | PROJECT NUMBER & PHASE 04190001401

CONTRACT CHANGE ORDER NO. 20
SHEET _____ OF _____

20 REPLACED PER CONTRACT CHANGE ORDER No. 20 DATED

FOR REVISION ONLY
July 22, 2024
DATE

20

Dist	COUNTY	ROUTE	POST MILES TOTAL PROJECT	SHEET No.	TOTAL SHEETS
04	SCI	82	18.2/26.4	260A	466

AS-AWARDED CONTRACT PLANS
THIS STAMP PLACED IN LIEU OF ORIGINAL SIGNATURE
REGISTERED CIVIL ENGINEER DATE
PLANS APPROVAL DATE

REGISTERED PROFESSIONAL ENGINEER No. Exp. CIVIL STATE OF CALIFORNIA

THE STATE OF CALIFORNIA OR ITS OFFICERS OR AGENTS SHALL NOT BE RESPONSIBLE FOR THE ACCURACY OR COMPLETENESS OF SCANNED COPIES OF THIS PLAN SHEET.

TRAFFIC STRIPES, PAVEMENT MARKINGS AND PAVEMENT MARKERS

SHEET No.	LOCATION/STATION	DIRECTION	DETAIL No.	THERMOPLASTIC TRAFFIC STRIPE (ENHANCED WET NIGHT VISIBILITY)		TRAFFIC STRIPE TAPE (WARRANTY)			THERMOPLASTIC CROSSWALK AND PAVEMENT MARKING (ENHANCED WET NIGHT VISIBILITY)		PAVEMENT MARKERS (RETRO-REFLECTIVE)		DESCRIPTION/COMMENTS	REMOVE THERMOPLASTIC TRAFFIC STRIPE	REMOVE THERMOPLASTIC PAVEMENT MARKING	REMOVE MARKER
				6" WHITE	6" YELLOW	6" WHITE		8" WHITE								
				WHITE SOLID	YELLOW SOLID	BROKEN (17-7)	BROKEN (6-1)	WHITE SOLID	WHITE	YELLOW	G	RY				
				LF					SQFT		EA			LF	SQFT	EA
	"A1" 1165+40 TO 1165+80	N/A							240				LADDER CROSSWALK			
	"A1" 1165+30 TO 1165+86	N/A							120				CROSSWALK			
	"A1" 1166+00 TO 1166+36	N/A							570				LADDER CROSSWALK			
	"A1" 1170+46 TO 1170+75	N/A							570				LADDER CROSSWALK			
	"A1" 1171+16 TO 1171+42	N/A							624				LADDER CROSSWALK			
	"A1" 1165+25 TO 1165+27	N/A							50				LIMIT LINE			
	"A1" 1166+28 TO 1166+40	N/A							50				LIMIT LINE			
PD-15	"A1" 1170+41 TO 1170+50	N/A							55				LIMIT LINE			
	"A1" 1171+32 TO 1171+40	N/A							55				LIMIT LINE			
	"A1" 1163+35 TO 1165+27	NB	38					540			22					
	"A1" 1166+42 TO 1167+18	SB	38					179			8					
	"A1" 1176+33 TO 1176+45	N/A							60				LIMIT LINE			
	"A1" 1176+62 TO 1177+14	N/A							60				CROSSWALK			
	"A1" 1177+32 TO 1177+34	N/A							55				LIMIT LINE			
	"A1" 1177+26 TO 1190+50	NB	9			2127					45					
	"A1" 1177+29 TO 1190+50	SB	9			2432					13					
	"A1" 1177+28 TO 1178+40	SB							84				TYPE III (L)			
	"A1" 1179+11 TO 1180+30	NB							84				TYPE III (L)			
	"A1" 1181+27 TO 1183+11	SB							84				TYPE III (L)			
	"A1" 1177+26 TO 1188+51		25A		2050				84			96				
	"A1" 1176+62 TO 1177+15	N/A							100				CROSSWALK			
PD-16	"A1" 1177+15 TO 1177+29	N/A							542				LADDER CROSSWALK			
	"A1" 1177+27 TO 1178+41	SB	38					114			5					
	"A1" 1179+07 TO 1180+38	NB	38					131			5					
	"A1" 1181+22 TO 1183+12	SB	38					189			6					
	"A1" 1177+14 TO 1177+29	N/A							570				LADDER CROSSWALK			
	"A1" 1181+01 TO 1181+39	N/A							570				LADDER CROSSWALK			
	"A1" 1180+30 TO 1180+60	N/A							65				LIMIT LINE			
	"A1" 1181+18 TO 1181+32	N/A							65				LIMIT LINE			
	"A1" 1178+90								54				PED			
	"A1" 1178+50								63				XING			
SHEET TOTAL					2050	4559		1153	4874		104	96				

PAVEMENT DELINEATION QUANTITIES
PDQ-12A

CALCULATED-DESIGNED BY: QUYNH NGUYEN
CHECKED BY: SON LY
REVISED BY: TG
DATE REVISED: 11-28-22
FUNCTIONAL SUPERVISOR: TAM LY
STATE OF CALIFORNIA - DEPARTMENT OF TRANSPORTATION
DESIGN

LAST REVISION DATE PLOTTED => 18-NOV-2024
12-07-22 TIME PLOTTED => 16:10

BORDER LAST REVISED 7/2/2010
USERNAME => s129144
DGN FILE => 0419000140nc012A.cco
RELATIVE BORDER SCALE IS IN INCHES 0 1 2 3
UNIT 0712
PROJECT NUMBER & PHASE 04190001401

CONTRACT CHANGE ORDER NO. 20
SHEET ____ OF ____

20 **SHEET DELETED PER CONTRACT CHANGE ORDER No. 20**

Son Thanh Ly
No. 72584
Exp. 6-30-26
CIVIL
STATE OF CALIFORNIA

20

FOR REVISION ONLY
July 22, 2024
DATE

Dist	COUNTY	ROUTE	POST MILES TOTAL PROJECT	SHEET No.	TOTAL SHEETS
04	SCI	82	18.2/26.4	261	466

AS-AWARDED CONTRACT PLANS
THIS STAMP PLACED IN LIEU OF ORIGINAL SIGNATURE
REGISTERED CIVIL ENGINEER DATE
January 20, 2023
PLANS APPROVAL DATE

REGISTERED PROFESSIONAL ENGINEER
No. ____
Exp. ____
CIVIL
STATE OF CALIFORNIA

THE STATE OF CALIFORNIA OR ITS OFFICERS OR AGENTS SHALL NOT BE RESPONSIBLE FOR THE ACCURACY OR COMPLETENESS OF SCANNED COPIES OF THIS PLAN SHEET.

TRAFFIC STRIPES, PAVEMENT MARKINGS AND PAVEMENT MARKERS

SHEET No.	LOCATION/STATION	DIRECTION	DETAIL No.	THERMOPLASTIC TRAFFIC STRIPE (ENHANCED WET NIGHT VISIBILITY)		TRAFFIC STRIPE TAPE (WARRANTY)					THERMOPLASTIC PAVEMENT MARKING (BIKE LANE TREATMENT)	THERMOPLASTIC CROSSWALK AND PAVEMENT MARKING (ENHANCED WET NIGHT VISIBILITY)		PAVEMENT MARKERS (RETRORE-FLECTIVE)		DELINEATOR (CLASS 1)	DESCRIPTION/COMMENTS	REMOVE THERMOPLASTIC TRAFFIC STRIPE	REMOVE THERMOPLASTIC PAVEMENT MARKING	REMOVE MARKER
				6" WHITE	6" YELLOW	6" WHITE				8" WHITE										
				WHITE SOLID	YELLOW SOLID	BROKEN (17-7)	BROKEN (6-1)	SOLID	BROKEN (8-4)	WHITE SOLID	GREEN	WHITE	YELLOW	G	RY			LF	SQFT	EA
				LF							SQFT			EA						
PD-16	"A1" 1188+49 TO 1188+49	N/A										45					LIMIT LINE			
	"A1" 1189+42 TO 1189+41	N/A										62					LIMIT LINE			
	"A1" 1188+50											72					KEEP			
	"A1" 1189+20											81					CLEAR			
PD-16 TO PD-17	"A1" 1189+45 TO 1196+54	NB	9			1,418								30						
	"A1" 1181+21 TO 1196+25	SB	9			3,008								63						
	"A1" 1189+43 TO 1192+47	SB										126					TYPE III (L)			
	"A1" 1189+41 TO 1196+35		25A		1388							84			60					
	"A1" 1189+42 TO 1192+47	SB	38							305				7						
PD-17	"A1" 1197+73 TO 1203+23	NB	9			1,099								13						
	"A1" 1197+36 TO 1203+14	SB	9			1,156								25						
	"A1" 1194+03 TO 1196+37	NB										126					TYPE III (L)			
	"A1" 1197+52 TO 1200+37	SB										126					TYPE III (L)			
	"A1" 1202+88 TO 1204+39	NB/SB										84					2 TYPE III (L)			
	"A1" 1197+51 TO 1203+14	NB	25A		563										24					
	"A1" 1195+20											22					ONLY			
	"A1" 1195+40											20					BUS			
	"A1" 1195+18 TO 1196+18											80					12" WHITE LINE			
	"A1" 1196+20 TO 1197+00		40				100					570								
PD-17	"A1" 1194+01 TO 1196+43	NB	38							242				11						
	"A1" 1197+46 TO 1200+36	SB	38							289				12						
	"A1" 1201+96 TO 1203+16	NB	38							120				5						
	"A1" 1204+34 TO 1205+25	SB	38							91				4						
	"A1" 1196+33 TO 1196+59											62					LIMIT LINE			
	"A1" 1196+18 TO 1196+07											170					CROSSWALK			
	"A1" 1197+34 TO 1197+57											60					LIMIT LINE			
	"A1" 1203+10 TO 1204+41											55					LIMIT LINE			
	"A1" 1203+19 TO 1204+12											180					CROSSWALK			
	"A1" 1203+36 TO 1204+31											180					CROSSWALK			
	"A1" 1204+28 TO 1204+41											55					LIMIT LINE			
PD-17 TO PD-18	"A1" 1204+47 TO 1214+24	NB	9			1,955								41						
	"A1" 1204+32 TO 1214+21	SB	9			1,978								42						
	"A1" 1204+39 TO 1214+17		25A		1954										84					
PD-18	"A1" 1213+93 TO 1213+93	NB										42					TYPE III (L)			
	"A1" 1215+12 TO 1217+27		25A		230										20					
	"A1" 1214+19 TO 1214+31											614					LADDER CROSSWALK			
	"A1" 1214+14 TO 1214+15											55					LIMIT LINE			
	"A1" 1215+09 TO 1215+13											45					LIMIT LINE			
	"A1" 1213+10 TO 1214+20	WB	38							109										
SHEET TOTAL					4135	10,614	100			1156		3016		253	188					

PAVEMENT DELINEATION QUANTITIES

PDQ-13

QUYNH NGUYEN | SON LY | TG | 11-28-22
CALCULATED-DESIGNED BY | CHECKED BY | REVISED BY | DATE REVISED

FUNCTIONAL SUPERVISOR: TAM LY

STATE OF CALIFORNIA - DEPARTMENT OF TRANSPORTATION
Caltrans® DESIGN

LAST REVISION: DATE PLOTTED => 18-NOV-2024
12-07-22 TIME PLOTTED => 16:10

BORDER LAST REVISED 7/2/2010 | USERNAME => s129144 | DGN FILE => 0419000140nc013.cco | RELATIVE BORDER SCALE IS IN INCHES 0 1 2 3 | UNIT 0712 | PROJECT NUMBER & PHASE 04190001401

CONTRACT CHANGE ORDER NO. 20
SHEET _____ OF _____

20 **REPLACED PER CONTRACT CHANGE ORDER No. 20**

Son Thanh Ly
No. 72584
Exp. 6-30-26
CIVIL
STATE OF CALIFORNIA
REGISTERED PROFESSIONAL ENGINEER

20

FOR REVISION ONLY
July 22, 2024
DATE

Dist	COUNTY	ROUTE	POST MILES TOTAL PROJECT	SHEET No.	TOTAL SHEETS
04	SCI	82	18.2/26.4	261A	466

AS-AWARDED CONTRACT PLANS
THIS STAMP PLACED IN LIEU OF ORIGINAL SIGNATURE

REGISTERED CIVIL ENGINEER DATE

PLANS APPROVAL DATE

REGISTERED PROFESSIONAL ENGINEER
No. _____
Exp. _____
CIVIL
STATE OF CALIFORNIA

THE STATE OF CALIFORNIA OR ITS OFFICERS OR AGENTS SHALL NOT BE RESPONSIBLE FOR THE ACCURACY OR COMPLETENESS OF SCANNED COPIES OF THIS PLAN SHEET.

TRAFFIC STRIPES, PAVEMENT MARKINGS AND PAVEMENT MARKERS

SHEET No.	LOCATION/STATION	DIRECTION	DETAIL No.	THERMOPLASTIC TRAFFIC STRIPE (ENHANCED WET NIGHT VISIBILITY)		TRAFFIC STRIPE TAPE (WARRANTY)			THERMOPLASTIC CROSSWALK AND PAVEMENT MARKING (ENHANCED WET NIGHT VISIBILITY)		PAVEMENT MARKERS (RETRO-REFLECTIVE)		DESCRIPTION/COMMENTS	REMOVE THERMOPLASTIC TRAFFIC STRIPE	REMOVE THERMOPLASTIC PAVEMENT MARKING	REMOVE MARKER
				6" WHITE	6" YELLOW	6" WHITE		8" WHITE								
				WHITE SOLID	YELLOW SOLID	BROKEN (17-7)	BROKEN (6-1)	WHITE SOLID	WHITE	YELLOW	G	RY				
				LF					SQFT		EA			LF	SQFT	EA
PD-16	"A1" 1188+49 TO 1188+49	N/A							45				LIMIT LINE			
	"A1" 1189+42 TO 1189+41	N/A							62				LIMIT LINE			
	"A1" 1188+50								72				KEEP			
	"A1" 1189+20								81				CLEAR			
PD-16 TO PD-17	"A1" 1189+45 TO 1196+54	NB	9			1,418					30					
	"A1" 1181+21 TO 1196+25	SB	9			3,008					63					
	"A1" 1189+43 TO 1192+47	SB							126				TYPE III (L)			
	"A1" 1189+41 TO 1196+35		25A		1388				84			60				
	"A1" 1189+42 TO 1192+47	SB	38					305			7					
	"A1" 1197+73 TO 1203+23	NB	9			1,099					13					
	"A1" 1197+36 TO 1203+14	SB	9			1,156					25					
	"A1" 1194+03 TO 1196+37	NB							126				TYPE III (L)			
	"A1" 1197+52 TO 1200+37	SB							126				TYPE III (L)			
	"A1" 1202+88 TO 1204+39	NB/SB							84				2 TYPE III (L)			
	"A1" 1197+51 TO 1203+14	NB	25A		563							24				
	"A1" 1195+20								22				ONLY			
	"A1" 1195+40								20				BUS			
	"A1" 1195+18 TO 1196+18								80				12" WHITE LINE			
	"A1" 1196+20 TO 1197+00		40				100		570							
PD-17	"A1" 1194+01 TO 1196+43	NB	38					242			11					
	"A1" 1197+46 TO 1200+36	SB	38					289			12					
	"A1" 1201+96 TO 1203+16	NB	38					120			5					
	"A1" 1204+34 TO 1205+25	SB	38					91			4					
	"A1" 1196+33 TO 1196+59								62				LIMIT LINE			
	"A1" 1196+18 TO 1196+07								170				CROSSWALK			
	"A1" 1197+34 TO 1197+57								60				LIMIT LINE			
	"A1" 1203+10 TO 1204+41								55				LIMIT LINE			
	"A1" 1203+19 TO 1204+12								180				CROSSWALK			
	"A1" 1203+36 TO 1204+31								180				CROSSWALK			
	"A1" 1204+28 TO 1204+41								55				LIMIT LINE			
PD-17 TO PD-18	"A1" 1204+47 TO 1214+24	NB	9			1,955					41					
	"A1" 1204+32 TO 1214+21	SB	9			1,978					42					
	"A1" 1204+39 TO 1214+17		25A		1954							84				
PD-18	"A1" 1213+93 TO 1213+93	NB							42				TYPE III (L)			
	"A1" 1215+12 TO 1217+27		25A		230							20				
	"A1" 1214+19 TO 1214+31								614				LADDER CROSSWALK			
	"A1" 1214+14 TO 1214+15								55				LIMIT LINE			
	"A1" 1215+09 TO 1215+13								45				LIMIT LINE			
	"A1" 1213+10 TO 1214+20	WB	38					109								
SHEET TOTAL					4135	10,614	100	1156	3016		253	188				

PAVEMENT DELINEATION QUANTITIES

PDQ-13A

REVISED BY: TG | DATE REVISED: 11-28-22
CALCULATED-DESIGNED BY: QUYNH NGUYEN | CHECKED BY: SON LY
FUNCTIONAL SUPERVISOR: TAM LY
STATE OF CALIFORNIA - DEPARTMENT OF TRANSPORTATION
Caltrans® DESIGN

LAST REVISION: DATE PLOTTED => 18-NOV-2024 | TIME PLOTTED => 16:10
12-07-22

BORDER LAST REVISED 7/2/2010
USERNAME => s129144
DGN FILE => 0419000140nc013A.cco
RELATIVE BORDER SCALE IS IN INCHES 0 1 2 3
UNIT 0712
PROJECT NUMBER & PHASE 04190001401

CONTRACT CHANGE ORDER NO. 20
SHEET _____ OF _____

20 **SHEET DELETED PER CONTRACT CHANGE ORDER No. 20**

Son Thanh Ly No. 72584 Exp. 6-30-26 CIVIL — REGISTERED PROFESSIONAL ENGINEER — STATE OF CALIFORNIA

FOR REVISION ONLY
July 22, 2024
DATE

20

Dist	COUNTY	ROUTE	POST MILES TOTAL PROJECT	SHEET No.	TOTAL SHEETS
04	SCI	82	18.2/26.4	262	466

AS-AWARDED CONTRACT PLANS
THIS STAMP PLACED IN LIEU OF ORIGINAL SIGNATURE
REGISTERED CIVIL ENGINEER DATE
PLANS APPROVAL DATE

REGISTERED PROFESSIONAL ENGINEER — No. Exp. CIVIL — STATE OF CALIFORNIA

THE STATE OF CALIFORNIA OR ITS OFFICERS OR AGENTS SHALL NOT BE RESPONSIBLE FOR THE ACCURACY OR COMPLETENESS OF SCANNED COPIES OF THIS PLAN SHEET.

TRAFFIC STRIPES, PAVEMENT MARKINGS AND PAVEMENT MARKERS

SHEET No.	LOCATION/STATION	DIRECTION	DETAIL No.	THERMOPLASTIC TRAFFIC STRIPE (ENHANCED WET NIGHT VISIBILITY) 6" WHITE SOLID (LF)	THERMOPLASTIC TRAFFIC STRIPE (ENHANCED WET NIGHT VISIBILITY) 6" YELLOW SOLID (LF)	TRAFFIC STRIPE TAPE (WARRANTY) 6" WHITE BROKEN (17-7) (LF)	TRAFFIC STRIPE TAPE (WARRANTY) 6" WHITE BROKEN (6-1) (LF)	TRAFFIC STRIPE TAPE (WARRANTY) 6" WHITE SOLID (LF)	TRAFFIC STRIPE TAPE (WARRANTY) 6" WHITE BROKEN (8-4) (LF)	TRAFFIC STRIPE TAPE (WARRANTY) 8" WHITE SOLID (LF)	THERMOPLASTIC PAVEMENT MARKING (BIKE LANE TREATMENT) GREEN (SQFT)	THERMOPLASTIC CROSSWALK AND PAVEMENT MARKING (ENHANCED WET NIGHT VISIBILITY) WHITE (SQFT)	THERMOPLASTIC CROSSWALK AND PAVEMENT MARKING (ENHANCED WET NIGHT VISIBILITY) YELLOW (SQFT)	PAVEMENT MARKERS (RETRORE-FLECTIVE) G (EA)	PAVEMENT MARKERS (RETRORE-FLECTIVE) RY (EA)	DELINEATOR (CLASS 1)	DESCRIPTION/COMMENTS	REMOVE THERMOPLASTIC TRAFFIC STRIPE LF	REMOVE THERMOPLASTIC PAVEMENT MARKING SQFT	REMOVE MARKER EA
	"A1" 1214+14 TO 1214+15	N/A										55						LIMIT LINE			
	"A1" 1215+09 TO 1215+13	N/A										45						LIMIT LINE			
	"A1" 1213+10 TO 1214+20	NB	38							109											
	"A1" 1214+60	NB										21						KEEP			
PD-18	"A1" 1214+80	NB										27						CLEAR			
	"A1" 1214+60	SB										21						KEEP			
	"A1" 1215+00	SB										27						CLEAR			
	"A1" 1216+20	SB										54						PED			
	"A1" 1216+60	SB										63						XING			
	"A1" 1216+31											36						12" LIMIT LINE			
	"A1" 1215+32 TO 1220+31	NB	9			998								30							
PD-18 TO PD-19	"A1" 1181+21 TO 1196+25	SB	9			1020								63							
	"A1" 1217+54 TO 1220+24	NB										84						TYPE III (L)			
	"A1" 1217+43 TO 1220+29		25A		572										24						
	"A1" 1217+55 TO 1220+29	NB	38							274				6							
	"A1" 1221+24 TO 1227+22	NB	9			1196								25							
	"A1" 1221+29 TO 1227+22	SB	9			1186								25							
	"A1" 1228+12 TO 1232+70	NB	9			915								20							
	"A1" 1228+14 TO 1232+68	SB	9			909								19							
	"A1" 1221+24 TO 1224+99	SB										126						TYPE III (L)			
	"A1" 1225+74 TO 1227+19	NB										84						TYPE III (L)			
	"A1" 1228+11 TO 1229+86	SB										84						TYPE III (L)			
	"A1" 1231+39 TO 1232+66	NB										84						TYPE III (L)			
	"A1" 1233+25 TO 1234+29	SB										84						TYPE III (L)			
	"A1" 1221+19 TO 1227+24		25A		1210										52						
	"A1" 1228+10 TO 1232+69		25A		916										40						
PD-19	"A1" 1220+26 TO 1220+37	N/A										542						LADDER CROSSWALK			
	"A1" 1221+05 TO 1221+28	N/A										646						LADDER CROSSWALK			
	"A1" 1227+25 TO 1227+36	N/A										542						LADDER CROSSWALK			
	"A1" 1233+05 TO 1233+29	N/A										580						LADDER CROSSWALK			
	"A1" 1221+23 TO 1225+07	SB	38							384				8							
	"A1" 1225+72 TO 1227+20	NB	38							148				4							
	"A1" 1228+10 TO 1229+88	SB	38							179				4							
	"A1" 1231+36 TO 1232+68	NB	38							132				3							
	"A1" 1233+21 TO 1234+30	SB	38							109				3							
	"A1" 1233+42	NB										64						GREEN PAVEMENT			
	"A1" 1233+42	NB										11.5						SHARROW			
	"A1" 1220+21 TO 1221+17	N/A										55						LIMIT LINE			
	"A1" 1220+43 TO 1221+17	N/A										120						LADDER CROSSWALK			
SHEET TOTAL					2698	6224				1335		3455.5		210	116						

PAVEMENT DELINEATION QUANTITIES

PDQ-14

CALCULATED-DESIGNED BY	CHECKED BY	FUNCTIONAL SUPERVISOR	REVISED BY	DATE REVISED
QUYNH NGUYEN	SON LY	TAM LY	TG	11-28-22

STATE OF CALIFORNIA - DEPARTMENT OF TRANSPORTATION
DESIGN

LAST REVISION | DATE PLOTTED => 18-NOV-2024
12-07-22 | TIME PLOTTED => 16:10

BORDER LAST REVISED 7/2/2010 | USERNAME => s129144 | DGN FILE => 0419000140nc014.cco | RELATIVE BORDER SCALE IS IN INCHES 0 1 2 3 | UNIT 0712 | PROJECT NUMBER & PHASE 04190001401

CONTRACT CHANGE ORDER NO. 20
SHEET _____ OF _____

20 REPLACED PER CONTRACT CHANGE ORDER No. 20 DATED

Son Thanh Ly
No. 72584
Exp. 6-30-26
CIVIL
STATE OF CALIFORNIA
FOR REVISION ONLY
July 22, 2024
DATE

20

Dist	COUNTY	ROUTE	POST MILES TOTAL PROJECT	SHEET No.	TOTAL SHEETS
04	SCI	82	18.2/26.4	262A	466

AS-AWARDED CONTRACT PLANS
THIS STAMP PLACED IN LIEU OF ORIGINAL SIGNATURE
REGISTERED CIVIL ENGINEER DATE
PLANS APPROVAL DATE
REGISTERED PROFESSIONAL ENGINEER No. Exp. CIVIL STATE OF CALIFORNIA
THE STATE OF CALIFORNIA OR ITS OFFICERS OR AGENTS SHALL NOT BE RESPONSIBLE FOR THE ACCURACY OR COMPLETENESS OF SCANNED COPIES OF THIS PLAN SHEET.

TRAFFIC STRIPES, PAVEMENT MARKINGS AND PAVEMENT MARKERS

SHEET No.	LOCATION/STATION	DIRECTION	DETAIL No.	THERMOPLASTIC TRAFFIC STRIPE (ENHANCED WET NIGHT VISIBILITY)		TRAFFIC STRIPE TAPE (WARRANTY)			THERMOPLASTIC CROSSWALK AND PAVEMENT MARKING (ENHANCED WET NIGHT VISIBILITY)		PAVEMENT MARKERS (RETRO-REFLECTIVE)		DESCRIPTION/COMMENTS	REMOVE THERMOPLASTIC TRAFFIC STRIPE	REMOVE THERMOPLASTIC PAVEMENT MARKING	REMOVE MARKER
				6" WHITE	6" YELLOW	6" WHITE		8" WHITE								
				WHITE SOLID	YELLOW SOLID	BROKEN (17-7)	BROKEN (6-1)	WHITE SOLID	WHITE	YELLOW	G	RY				
				LF					SQFT		EA			LF	SQFT	EA
	"A1" 1214+14 TO 1214+15	N/A							55				LIMIT LINE			
	"A1" 1215+09 TO 1215+13	N/A							45				LIMIT LINE			
	"A1" 1213+10 TO 1214+20	NB	38					109								
	"A1" 1214+60	NB							21				KEEP			
PD-18	"A1" 1214+80	NB							27				CLEAR			
	"A1" 1214+60	SB							21				KEEP			
	"A1" 1215+00	SB							27				CLEAR			
	"A1" 1216+20	SB							54				PED			
	"A1" 1216+60	SB							63				XING			
	"A1" 1216+31								36				12" LIMIT LINE			
	"A1" 1215+32 TO 1220+31	NB	9			998					30					
PD-18 TO PD-19	"A1" 1181+21 TO 1196+25	SB	9			1020					63					
	"A1" 1217+54 TO 1220+24	NB							84				TYPE III (L)			
	"A1" 1217+43 TO 1220+29		25A		572							24				
	"A1" 1217+55 TO 1220+29	NB	38					274			6					
	"A1" 1221+24 TO 1227+22	NB	9			1196					25					
	"A1" 1221+29 TO 1227+22	SB	9			1186					25					
	"A1" 1228+12 TO 1232+70	NB	9			915					20					
	"A1" 1228+14 TO 1232+68	SB	9			909					19					
	"A1" 1221+24 TO 1224+99	SB							126				TYPE III (L)			
	"A1" 1225+74 TO 1227+19	NB							84				TYPE III (L)			
	"A1" 1228+11 TO 1229+86	SB							84				TYPE III (L)			
	"A1" 1231+39 TO 1232+66	NB							84				TYPE III (L)			
	"A1" 1233+25 TO 1234+29	SB							84				TYPE III (L)			
	"A1" 1221+19 TO 1227+24		25A		1210							52				
	"A1" 1228+10 TO 1232+69		25A		916							40				
PD-19	"A1" 1220+26 TO 1220+37	N/A							542				LADDER CROSSWALK			
	"A1" 1221+05 TO 1221+28	N/A							646				LADDER CROSSWALK			
	"A1" 1227+25 TO 1227+36	N/A							542				LADDER CROSSWALK			
	"A1" 1233+05 TO 1233+29	N/A							580				LADDER CROSSWALK			
	"A1" 1221+23 TO 1225+07	SB	38					384			8					
	"A1" 1225+72 TO 1227+20	NB	38					148			4					
	"A1" 1228+10 TO 1229+88	SB	38					179			4					
	"A1" 1231+36 TO 1232+68	NB	38					132			3					
	"A1" 1233+21 TO 1234+30	SB	38					109			3					
	"A1" 1233+42	NB							64				GREEN PAVEMENT			
	"A1" 1220+21 TO 1221+17	N/A							55				LIMIT LINE			
	"A1" 1220+43 TO 1221+17	N/A							120				LADDER CROSSWALK			
SHEET TOTAL					2698	6224		1335	3444		210	116				

PAVEMENT DELINEATION QUANTITIES

PDQ-14A

CALCULATED-DESIGNED BY	CHECKED BY	FUNCTIONAL SUPERVISOR	REVISED BY	DATE REVISED
QUYNH NGUYEN	SON LY	TAM LY	TG	11-28-22

STATE OF CALIFORNIA - DEPARTMENT OF TRANSPORTATION
DESIGN

LAST REVISION | DATE PLOTTED => 18-NOV-2024
12-07-22 | TIME PLOTTED => 16:10

BORDER LAST REVISED 7/2/2010 | USERNAME => s129144 | DGN FILE => 0419000140nc014A.cco | RELATIVE BORDER SCALE IS IN INCHES 0 1 2 3 | UNIT 0712 | PROJECT NUMBER & PHASE 04190001401

CONTRACT CHANGE ORDER NO. 20
SHEET _____ OF _____

20 SHEET DELETED PER CONTRACT CHANGE ORDER No. 20 DATED

TRAFFIC STRIPES, PAVEMENT MARKINGS AND PAVEMENT MARKERS

SHEET No.	LOCATION/STATION	DIRECTION	DETAIL No.	THERMOPLASTIC TRAFFIC STRIPE (ENHANCED WET NIGHT VISIBILITY)		TRAFFIC STRIPE TAPE (WARRANTY)					THERMOPLASTIC PAVEMENT MARKING (BIKE LANE TREATMENT)	THERMOPLASTIC CROSSWALK AND PAVEMENT MARKING (ENHANCED WET NIGHT VISIBILITY)		PAVEMENT MARKERS (RETRO-REFLECTIVE)		DELINEATOR (CLASS 1)	DESCRIPTION/COMMENTS	REMOVE THERMOPLASTIC TRAFFIC STRIPE	REMOVE THERMOPLASTIC PAVEMENT MARKING	REMOVE MARKER
				6" WHITE	6" YELLOW	6" WHITE				8" WHITE										
				WHITE SOLID	YELLOW SOLID	BROKEN (17-7)	BROKEN (6-1)	SOLID	BROKEN (8-4)	WHITE SOLID	GREEN	WHITE	YELLOW	G	RY			LF	SQFT	EA
				LF							SQFT			EA						
PD-19	"A1" 1220+32 TO 1221+05	N/A										140					LADDER CROSSWALK			
	"A1" 1221+27 TO 1221+33	N/A										60					LIMIT LINE			
	"A1" 1227+20 TO 1227+21	N/A										60					LIMIT LINE			
	"A1" 1227+37 TO 1228+00	N/A										110					LADDER CROSSWALK			
	"A1" 1228+10 TO 1223+28	N/A										165					LIMIT LINE			
	"A1" 1233+50											54					PED			
	"A1" 1234+10											63					XING			
PD-19 TO PD 20	"A1" 1233+28 TO 1235+38	NB	9			419								9						
	"A1" 1233+20 TO 1235+44	SB	9			448								10						
	"A1" 1233+25 TO 1235+48		25A		448										20					
	"A1" 1236+36 TO 1242+52	NB	9			1232								26						
	"A1" 1236+28 TO 1242+52	SB	9			1248								26						
	"A1" 1243+93 TO 1246+13	NB	9			440								10						
	"A1" 1235+11 TO 1235+11	NB										42					TYPE III (L)			
	"A1" 1237+79 TO 1238+83	SB										84					TYPE III (L)			
	"A1" 1240+76 TO 1242+50	NB										84					TYPE III (L)			
	"A1" 1243+93 TO 1243+93	SB										42					TYPE III (L)			
	"A1" 1246+05 TO 1246+05	NB										42					TYPE III (L)			
	"A1" 1246+97 TO 1248+40	SB										84					TYPE III (L)			
	"A1" 1235+97 TO 1235+97	SB										81					CLEAR			
	"A1" 1236+10 TO 1236+10	SB										72					KEEP			
	"A1" 1237+98 TO 1237+98	SB	38									49.5								
	"A1" 1237+71 TO 1242+50		25A		958										40					
PD-20	"A1" 1243+91 TO 1246+06		25A		430										20					
	"A1" 1235+60 TO 1235+71	N/A										564					LADDER CROSSWALK			
	"A1" 1237+52 TO 1237+77	N/A										548					LADDER CROSSWALK			
	"A1" 1242+52 TO 1242+63	N/A										554					LADDER CROSSWALK			
	"A1" 1243+42 TO 1243+91	N/A										618					LADDER CROSSWALK			
	"A1" 1246+10 TO 1246+28	N/A										592					LADDER CROSSWALK			
	"A1" 1234+90 TO 1235+38	NB	38							49				2						
	"A1" 1237+71 TO 1238+83	SB	38							112				3						
	"A1" 1240+74 TO 1242+52	NB	38							177				4						
	"A1" 1243+85 TO 1244+72	SB	38							87				2						
	"A1" 1245+40 TO 1246+13	NB	38							73				2						
	"A1" 1246+94 TO 1248+41	SB	38							147				4						
	"A1" 1235+41 TO 1235+41	N/A										55					LIMIT LINE			
	"A1" 1237+84 TO 1237+84	N/A										55					LIMIT LINE			
	"A1" 1242+47 TO 1242+46	N/A										55					LIMIT LINE			
SHEET TOTAL					1836	3787				645		4273.5		98	80					

FOR REVISION ONLY
July 22, 2024
DATE

Dist	COUNTY	ROUTE	POST MILES TOTAL PROJECT	SHEET No.	TOTAL SHEETS
04	SCI	82	18.2/26.4	263	466

AS-AWARDED CONTRACT PLANS
THIS STAMP PLACED IN LIEU OF ORIGINAL SIGNATURE
REGISTERED CIVIL ENGINEER DATE
PLANS APPROVAL DATE

THE STATE OF CALIFORNIA OR ITS OFFICERS OR AGENTS SHALL NOT BE RESPONSIBLE FOR THE ACCURACY OR COMPLETENESS OF SCANNED COPIES OF THIS PLAN SHEET.

REVISED BY: TG — DATE REVISED: 11-28-22
CALCULATED-DESIGNED BY: QUYNH NGUYEN — CHECKED BY: SON LY
FUNCTIONAL SUPERVISOR: TAM LY

STATE OF CALIFORNIA - DEPARTMENT OF TRANSPORTATION
DESIGN

PAVEMENT DELINEATION QUANTITIES

PDQ-15

LAST REVISION | DATE PLOTTED => 18-NOV-2024
12-07-22 | TIME PLOTTED => 16:10

BORDER LAST REVISED 7/2/2010 | USERNAME => s129144 | DGN FILE => 0419000140nc015.cco | RELATIVE BORDER SCALE IS IN INCHES 0 1 2 3 | UNIT 0712 | PROJECT NUMBER & PHASE 04190001401

CONTRACT CHANGE ORDER NO. 20
SHEET _____ OF _____

20 REPLACED PER CONTRACT CHANGE ORDER No. 20 DATED

Son Thanh Ly
No. 72584
Exp. 6-30-26
CIVIL
STATE OF CALIFORNIA

FOR REVISION ONLY
July 22, 2024
DATE

20

Dist	COUNTY	ROUTE	POST MILES TOTAL PROJECT	SHEET No.	TOTAL SHEETS
04	SCI	82	18.2/26.4	263A	466

AS-AWARDED CONTRACT PLANS
THIS STAMP PLACED IN LIEU OF ORIGINAL SIGNATURE
REGISTERED CIVIL ENGINEER DATE
PLANS APPROVAL DATE

REGISTERED PROFESSIONAL ENGINEER
No. _____
Exp. _____
CIVIL
STATE OF CALIFORNIA

THE STATE OF CALIFORNIA OR ITS OFFICERS OR AGENTS SHALL NOT BE RESPONSIBLE FOR THE ACCURACY OR COMPLETENESS OF SCANNED COPIES OF THIS PLAN SHEET.

TRAFFIC STRIPES, PAVEMENT MARKINGS AND PAVEMENT MARKERS

SHEET No.	LOCATION/STATION	DIRECTION	DETAIL No.	THERMOPLASTIC TRAFFIC STRIPE (ENHANCED WET NIGHT VISIBILITY)		TRAFFIC STRIPE TAPE (WARRANTY)			THERMOPLASTIC CROSSWALK AND PAVEMENT MARKING (ENHANCED WET NIGHT VISIBILITY)		PAVEMENT MARKERS (RETRORE-FLECTIVE)		DESCRIPTION/COMMENTS	REMOVE THERMOPLASTIC TRAFFIC STRIPE	REMOVE THERMOPLASTIC PAVEMENT MARKING	REMOVE MARKER
				6" WHITE	6" YELLOW	6" WHITE		8" WHITE								
				WHITE SOLID	YELLOW SOLID	BROKEN (17-7)	BROKEN (6-1)	WHITE SOLID	WHITE	YELLOW	G	RY				
				LF					SQFT		EA			LF	SQFT	EA
	"A1" 1220+32 TO 1221+05	N/A							140				LADDER CROSSWALK			
	"A1" 1221+27 TO 1221+33	N/A							60				LIMIT LINE			
	"A1" 1227+20 TO 1227+21	N/A							60				LIMIT LINE			
PD-19	"A1" 1227+37 TO 1228+00	N/A							110				LADDER CROSSWALK			
	"A1" 1228+10 TO 1223+28	N/A							165				LIMIT LINE			
	"A1" 1233+50								54				PED			
	"A1" 1234+10								63				XING			
PD-19	"A1" 1233+28 TO 1235+38	NB	9			419					9					
TO	"A1" 1233+20 TO 1235+44	SB	9			448					10					
PD 20	"A1" 1233+25 TO 1235+48		25A		448							20				
	"A1" 1236+36 TO 1242+52	NB	9			1232					26					
	"A1" 1236+28 TO 1242+52	SB	9			1248					26					
	"A1" 1243+93 TO 1246+13	NB	9			440					10					
	"A1" 1235+11 TO 1235+11	NB							42				TYPE III (L)			
	"A1" 1237+79 TO 1238+83	SB							84				TYPE III (L)			
	"A1" 1240+76 TO 1242+50	NB							84				TYPE III (L)			
	"A1" 1243+93 TO 1243+93	SB							42				TYPE III (L)			
	"A1" 1246+05 TO 1246+05	NB							42				TYPE III (L)			
	"A1" 1246+97 TO 1248+40	SB							84				TYPE III (L)			
	"A1" 1235+97 TO 1235+97	SB							81				CLEAR			
	"A1" 1236+10 TO 1236+10	SB							72				KEEP			
	"A1" 1237+98 TO 1237+98	SB	38						49.5							
	"A1" 1237+71 TO 1242+50		25A		958							40				
PD-20	"A1" 1243+91 TO 1246+06		25A		430							20				
	"A1" 1235+60 TO 1235+71	N/A							564				LADDER CROSSWALK			
	"A1" 1237+52 TO 1237+77	N/A							548				LADDER CROSSWALK			
	"A1" 1242+52 TO 1242+63	N/A							554				LADDER CROSSWALK			
	"A1" 1243+42 TO 1243+91	N/A							618				LADDER CROSSWALK			
	"A1" 1246+10 TO 1246+28	N/A							592				LADDER CROSSWALK			
	"A1" 1234+90 TO 1235+38	NB	38					49			2					
	"A1" 1237+71 TO 1238+83	SB	38					112			3					
	"A1" 1240+74 TO 1242+52	NB	38					177			4					
	"A1" 1243+85 TO 1244+72	SB	38					87			2					
	"A1" 1245+40 TO 1246+13	NB	38					73			2					
	"A1" 1246+94 TO 1248+41	SB	38					147			4					
	"A1" 1235+41 TO 1235+41	N/A							55				LIMIT LINE			
	"A1" 1237+84 TO 1237+84	N/A							55				LIMIT LINE			
	"A1" 1242+47 TO 1242+46	N/A							55				LIMIT LINE			
SHEET TOTAL					1836	3787		645	4273.5		98	80				

PAVEMENT DELINEATION QUANTITIES

PDQ-15A

CALCULATED-DESIGNED BY	CHECKED BY	REVISED BY	DATE REVISED
QUYNH NGUYEN	SON LY	TG	11-28-22

FUNCTIONAL SUPERVISOR: TAM LY

STATE OF CALIFORNIA - DEPARTMENT OF TRANSPORTATION
DESIGN
Caltrans

LAST REVISION | DATE PLOTTED => 18-NOV-2024
12-07-22 | TIME PLOTTED => 16:10

CONTRACT CHANGE ORDER NO. 20
SHEET _____ OF _____

20 **SHEET DELETED PER CONTRACT CHANGE ORDER No. 20 DATED**

REGISTERED PROFESSIONAL ENGINEER — Son Thanh Ly — No. 72584 — Exp. 6-30-26 — CIVIL — STATE OF CALIFORNIA

20

FOR REVISION ONLY
July 22, 2024
DATE

Dist	COUNTY	ROUTE	POST MILES TOTAL PROJECT	SHEET No.	TOTAL SHEETS
04	SCI	82	18.2/26.4	264	466

AS-AWARDED CONTRACT PLANS
THIS STAMP PLACED IN LIEU OF ORIGINAL SIGNATURE
REGISTERED CIVIL ENGINEER DATE
PLANS APPROVAL DATE

REGISTERED PROFESSIONAL ENGINEER — No. _____ — Exp. _____ — CIVIL — STATE OF CALIFORNIA

THE STATE OF CALIFORNIA OR ITS OFFICERS OR AGENTS SHALL NOT BE RESPONSIBLE FOR THE ACCURACY OR COMPLETENESS OF SCANNED COPIES OF THIS PLAN SHEET.

TRAFFIC STRIPES, PAVEMENT MARKINGS AND PAVEMENT MARKERS

SHEET No.	LOCATION/STATION	DIRECTION	DETAIL No.	THERMOPLASTIC TRAFFIC STRIPE (ENHANCED WET NIGHT VISIBILITY)		TRAFFIC STRIPE TAPE (WARRANTY)					THERMOPLASTIC PAVEMENT MARKING (BIKE LANE TREATMENT)	THERMOPLASTIC CROSSWALK AND PAVEMENT MARKING (ENHANCED WET NIGHT VISIBILITY)		PAVEMENT MARKERS (RETRO-REFLECTIVE)		DELINEATOR (CLASS 1)	DESCRIPTION/COMMENTS	REMOVE THERMOPLASTIC TRAFFIC STRIPE	REMOVE THERMOPLASTIC PAVEMENT MARKING	REMOVE MARKER
				6" WHITE	6" YELLOW	6" WHITE				8" WHITE										
				WHITE SOLID	YELLOW SOLID	BROKEN (17-7)	BROKEN (6-1)	SOLID	BROKEN (8-4)	WHITE SOLID	GREEN	WHITE	YELLOW	G	RY			LF	SQFT	EA
				LF							SQFT			EA						
PD-20	"A1" 1243+28 TO 1243+72	N/A										90					LADDER CROSSWALK			
	"A1" 1243+62 TO 1243+99	N/A										65					LIMIT LINE			
	"A1" 1245+87 TO 1245+91	N/A										55					LIMIT LINE			
	"A1" 1246+93 TO 1246+94	N/A										55					LIMIT LINE			
	"A1" 1235+90	SB										81					CLEAR			
	"A1" 1236+30	SB										72					KEEP			
	"A1" 1240+00	SB										63					XING			
	"A1" 1240+40	SB										54					PED			
	"A1" 1244+70	NB										54					PED			
	"A1" 1245+10	NB										63					XING			
PD-20 TO PD-21	"A1" 1246+96 TO 1254+85	NB	9			1578								33						
	"A1" 1243+71 TO 1254+86	SB	9			2230								47						
	"A1" 1246+94 TO 1251+80		25A		974										44					
PD-21	"A1" 1255+50 TO 1256+35	NB	9			170								4						
	"A1" 1255+50 TO 1256+37	SB	9			173								4			4 TRAFFIC STRIPES			
	"A1" 1252+19 TO 1254+84	NB										84					TYPE III (L)			
	"A1" 1257+19 TO 1258+32	SB										84					TYPE III (L)			
	"A1" 1261+90 TO 1261+90	NB										42					TYPE III (L)			
	"A1" 1263+19 TO 1264+37	SB										84					TYPE III (L)			
	"A1" 1268+40	SB										42					TYPE VI (L)			
	"A1" 1270+20 TO 1271+70	SB										64					TYPE III (R)			
	"A1" 1252+14 TO 1254+87		25A		548										24					
	"A1" 1257+12 TO 1262+15		25A		1004										44					
	"A1" 1254+62 TO 1254+87	N/A										124					LADDER CROSSWALK			
	"A1" 1254+86 TO 1254+96	N/A										548					LADDER CROSSWALK			
	"A1" 1254+98 TO 1255+38	N/A										212					LADDER CROSSWALK			
	"A1" 1255+42 TO 1255+61	N/A										108					LADDER CROSSWALK			
	"A1" 1256+84 TO 1257+18	N/A										570					LADDER CROSSWALK			
	"A1" 1252+18 TO 1254+86	NB	38							268				12						
	"A1" 1257+16 TO 1258+31	SB	38							115				5						
	"A1" 1261+46 TO 1262+11	NB	38							64				3						
	"A1" 1263+17 TO 1264+38	SB	38							122				5						
	"A1" 1254+80 TO 1254+81	N/A										55					LIMIT LINE			
	"A1" 1255+50 TO 1255+51	N/A										50					LIMIT LINE			
	"A1" 1256+35 TO 1256+35	N/A										45					LIMIT LINE			
	"A1" 1256+44 TO 1256+82	N/A										70					LADDER CROSSWALK			
	"A1" 1257+14 TO 1257+24	N/A										55					LIMIT LINE			
SHEET TOTAL					2526	4151				569		2889		113	112					

PAVEMENT DELINEATION QUANTITIES

PDQ-16

CALCULATED-DESIGNED BY: QUYNH NGUYEN
CHECKED BY: SON LY
FUNCTIONAL SUPERVISOR: TAM LY
REVISED BY: TG
DATE REVISED: 11-28-22

STATE OF CALIFORNIA - DEPARTMENT OF TRANSPORTATION
DESIGN

LAST REVISION | DATE PLOTTED => 18-NOV-2024
12-07-22 | TIME PLOTTED => 16:10

BORDER LAST REVISED 7/2/2010
USERNAME => s129144
DGN FILE => 0419000140nc016.cco
RELATIVE BORDER SCALE IS IN INCHES 0 1 2 3
UNIT 0712
PROJECT NUMBER & PHASE 04190001401

CONTRACT CHANGE ORDER NO. 20
SHEET _____ OF _____

20 REPLACED PER CONTRACT CHANGE ORDER No. 20 DATED

Son Thanh Ly
No. 72584
Exp. 6-30-26
CIVIL
STATE OF CALIFORNIA
REGISTERED PROFESSIONAL ENGINEER

20

FOR REVISION ONLY
July 22, 2024
DATE

Dist	COUNTY	ROUTE	POST MILES TOTAL PROJECT	SHEET No.	TOTAL SHEETS
04	SCI	82	18.2/26.4	264A	466

AS-AWARDED CONTRACT PLANS
THIS STAMP PLACED IN LIEU OF ORIGINAL SIGNATURE

REGISTERED CIVIL ENGINEER DATE

PLANS APPROVAL DATE

No. Exp. CIVIL
REGISTERED PROFESSIONAL ENGINEER
STATE OF CALIFORNIA

THE STATE OF CALIFORNIA OR ITS OFFICERS OR AGENTS SHALL NOT BE RESPONSIBLE FOR THE ACCURACY OR COMPLETENESS OF SCANNED COPIES OF THIS PLAN SHEET.

TRAFFIC STRIPES, PAVEMENT MARKINGS AND PAVEMENT MARKERS

SHEET No.	LOCATION/STATION	DIRECTION	DETAIL No.	THERMOPLASTIC TRAFFIC STRIPE (ENHANCED WET NIGHT VISIBILITY)		TRAFFIC STRIPE TAPE (WARRANTY)			THERMOPLASTIC CROSSWALK AND PAVEMENT MARKING (ENHANCED WET NIGHT VISIBILITY)		PAVEMENT MARKERS (RETROREFLECTIVE)		DESCRIPTION/COMMENTS	REMOVE THERMOPLASTIC TRAFFIC STRIPE	REMOVE THERMOPLASTIC PAVEMENT MARKING	REMOVE MARKER
				6" WHITE	6" YELLOW	6" WHITE		8" WHITE								
				WHITE SOLID	YELLOW SOLID	BROKEN (17-7)	BROKEN (6-1)	WHITE SOLID	WHITE	YELLOW	G	RY				
				LF					SQFT		EA			LF	SQFT	EA
PD-20	"A1" 1243+28 TO 1243+72	N/A							90				LADDER CROSSWALK			
	"A1" 1243+62 TO 1243+99	N/A							65				LIMIT LINE			
	"A1" 1245+87 TO 1245+91	N/A							55				LIMIT LINE			
	"A1" 1246+93 TO 1246+94	N/A							55				LIMIT LINE			
	"A1" 1235+90	SB							81				CLEAR			
	"A1" 1236+30	SB							72				KEEP			
	"A1" 1240+00	SB							63				XING			
	"A1" 1240+40	SB							54				PED			
	"A1" 1244+70	NB							54				PED			
	"A1" 1245+10	NB							63				XING			
PD-20 TO PD-21	"A1" 1246+96 TO 1254+85	NB	9			1578					33					
	"A1" 1243+71 TO 1254+86	SB	9			2230					47					
	"A1" 1246+94 TO 1251+80		25A		974							44				
	"A1" 1255+50 TO 1256+35	NB	9			170					4					
	"A1" 1255+50 TO 1256+37	SB	9			173					4		4 TRAFFIC STRIPES			
	"A1" 1252+19 TO 1254+84	NB							84				TYPE III (L)			
	"A1" 1257+19 TO 1258+32	SB							84				TYPE III (L)			
	"A1" 1261+90 TO 1261+90	NB							42				TYPE III (L)			
	"A1" 1263+19 TO 1264+37	SB							84				TYPE III (L)			
	"A1" 1268+40	SB							42				TYPE VI (L)			
	"A1" 1270+20 TO 1271+70	SB							64				TYPE III (R)			
	"A1" 1252+14 TO 1254+87		25A		548							24				
	"A1" 1257+12 TO 1262+15		25A		1004							44				
PD-21	"A1" 1254+62 TO 1254+87	N/A							124				LADDER CROSSWALK			
	"A1" 1254+86 TO 1254+96	N/A							548				LADDER CROSSWALK			
	"A1" 1254+98 TO 1255+38	N/A							212				LADDER CROSSWALK			
	"A1" 1255+42 TO 1255+61	N/A							108				LADDER CROSSWALK			
	"A1" 1256+84 TO 1257+18	N/A							570				LADDER CROSSWALK			
	"A1" 1252+18 TO 1254+86	NB	38					268			12					
	"A1" 1257+16 TO 1258+31	SB	38					115			5					
	"A1" 1261+46 TO 1262+11	NB	38					64			3					
	"A1" 1263+17 TO 1264+38	SB	38					122			5					
	"A1" 1254+80 TO 1254+81	N/A							55				LIMIT LINE			
	"A1" 1255+50 TO 1255+51	N/A							50				LIMIT LINE			
	"A1" 1256+35 TO 1256+35	N/A							45				LIMIT LINE			
	"A1" 1256+44 TO 1256+82	N/A							70				LADDER CROSSWALK			
	"A1" 1257+14 TO 1257+24	N/A							55				LIMIT LINE			
SHEET TOTAL					2526	4151		569	2889		113	112				

REVISED BY: TG | DATE REVISED: 11-28-22
CALCULATED-DESIGNED BY: QUYNH NGUYEN | CHECKED BY: SON LY
FUNCTIONAL SUPERVISOR: TAM LY

STATE OF CALIFORNIA - DEPARTMENT OF TRANSPORTATION
DESIGN

PAVEMENT DELINEATION QUANTITIES

PDQ-16A

LAST REVISION | DATE PLOTTED => 18-NOV-2024
12-07-22 | TIME PLOTTED => 16:11

BORDER LAST REVISED 7/2/2010
USERNAME => s129144
DGN FILE => 0419000140nc016A.cco
RELATIVE BORDER SCALE IS IN INCHES 0 1 2 3
UNIT 0712
PROJECT NUMBER & PHASE 04190001401

CONTRACT CHANGE ORDER NO. 20
SHEET _____ OF _____

20 SHEET DELETED PER CONTRACT CHANGE ORDER No. 20 DATED

TRAFFIC STRIPES, PAVEMENT MARKINGS AND PAVEMENT MARKERS

REGISTERED PROFESSIONAL ENGINEER — Son Thanh Ly — No. 72584 — Exp. 6-30-26 — CIVIL — STATE OF CALIFORNIA

FOR REVISION ONLY
July 22, 2024
DATE

20

Dist	COUNTY	ROUTE	POST MILES TOTAL PROJECT	SHEET No.	TOTAL SHEETS
04	SCI	82	18.2/26.4	265	466

AS-AWARDED CONTRACT PLANS
THIS STAMP PLACED IN LIEU OF ORIGINAL SIGNATURE
REGISTERED CIVIL ENGINEER DATE
PLANS APPROVAL DATE

REGISTERED PROFESSIONAL ENGINEER — No. _____ — Exp. _____ — CIVIL — STATE OF CALIFORNIA

THE STATE OF CALIFORNIA OR ITS OFFICERS OR AGENTS SHALL NOT BE RESPONSIBLE FOR THE ACCURACY OR COMPLETENESS OF SCANNED COPIES OF THIS PLAN SHEET.

SHEET No.	LOCATION/STATION	DIRECTION	DETAIL No.	THERMOPLASTIC TRAFFIC STRIPE (ENHANCED WET NIGHT VISIBILITY)		TRAFFIC STRIPE TAPE (WARRANTY)					THERMOPLASTIC PAVEMENT MARKING (BIKE LANE TREATMENT)	THERMOPLASTIC CROSSWALK AND PAVEMENT MARKING (ENHANCED WET NIGHT VISIBILITY)		PAVEMENT MARKERS (RETRORE-FLECTIVE)		DELINEATOR (CLASS 1)	DESCRIPTION/COMMENTS	REMOVE THERMOPLASTIC TRAFFIC STRIPE	REMOVE THERMOPLASTIC PAVEMENT MARKING	REMOVE MARKER
				6" WHITE	6" YELLOW	6" WHITE				8" WHITE										
				WHITE SOLID	YELLOW SOLID	BROKEN (17-7)	BROKEN (6-1)	SOLID	BROKEN (8-4)	WHITE SOLID	GREEN	WHITE	YELLOW	G	RY			LF	SQFT	EA
				LF							SQFT			EA						
PD-21	"A1" 1256+99 TO 1268+50	NB	9			2,300								48						
TO	"A1" 1257+10 TO 1268+46	SB	9			2,272								48						
PD-22	"A1" 1263+17 TO 1268+42		25A		1050										44					
	"A1" 1265+60 TO 1268+42	NB										252					TYPE III (L)			
	"A1" 1269+93 TO 1273+21	SB										252					TYPE III (L)			
	"A1" 1274+39 TO 1275+58	NB										84					TYPE III (L)			
	"A1" 1276+40 TO 1277+33	SB										84					TYPE III (L)			
	"A1" 1269+94 TO 1275+59		25A		1130										48					
	"A1" 1268+44 TO 1268+62	N/A										570					LADDER CROSSWALK			
	"A1" 1269+73 TO 1269+93	N/A										624					LADDER CROSSWALK			
	"A1" 1268+44 TO 1269+93	N/A					200													
	"A1" 1269+73 TO 1269+93	NB	38							287				12						
PD-22	"A1" 1265+61 TO 1268+48	NB	38							289				12						
	"A1" 1269+90 TO 1273+22	SB	38							332				14						
	"A1" 1269+89 TO 1273+22	SB	38							333				14						
	"A1" 1274+38 TO 1275+58	NB	38							120				5						
	"A1" 1276+38 TO 1277+33	SB	38							94				2						
	"A1" 1268+42 TO 1268+46	N/A										60					LIMIT LINE			
	"A1" 1268+72 TO 1269+68	N/A										190					LADDER CROSSWALK			
	"A1" 1268+73 TO 1269+67	N/A										190					LADDER CROSSWALK			
	"A1" 1269+98 TO 1269+93	N/A										70					LIMIT LINE			
	"A1" 1270+00 TO 1271+00	SB										84					TYPE III (R)			
PD-22	"A1" 1269+85 TO 1282+05	NB	9			2,441								51						
TO	"A1" 1269+85 TO 1282+06	SB	9			2,428								51						
PD-23	"A1" 1276+36 TO 1282+07		25A		1142										48					
	"A1" 1282+93 TO 1285+57	NB	9			527								11						
	"A1" 1282+86 TO 1285+39	SB	9			506								11						
	"A1" 1286+23 TO 1288+60	NB	9			475								10						
	"A1" 1285+95 TO 1288+53	SB	9			516								11						
	"A1" 1279+93 TO 1281+95	NB										84					TYPE III (L)			
	"A1" 1282+93 TO 1284+26	SB										84					TYPE III (L)			
	"A1" 1286+10 TO 1286+10	SB										42					TYPE III (L)			
PD-23	"A1" 1288+31 TO 1288+31	NB										42					TYPE III (L)			
	"A1" 1289+55 TO 1290+60	SB										84					TYPE III (L)			
	"A1" 1282+94 TO 1285+41		25A		946										24					
	"A1" 1286+16 TO 1288+58		25A		484										24					
	"A1" 1282+05 TO 1282+26	N/A										576					LADDER CROSSWALK			
	"A1" 1282+71 TO 1282+93	N/A										570					LADDER CROSSWALK			
	"A1" 1285+36 TO 1285+71	N/A										598					LADDER CROSSWALK			
	"A1" 1285+82 TO 1286+25	N/A										576					LADDER CROSSWALK			
SHEET TOTAL					4752	11,465	200			1455		5116		300	188					

PAVEMENT DELINEATION QUANTITIES

PDQ-17

CALCULATED-DESIGNED BY		REVISED BY	TG
CHECKED BY		DATE REVISED	11-28-22
FUNCTIONAL SUPERVISOR	TAM LY		
		QUYNH NGUYEN	SON LY

STATE OF CALIFORNIA - DEPARTMENT OF TRANSPORTATION
Caltrans® DESIGN

LAST REVISION DATE PLOTTED => 18-NOV-2024
12-07-22 TIME PLOTTED => 16:11

BORDER LAST REVISED 7/2/2010 | USERNAME => s129144 | DGN FILE => 0419000140nc017.cco | RELATIVE BORDER SCALE IS IN INCHES 0 1 2 3 | UNIT 0712 | PROJECT NUMBER & PHASE 04190001401

CONTRACT CHANGE ORDER NO. 20
SHEET _____ OF _____

20 **REPLACED PER CONTRACT CHANGE ORDER No. 20 DATED**

Son Thanh Ly
No. 72584
Exp. 6-30-26
CIVIL
STATE OF CALIFORNIA
REGISTERED PROFESSIONAL ENGINEER

20

FOR REVISION ONLY
July 22, 2024
DATE

Dist	COUNTY	ROUTE	POST MILES TOTAL PROJECT	SHEET No.	TOTAL SHEETS
04	SCI	82	18.2/26.4	265A	466

AS-AWARDED CONTRACT PLANS
THIS STAMP PLACED IN LIEU OF ORIGINAL SIGNATURE

REGISTERED CIVIL ENGINEER DATE

PLANS APPROVAL DATE

REGISTERED PROFESSIONAL ENGINEER
No. _____
Exp. _____
CIVIL
STATE OF CALIFORNIA

THE STATE OF CALIFORNIA OR ITS OFFICERS OR AGENTS SHALL NOT BE RESPONSIBLE FOR THE ACCURACY OR COMPLETENESS OF SCANNED COPIES OF THIS PLAN SHEET.

TRAFFIC STRIPES, PAVEMENT MARKINGS AND PAVEMENT MARKERS

SHEET No.	LOCATION/STATION	DIRECTION	DETAIL No.	THERMOPLASTIC TRAFFIC STRIPE (ENHANCED WET NIGHT VISIBILITY)		TRAFFIC STRIPE TAPE (WARRANTY)			THERMOPLASTIC CROSSWALK AND PAVEMENT MARKING (ENHANCED WET NIGHT VISIBILITY)		PAVEMENT MARKERS (RETRORE-FLECTIVE)		DESCRIPTION/COMMENTS	REMOVE THERMOPLASTIC TRAFFIC STRIPE	REMOVE THERMOPLASTIC PAVEMENT MARKING	REMOVE MARKER
				6" WHITE	6" YELLOW	6" WHITE		8" WHITE								
				WHITE SOLID	YELLOW SOLID	BROKEN (17-7)	BROKEN (6-1)	WHITE SOLID	WHITE	YELLOW	G	RY		LF	SQFT	EA
				LF					SQFT		EA					
PD-21 TO PD-22	"A1" 1256+99 TO 1268+50	NB	9			2,300					48					
	"A1" 1257+10 TO 1268+46	SB	9			2,272					48					
	"A1" 1263+17 TO 1268+42		25A		1050							44				
	"A1" 1265+60 TO 1268+42	NB							252				TYPE III (L)			
	"A1" 1269+93 TO 1273+21	SB							252				TYPE III (L)			
	"A1" 1274+39 TO 1275+58	NB							84				TYPE III (L)			
	"A1" 1276+40 TO 1277+33	SB							84				TYPE III (L)			
	"A1" 1269+94 TO 1275+59		25A		1130							48				
	"A1" 1268+44 TO 1268+62	N/A							570				LADDER CROSSWALK			
	"A1" 1269+73 TO 1269+93	N/A							624				LADDER CROSSWALK			
	"A1" 1268+44 TO 1269+93	N/A					200									
	"A1" 1269+73 TO 1269+93	NB	38					287			12					
PD-22	"A1" 1265+61 TO 1268+48	NB	38					289			12					
	"A1" 1269+90 TO 1273+22	SB	38					332			14					
	"A1" 1269+89 TO 1273+22	SB	38					333			14					
	"A1" 1274+38 TO 1275+58	NB	38					120			5					
	"A1" 1276+38 TO 1277+33	SB	38					94			2					
	"A1" 1268+42 TO 1268+46	N/A							60				LIMIT LINE			
	"A1" 1268+72 TO 1269+68	N/A							190				LADDER CROSSWALK			
	"A1" 1268+73 TO 1269+67	N/A							190				LADDER CROSSWALK			
	"A1" 1269+98 TO 1269+93	N/A							70				LIMIT LINE			
	"A1" 1270+00 TO 1271+00	SB							84				TYPE III (R)			
PD-22 TO PD-23	"A1" 1269+85 TO 1282+05	NB	9			2,441					51					
	"A1" 1269+85 TO 1282+06	SB	9			2,428					51					
	"A1" 1276+36 TO 1282+07		25A		1142							48				
	"A1" 1282+93 TO 1285+57	NB	9			527					11					
	"A1" 1282+86 TO 1285+39	SB	9			506					11					
	"A1" 1286+23 TO 1288+60	NB	9			475					10					
	"A1" 1285+95 TO 1288+53	SB	9			516					11					
	"A1" 1279+93 TO 1281+95	NB							84				TYPE III (L)			
	"A1" 1282+93 TO 1284+26	SB							84				TYPE III (L)			
	"A1" 1286+10 TO 1286+10	SB							42				TYPE III (L)			
PD-23	"A1" 1288+31 TO 1288+31	NB							42				TYPE III (L)			
	"A1" 1289+55 TO 1290+60	SB							84				TYPE III (L)			
	"A1" 1282+94 TO 1285+41		25A		946							24				
	"A1" 1286+16 TO 1288+58		25A		484							24				
	"A1" 1282+05 TO 1282+26	N/A							576				LADDER CROSSWALK			
	"A1" 1282+71 TO 1282+93	N/A							570				LADDER CROSSWALK			
	"A1" 1285+36 TO 1285+71	N/A							598				LADDER CROSSWALK			
	"A1" 1285+82 TO 1286+25	N/A							576				LADDER CROSSWALK			
SHEET TOTAL					4752	11,465	200	1455	5116		300	188				

PAVEMENT DELINEATION QUANTITIES

PDQ-17A

LAST REVISION: DATE PLOTTED => 18-NOV-2024
TIME PLOTTED => 16:11

REVISED BY	DATE REVISED
TG	11-28-22

CALCULATED-DESIGNED BY: QUYNH NGUYEN
CHECKED BY: SON LY
FUNCTIONAL SUPERVISOR: TAM LY

STATE OF CALIFORNIA - DEPARTMENT OF TRANSPORTATION
Caltrans® DESIGN

BORDER LAST REVISED 7/2/2010

USERNAME => s129144
DGN FILE => 0419000140nc017A.cco

RELATIVE BORDER SCALE IS IN INCHES 0 1 2 3

UNIT 0712

PROJECT NUMBER & PHASE 04190001401

CONTRACT CHANGE ORDER NO. 20
SHEET _____ OF _____

20 SHEET DELETED PER CONTRACT CHANGE ORDER No. 20 DATED

REGISTERED PROFESSIONAL ENGINEER — Son Thanh Ly — No. 72584 — Exp. 6-30-26 — CIVIL — STATE OF CALIFORNIA

FOR REVISION ONLY
July 22, 2024
DATE

20

Dist	COUNTY	ROUTE	POST MILES TOTAL PROJECT	SHEET No.	TOTAL SHEETS
04	SCI	82	18.2/26.4	266	466

AS-AWARDED CONTRACT PLANS
THIS STAMP PLACED IN LIEU OF ORIGINAL SIGNATURE
REGISTERED CIVIL ENGINEER DATE
PLANS APPROVAL DATE

REGISTERED PROFESSIONAL ENGINEER — No. _____ — Exp. _____ — CIVIL — STATE OF CALIFORNIA

THE STATE OF CALIFORNIA OR ITS OFFICERS OR AGENTS SHALL NOT BE RESPONSIBLE FOR THE ACCURACY OR COMPLETENESS OF SCANNED COPIES OF THIS PLAN SHEET.

TRAFFIC STRIPES, PAVEMENT MARKINGS AND PAVEMENT MARKERS

SHEET No.	LOCATION/STATION	DIRECTION	DETAIL No.	THERMOPLASTIC TRAFFIC STRIPE (ENHANCED WET NIGHT VISIBILITY)		TRAFFIC STRIPE TAPE (WARRANTY)					THERMOPLASTIC PAVEMENT MARKING (BIKE LANE TREATMENT)	THERMOPLASTIC CROSSWALK AND PAVEMENT MARKING (ENHANCED WET NIGHT VISIBILITY)		PAVEMENT MARKERS (RETRORE-FLECTIVE)		DELINEATOR (CLASS 1)	DESCRIPTION/COMMENTS	REMOVE THERMOPLASTIC TRAFFIC STRIPE	REMOVE THERMOPLASTIC PAVEMENT MARKING	REMOVE MARKER
				6" WHITE	6" YELLOW	6" WHITE				8" WHITE										
				WHITE SOLID	YELLOW SOLID	BROKEN (17-7)	BROKEN (6-1)	SOLID	BROKEN (8-4)	WHITE SOLID	GREEN	WHITE	YELLOW	G	RY			LF	SQFT	EA
				LF							SQFT			EA						
	"A1" 1289+31 TO 1289+53	N/A										560					LADDER CROSSWALK			
	"A1" 1279+29 TO 1282+06	NB	38							214				5						
	"A1" 1282+89 TO 1284+29	SB	38							141				3						
	"A1" 1284+29 TO 1285+49	NB	38							120				3						
	"A1" 1286+06 TO 1287+40	SB	38							134				3						
	"A1" 1288+07 TO 1288+54	NB	38							47				1						
	"A1" 1289+50 TO 1290+60	SB	38							110				3						
	"A1" 1282+05 TO 1282+00	N/A										55					LIMIT LINE			
	"A1" 1282+26 TO 1282+71	N/A										90					LADDER CROSSWALK			
	"A1" 1282+15 TO 1282+82	N/A										130					LADDER CROSSWALK			
PD-23	"A1" 1282+87 TO 1282+93	N/A										55					LIMIT LINE			
	"A1" 1285+42 TO 1285+53	N/A										55					LIMIT LINE			
	"A1" 1285+46 TO 1285+81	N/A										80					LADDER CROSSWALK			
	"A1" 1285+71 TO 1286+14	N/A										80					LADDER CROSSWALK			
	"A1" 1285+98 TO 1286+14	N/A										55					LIMIT LINE			
	"A1" 1288+59 TO 1288+60	N/A										60					LIMIT LINE			
	"A1" 1288+72 TO 1289+10	N/A										80					LADDER CROSSWALK			
	"A1" 1289+52 TO 1289+58	N/A										55					LIMIT LINE			
	"A1" 1292+30											63					XING			
	"A1" 1292+70											54					PED			
PD-23	"A1" 1289+46 TO 1296+04	NB	9			1,317								28						
TO	"A1" 1289+51 TO 1295+82	SB	9			1,261								27						
PD-24	"A1" 1289+48 TO 1295+91		25A		1286										56					
	"A1" 1296+98 TO 1306+91	NB	9			1,986								42						
	"A1" 1296+90 TO 1307+02	SB	9			2,024								43						
	"A1" 1293+94 TO 1295+86	NB										84					TYPE III (L)			
	"A1" 1296+98 TO 1298+42	SB										84					TYPE III (L)			
	"A1" 1305+59 TO 1306+90	NB										84					TYPE III (L)			
PD-24	"A1" 1296+94 TO 1306+95		25A		2002										84					
	"A1" 1306+88 TO 1307+12	N/A										608					LADDER CROSSWALK			
	"A1" 1307+50 TO 1308+02	N/A										662					LADDER CROSSWALK			
	"A1" 1293+93 TO 1295+94	NB	38							200				5						
	"A1" 1296+92 TO 1298+51	SB	38							159				4						
	"A1" 1305+58 TO 1306+93	SB	38							135				3						
PD-25	"A1" 1319+44 TO 1319+45	N/A										100					LIMIT LINE			
	"A1" 1320+26 TO 1320+26	N/A										120					LIMIT LINE			
PD-25	"A1" 1320+34 TO 1329+57	NB	25A		1844										80					
TO PD-26	"A1" 1320+93 TO 1342+75	NB	9			8,728								182						
SHEET TOTAL					5132	15,316				1260		3214		352	220					

PAVEMENT DELINEATION QUANTITIES

PDQ-18

CALCULATED-DESIGNED BY: QUYNH NGUYEN
CHECKED BY: SON LY
FUNCTIONAL SUPERVISOR: TAM LY
REVISED BY: TG
DATE REVISED: 11-28-22

STATE OF CALIFORNIA - DEPARTMENT OF TRANSPORTATION
DESIGN

LAST REVISION | DATE PLOTTED => 18-NOV-2024
12-07-22 | TIME PLOTTED => 16:11

BORDER LAST REVISED 7/2/2010 | USERNAME => s129144 | DGN FILE => 0419000140nc018.cco | RELATIVE BORDER SCALE IS IN INCHES 0 1 2 3 | UNIT 0712 | PROJECT NUMBER & PHASE 04190001401

CONTRACT CHANGE ORDER NO. 20
SHEET _____ OF _____

20 REPLACED PER CONTRACT CHANGE ORDER No. 20 DATED

Son Thanh Ly
No. 72584
Exp. 6-30-26
CIVIL
STATE OF CALIFORNIA
FOR REVISION ONLY
July 22, 2024
DATE

20

Dist	COUNTY	ROUTE	POST MILES TOTAL PROJECT	SHEET No.	TOTAL SHEETS
04	SCI	82	18.2/26.4	266A	466

AS-AWARDED CONTRACT PLANS
THIS STAMP PLACED IN LIEU OF ORIGINAL SIGNATURE
REGISTERED CIVIL ENGINEER DATE
PLANS APPROVAL DATE
REGISTERED PROFESSIONAL ENGINEER No. Exp. CIVIL STATE OF CALIFORNIA
THE STATE OF CALIFORNIA OR ITS OFFICERS OR AGENTS SHALL NOT BE RESPONSIBLE FOR THE ACCURACY OR COMPLETENESS OF SCANNED COPIES OF THIS PLAN SHEET.

TRAFFIC STRIPES, PAVEMENT MARKINGS AND PAVEMENT MARKERS

SHEET No.	LOCATION/STATION	DIRECTION	DETAIL No.	THERMOPLASTIC TRAFFIC STRIPE (ENHANCED WET NIGHT VISIBILITY)		TRAFFIC STRIPE TAPE (WARRANTY)			THERMOPLASTIC CROSSWALK AND PAVEMENT MARKING (ENHANCED WET NIGHT VISIBILITY)		PAVEMENT MARKERS (RETRORE-FLECTIVE)		DESCRIPTION/COMMENTS	REMOVE THERMOPLASTIC TRAFFIC STRIPE	REMOVE THERMOPLASTIC PAVEMENT MARKING	REMOVE MARKER
				6" WHITE	6" YELLOW	6" WHITE		8" WHITE	WHITE	YELLOW	G	RY		LF	SQFT	EA
				WHITE SOLID	YELLOW SOLID	BROKEN (17-7)	BROKEN (6-1)	WHITE SOLID								
				LF					SQFT		EA					
	"A1" 1289+31 TO 1289+53	N/A							560				LADDER CROSSWALK			
	"A1" 1279+29 TO 1282+06	NB	38					214			5					
	"A1" 1282+89 TO 1284+29	SB	38					141			3					
	"A1" 1284+29 TO 1285+49	NB	38					120			3					
	"A1" 1286+06 TO 1287+40	SB	38					134			3					
	"A1" 1288+07 TO 1288+54	NB	38					47			1					
	"A1" 1289+50 TO 1290+60	SB	38					110			3					
	"A1" 1282+05 TO 1282+00	N/A							55				LIMIT LINE			
	"A1" 1282+26 TO 1282+71	N/A							90				LADDER CROSSWALK			
	"A1" 1282+15 TO 1282+82	N/A							130				LADDER CROSSWALK			
PD-23	"A1" 1282+87 TO 1282+93	N/A							55				LIMIT LINE			
	"A1" 1285+42 TO 1285+53	N/A							55				LIMIT LINE			
	"A1" 1285+46 TO 1285+81	N/A							80				LADDER CROSSWALK			
	"A1" 1285+71 TO 1286+14	N/A							80				LADDER CROSSWALK			
	"A1" 1285+98 TO 1286+14	N/A							55				LIMIT LINE			
	"A1" 1288+59 TO 1288+60	N/A							60				LIMIT LINE			
	"A1" 1288+72 TO 1289+10	N/A							80				LADDER CROSSWALK			
	"A1" 1289+52 TO 1289+58	N/A							55				LIMIT LINE			
	"A1" 1292+30								63				XING			
	"A1" 1292+70								54				PED			
PD-23	"A1" 1289+46 TO 1296+04	NB	9			1,317					28					
TO	"A1" 1289+51 TO 1295+82	SB	9			1,261					27					
PD-24	"A1" 1289+48 TO 1295+91		25A		1286							56				
	"A1" 1296+98 TO 1306+91	NB	9			1,986					42					
	"A1" 1296+90 TO 1307+02	SB	9			2,024					43					
	"A1" 1293+94 TO 1295+86	NB							84				TYPE III (L)			
	"A1" 1296+98 TO 1298+42	SB							84				TYPE III (L)			
	"A1" 1305+59 TO 1306+90	NB							84				TYPE III (L)			
PD-24	"A1" 1296+94 TO 1306+95		25A		2002							84				
	"A1" 1306+88 TO 1307+12	N/A							608				LADDER CROSSWALK			
	"A1" 1307+50 TO 1308+02	N/A							662				LADDER CROSSWALK			
	"A1" 1293+93 TO 1295+94	NB	38					200			5					
	"A1" 1296+92 TO 1298+51	SB	38					159			4					
	"A1" 1305+58 TO 1306+93	SB	38					135			3					
PD-25	"A1" 1319+44 TO 1319+45	N/A							100				LIMIT LINE			
	"A1" 1320+26 TO 1320+26	N/A							120				LIMIT LINE			
PD-25	"A1" 1320+34 TO 1329+57	NB	25A		1844							80				
TO PD-26	"A1" 1320+93 TO 1342+75	NB	9			8,728					182					
	SHEET TOTAL				5132	15,316		1260	3214		352	220				

PAVEMENT DELINEATION QUANTITIES

PDQ-18A

STATE OF CALIFORNIA - DEPARTMENT OF TRANSPORTATION
Caltrans DESIGN
FUNCTIONAL SUPERVISOR: TAM LY
CALCULATED-DESIGNED BY: QUYNH NGUYEN
CHECKED BY: SON LY
REVISED BY: TG
DATE REVISED: 11-28-22
LAST REVISION: DATE PLOTTED => 18-NOV-2024
TIME PLOTTED => 16:11
12-07-22

BORDER LAST REVISED 7/2/2010
USERNAME => s129144
DGN FILE => 0419000140nc018A.cco
RELATIVE BORDER SCALE IS IN INCHES 0 1 2 3
UNIT 0712
PROJECT NUMBER & PHASE 04190001401

CONTRACT CHANGE ORDER NO. 20
SHEET ____ OF ____

20 **SHEET DELETED PER CONTRACT CHANGE ORDER No. 20 DATED**

Son Thanh Ly
No. 72584
Exp. 6-30-26
CIVIL
STATE OF CALIFORNIA
REGISTERED PROFESSIONAL ENGINEER

FOR REVISION ONLY
July 22, 2024
DATE

20

Dist	COUNTY	ROUTE	POST MILES TOTAL PROJECT	SHEET No.	TOTAL SHEETS
04	SCI	82	18.2/26.4	267	466

AS-AWARDED CONTRACT PLANS
THIS STAMP PLACED IN LIEU OF ORIGINAL SIGNATURE
REGISTERED CIVIL ENGINEER DATE
PLANS APPROVAL DATE

REGISTERED PROFESSIONAL ENGINEER No. Exp. CIVIL STATE OF CALIFORNIA

THE STATE OF CALIFORNIA OR ITS OFFICERS OR AGENTS SHALL NOT BE RESPONSIBLE FOR THE ACCURACY OR COMPLETENESS OF SCANNED COPIES OF THIS PLAN SHEET.

TRAFFIC STRIPES, PAVEMENT MARKINGS AND PAVEMENT MARKERS

SHEET No.	LOCATION/STATION	DIRECTION	DETAIL No.	THERMOPLASTIC TRAFFIC STRIPE (ENHANCED WET NIGHT VISIBILITY)		TRAFFIC STRIPE TAPE (WARRANTY)					THERMOPLASTIC PAVEMENT MARKING (BIKE LANE TREATMENT)	THERMOPLASTIC CROSSWALK AND PAVEMENT MARKING (ENHANCED WET NIGHT VISIBILITY)		PAVEMENT MARKERS (RETRO-REFLECTIVE)		DELINEATOR (CLASS 1)	DESCRIPTION/COMMENTS	REMOVE THERMOPLASTIC TRAFFIC STRIPE	REMOVE THERMOPLASTIC PAVEMENT MARKING	REMOVE MARKER
				6" WHITE	6" YELLOW	6" WHITE				8" WHITE										
				WHITE SOLID	YELLOW SOLID	BROKEN (17-7)	BROKEN (6-1)	SOLID	BROKEN (8-4)	WHITE SOLID	GREEN	WHITE	YELLOW	G	RY			LF	SQFT	EA
				LF							SQFT			EA						
PD-25	"A1" 1320+28 TO 1343+04	SB	9			9,102								190						
TO PD-26	"A1" 1330+19 TO 1342+95	NB	25A		2552										108					
	"A1" 1339+07 TO 1342+88	NB										126					TYPE III (L)			
	"A1" 1343+94 TO 1346+91	SB										126					TYPE III (L)			
	"A1" 1347+85 TO 1349+42	SB										84					TYPE III (L)			
	"A1" 1343+88 TO 1347+15	NB	25A		327										14					
	"A1" 1342+69 TO 1343+18	N/A										586					LADDER CROSSWALK			
	"A1" 1343+73 TO 1343+96	N/A										570					LADDER CROSSWALK			
	"A1" 1339+04 TO 1342+87	NB	38							383				88						
PD-27	"A1" 1343+91 TO 1346+94	SB	38							303				77						
	"A1" 1347+27 TO 1349+43	SB	38							216				55						
	"A1" 1342+62 TO 1342+87	N/A										60					LIMIT LINE			
	"A1" 1343+21 TO 1343+85	N/A											130				LADDER CROSSWALK			
	"A1" 1342+99 TO 1343+15	N/A											50				LADDER CROSSWALK			
	"A1" 1342+80 TO 1343+68	N/A											160				LADDER CROSSWALK			
	"A1" 1343+95 TO 1344+01	N/A										55					LIMIT LINE			
	"A1" 1343+91 TO 1344+09	N/A											70				LADDER CROSSWALK			
	"A1" 1343+50		21		100															
	"A1" 1343+30											45					TYPE II (R)			
	"A1" 1343+40											14					TYPE I			
	"A1" 1343+50											27					TYPE VI (L)			
PD-27	"A1" 1343+90 TO 1354+28	NB	9			2,075								44						
TO	"A1" 1343+96 TO 1354+23	SB	9			2,054								43						
PD-28	"A1" 1347+89 TO 1354+23	NB	25A		634										28					
	"A1" 1342+50 TO 1367+50	SB										126					TYPE III (L)			
	"A1" 1342+50 TO 1367+50	SB										42					TYPE III (R)			
	"A1" 1359+00 TO 1367+50	SB										75					TYPE I			
	"A1" 1363+50 TO 1365+76	SB										84					TYPE VI			
	"A1" 1354+00 TO 1356+00	SB										76					NO TURN			
	"A1" 1367+22 TO 1367+22	SB										63					SIGNAL AHEAD			
	"A1" 1364+02 TO 1364+06	SB										50					CHEVRON MARKING			
	"A1" 1343+50 TO 1363+50	SB										42					DIAGONAL MARKING			
	"A1" 1354+90 TO 1365+47	NB	25A		1430										60			795		16
PD-28	"A1" 1354+20 TO 1354+40	N/A										212					LADDER CROSSWALK			
	"A1" 1354+20 TO 1354+40	N/A										212					LADDER CROSSWALK			
	"A1" 1354+40 TO 1355+00	N/A										212					LADDER CROSSWALK			
	"A1" 1354+93 TO 1356+13	SB	38							120				33						
	"A1" 1363+22 TO 1365+38	NB	38							215				55						
	"A1" 1363+23 TO 1365+85	NB	38							262				66						
	"A1" 1354+24	N/A										34					LIMIT LINE			
	"A1" 1354+95	N/A										12								
	"A1" 1354+93	N/A										46					LIMIT LINE			
	"A1" 1360+20 TO 1360+60	NB										40					CHEVRON MARKING			
SHEET TOTAL					5043	13,231				1499		3019	410	345	210			795		16

PAVEMENT DELINEATION QUANTITIES

PDQ-19

CALCULATED-DESIGNED BY
CHECKED BY
REVISED BY: TG — DATE REVISED: 11-28-22
QUYNH NGUYEN
SON LY
FUNCTIONAL SUPERVISOR: TAM LY
STATE OF CALIFORNIA - DEPARTMENT OF TRANSPORTATION
DESIGN

LAST REVISION DATE PLOTTED => 18-NOV-2024
TIME PLOTTED => 16:11
12-07-22

BORDER LAST REVISED 7/2/2010
USERNAME => s129144
DGN FILE => 0419000140nc019.cco
RELATIVE BORDER SCALE IS IN INCHES 0 1 2 3
UNIT 0712
PROJECT NUMBER & PHASE 04190001401

CONTRACT CHANGE ORDER NO. 20
SHEET ____ OF ____

20 REPLACED PER CONTRACT CHANGE ORDER No. 20 DATED

TRAFFIC STRIPES, PAVEMENT MARKINGS AND PAVEMENT MARKERS

SHEET No.	LOCATION/STATION	DIRECTION	DETAIL No.	THERMOPLASTIC TRAFFIC STRIPE (ENHANCED WET NIGHT VISIBILITY)		TRAFFIC STRIPE TAPE (WARRANTY)			THERMOPLASTIC CROSSWALK AND PAVEMENT MARKING (ENHANCED WET NIGHT VISIBILITY)		PAVEMENT MARKERS (RETRO-REFLECTIVE)		DESCRIPTION/COMMENTS	REMOVE THERMOPLASTIC TRAFFIC STRIPE	REMOVE THERMOPLASTIC PAVEMENT MARKING	REMOVE MARKER
				6" WHITE	6" YELLOW	6" WHITE		8" WHITE								
				WHITE SOLID	YELLOW SOLID	BROKEN (17-7)	BROKEN (6-1)	WHITE SOLID	WHITE	YELLOW	G	RY		LF	SQFT	EA
				LF					SQFT		EA					
PD-25	"A1" 1320+28 TO 1343+04	SB	9			9,102					190					
TO PD-26	"A1" 1330+19 TO 1342+95	NB	25A		2552							108				
	"A1" 1339+07 TO 1342+88	NB							126				TYPE III (L)			
	"A1" 1343+94 TO 1346+91	SB							126				TYPE III (L)			
	"A1" 1347+85 TO 1349+42	SB							84				TYPE III (L)			
	"A1" 1343+88 TO 1347+15	NB	25A		327							14				
	"A1" 1342+69 TO 1343+18	N/A							586				LADDER CROSSWALK			
	"A1" 1343+73 TO 1343+96	N/A							570				LADDER CROSSWALK			
	"A1" 1339+04 TO 1342+87	NB	38					383			88					
PD-27	"A1" 1343+91 TO 1346+94	SB	38					303			77					
	"A1" 1347+27 TO 1349+43	SB	38					216			55					
	"A1" 1342+62 TO 1342+87	N/A							60				LIMIT LINE			
	"A1" 1343+21 TO 1343+85	N/A								130			LADDER CROSSWALK			
	"A1" 1342+99 TO 1343+15	N/A								50			LADDER CROSSWALK			
	"A1" 1342+80 TO 1343+68	N/A								160			LADDER CROSSWALK			
	"A1" 1343+95 TO 1344+01	N/A							55				LIMIT LINE			
	"A1" 1343+91 TO 1344+09	N/A								70			LADDER CROSSWALK			
	"A1" 1343+50		21		100											
	"A1" 1343+30								45				TYPE II (R)			
	"A1" 1343+40								14				TYPE I			
	"A1" 1343+50								27				TYPE VI (L)			
PD-27	"A1" 1343+90 TO 1354+28	NB	9			2,075					44					
TO	"A1" 1343+96 TO 1354+23	SB	9			2,054					43					
PD-28	"A1" 1347+89 TO 1354+23	NB	25A		634							28				
	"A1" 1342+50 TO 1367+50	SB							126				TYPE III (L)			
	"A1" 1342+50 TO 1367+50	SB							42				TYPE III (R)			
	"A1" 1359+00 TO 1367+50	SB							75				TYPE I			
	"A1" 1363+50 TO 1365+76	SB							84				TYPE VI			
	"A1" 1354+00 TO 1356+00	SB							76				NO TURN			
	"A1" 1367+22 TO 1367+22	SB							63				SIGNAL AHEAD			
	"A1" 1364+02 TO 1364+06	SB							50				CHEVRON MARKING			
	"A1" 1343+50 TO 1363+50	SB							42				DIAGONAL MARKING			
	"A1" 1354+90 TO 1365+47	NB	25A		1430							60		795		16
PD-28	"A1" 1354+20 TO 1354+40	N/A							212				LADDER CROSSWALK			
	"A1" 1354+20 TO 1354+40	N/A							212				LADDER CROSSWALK			
	"A1" 1354+40 TO 1355+00	N/A							212				LADDER CROSSWALK			
	"A1" 1354+93 TO 1356+13	SB	38					120			33					
	"A1" 1363+22 TO 1365+38	NB	38					215			55					
	"A1" 1363+23 TO 1365+85	NB	38					262			66					
	"A1" 1354+24	N/A							34				LIMIT LINE			
	"A1" 1354+95	N/A							12							
	"A1" 1354+93	N/A							46				LIMIT LINE			
	"A1" 1360+20 TO 1360+60	NB							40				CHEVRON MARKING			
SHEET TOTAL					5043	13,231		1499	3019	410	345	210		795		16

Son Thanh Ly
No. 72584
Exp. 6-30-26
CIVIL
REGISTERED PROFESSIONAL ENGINEER
STATE OF CALIFORNIA

20

FOR REVISION ONLY
July 22, 2024
DATE

Dist	COUNTY	ROUTE	POST MILES TOTAL PROJECT	SHEET No.	TOTAL SHEETS
04	SCI	82	18.2/26.4	267A	466

AS-AWARDED CONTRACT PLANS
THIS STAMP PLACED IN LIEU OF ORIGINAL SIGNATURE
REGISTERED CIVIL ENGINEER DATE
PLANS APPROVAL DATE

REGISTERED PROFESSIONAL ENGINEER
No. ____
Exp. ____
CIVIL
STATE OF CALIFORNIA

THE STATE OF CALIFORNIA OR ITS OFFICERS OR AGENTS SHALL NOT BE RESPONSIBLE FOR THE ACCURACY OR COMPLETENESS OF SCANNED COPIES OF THIS PLAN SHEET.

REVISED BY: TG — DATE REVISED: 11-28-22
CALCULATED-DESIGNED BY: QUYNH NGUYEN
CHECKED BY: SON LY
FUNCTIONAL SUPERVISOR: TAM LY

STATE OF CALIFORNIA - DEPARTMENT OF TRANSPORTATION
Caltrans® DESIGN

PAVEMENT DELINEATION QUANTITIES

PDQ-19A

LAST REVISION DATE PLOTTED => 18-NOV-2024
12-07-22 TIME PLOTTED => 16:11

BORDER LAST REVISED 7/2/2010
USERNAME => s129144
DGN FILE => 0419000140nc019A.cco
RELATIVE BORDER SCALE IS IN INCHES 0 1 2 3
UNIT 0712
PROJECT NUMBER & PHASE 04190001401

CONTRACT CHANGE ORDER NO. 20
SHEET _____ OF _____

20 **SHEET DELETED PER CONTRACT CHANGE ORDER No. 20 DATED**

TRAFFIC STRIPES, PAVEMENT MARKINGS AND PAVEMENT MARKERS

SHEET No.	LOCATION/STATION	DIRECTION	DETAIL No.	THERMOPLASTIC TRAFFIC STRIPE (ENHANCED WET NIGHT VISIBILITY)		TRAFFIC STRIPE TAPE (WARRANTY)					THERMOPLASTIC PAVEMENT MARKING (BIKE LANE TREATMENT)	THERMOPLASTIC CROSSWALK AND PAVEMENT MARKING (ENHANCED WET NIGHT VISIBILITY)		PAVEMENT MARKERS (RETRORE-FLECTIVE)		DELINEATOR (CLASS 1)	DESCRIPTION/COMMENTS	REMOVE THERMOPLASTIC TRAFFIC STRIPE	REMOVE THERMOPLASTIC PAVEMENT MARKING	REMOVE MARKER
				6" WHITE	6" YELLOW	6" WHITE				8" WHITE										
				WHITE SOLID	YELLOW SOLID	BROKEN (17-7)	BROKEN (6-1)	SOLID	BROKEN (8-4)	WHITE SOLID	GREEN	WHITE	YELLOW	G	RY			LF	SQFT	EA
				LF							SQFT			EA						
	"A1" 1353+55 TO 1354+20	SB	27B	65																
PD-28	"A1" 1356+00 TO 1362+00	NB										130					LEFT TURN ONLY			
	"A1" 1360+00 TO 1362+00	NB										75					TYPE I ARROW			
	"A1" 1360+00 TO 1362+00	NB										135					TYPE II (L)			
	"A1" 1360+00 TO 1362+00	NB										252					TYPE III (R)			
	"A1" 1352+50 TO 1367+50	NB	9			3,026								63				1592		33
	"A1" 1352+50 TO 1367+50	SB	9			3,176								66				1592		33
	"A1" 1352+50 TO 1367+50	SB	25A		1780										38			795		17
	"A1" 1359+55 TO 165+00	SB											310				DIAGONAL PAVEMENT			
	"A1" 1349+93 TO 1367+50	SB	38							300										
	"A1" 1360+20 TO 1367+50	NB	38							790										
	"A1" 1361+20 TO 1367+36	NB	36							233										
	"A1" 1378+90											42					TYPE III (R)			
	"A1" 1367+50 TO 1381+50	SB	25A		1520										33			490		10
	"A1" 1367+50 TO 1381+50	NB	9	558		3,845								81				982		20
	"A1" 1367+50 TO 1381+50	SB	9			3,839								80				982		20
	"A1" 1367+50 TO 1381+50	NB	25A		1520										33			490		10
	"A1" 1370+64 TO 1373+75	SB										84					TYPE VI ARROW			
	"A1" 1371+65 TO 1374+04	NB										252					TYPE III (L)			
	"A1" 1374+58 TO 1374+58	NB															NO			
	"A1" 1374+88 TO 1374+88	NB															TURN			
	"A1" 1371+45 TO 1371+45	SB										75					TYPE I ARROW			
PD-29	"A1" 1375+39 TO 1375+50	N/A										614					LADDER CROSSWALK			
	"A1" 1370+17 TO 1374+11	SB	38							394				9						
	"A1" 1371+61 TO 1374+11	NB	38							249				6						
	"A1" 1374+11 TO 1375+55	N/A										95					LIMIT LINE			
	"A1" 1374+38 TO 1375+33	N/A										180					LADDER CROSSWALK			
	"A1" 1374+00 TO 1375+50		40				200													
	"A1" 1374+00 TO 1375+50		39A						200											
	"A1" 1375+54 TO 1388+72	NB	9			2,630								55						
	"A1" 1375+54 TO 1388+54	SB	9			2,600								55						
PD-29 TO PD-30	"A1" 1380+54 TO 1381+79	NB										84					TYPE III (L)			
	"A1" 1347+89 TO 1354+23	NB	25		642										14					
	"A1" 1354+93 TO 1356+13	SB	38							130				3						
SHEET TOTAL				623	5462	19,116	200		200	2096		2018	310	418	118			6923		143

FOR REVISION ONLY
July 22, 2024
DATE

Dist	COUNTY	ROUTE	POST MILES TOTAL PROJECT	SHEET No.	TOTAL SHEETS
04	SCI	82	18.2/26.4	268	466

AS-AWARDED CONTRACT PLANS
THIS STAMP PLACED IN LIEU OF ORIGINAL SIGNATURE
REGISTERED CIVIL ENGINEER DATE
PLANS APPROVAL DATE

THE STATE OF CALIFORNIA OR ITS OFFICERS OR AGENTS SHALL NOT BE RESPONSIBLE FOR THE ACCURACY OR COMPLETENESS OF SCANNED COPIES OF THIS PLAN SHEET.

PAVEMENT DELINEATION QUANTITIES

PDQ-20

REVISED BY: TG — DATE REVISED: 11-28-22
CALCULATED-DESIGNED BY: QUYNH NGUYEN
CHECKED BY: SON LY
FUNCTIONAL SUPERVISOR: TAM LY
STATE OF CALIFORNIA - DEPARTMENT OF TRANSPORTATION
DESIGN
Caltrans

LAST REVISION: DATE PLOTTED => 18-NOV-2024 TIME PLOTTED => 16:12
12-07-22

BORDER LAST REVISED 7/2/2010
USERNAME => s129144
DGN FILE => 0419000140nc020.cco
RELATIVE BORDER SCALE IS IN INCHES 0 1 2 3
UNIT 0712
PROJECT NUMBER & PHASE 04190001401

CONTRACT CHANGE ORDER NO. 20
SHEET _____ OF _____

20 REPLACED PER CONTRACT CHANGE ORDER No. 20 DATED

TRAFFIC STRIPES, PAVEMENT MARKINGS AND PAVEMENT MARKERS

SHEET No.	LOCATION/STATION	DIRECTION	DETAIL No.	THERMOPLASTIC TRAFFIC STRIPE (ENHANCED WET NIGHT VISIBILITY)		TRAFFIC STRIPE TAPE (WARRANTY)			THERMOPLASTIC CROSSWALK AND PAVEMENT MARKING (ENHANCED WET NIGHT VISIBILITY)		PAVEMENT MARKERS (RETROREFLECTIVE)		DESCRIPTION/COMMENTS	REMOVE THERMOPLASTIC TRAFFIC STRIPE	REMOVE THERMOPLASTIC PAVEMENT MARKING	REMOVE MARKER
				6" WHITE	6" YELLOW	6" WHITE		8" WHITE	WHITE	YELLOW	G	RY				
				WHITE SOLID	YELLOW SOLID	BROKEN (17-7)	BROKEN (6-1)	WHITE SOLID	WHITE	YELLOW	G	RY				
				LF					SQFT		EA			LF	SQFT	EA
PD-28	"A1" 1353+55 TO 1354+20	SB	27B	65												
	"A1" 1356+00 TO 1362+00	NB							130				LEFT TURN ONLY			
	"A1" 1360+00 TO 1362+00	NB							75				TYPE I ARROW			
	"A1" 1360+00 TO 1362+00	NB							135				TYPE II (L)			
	"A1" 1360+00 TO 1362+00	NB							252				TYPE III (R)			
	"A1" 1352+50 TO 1367+50	NB	9			3,026					63			1592		33
	"A1" 1352+50 TO 1367+50	SB	9			3,176					66			1592		33
	"A1" 1352+50 TO 1367+50	SB	25A		1780							38		795		17
	"A1" 1359+55 TO 165+00	SB								310			DIAGONAL PAVEMENT			
	"A1" 1349+93 TO 1367+50	SB	38					300								
	"A1" 1360+20 TO 1367+50	NB	38					790								
	"A1" 1361+20 TO 1367+36	NB	36					233								
PD-29	"A1" 1378+90								42				TYPE III (R)			
	"A1" 1367+50 TO 1381+50	SB	25A		1520							33		490		10
	"A1" 1367+50 TO 1381+50	NB	9	558		3,845					81			982		20
	"A1" 1367+50 TO 1381+50	SB	9			3,839					80			982		20
	"A1" 1367+50 TO 1381+50	NB	25A		1520							33		490		10
	"A1" 1370+64 TO 1373+75	SB							84				TYPE VI ARROW			
	"A1" 1371+65 TO 1374+04	NB							252				TYPE III (L)			
	"A1" 1374+58 TO 1374+58	NB											NO			
	"A1" 1374+88 TO 1374+88	NB											TURN			
	"A1" 1371+45 TO 1371+45	SB							75				TYPE I ARROW			
	"A1" 1375+39 TO 1375+50	N/A							614				LADDER CROSSWALK			
	"A1" 1370+17 TO 1374+11	SB	38					394			9					
	"A1" 1371+61 TO 1374+11	NB	38					249			6					
	"A1" 1374+11 TO 1375+55	N/A							95				LIMIT LINE			
	"A1" 1374+38 TO 1375+33	N/A							180				LADDER CROSSWALK			
	"A1" 1374+00 TO 1375+50		40				200									
	"A1" 1374+00 TO 1375+50		39A													
PD-29 TO PD-30	"A1" 1375+54 TO 1388+72	NB	9			2,630					55					
	"A1" 1375+54 TO 1388+54	SB	9			2,600					55					
	"A1" 1380+54 TO 1381+79	NB							84				TYPE III (L)			
	"A1" 1347+89 TO 1354+23	NB	25		642							14				
	"A1" 1354+93 TO 1356+13	SB	38					130			3					
SHEET TOTAL				623	5462	19,116	200	2096	2018	310	418	118		6923		143

Son Thanh Ly
No. 72584
Exp. 6-30-24
CIVIL
STATE OF CALIFORNIA
REGISTERED PROFESSIONAL ENGINEER

20

FOR REVISION ONLY
July 22, 2024
DATE

Dist	COUNTY	ROUTE	POST MILES TOTAL PROJECT	SHEET No.	TOTAL SHEETS
04	SCI	82	18.2/26.4	268A	466

AS-AWARDED CONTRACT PLANS
THIS STAMP PLACED IN LIEU OF ORIGINAL SIGNATURE
REGISTERED CIVIL ENGINEER DATE
PLANS APPROVAL DATE

REGISTERED PROFESSIONAL ENGINEER
No. _____
Exp. _____
CIVIL
STATE OF CALIFORNIA

THE STATE OF CALIFORNIA OR ITS OFFICERS OR AGENTS SHALL NOT BE RESPONSIBLE FOR THE ACCURACY OR COMPLETENESS OF SCANNED COPIES OF THIS PLAN SHEET.

CALCULATED-DESIGNED BY: QUYNH NGUYEN
CHECKED BY: SON LY
REVISED BY: TG
DATE REVISED: 11-28-22
FUNCTIONAL SUPERVISOR: TAM LY

STATE OF CALIFORNIA - DEPARTMENT OF TRANSPORTATION
DESIGN

PAVEMENT DELINEATION QUANTITIES

PDQ-20A

LAST REVISION | DATE PLOTTED => 18-NOV-2024
12-07-22 | TIME PLOTTED => 16:12

BORDER LAST REVISED 7/2/2010
USERNAME => s129144
DGN FILE => 0419000140nc020A.cco
RELATIVE BORDER SCALE IS IN INCHES 0 1 2 3
UNIT 0712
PROJECT NUMBER & PHASE 04190001401

CONTRACT CHANGE ORDER NO. 20
SHEET ____ OF ____

20 SHEET DELETED PER CONTRACT CHANGE ORDER No. 20 DATED

REGISTERED PROFESSIONAL ENGINEER
Son Thanh Ly
No. 72584
Exp. 6-30-26
CIVIL
STATE OF CALIFORNIA

20

FOR REVISION ONLY
July 22, 2024
DATE

Dist	COUNTY	ROUTE	POST MILES TOTAL PROJECT	SHEET No.	TOTAL SHEETS
04	SCI	82	18.2/26.4	269	466

AS-AWARDED CONTRACT PLANS
THIS STAMP PLACED IN LIEU OF ORIGINAL SIGNATURE
REGISTERED CIVIL ENGINEER DATE
PLANS APPROVAL DATE

REGISTERED PROFESSIONAL ENGINEER
No. ____
Exp. ____
CIVIL
STATE OF CALIFORNIA

THE STATE OF CALIFORNIA OR ITS OFFICERS OR AGENTS SHALL NOT BE RESPONSIBLE FOR THE ACCURACY OR COMPLETENESS OF SCANNED COPIES OF THIS PLAN SHEET.

TRAFFIC STRIPES, PAVEMENT MARKINGS AND PAVEMENT MARKERS

SHEET No.	LOCATION/STATION	DIRECTION	DETAIL No.	THERMOPLASTIC TRAFFIC STRIPE (ENHANCED WET NIGHT VISIBILITY)		TRAFFIC STRIPE TAPE (WARRANTY)					THERMOPLASTIC PAVEMENT MARKING (BIKE LANE TREATMENT)	THERMOPLASTIC CROSSWALK AND PAVEMENT MARKING (ENHANCED WET NIGHT VISIBILITY)		PAVEMENT MARKERS (RETRO-REFLECTIVE)		DELINEATOR (CLASS 1)	DESCRIPTION/COMMENTS	REMOVE THERMOPLASTIC TRAFFIC STRIPE	REMOVE THERMOPLASTIC PAVEMENT MARKING	REMOVE MARKER
				6" WHITE	6" YELLOW	6" WHITE				8" WHITE										
				WHITE SOLID	YELLOW SOLID	BROKEN (17-7)	BROKEN (6-1)	SOLID	BROKEN (8-4)	WHITE SOLID	GREEN	WHITE	YELLOW	G	RY			LF	SQFT	EA
				LF								SQFT		EA						
	"A1" 1390+04 TO 1393+54	NB/SB	9			1398								30			2 TRAFFIC STRIPE			
	"A1" 1384+07 TO 1385+51	NB										84					TYPE III (L)			
	"A1" 1386+92 TO 1388+52	NB										84					TYPE III (L)			
	"A1" 1387+59 TO 1387+59	NB										42					TYPE III (R)			
	"A1" 1390+15 TO 1391+42	SB										84					TYPE III (R)			
	"A1" 1390+64 TO 1392+79	SB										84					TYPE III (L)			
	"A1" 1381+84 TO 1385+49	NB/SB	25A		365										8					
	"A1" 1385+40 TO 1388+61	NB/SB	25A		642										13					
PD-30	"A1" 1390+58 TO 1393+15	NB/SB	25A		506										10					
	"A1" 1388+52 TO 1388+72	N/A										570					LADDER CROSSWALK			
	"A1" 1389+93 TO 1390+04	N/A										570					LADDER CROSSWALK			
	"A1" 1384+04 TO 1385+39	NB	38							270				12			2 TRAFFIC STRIPE			
	"A1" 1386+90 TO 1388+61	NB	38							342				15			2 TRAFFIC STRIPE			
	"A1" 1390+58 TO 1393+13	SB	38							508				22			2 TRAFFIC STRIPE			
	"A1" 1388+57 TO 1388+61	N/A										110					LIMIT LINE			
	"A1" 1390+09 TO 1390+09	N/A										90					LIMIT LINE			
	"A1" 1390+58 TO 1390+58	N/A										32					LIMIT LINE			
	"A1" 1388+58 TO 1390+00	NB	27B	140																
	"A1" 1389+00 TO 1390+00		40				140													
SHEET TOTAL				140	1513	1398	140			1120		1750		79	31					

QUYNH NGUYEN | CALCULATED-DESIGNED BY
SON LY | CHECKED BY
TG | REVISED BY
11-28-22 | DATE REVISED
FUNCTIONAL SUPERVISOR
TAM LY

STATE OF CALIFORNIA - DEPARTMENT OF TRANSPORTATION
Caltrans
DESIGN

PAVEMENT DELINEATION QUANTITIES

PDQ-21

LAST REVISION | DATE PLOTTED => 18-NOV-2024
12-07-22 | TIME PLOTTED => 16:12

BORDER LAST REVISED 7/2/2010
USERNAME => s129144
DGN FILE => 0419000140nc021.cco
RELATIVE BORDER SCALE IS IN INCHES 0 1 2 3
UNIT 0712
PROJECT NUMBER & PHASE 04190001401

CONTRACT CHANGE ORDER NO. 20
SHEET _____ OF _____

20 REPLACED PER CONTRACT CHANGE ORDER No. 20 DATED

Son Thanh Ly
No. 72584
Exp. 6-30-26
CIVIL
REGISTERED PROFESSIONAL ENGINEER
STATE OF CALIFORNIA

FOR REVISION ONLY
July 22, 2024
DATE

20

Dist	COUNTY	ROUTE	POST MILES TOTAL PROJECT	SHEET No.	TOTAL SHEETS
04	SCI	82	18.2/26.4	269A	466

AS-AWARDED CONTRACT PLANS
THIS STAMP PLACED IN LIEU OF ORIGINAL SIGNATURE

REGISTERED CIVIL ENGINEER DATE

PLANS APPROVAL DATE

REGISTERED PROFESSIONAL ENGINEER
No. _____
Exp. _____
CIVIL
STATE OF CALIFORNIA

THE STATE OF CALIFORNIA OR ITS OFFICERS OR AGENTS SHALL NOT BE RESPONSIBLE FOR THE ACCURACY OR COMPLETENESS OF SCANNED COPIES OF THIS PLAN SHEET.

TRAFFIC STRIPES, PAVEMENT MARKINGS AND PAVEMENT MARKERS

SHEET No.	LOCATION/STATION	DIRECTION	DETAIL No.	THERMOPLASTIC TRAFFIC STRIPE (ENHANCED WET NIGHT VISIBILITY)		TRAFFIC STRIPE TAPE (WARRANTY)			THERMOPLASTIC CROSSWALK AND PAVEMENT MARKING (ENHANCED WET NIGHT VISIBILITY)		PAVEMENT MARKERS (RETRORE-FLECTIVE)		DESCRIPTION/COMMENTS	REMOVE THERMOPLASTIC TRAFFIC STRIPE	REMOVE THERMOPLASTIC PAVEMENT MARKING	REMOVE MARKER
				6" WHITE	6" YELLOW	6" WHITE		8" WHITE								
				WHITE SOLID	YELLOW SOLID	BROKEN (17-7)	BROKEN (6-1)	WHITE SOLID	WHITE	YELLOW	G	RY				
				LF					SQFT		EA			LF	SQFT	EA
	"A1" 1390+04 TO 1393+54	NB/SB	9			1398					30		2 TRAFFIC STRIPE			
	"A1" 1384+07 TO 1385+51	NB							84				TYPE III (L)			
	"A1" 1386+92 TO 1388+52	NB							84				TYPE III (L)			
	"A1" 1387+59 TO 1387+59	NB							42				TYPE III (R)			
	"A1" 1390+15 TO 1391+42	SB							84				TYPE III (R)			
	"A1" 1390+64 TO 1392+79	SB							84				TYPE III (L)			
	"A1" 1381+84 TO 1385+49	NB/SB	25A		365							8				
	"A1" 1385+40 TO 1388+61	NB/SB	25A		642							13				
PD-30	"A1" 1390+58 TO 1393+15	NB/SB	25A		506							10				
	"A1" 1388+52 TO 1388+72	N/A							570				LADDER CROSSWALK			
	"A1" 1389+93 TO 1390+04	N/A							570				LADDER CROSSWALK			
	"A1" 1384+04 TO 1385+39	NB	38					270			12		2 TRAFFIC STRIPE			
	"A1" 1386+90 TO 1388+61	NB	38					342			15		2 TRAFFIC STRIPE			
	"A1" 1390+58 TO 1393+13	SB	38					508			22		2 TRAFFIC STRIPE			
	"A1" 1388+57 TO 1388+61	N/A							110				LIMIT LINE			
	"A1" 1390+09 TO 1390+09	N/A							90				LIMIT LINE			
	"A1" 1390+58 TO 1390+58	N/A							32				LIMIT LINE			
	"A1" 1388+58 TO 1390+00	NB	27B	140												
	"A1" 1389+00 TO 1390+00		40				140									
SHEET TOTAL				140	1513	1398	140	1120	1750		79	31				

CALCULATED-DESIGNED BY: QUYNH NGUYEN
CHECKED BY: SON LY
REVISED BY: TG
DATE REVISED: 11-28-22
FUNCTIONAL SUPERVISOR: TAM LY

STATE OF CALIFORNIA - DEPARTMENT OF TRANSPORTATION
DESIGN

PAVEMENT DELINEATION QUANTITIES

PDQ-21A

LAST REVISION | DATE PLOTTED => 18-NOV-2024
12-07-22 | TIME PLOTTED => 16:12

BORDER LAST REVISED 7/2/2010

USERNAME => s129144
DGN FILE => 0419000140nc021A.cco

RELATIVE BORDER SCALE IS IN INCHES 0 1 2 3

UNIT 0712

PROJECT NUMBER & PHASE 04190001401

TRAFFIC STRIPES, PAVEMENT MARKINGS AND PAVEMENT MARKERS

SHEET No.	LOCATION/STATION	DIRECTION	DETAIL No.	THERMOPLASTIC TRAFFIC STRIPE (ENHANCED WET NIGHT VISIBILITY)	TRAFFIC STRIPE TAPE	PAVEMENT MARKERS (RETRORE-FLECTIVE)
				12" WHITE	8" WHITE BROKEN (12-3)	G
				LF		EA
PD-3	"A1" 987+15 TO 987+30	SB	36	15		
	"A1" 988+80 TO 989+00	SB	36	20		
PD-3 TO PD-4	"A1" 989+00 TO 990+69	SB	36	170		
PD-4	"A1" 992+42 TO 992+59	NB	36	16		
	"A1" 998+30 TO 999+16	NB	36	85		
PD-28	"A1" 1360+20 TO 1361+36	NB	36	233		
PD-29	"A1" 137+24 TO 1371+68	SB	36	85		
PD-28 TO PD-29	"A1" 1355+00 TO 1370+16	NB	37B		1530	45
SHEET TOTAL				624	1530	45

Son Thanh Ly
No. 72584
Exp. 6-30-26
CIVIL
REGISTERED PROFESSIONAL ENGINEER
STATE OF CALIFORNIA

FOR REVISION ONLY
July 22, 2024
DATE

Dist	COUNTY	ROUTE	POST MILES TOTAL PROJECT	SHEET No.	TOTAL SHEETS
04	SCI	82	18.2/26.4	270	466

AS-AWARDED CONTRACT PLANS
THIS STAMP PLACED IN LIEU OF ORIGINAL SIGNATURE

REGISTERED CIVIL ENGINEER DATE

PLANS APPROVAL DATE

REGISTERED PROFESSIONAL ENGINEER
No. Exp. CIVIL
STATE OF CALIFORNIA

THE STATE OF CALIFORNIA OR ITS OFFICERS OR AGENTS SHALL NOT BE RESPONSIBLE FOR THE ACCURACY OR COMPLETENESS OF SCANNED COPIES OF THIS PLAN SHEET.

CONTRACT CHANGE ORDER NO. 20
SHEET _____ OF _____

TRAFFIC STRIPES, PAVEMENT MARKINGS AND PAVEMENT MARKERS

SHEET No.	STATION LIMITS 20	PAINT CURB (2-COAT) YELLOW ~~WHITE~~	PAINT CURB (2-COAT) RED	OBJECT MARKER (TYPE K-1)	THERMOPLASTIC CROSSWALK AND PAVEMENT MARKING (ENHANCED WET NIGHT VISIBILITY)	DESCRIPTION/COMMENTS
		SQFT		EA	SQFT	
PD-2	980+30	1		1	4	2 BIKE LOOP DETECTOR SYMBOLS
	981+50	1		1		
PD-4	1011+00	1		1	6	3 BIKE LOOP DETECTOR SYMBOLS
	1012+50	1		1	6	3 BIKE LOOP DETECTOR SYMBOLS
PD-5	1027+10	1		1	4	2 BIKE LOOP DETECTOR SYMBOLS
	1028+25	1		1	4	2 BIKE LOOP DETECTOR SYMBOLS
PD-7	1048+50	1		1	4	2 BIKE LOOP DETECTOR SYMBOLS
	1049+50	1		1	4	2 BIKE LOOP DETECTOR SYMBOLS
	1063+15	1		1	2	1 BIKE LOOP DETECTOR SYMBOLS
PD-8	1064+30	1		1	6	3 BIKE LOOP DETECTOR SYMBOLS
PD-9	1088+50	1		1	6	3 BIKE LOOP DETECTOR SYMBOLS
	1089+50	1		1	2	1 BIKE LOOP DETECTOR SYMBOLS
PD-10	1094+05	1		1	4	2 BIKE LOOP DETECTOR SYMBOLS
	1095+15	1		1	4	2 BIKE LOOP DETECTOR SYMBOLS
	1100+20	1		1	4	2 BIKE LOOP DETECTOR SYMBOLS
	1101+35	1		1	4	2 BIKE LOOP DETECTOR SYMBOLS
PD-11	1112+95	1		1	4	2 BIKE LOOP DETECTOR SYMBOLS
	1113+95	1		1	6	3 BIKE LOOP DETECTOR SYMBOLS
	1117+25	2		1	2	1 BIKE LOOP DETECTOR SYMBOLS
	1118+15	2		1	4	2 BIKE LOOP DETECTOR SYMBOLS
PD-12	1122+85	1		1		
	1123+05	1		1		
	1127+60	1		1	4	2 BIKE LOOP DETECTOR SYMBOLS
	1128+45	1		1	4	2 BIKE LOOP DETECTOR SYMBOLS
	1133+75	1		1	4	2 BIKE LOOP DETECTOR SYMBOLS
PD-13	1134+75	1		1	2	1 BIKE LOOP DETECTOR SYMBOLS
	1139+55	1		1	4	2 BIKE LOOP DETECTOR SYMBOLS
	1140+60	1		1	4	2 BIKE LOOP DETECTOR SYMBOLS
PD-14	1152+00	1		1	6	3 BIKE LOOP DETECTOR SYMBOLS
	1153+40	1		1	6	3 BIKE LOOP DETECTOR SYMBOLS
PD-15	1165+20	1		1	4	2 BIKE LOOP DETECTOR SYMBOLS
	1166+40	1		1	4	2 BIKE LOOP DETECTOR SYMBOLS
	1170+45	1		1	2	1 BIKE LOOP DETECTOR SYMBOLS
	1171+35	1		1	2	1 BIKE LOOP DETECTOR SYMBOLS
PD-16	1177+30	1		1		
	1180+31	1		1	2	1 BIKE LOOP DETECTOR SYMBOLS
	1181+20	1		1	2	1 BIKE LOOP DETECTOR SYMBOLS
	1188+50	2		1		
	1189+40	1		1		
PD-17	1196+40	2		1	2	1 BIKE LOOP DETECTOR SYMBOLS
	1197+55	3		1	2	1 BIKE LOOP DETECTOR SYMBOLS
	1203+15	1		1	2	1 BIKE LOOP DETECTOR SYMBOLS
	1204+25	1		1	2	1 BIKE LOOP DETECTOR SYMBOLS
PD-18	1214+15	1		1		
	1215+15	2		1		
SUBTOTAL A		52		45	138	

TRAFFIC STRIPES, PAVEMENT MARKINGS AND PAVEMENT MARKERS

SHEET No.	STATION LIMITS 20	PAINT CURB (2-COAT) YELLOW ~~WHITE~~	PAINT CURB (2-COAT) RED	OBJECT MARKER (TYPE K-1)	THERMOPLASTIC CROSSWALK AND PAVEMENT MARKING (ENHANCED WET NIGHT VISIBILITY)	DESCRIPTION/COMMENTS
		SQFT		EA	SQFT	
PD-19	1220+25	1		1	2	1 BIKE LOOP DETECTOR SYMBOLS
	1221+30	1		1	2	1 BIKE LOOP DETECTOR SYMBOLS
	1227+22	1		1	2	1 BIKE LOOP DETECTOR SYMBOLS
	1228+10	1		1	2	1 BIKE LOOP DETECTOR SYMBOLS
	1232+65	1		1	2	1 BIKE LOOP DETECTOR SYMBOLS
	1233+20	1		1	2	1 BIKE LOOP DETECTOR SYMBOLS
PD-20	1242+50	1		1	2	1 BIKE LOOP DETECTOR SYMBOLS
	1243+80				2	1 BIKE LOOP DETECTOR SYMBOLS
	1246+10	1		1		
	1246+93	1		1		
PD-21	1254+80	1		1	2	1 BIKE LOOP DETECTOR SYMBOLS
	1257+00				2	1 BIKE LOOP DETECTOR SYMBOLS
	1257+10	1		1		
	1250+79.12 TO 1251+12.12		33			
	1257+89.50 TO 1258+00		10.5			
	1259+25 TO 1259+35		10			
PD-22	1268+45	1		1	4	2 BIKE LOOP DETECTOR SYMBOLS
	1269+95	1		1	4	2 BIKE LOOP DETECTOR SYMBOLS
PD-23	1282+00 TO 1283+00				12	6 BIKE LOOP DETECTOR SYMBOLS
	1282+00	1		1		
	1282+87	1		1		
	1285+50	1		1	2	1 BIKE LOOP DETECTOR SYMBOLS
	1286+20	1		1	2	1 BIKE LOOP DETECTOR SYMBOLS
	1288+55	1		1		
	1289+50	1		1		
	1281+84 TO 1282+04		20			
	1282+93 TO 1283+13		20			
	1290+90 TO 1291+06		16			
PD-24	1296+06	1		1	2	1 BIKE LOOP DETECTOR SYMBOLS
	1296+73	1		1	2	1 BIKE LOOP DETECTOR SYMBOLS
	1306+93	1		1	2	1 BIKE LOOP DETECTOR SYMBOLS
	1307+84	1		1	2	1 BIKE LOOP DETECTOR SYMBOLS
PD-25	1319+45	1		1		
	1320+35	1		1		
PD-27	1342+95	1		1	2	1 BIKE LOOP DETECTOR SYMBOLS
	1343+90	1		1	2	1 BIKE LOOP DETECTOR SYMBOLS
PD-28	1354+30	1		1		
PD-29	1375+50	2		1		
	1374+00				4	2 BIKE LOOP DETECTOR SYMBOLS
PD-30	1388+60	1		1		
SUBTOTAL		31	109.5	30	60	
SUBTOTAL A		52		45	138	
GRAND TOTAL		83	109.5	75	198	
TOTAL		192.5		75	198	

20 **REVISED PER CONTRACT CHANGE ORDER No. 20 DATED**

PAVEMENT DELINEATION QUANTITIES
PDQ-22

CALCULATED-DESIGNED BY	CHECKED BY
QUYNH NGUYEN	SON LY

REVISED BY	DATE REVISED
TG	11-28-22

FUNCTIONAL SUPERVISOR: TAM LY

STATE OF CALIFORNIA - DEPARTMENT OF TRANSPORTATION
Caltrans® DESIGN

LAST REVISION DATE PLOTTED => 19-NOV-2024
TIME PLOTTED => 17:03
12-07-22

BORDER LAST REVISED 7/2/2010

USERNAME => s129144
DGN FILE => 0419000140nc022.cco

RELATIVE BORDER SCALE IS IN INCHES 0 1 2 3

UNIT 0712

PROJECT NUMBER & PHASE 04190001401

CONTRACT CHANGE ORDER NO. 20
SHEET ____ OF ____

20 **SHEET DELETED PER CONTRACT CHANGE ORDER No. 20 DATED**

Son Thanh Ly
No. 72584
Exp. 6-30-26
CIVIL
REGISTERED PROFESSIONAL ENGINEER
STATE OF CALIFORNIA

FOR REVISION ONLY
July 22, 2024
DATE

20

Dist	COUNTY	ROUTE	POST MILES TOTAL PROJECT	SHEET No.	TOTAL SHEETS
04	SCI	82	18.2/26.4	271	466

AS-AWARDED CONTRACT PLANS
THIS STAMP PLACED IN LIEU OF ORIGINAL SIGNATURE
REGISTERED CIVIL ENGINEER DATE
PLANS APPROVAL DATE

THE STATE OF CALIFORNIA OR ITS OFFICERS OR AGENTS SHALL NOT BE RESPONSIBLE FOR THE ACCURACY OR COMPLETENESS OF SCANNED COPIES OF THIS PLAN SHEET.

REGISTERED PROFESSIONAL ENGINEER
No.
Exp.
CIVIL
STATE OF CALIFORNIA

TRAFFIC STRIPES, PAVEMENT MARKINGS AND PAVEMENT MARKERS

	THERMOPLASTIC TRAFFIC STRIPE (ENHANCED WET NIGHT VISIBILITY)	TRAFFIC STRIPE TAPE (WARRANTY)					THERMOPLASTIC PAVEMENT MARKING (BIKE LANE TREATMENT)	THERMOPLASTIC CROSSWALK AND PAVEMENT MARKING (ENHANCED WET NIGHT VISIBILITY)		PAVEMENT MARKERS (RETRORE-FLECTIVE)	DELINEATOR (CLASS 1)	REMOVE THERMOPLASTIC TRAFFIC STRIPE	REMOVE THERMOPLASTIC PAVEMENT MARKING	REMOVE MARKER
	6" WHITE	6" YELLOW	6" WHITE				8" WHITE							
	WHITE SOLID	YELLOW SOLID	BROKEN (17-7)	BROKEN (6-1)	SOLID	BROKEN (8-4)	WHITE SOLID	GREEN	WHITE	YELLOW				
	LF							SQFT			EA			
SHEET PDQ-1 TOTAL		1,795	9,768	100	1,415	363	1,527	3,410	3,025		338	71	7,823	777	166
SHEET PDQ-2 TOTAL		5,378	5,600	400	4,980	1280	429	8,173	675		365	251		20	
SHEET PDQ-3 TOTAL		2,840	5,000		2,883	714	457	4,048	10,914		248	145		60	
SHEET PDQ-4 TOTAL		4,155	11,174	100	1,920	1804	743	4,884	3,074		451	55		100	
SHEET PDQ-5 TOTAL	1,279	3,936		100	3,466	1045	540	6,006	10,086		209	237		60	
SHEET PDQ-6 TOTAL		3,570	7,060	200	3,323	448	1,309	2,708	3,987		356	166		60	
SHEET PDQ-7 TOTAL		2,610	5,939		2,377	596	733	2,960	4,011		260	119			
SHEET PDQ-8 TOTAL		1,620	5,461	100	2,964	465	618	1,340	5,089		210	148			
SHEET PDQ-9 TOTAL		1,800	1,904	100	2,626	667	728	4,152	3,920		112	128		20	
SHEET PDQ-10 TOTAL		3,258	4,580	300	1,985	957	1,367	6,539	2,282		246	99			
SHEET PDQ-11 TOTAL		4,234	8,372		2,725	271	926	2,941	2,349		347	132			
SHEET PDQ-12 TOTAL		2,050	4,559		1,315	285	1,153	580	5,554		200	43			
SHEET PDQ-13 TOTAL		4,135	10,614	100			1,156		3,016		441				
SHEET PDQ-14 TOTAL		2,698	6,224				1,335		3,455.5		326				
SHEET PDQ-15 TOTAL		1,836	3,787				645		4,273.5		178				
SHEET PDQ-16 TOTAL		2,526	4,151				569		2,889		225				
SHEET PDQ-17 TOTAL		4,752	11,465	200			1,455		5,116		488				
SHEET PDQ-18 TOTAL		5,132	15,316				1,260		3,214		572				
SHEET PDQ-19 TOTAL		5,043	13,231				1,499		3,019	410	555		795		16
SHEET PDQ-20 TOTAL	623	5,462	19,116	200		200	2,096		2,018	310	536		6,923		143
SHEET PDQ-21 TOTAL	140	1,513	1,398	140			1,120		1,750		110				
SHEET PDQ-22 TOTAL									198		45				
TOTAL	2,042	70,343	154,719	2040	31,979	9095	21,665	47,741	83,915	720	6818	1594	15,541	1097	325
GRAND TOTAL	72,385		154,719	2040	31,979	9095	21,665	47.741	84,635		6818	1594	15,541	1097	325

SHEET No.	LOCATION/STATION	STAMPED ASPHALT CROSSWALK	THERMOPLASTIC PAVEMENT MARKING (BUS LANE)
			RED
		SQFT	
PD-17	"A1" 1195+18 TO 1197+18		884
PD-24	"A1" 1296+00 TO 1297+00	2160	
TOTAL		2160	884

PAVEMENT DELINEATION QUANTITIES

PDQ-23

CALCULATED-DESIGNED BY: QUYNH NGUYEN
CHECKED BY: SON LY
REVISED BY: TG
DATE REVISED: 11-28-22
FUNCTIONAL SUPERVISOR: TAM LY
STATE OF CALIFORNIA - DEPARTMENT OF TRANSPORTATION
DESIGN

LAST REVISION | DATE PLOTTED => 18-NOV-2024
12-07-22 | TIME PLOTTED => 16:12

BORDER LAST REVISED 7/2/2010
USERNAME => s129144
DGN FILE => 0419000140nc023.cco
RELATIVE BORDER SCALE IS IN INCHES 0 1 2 3
UNIT 0712
PROJECT NUMBER & PHASE 04190001401

Dist	COUNTY	ROUTE	POST MILES TOTAL PROJECT	SHEET No.	TOTAL SHEETS
04	SCI	82	18.2/26.4	271A	466

AS-AWARDED CONTRACT PLANS
THIS STAMP PLACED IN LIEU OF ORIGINAL SIGNATURE
REGISTERED CIVIL ENGINEER DATE
January 20, 2023
PLANS APPROVAL DATE

REGISTERED PROFESSIONAL ENGINEER — No. — Exp. — CIVIL — STATE OF CALIFORNIA

THE STATE OF CALIFORNIA OR ITS OFFICERS OR AGENTS SHALL NOT BE RESPONSIBLE FOR THE ACCURACY OR COMPLETENESS OF SCANNED COPIES OF THIS PLAN SHEET.

20 REPLACED PER CONTRACT CHANGE ORDER No. 20 DATED

REGISTERED PROFESSIONAL ENGINEER — Son Thanh Ly — No. 72584 — Exp. 6-30-26 — CIVIL — STATE OF CALIFORNIA

FOR REVISION ONLY
July 22, 2024
DATE

TRAFFIC STRIPES, PAVEMENT MARKINGS AND PAVEMENT MARKERS

	THERMOPLASTIC TRAFFIC STRIPE (ENHANCED WET NIGHT VISIBILITY)		TRAFFIC STRIPE TAPE (WARRANTY)			THERMOPLASTIC CROSSWALK AND PAVEMENT MARKING (ENHANCED WET NIGHT VISIBILITY)		PAVEMENT MARKERS (RETRORE-FLECTIVE)	REMOVE THERMOPLASTIC TRAFFIC STRIPE	REMOVE THERMOPLASTIC PAVEMENT MARKING	REMOVE MARKER
	6" WHITE	6" YELLOW	6" WHITE		8" WHITE						
	WHITE SOLID	YELLOW SOLID	BROKEN (17-7)	BROKEN (6-1)	WHITE SOLID	WHITE	YELLOW				
	LF					SQFT		EA	LF	SQFT	EA
SHEET PDQ-1A TOTAL		1,795	9,768	100	1,527	2,972		338	7,823	777	166
SHEET PDQ-2A TOTAL		5,378	5,600	400	429	305		365		20	
SHEET PDQ-3A TOTAL		2,840	5,000		457	10,788		248		60	
SHEET PDQ-4A TOTAL		4,155	11,174	100	743	2,669		451		100	
SHEET PDQ-5A TOTAL	1,279	3,936		100	540	10,044		209		60	
SHEET PDQ-6A TOTAL		3,570	7,060	200	1,309	3,861		356		60	
SHEET PDQ-7A TOTAL		2,610	5,939		733	3,191		260			
SHEET PDQ-8A TOTAL		1,620	5,461	100	618	3,264		210			
SHEET PDQ-9A TOTAL		1,800	1,904	100	728	3,794		112		20	
SHEET PDQ-10A TOTAL		3,258	4,580	300	1,367	2,144		246			
SHEET PDQ-11A TOTAL		4,234	8,372		926	2,212		347			
SHEET PDQ-12A TOTAL		2,050	4,559		1,153	4,874		200			
SHEET PDQ-13A TOTAL		4,135	10,614	100	1,156	3,016		441			
SHEET PDQ-14A TOTAL		2,698	6,224		1,335	3,444		326			
SHEET PDQ-15A TOTAL		1,836	3,787		645	4,273.5		178			
SHEET PDQ-16A TOTAL		2,526	4,151		569	2,889		225			
SHEET PDQ-17A TOTAL		4,752	11,465	200	1,455	5,116		488			
SHEET PDQ-18A TOTAL		5,132	15,316		1,260	3,214		572			
SHEET PDQ-19A TOTAL		5,043	13,231		1,499	3,019	410	555	795		16
SHEET PDQ-20A TOTAL	623	5,462	19,116	200	2,096	2,018	310	536	6,923		143
SHEET PDQ-21A TOTAL	140	1,513	1,398	140	1,120	1,750		110			
SHEET PDQ-22A TOTAL						198		45			
TOTAL	2,042	70,343	154,719	2040	21,665	79,055.5	720	6818	15,541	1097	325
GRAND TOTAL	72,385		154,719	2040	21,665	79,755.5		6818	15,541	1097	325

SHEET No.	LOCATION/STATION	STAMPED ASPHALT CROSSWALK	THERMOPLASTIC PAVEMENT MARKING (BUS LANE)
			RED
		SQFT	
PD-17	"A1" 1195+18 TO 1197+18		884
PD-24	"A1" 1296+00 TO 1297+00	2160	
TOTAL		2160	884

CONTRACT CHANGE ORDER NO. 20
SHEET _____ OF _____

PAVEMENT DELINEATION QUANTITIES

PDQ-23A

CALCULATED-DESIGNED BY	QUYNH NGUYEN	REVISED BY	TG	LAST REVISION	DATE PLOTTED => 18-NOV-2024
CHECKED BY	SON LY	DATE REVISED	11-28-22	12-07-22	TIME PLOTTED => 16:12
FUNCTIONAL SUPERVISOR	TAM LY				
STATE OF CALIFORNIA - DEPARTMENT OF TRANSPORTATION	DESIGN				

TRAFFIC STRIPES, PAVEMENT MARKINGS AND PAVEMENT MARKERS
(BIKE LANES, CROSSWALKS, AND LIMIT LINES)

SHEET No.	DIRECTION	DETAIL No.	THERMOPLASTIC TRAFFIC STRIPE (ENHANCED WET NIGHT VISIBILITY) 6" WHITE SOLID	THERMOPLASTIC TRAFFIC STRIPE (ENHANCED WET NIGHT VISIBILITY) 6" WHITE BROKEN (8-4)	THERMOPLASTIC PAVEMENT MARKING (BIKE LANE TREATMENT) GREEN	THERMOPLASTIC CROSSWALK AND PAVEMENT MARKING (ENHANCED WET NIGHT VISIBILITY) WHITE	DESCRIPTION/COMMENTS	REMOVE THERMOPLASTIC TRAFFIC STRIPE
			LF		SQFT			LF
PD-1						12	12" LIMIT LINE AT CRESTVIEW Dr	
PD-2	SB	39	1040				2 STRIPES + 45 DEGREE STRIPES	
	SB	39A		193	1020			
	SB				500	23	SOLID GREEN	
	SB				255	21	BIKE LANE SYMBOL W/ PERSON	
	NB	39	757				2 STRIPES + 45 DEGREE STRIPES	
	NB	39A		55	100			
	NB				255	28	BIKE LANE SYMBOL W/ PERSON	
	INTERSECTION			1190	828			
PD-3	SB	39	1092				2 STRIPES + 45 DEGREE STRIPES	
	SB	39A		907	1,484			
	SB				408		SOLID GREEN	
	SB	39	82		255	21	BIKE LANE SYMBOL W/ PERSON	
	SB					14	12" LIMIT LINE AT HANFORD Dr	
	NB	39	2011				2 STRIPES + 45 DEGREE STRIPES	
	NB	39A		619	1,112			
	NB				510	42	BIKE LANE SYMBOL W/ PERSON	
PD-4	SB	39	240					
	SB	39A		1150	1,860			
	SB				160	46	SHARROW	
	SB				170	14	BIKE LANE SYMBOL W/ PERSON	
	SB					13	12" LIMIT LINE AT BAY St	
	SB				110		BIKE BOX	
	SB					126	BIKE BUS ONLY	
	NB	39	496					
	NB	39A		1390	3,356			
	NB				170	14	BIKE LANE SYMBOL W/ PERSON	
	NB					33	12" LIMIT LINE AT YUBA Dr AND BAY St	
	NB					63	BIKE BUS ONLY	
PD-5	SB	39	1045					
	SB	39A		898	2,746			
	SB				340	28	BIKE LANE SYMBOL W/ PERSON	
	SB				110	11	2 STAGE BIKE BOX	
	SB					21	12" LIMIT LINE AT PHYLLIS Ave	
	SB				110	12	BIKE BOX	
	SB					63	BIKE BUS ONLY	
	NB	39	1169					
	NB	39A		865	2,792			
	NB				340	28	BIKE LANE SYMBOL W/ PERSON	
	NB				110	11	2 STAGE BIKE BOX	
	NB					48	12" LIMIT LINE AT CALDERON Ave AND EHRHORN Ave	
	NB				110	12	BIKE BOX	
	NB					63	BIKE BUS ONLY	
	INTERSECTION			712	768			
SHEET TOTAL			7932	7979	19,979	767		

Dist	COUNTY	ROUTE	POST MILES TOTAL PROJECT	SHEET No.	TOTAL SHEETS
04	SCI	82	18.2/26.4	269B	466

20

AS-AWARDED CONTRACT PLANS
THIS STAMP PLACED IN LIEU OF ORIGINAL SIGNATURE

REGISTERED CIVIL ENGINEER DATE

PLANS APPROVAL DATE

REGISTERED PROFESSIONAL ENGINEER — No. Exp. CIVIL — STATE OF CALIFORNIA

THE STATE OF CALIFORNIA OR ITS OFFICERS OR AGENTS SHALL NOT BE RESPONSIBLE FOR THE ACCURACY OR COMPLETENESS OF SCANNED COPIES OF THIS PLAN SHEET.

REGISTERED PROFESSIONAL ENGINEER — Son Thanh Ly — No. 72584 — Exp. 6-30-26 — CIVIL — STATE OF CALIFORNIA

FOR REVISION ONLY
July 22, 2024
DATE

CONTRACT CHANGE ORDER NO. 20
SHEET _____ OF _____

20 ADDED PER CONTRACT CHANGE ORDER No. 20 DATED

PAVEMENT DELINEATION QUANTITIES
PDQ-23B

REVISED BY	TG
DATE REVISED	11-28-22
CALCULATED-DESIGNED BY	QUYNH NGUYEN
CHECKED BY	SON LY
FUNCTIONAL SUPERVISOR	TAM LY
STATE OF CALIFORNIA - DEPARTMENT OF TRANSPORTATION	DESIGN

LAST REVISION DATE PLOTTED => 19-NOV-2024
12-07-22 TIME PLOTTED => 08:25

BORDER LAST REVISED 7/2/2010 | USERNAME => s129144 | DGN FILE => 0419000140nc023B.cco | RELATIVE BORDER SCALE IS IN INCHES 0 1 2 3 | UNIT 0712 | PROJECT NUMBER & PHASE 04190001401

TRAFFIC STRIPES, PAVEMENT MARKINGS AND PAVEMENT MARKERS
(BIKE LANES, CROSSWALKS, AND LIMIT LINES)

SHEET No.	DIRECTION	DETAIL No.	THERMOPLASTIC TRAFFIC STRIPE (ENHANCED WET NIGHT VISIBILITY) 6" WHITE SOLID	THERMOPLASTIC TRAFFIC STRIPE (ENHANCED WET NIGHT VISIBILITY) 6" WHITE BROKEN (8-4)	THERMOPLASTIC PAVEMENT MARKING (BIKE LANE TREATMENT) GREEN	THERMOPLASTIC CROSSWALK AND PAVEMENT MARKING (ENHANCED WET NIGHT VISIBILITY) WHITE	DESCRIPTION/COMMENTS	REMOVE THERMOPLASTIC TRAFFIC STRIPE
			LF		SQFT			LF
PD-6	SB	39	431					
	SB	39A		1350	4,202			
	SB				255	21	BIKE LANE SYMBOL W/ PERSON	
	SB					45	12" LIMIT LINE AT BONITA Ave, BORANDA Ave, LANE Ave	
	SB					63	BIKE BUS ONLY	
	NB	39	1351					
	NB	39A		925	2,620			
	NB				425	35	BIKE LANE SYMBOL W/ PERSON	
	NB					48	12" LIMIT LINE AT BUSH St, VIEW St, HOPE St	
	NB					63	BIKE BUS ONLY	
PD-7	SB	39	1192				2 STRIPES + 45 DEGREE STRIPES	
	SB	39A		928	2,426			
	SB				425	35	BIKE LANE SYMBOL W/ PERSON	
	SB					63	BIKE BUS ONLY	
	NB	39	1094				2 STRIPES + 45 DEGREE STRIPES	
	NB	39A		825	2,380			
	NB				425	35	BIKE LANE SYMBOL W/ PERSON	
	NB				80	23	SHARROW	
	NB				110	2	BIKE BOX	
	NB					63	BIKE BUS ONLY	
	INTERSECTION	39A		826	956			
						126	12" LIMIT LINE AT CASTRO St, OAK St, MIRAMONTE Ave	
PD-8	SB	39	1071				2 STRIPES + 45 DEGREE STRIPES	
	SB	39A		1073	3,000			
	SB				160	46	SHARROW	
	SB				340	28	BIKE LANE SYMBOL W/ PERSON	
	SB				110		BIKE BOX	
	SB					63	BIKE BUS ONLY	
	INTERSECTION	39A		454	1,756			
	NB	39	702				2 STRIPES + 45 DEGREE STRIPES	
	NB	39A		1532	3,432			
	NB				340	28	BIKE LANE SYMBOL W/ PERSON	
	NB					63	BIKE BUS ONLY	
						101	12" LIMIT LINE AT SHORELINE Blvd, MOUNTAIN VIEW Ave, PALO ALTO Ave, PETTIS Ave	
PD-9	SB	39	808				2 STRIPES + 45 DEGREE STRIPES	
	SB	39A		708	1504			
	SB	39	156					
	SB				120	35	SHARROW	
	SB				340	28	BIKE LANE SYMBOL W/ PERSON	
	SB					63	BIKE BUS ONLY	
	NB	39	610				2 STRIPES + 45 DEGREE STRIPES	
	NB	39A		529	1,286			
	NB	39	570					
	NB				255	21	BIKE LANE SYMBOL W/ PERSON	
	NB					63	BIKE BUS ONLY	
	INTERSECTION	39A		180	384			
						52	12" LIMIT LINE AT RICH Ave, EL MONTE Ave	
SHEET TOTAL			7985	9330	27,331	1213		

CONTRACT CHANGE ORDER NO. 20
SHEET _____ OF _____

20 ADDED PER CONTRACT CHANGE ORDER No. 20 DATED

Dist	COUNTY	ROUTE	POST MILES TOTAL PROJECT	SHEET No.	TOTAL SHEETS
04	SCI	82	18.2/26.4	269C	466

20

AS-AWARDED CONTRACT PLANS
THIS STAMP PLACED IN LIEU OF ORIGINAL SIGNATURE

REGISTERED CIVIL ENGINEER DATE

PLANS APPROVAL DATE

REGISTERED PROFESSIONAL ENGINEER — No. ____ Exp. ____ CIVIL — STATE OF CALIFORNIA

THE STATE OF CALIFORNIA OR ITS OFFICERS OR AGENTS SHALL NOT BE RESPONSIBLE FOR THE ACCURACY OR COMPLETENESS OF SCANNED COPIES OF THIS PLAN SHEET.

REGISTERED PROFESSIONAL ENGINEER — Son Thanh Ly — No. 72584 — Exp. 6-30-26 — CIVIL — STATE OF CALIFORNIA

FOR REVISION ONLY
July 22, 2024
DATE

PAVEMENT DELINEATION QUANTITIES
PDQ-23C

REVISED BY: TG — DATE REVISED: 11-28-22
CALCULATED-DESIGNED BY: QUYNH NGUYEN — CHECKED BY: SON LY
FUNCTIONAL SUPERVISOR: TAM LY
STATE OF CALIFORNIA - DEPARTMENT OF TRANSPORTATION — DESIGN — Caltrans

LAST REVISION | DATE PLOTTED => 18-NOV-2024 | TIME PLOTTED => 16:13
12-07-22

BORDER LAST REVISED 7/2/2010 | USERNAME => s129144 | DGN FILE => 0419000140nc023C.cco | RELATIVE BORDER SCALE IS IN INCHES 0 1 2 3 | UNIT 0712 | PROJECT NUMBER & PHASE 04190001401

TRAFFIC STRIPES, PAVEMENT MARKINGS AND PAVEMENT MARKERS
(BIKE LANES, CROSSWALKS, AND LIMIT LINES)

SHEET No.	DIRECTION	DETAIL No.	THERMOPLASTIC TRAFFIC STRIPE (ENHANCED WET NIGHT VISIBILITY) 6" WHITE SOLID	THERMOPLASTIC TRAFFIC STRIPE (ENHANCED WET NIGHT VISIBILITY) 6" WHITE BROKEN (8-4)	THERMOPLASTIC PAVEMENT MARKING (BIKE LANE TREATMENT) GREEN	THERMOPLASTIC CROSSWALK AND PAVEMENT MARKING (ENHANCED WET NIGHT VISIBILITY) WHITE	DESCRIPTION/COMMENTS	REMOVE THERMOPLASTIC TRAFFIC STRIPE
			LF		SQFT			LF
PD-10	SB	39	1,079				2 STRIPES + 45 DEGREE STRIPES	
	SB	39A		760	2,376			
	SB				340	28	BIKE LANE SYMBOL W/ PERSON	
	SB					63	BIKE BUS ONLY	
	NB	39	1,610				2 STRIPES + 45 DEGREE STRIPES	
	NB	39A		453	1,287			
	NB				340	28	BIKE LANE SYMBOL W/ PERSON	
	NB					63	BIKE BUS ONLY	
	INTERSECTION			380	444			
						29	12" LIMIT LINE AT ESCUELA Ave, CLARK Ave	
PD-11	SB	39	887				2 STRIPES + 45 DEGREE STRIPES	
	SB	39	150					
	SB	39A		720	2,168			
	SB				340	28	BIKE LANE SYMBOL W/ PERSON	
	SB					63	BIKE BUS ONLY	
	NB	39	1,031					
	NB	39	73					
	NB	39A		685	1,656			
	NB				510	42	BIKE LANE SYMBOL W/ PERSON	
	NB					63	BIKE BUS ONLY	
	INTERSECTION			325	392			
PD-12	SB	39	834				2 STRIPES + 45 DEGREE STRIPES	
	SB	39A		1050	3,388			
	SB				340	28	BIKE LANE SYMBOL W/ PERSON	
	SB					126	BIKE BUS ONLY	
	NB	39	717				2 STRIPES + 45 DEGREE STRIPES	
	NB	39A		1086	3,404			
	NB				255	21	BIKE LANE SYMBOL W/ PERSON	
	NB					126	BIKE BUS ONLY	
						15	12" LIMIT LINE AT ORTEGA Ave	
PD-13	SB	39	850				2 STRIPES + 45 DEGREE STRIPES	
	SB	39A		940	2,960			
	SB				425	35	BIKE LANE SYMBOL W/ PERSON	
	SB					63	BIKE BUS ONLY	
	NB	39	674				2 STRIPES + 45 DEGREE STRIPES	
	NB	39A		664	1,774			
	NB				510	42	BIKE LANE SYMBOL W/ PERSON	
	NB					63	BIKE BUS ONLY	
	INTERSECTION	39A		186	224			
	NB				120	34.5	SHARROW	
PD-14	SB	39	1,574				2 STRIPES + 45 DEGREE STRIPES	
	SB	39A		556	1,584			
	SB				510	42	BIKE LANE SYMBOL W/ PERSON	
	SB					63	BIKE BUS ONLY	
	NB	39	696				2 STRIPES + 45 DEGREE STRIPES	
	NB	39A		598	1,616			
	NB				170	14	BIKE LANE SYMBOL W/ PERSON	
	INTERSECTION	39A		898	450			
					550		BIKE BOX	
						8	BIKE LOOP DETECTOR SYMBOL	
SHEET TOTAL			10,175	9301	28,133	1087.5		

CONTRACT CHANGE ORDER NO. 20
SHEET _____ OF _____

Dist	COUNTY	ROUTE	POST MILES TOTAL PROJECT	SHEET No.	TOTAL SHEETS
04	SCI	82	18.2/26.4	269D	466

AS-AWARDED CONTRACT PLANS
THIS STAMP PLACED IN LIEU OF ORIGINAL SIGNATURE

REGISTERED CIVIL ENGINEER DATE

REGISTERED PROFESSIONAL ENGINEER — No. _____ Exp. _____ CIVIL — STATE OF CALIFORNIA

PLANS APPROVAL DATE

THE STATE OF CALIFORNIA OR ITS OFFICERS OR AGENTS SHALL NOT BE RESPONSIBLE FOR THE ACCURACY OR COMPLETENESS OF SCANNED COPIES OF THIS PLAN SHEET.

REGISTERED PROFESSIONAL ENGINEER — Son Thanh Ly — No. 72584 — Exp. 6-30-26 — CIVIL — STATE OF CALIFORNIA

FOR REVISION ONLY
July 22, 2024
DATE

20 ADDED PER CONTRACT CHANGE ORDER No. 20 DATED

PAVEMENT DELINEATION QUANTITIES
PDQ-23D

LAST REVISION | DATE PLOTTED => 18-NOV-2024
12-07-22 | TIME PLOTTED => 16:13

CALCULATED-DESIGNED BY: QUYNH NGUYEN
CHECKED BY: SON LY
REVISED BY: TG
DATE REVISED: 11-28-22
FUNCTIONAL SUPERVISOR: TAM LY
STATE OF CALIFORNIA - DEPARTMENT OF TRANSPORTATION
DESIGN

BORDER LAST REVISED 7/2/2010
USERNAME => s129144
DGN FILE => 0419000140nc023D.cco
RELATIVE BORDER SCALE IS IN INCHES 0 1 2 3
UNIT 0712
PROJECT NUMBER & PHASE 04190001401

TRAFFIC STRIPES, PAVEMENT MARKINGS AND PAVEMENT MARKERS
(BIKE LANES, CROSSWALKS, AND LIMIT LINES)

SHEET No.	DIRECTION	DETAIL No.	THERMOPLASTIC TRAFFIC STRIPE (ENHANCED WET NIGHT VISIBILITY) 6" WHITE SOLID	THERMOPLASTIC TRAFFIC STRIPE (ENHANCED WET NIGHT VISIBILITY) 6" WHITE BROKEN (8-4)	THERMOPLASTIC PAVEMENT MARKING (BIKE LANE TREATMENT) GREEN	THERMOPLASTIC CROSSWALK AND PAVEMENT MARKING (ENHANCED WET NIGHT VISIBILITY) WHITE	DESCRIPTION/COMMENTS	REMOVE THERMOPLASTIC TRAFFIC STRIPE
			LF		SQFT			LF
PD-15	SB	39	1,303				2 STRIPES + 45 DEGREE STRIPES	
	SB	39A		782	1,752			
	SB				340	28	BIKE LANE SYMBOL W/ PERSON	
	SB					63	BIKE BUS LANE	
	NB	39	981				2 STRIPES + 45 DEGREE STRIPES	
	NB	39A		736	1,480			
	NB				520	35	BIKE LANE SYMBOL W/ PERSON	
	NB					63	BIKE BUS LANE	
	INTERSECTION	39A		660	912			
						21	12" LIMIT LINE AT DEL MEDIO Ave	
PD-16	SB	39	1,146				2 STRIPES + 45 DEGREE STRIPES	
	SB	39A		623	1,728			
	SB				728	42	BIKE LANE SYMBOL W/ PERSON	
	SB					63	BIKE BUS LANE	
	NB	39	665				2 STRIPES + 45 DEGREE STRIPES	
	NB	39A		834	1,048			
	NB				312	14	BIKE LANE SYMBOL W/ PERSON	
	NB					63	BIKE BUS LANE	
	INTERSECTION	39A		740	896			
						4	BIKE LOOP DETECTOR SYMBOL	
PD-17	SB	39	327				2 STRIPES + 45 DEGREE STRIPES	
	SB	39A		1181	2,121			
	SB				200	57.5	SHARROW	
	SB				340	28	BIKE LANE SYMBOL W/ PERSON	
	SB				121	24	BIKE BOX	
	SB					126	BIKE BUS LANE	
	NB	39	774				2 STRIPES + 45 DEGREE STRIPES	
	NB	39A		586	2,524			
	NB				170	14	BIKE LANE SYMBOL W/ PERSON	
	NB					63	BIKE BUS LANE	
						8	BIKE LOOP DETECTOR SYMBOL	
	INTERSECTION	39A		746	690			
PD-18	SB	39	1,526				2 STRIPES + 45 DEGREE STRIPES	
	SB	39A		570	1,852			
	SB				340	28	BIKE LANE SYMBOL W/ PERSON	
	SB					63	BIKE BUS LANE	
	NB	39	1,931				2 STRIPES + 45 DEGREE STRIPES	
	NB	39A		382	1,064			
	NB				510	42	BIKE LANE SYMBOL W/ PERSON	
	INTERSECTION	39A		364	182			
PD-19	SB	39	780				2 STRIPES + 45 DEGREE STRIPES	
	SB	39A		1,095	2,436			
	SB				416	28	BIKE LANE SYMBOL W/ PERSON	
	SB				160	24	BIKE BOX	
	SB					63	BIKE BUS LANE	
	NB	39	723				2 STRIPES + 45 DEGREE STRIPES	
	NB	39A		961	2,968			
	NB				416	28	BIKE LANE SYMBOL W/ PERSON	
	INTERSECTION	39A		516	632			
	NB				160	24	BIKE BOX	
						8	BIKE LOOP DETECTOR SYMBOL	
	NB					126	BIKE BUS LANE	
SHEET TOTAL			10,156	10,776	27,018	1150.5		

CONTRACT CHANGE ORDER NO. 20
SHEET ____ OF ____

Dist	COUNTY	ROUTE	POST MILES TOTAL PROJECT	SHEET No.	TOTAL SHEETS
04	SCI	82	18.2/26.4	269E	466

20

AS-AWARDED CONTRACT PLANS
THIS STAMP PLACED IN LIEU OF ORIGINAL SIGNATURE
REGISTERED CIVIL ENGINEER DATE

January 20, 2023
PLANS APPROVAL DATE

REGISTERED PROFESSIONAL ENGINEER — No. ____ Exp. ____ CIVIL — STATE OF CALIFORNIA

THE STATE OF CALIFORNIA OR ITS OFFICERS OR AGENTS SHALL NOT BE RESPONSIBLE FOR THE ACCURACY OR COMPLETENESS OF SCANNED COPIES OF THIS PLAN SHEET.

REGISTERED PROFESSIONAL ENGINEER — Son Thanh Ly — No. 72584 — Exp. 6-30-26 — CIVIL — STATE OF CALIFORNIA

FOR REVISION ONLY
July 22, 2024
DATE

20 ADDED PER CONTRACT CHANGE ORDER No. 20 DATED

PAVEMENT DELINEATION QUANTITIES
PDQ-23E

REVISED BY	TG
DATE REVISED	11-28-22
CALCULATED-DESIGNED BY	QUYNH NGUYEN
CHECKED BY	SON LY
FUNCTIONAL SUPERVISOR	TAM LY

STATE OF CALIFORNIA - DEPARTMENT OF TRANSPORTATION
Caltrans® DESIGN

LAST REVISION DATE PLOTTED => 18-NOV-2024
TIME PLOTTED => 12-07-22 16:13

BORDER LAST REVISED 7/2/2010 | USERNAME => s129144 | DGN FILE => 0419000140nc023E.cco | RELATIVE BORDER SCALE IS IN INCHES 0 1 2 3 | UNIT 0712 | PROJECT NUMBER & PHASE 04190001401

TRAFFIC STRIPES, PAVEMENT MARKINGS AND PAVEMENT MARKERS
(BIKE LANES, CROSSWALKS, AND LIMIT LINES)

SHEET No.	DIRECTION	DETAIL No.	THERMOPLASTIC TRAFFIC STRIPE (ENHANCED WET NIGHT VISIBILITY) 6" WHITE SOLID	THERMOPLASTIC TRAFFIC STRIPE (ENHANCED WET NIGHT VISIBILITY) 6" WHITE BROKEN (8-4)	THERMOPLASTIC PAVEMENT MARKING (BIKE LANE TREATMENT) GREEN	THERMOPLASTIC CROSSWALK AND PAVEMENT MARKING (ENHANCED WET NIGHT VISIBILITY) WHITE	DESCRIPTION/COMMENTS	REMOVE THERMOPLASTIC TRAFFIC STRIPE
			LF		SQFT			LF
PD-20	SB	39	1045				2 STRIPES + 45 DEGREE STRIPES	
	SB	39A		847	3,007			
	SB				425	35	BIKE LANE SYMBOL W/ PERSON	
	SB					126	BIKE BUS ONLY	
	NB	39	540				2 STRIPES + 45 DEGREE STRIPES	
	NB	39A		715	2,455			
	NB				340	28	BIKE LANE SYMBOL W/ PERSON	
	NB					63	BIKE BUS ONLY	
	INTERSECTION	39A		1,100	1,320			
PD-21	SB	39	1400			4	BIKE LOOP DETECTOR SYMBOL	
	SB	39A		525	2,270			
	SB				340	28	BIKE LANE SYMBOL W/ PERSON	
	SB					63	BIKE BUS ONLY	
	NB	39	706				2 STRIPES + 45 DEGREE STRIPES	
	NB	39A		765	2,250			
	NB				340	28	BIKE LANE SYMBOL W/ PERSON	
	NB					63	BIKE BUS ONLY	
	INTERSECTION	39A		1,290	1,570			
					260		BIKE BOX AT HANSEN Wy	
						36	YEILD LINE	
						31	12" LIMIT LINE AT LAMBERT Ave, PORTAGE Ave	
						160	LADDER CROSSWALK AND LIMIT LINE AT ACACIA Ave	12
						215	LADDER CROSSWALK AND LIMIT LINE AT OLIVE Ave	18
						4	BIKE LOOP DETECTOR SYMBOL	
PD-22	SB	39	607				2 STRIPES + 45 DEGREE STRIPES	
	SB	39A		720	1,584			
	SB				415	35	BIKE LANE SYMBOL W/ PERSON	
	SB				120	46	SHARROW	
	SB				120	2	BIKE BOX	
	SB					63	BIKE BUS ONLY	
	NB	39	387		660		2 STRIPES + 45 DEGREE STRIPES	
	NB	39A		890	1,920			
	NB				255	21	BIKE LANE SYMBOL W/ PERSON	
	NB				120	46	SHARROW	
	NB				120	2	BIKE BOX	
	NB					63	BIKE BUS ONLY	
	INTERSECTION	39A		650	852			
						190	LADDER CROSSWALK AND LIMIT LINE AT PEPER Ave	15
						214	LADDER CROSSWALK AND LIMIT LINE AT SHERMAN Ave	68
						40	12" LIMIT LINE AT CAMBRIDGE Ave	
						4	BIKE LOOP DETECTOR SYMBOL	
PD-23	SB	39	385				2 STRIPES + 45 DEGREE STRIPES	
	SB	39A		950	2,755			
	SB				170	14	BIKE LANE SYMBOL W/ PERSON	
	SB					126	BIKE BUS ONLY	
	SB							
	NB	39	950				2 STRIPES + 45 DEGREE STRIPES	
	NB	39A		715	2,010			
	NB				425	35	BIKE LANE SYMBOL W/ PERSON	
						63	BIKE BUS ONLY	
	INTERSECTION	39A		940	1,350		2 STRIPES + 45 DEGREE STRIPES	
						520	LADDER CROSSWALK AND LIMIT LINE AT COLLEGE Ave, OXFORD Ave	180
						8	BIKE LOOP DETECTOR SYMBOL	
SHEET TOTAL			6,020	10,107	27,453	2376		293

CONTRACT CHANGE ORDER NO. 20
SHEET ____ OF ____

Dist	COUNTY	ROUTE	POST MILES TOTAL PROJECT	SHEET No.	TOTAL SHEETS
04	SCI	82	18.2/26.4	269F	466

AS-AWARDED CONTRACT PLANS
THIS STAMP PLACED IN LIEU OF ORIGINAL SIGNATURE

REGISTERED CIVIL ENGINEER DATE

PLANS APPROVAL DATE

REGISTERED PROFESSIONAL ENGINEER — No. ____ Exp. ____ CIVIL — STATE OF CALIFORNIA

THE STATE OF CALIFORNIA OR ITS OFFICERS OR AGENTS SHALL NOT BE RESPONSIBLE FOR THE ACCURACY OR COMPLETENESS OF SCANNED COPIES OF THIS PLAN SHEET.

REGISTERED PROFESSIONAL ENGINEER — Son Thanh Ly — No. 72584 — Exp. 6-30-26 — CIVIL — STATE OF CALIFORNIA

FOR REVISION ONLY
July 22, 2024
DATE

20 ADDED PER CONTRACT CHANGE ORDER No. 20 DATED

PAVEMENT DELINEATION QUANTITIES

PDQ-23F

REVISED BY	DATE REVISED
TG	11-28-22

CALCULATED-DESIGNED BY: QUYNH NGUYEN
CHECKED BY: SON LY
FUNCTIONAL SUPERVISOR: TAM LY

STATE OF CALIFORNIA - DEPARTMENT OF TRANSPORTATION
DESIGN

LAST REVISION: DATE PLOTTED => 18-NOV-2024
TIME PLOTTED => 16:13

BORDER LAST REVISED 7/2/2010
USERNAME => s129144
DGN FILE => 0419000140nc023F.cco
RELATIVE BORDER SCALE IS IN INCHES 0 1 2 3
UNIT 0712
PROJECT NUMBER & PHASE 04190001401

TRAFFIC STRIPES, PAVEMENT MARKINGS AND PAVEMENT MARKERS
(BIKE LANES, CROSSWALKS, AND LIMIT LINES)

SHEET No.	DIRECTION	DETAIL No.	THERMOPLASTIC TRAFFIC STRIPE (ENHANCED WET NIGHT VISIBILITY) 6" WHITE SOLID	THERMOPLASTIC TRAFFIC STRIPE (ENHANCED WET NIGHT VISIBILITY) 6" WHITE BROKEN (8-4)	THERMOPLASTIC PAVEMENT MARKING (BIKE LANE TREATMENT) GREEN	THERMOPLASTIC CROSSWALK AND PAVEMENT MARKING (ENHANCED WET NIGHT VISIBILITY) WHITE	DESCRIPTION/COMMENTS	REMOVE THERMOPLASTIC TRAFFIC STRIPE
			LF		SQFT			LF
PD-24	SB	39	1,179				2 STRIPES + 45 DEGREE STRIPES	
	SB	39A		670	1,775			
	SB				85	7	BIKE LANE SYMBOL W/ PERSON	
	SB					63	BIKE BUS ONLY	
						8	BIKE LOOP DETECTOR SYMBOL	
	NB	39	575				2 STRIPES + 45 DEGREE STRIPES	
	NB	39A		1000	2,760			
	NB				255	21	BIKE LANE SYMBOL W/ PERSON	
	INTERSECTION	39A		1110	1,130		2 STRIPES + 45 DEGREE STRIPES	
					50	14	BIKE BOX	
						320	LADDER CROSSWALK AND LIMIT LINE AT LELAND Ave, PARK AvE	25
PD-25	SB	39	2,167				2 STRIPES + 45 DEGREE STRIPES	
	SB	39A		376	1,120			
	SB				85	7	BIKE LANE SYMBOL W/ PERSON	
	SB					63	BIKE BUS ONLY	
	NB	39	1,011				2 STRIPES + 45 DEGREE STRIPES	
	NB	39A		694	2,120			
	NB				160	46	SHARROW	
	NB					63	BIKE BUS ONLY	
	INTERSECTION	39A		130	120			
						2	BIKE LOOP DETECTOR SYMBOL	
PD-26	SB	39	2,245				2 STRIPES + 45 DEGREE STRIPES	
	SB	39A		490	1,592			
	SB				170	14	BIKE LANE SYMBOL W/ PERSON	
	SB					63	BIKE BUS ONLY	
	NB	39	2,238				2 STRIPES + 45 DEGREE STRIPES	
	NB	39A		473	1,552			
	NB				255	21	BIKE LANE SYMBOL W/ PERSON	
	NB					63	BIKE BUS ONLY	
PD-27	SB	39	1,658				2 STRIPES + 45 DEGREE STRIPES	
	SB	39A		410	1,352			
	SB				85	7	BIKE LANE SYMBOL W/ PERSON	
	SB					63	BIKE BUS ONLY	
	NB	39	663				2 STRIPES + 45 DEGREE STRIPES	
	NB	39A		823	2,136			
	NB				110	12	BIKE BOX	
	NB					63	BIKE BUS ONLY	
	INTERSECTION	39A		468	476			
						92	12" LIMIT LINE AT EMBARCADERO Rd, ENICNA Ave, GALVEZ Rd	
						21	YIELD LINE	
PD-29	SB	39	490				2 STRIPES + 45 DEGREE STRIPES	
	SB	39A		930	1,092			
	SB					63	BIKE BUS ONLY	
	NB	39	110				2 STRIPES + 45 DEGREE STRIPES	
	NB	39A		1100	1,290			
						2	BIKE LOOP DETECTOR SYMBOL	
PD-30	SB	39	170				2 STRIPES + 45 DEGREE STRIPES	
	SB	39A		1,042	886			
	SB				85	7	BIKE LANE SYMBOL W/ PERSON	
	NB	39	1,082					
	NB	39A		204	252			
					85	7	BIKE LANE SYMBOL W/ PERSON	
						2	BIKE LOOP DETECTOR SYMBOL	
					1,225		SOLID GREEN	
SHEET TOTAL			11,930	9,920	22,303	1114		25

Dist	COUNTY	ROUTE	POST MILES TOTAL PROJECT	SHEET No.	TOTAL SHEETS
04	SCI	82	18.2/26.4	269G	466

20

AS-AWARDED CONTRACT PLANS
THIS STAMP PLACED IN LIEU OF ORIGINAL SIGNATURE

REGISTERED CIVIL ENGINEER DATE

PLANS APPROVAL DATE

REGISTERED PROFESSIONAL ENGINEER — No. Exp. CIVIL — STATE OF CALIFORNIA

THE STATE OF CALIFORNIA OR ITS OFFICERS OR AGENTS SHALL NOT BE RESPONSIBLE FOR THE ACCURACY OR COMPLETENESS OF SCANNED COPIES OF THIS PLAN SHEET.

REGISTERED PROFESSIONAL ENGINEER — Son Thanh Ly — No. 72584 — Exp. 6-30-26 — CIVIL — STATE OF CALIFORNIA

FOR REVISION ONLY
July 22, 2024
DATE

CONTRACT CHANGE ORDER NO. 20
SHEET _____ OF _____

20 **ADDED PER CONTRACT CHANGE ORDER No. 20 DATED**

PAVEMENT DELINEATION QUANTITIES

PDQ-23G

LAST REVISION: DATE PLOTTED => 18-NOV-2024
12-07-22 TIME PLOTTED => 16:13

CALCULATED-DESIGNED BY
CHECKED BY
FUNCTIONAL SUPERVISOR: TAM LY
REVISED BY: QUYNH NGUYEN
DATE REVISED: 11-28-22
TG
SON LY

STATE OF CALIFORNIA - DEPARTMENT OF TRANSPORTATION
Caltrans® DESIGN

Dist	COUNTY	ROUTE	POST MILES TOTAL PROJECT	SHEET No.	TOTAL SHEETS
04	SCI	82	18.2/26.4	270A	466

AS-AWARDED CONTRACT PLANS
THIS STAMP PLACED IN LIEU OF ORIGINAL SIGNATURE

REGISTERED CIVIL ENGINEER DATE

PLANS APPROVAL DATE

REGISTERED PROFESSIONAL ENGINEER — No. Exp. CIVIL — STATE OF CALIFORNIA

THE STATE OF CALIFORNIA OR ITS OFFICERS OR AGENTS SHALL NOT BE RESPONSIBLE FOR THE ACCURACY OR COMPLETENESS OF SCANNED COPIES OF THIS PLAN SHEET.

20

QWICK KURB CHANNELIZING SYSTEM

SHEET No.	DIRECTION	CONTINUOUS CURB (WHITE)	MEGA MARKER (WHITE)
		LF	EA
PD-2	SB	340	30
	NB	170	15
PD-3	SB	460	42
	NB	785	70
PD-4	SB	50	4
	NB	184	17
PD-5	SB	384	33
	NB	456	40
PD-6	SB	135	20
	NB	490	44
PD-7	SB	435	38
	NB	400	36
PD-8	SB	411	37
	NB	236	21
PD-9	SB	303	27
	NB	244	21
PD-10	SB	415	58
	NB	645	57
PD-11	SB	225	20
	NB	207	18
PD-12	SB	225	20
	NB	207	18
PD-13	SB	282	24
	NB	330	30
PD-14	SB	578	52
	NB	293	26
PD-15	SB	496	44
	NB	331	29
PD-16	SB	385	34
	NB	260	23
PD-17	SB	197	17
	NB	140	12
PD-18	SB	645	58
	NB	788	70
PD-19	SB	260	22
	NB	224	20
PD-20	SB	496	38
	NB	242	21
PD-21	SB	550	50
	NB	246	22
PD-22	SB	300	26
	NB	105	9
PD-23	SB	133	11
	NB	336	29
PD-24	SB	540	48
	NB	208	18
PD-25	SB	943	84
	NB	410	37
PD-26	SB	959	87
	NB	976	87
PD-27	SB	240	22
	NB	305	27
PD-29	SB	212	19
	NB	41	4
PD-30	NB	606	54
TOTAL		20,464	1882

TRAFFIC STRIPES, PAVEMENT MARKINGS AND PAVEMENT MARKERS

SHEET No.	DIRECTION	DETAIL No.	THERMOPLASTIC TRAFFIC STRIPE (ENHANCED WET NIGHT VISIBILITY) 6" WHITE SOLID	THERMOPLASTIC TRAFFIC STRIPE (ENHANCED WET NIGHT VISIBILITY) 6" WHITE BROKEN (6-1)	PAVEMENT MARKER TYPE H	TRAFFIC STRIPE TAPE WITH CONTRAST (WARRANTY) 6" WHITE BROKEN (17-7)
			LF		EA	LF
PD-1	INTERSECTION	40		120		
PD-3	SB	9				729
	NB	9				729
PD-27	SB	27B	750			
	NB	27B	123			
PD-28	SB		168			
	SB	26A			21	
	SB	27B	463			
	NB	27B	165			
TOTAL			1669	120	21	1458

Son Thanh Ly 72584 Exp. 6-30-26 CIVIL — REGISTERED PROFESSIONAL ENGINEER — STATE OF CALIFORNIA

FOR REVISION ONLY
July 22, 2024
DATE

20 ADDED PER CONTRACT CHANGE ORDER No. 20 DATED

TRAFFIC STRIPES, PAVEMENT MARKINGS AND PAVEMENT MARKERS (BIKE LANES, CROSSWALKS, AND LIMIT LINES)

	THERMOPLASTIC TRAFFIC STRIPE (ENHANCED WET NIGHT VISIBILITY) 6" WHITE SOLID	THERMOPLASTIC TRAFFIC STRIPE (ENHANCED WET NIGHT VISIBILITY) 6" WHITE BROKEN (8-4)	THERMOPLASTIC PAVEMENT MARKING (BIKE LANE TREATMENT) GREEN	THERMOPLASTIC CROSSWALK AND PAVEMENT MARKING (ENHANCED WET NIGHT VISIBILITY) WHITE	REMOVE PAVEMENT MARKING
	FT		SQFT		SQFT
SHEET PDQ-23B TOTAL	7,932	7,979	19,979	767	
SHEET PDQ-23C TOTAL	7,985	9,330	27,331	1,213	
SHEET PDQ-23D TOTAL	10,175	9,301	28,133	1,087.5	
SHEET PDQ-23E TOTAL	10,156	10,776	27,018	1,150.5	
SHEET PDQ-23F TOTAL	6,020	10,107	27,453	2,376	293
SHEET PDQ-23G TOTAL	11,930	9,920	22,303	1,114	25
TOTAL	54,198	57,413	152,217	7,708	318

CONTRACT CHANGE ORDER NO. 20
SHEET _____ OF _____

PAVEMENT DELINEATION QUANTITIES

PDQ-23H

QUYNH NGUYEN	TG	11-28-22	
CALCULATED-DESIGNED BY	REVISED BY	DATE REVISED	
SON LY			
CHECKED BY			
TAM LY			
FUNCTIONAL SUPERVISOR			

STATE OF CALIFORNIA - DEPARTMENT OF TRANSPORTATION
DESIGN

LAST REVISION DATE PLOTTED => 19-NOV-2024
12-07-22 TIME PLOTTED => 16:54

BORDER LAST REVISED 7/2/2010 | USERNAME => s129144 | DGN FILE => 0419000140nc023H.cco | RELATIVE BORDER SCALE IS IN INCHES 0 1 2 3 | UNIT 0712 | PROJECT NUMBER & PHASE 04190001401